

PERMIT

SEWAGE DISPOSAL SYSTEM

DEPARTMENT OF HEALTH AND MENTAL HYGIENE

HOWARD COUNTY HEALTH DEPARTMENT

BUREAU OF ENVIRONMENTAL HEALTH

441-9933 313-2640

INDEXED

P 56511

A REPAIR

DISTRICT 3rd.

DATE 3-20-96

DATE SYSTEM APPROVED 4/9/96

INSPECTOR RPP

Leonard Sutton & Co.

IS PERMITTED TO INSTALL ALTER X

ADDRESS 4556 College Avenue, Catonsville, MD PHONE (410) 744-4552

SUBDIVISION LOT ROAD 481 Route 32

PROPERTY OWNER Knight

481 Route 32
Sykesville, MD 21784

SEPTIC TANK CAPACITY 1000 GALLONS

NUMBER OF BEDROOMS 3

125 SQUARE FEET PER BEDROOM

LINEAR FEET OF TRENCH REQUIRED 45-50' (as certified)

REPAIR - PURPOSE - SEPTIC SYSTEM HAS FAILED

Call for inspection when ground is opened so sanitarian can recommend repairs.

Problem Probably just a plugged pipe between septic tank and dry well. If owner elects, they may install one 45 to 50 ft long Trench, 2 ft wide, inlet at 4 ft, bottom at 16 ft, 6 ft stone fill. This trench to be connected to existing dry well which is functional. RPP 4/4/96

vr/
PLANS APPROVED BY DATE

COVER NO WORK UNTIL INSPECTED AND APPROVED

NEITHER THE HOWARD COUNTY COUNCIL NOR THE HEALTH DEPARTMENT IS RESPONSIBLE FOR THE SUCCESSFUL OPERATION OF ANY SYSTEM

NOTE: CLEANOUT REQUIRED EVERY 70 FEET OF SEWER LINE AND/OR AT 90° SWEEPS IN LINES FROM HOUSE TO DRAIN FIELDS, 90° ELBOWS NOT ACCEPTABLE.

NOTE: ALL PARTS OF SEPTIC SYSTEMS (I.E. TANK, DISTRIBUTION BOX TRENCHES) TO BE 100 FEET FROM WELL (UNLESS OTHERWISE SPECIFICALLY AUTHORIZED)

NOTE: IF DEEP TRENCH(ES) ARE USED CALL FOR INSPECTION BEFORE AND AFTER PLACING GRAVEL IN TRENCH(ES) **BUILDING PERMIT SIGNED AND RETURNED** 6/28/01

NOTE: NO DRY WELL SHALL EXCEED 15 FOOT IN DIAMETER NO ABSORPTION TRENCH TO EXCEED 100 FEET IN LENGTH

NOTE: ALL PIPE FROM HOUSE TO SEPTIC TANK MUST BE CAST IRON OR SCHEDULE 35/40 PVC OR ABS

800137131 POLE BLDG-STORAGE


PERMIT VOID AFTER TWO YEARS

NOTE: INSTALL STAND PIPE ON SEPTIC TANK AND DRY WELL STAND PIPES MUST BE 6 INCHES IN DIAMETER CAST IRON. CONCRETE OR TERRA COTTA OR PVA OR ABS ACCEPTED. IF TOP OF SEPTIC TANK IS DEEPER THAN 3 FEET. MANHOLE TO GRADE REQUIRED.

NOTE: DISTRIBUTION BOXES MUST HAVE BAFFLES

*INSTALLER IS RESPONSIBLE FOR OBTAINING FINAL APPROVAL ON THIS PERMIT

P 56511

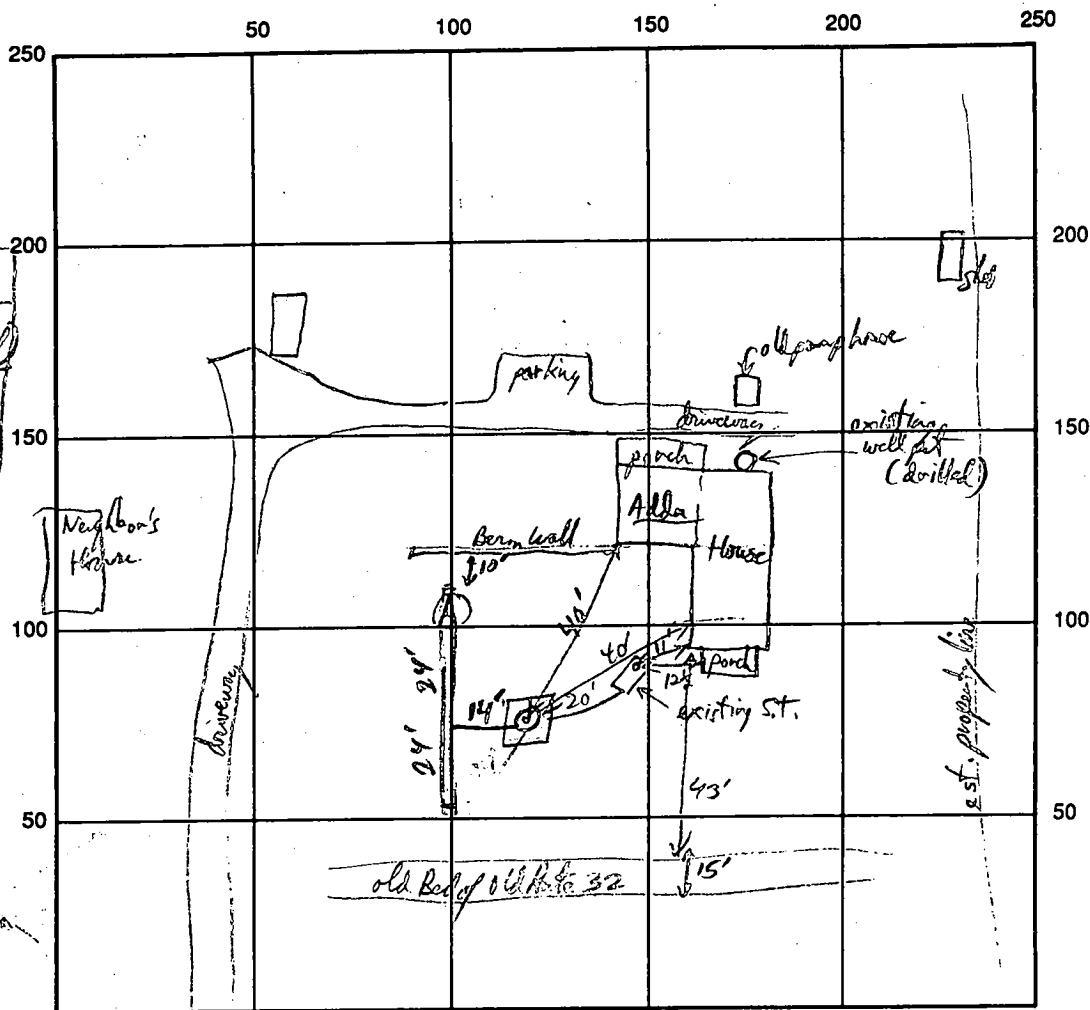

New Route 32 INDICATE NORTH - NAME ADJOINING ROADWAY AS BASE LINE

SEPTIC TANK LEVEL existing CLEANOUTS _____
 DISTRIBUTION BOX LEVEL NA
 DRAIN FIELD/TITLE DEPTH 10 FT. TRENCH WIDTH 3 FT. INLET DEPTH 4 FT.
 EFFECTIVE GRAVEL DEPTH 7 FT. TOTAL LENGTH 48 FT.
 NUMBER OF TRENCHES 1 ONE SIDEWALL/BOTTOM AREA _____ SQ. FT.
 DRYWALL INSIDE DIAMETER _____ FT. EFFECTIVE DEPTH BELOW INLET _____ FT.
 ABSORBENT AREA _____ SQ. FT.

REMARKS: Existing dry well Lid is 3' 5" below grade. Drywell water level at 5 ft below Lid at
4/19/96

System already installed & covered, Diagram based contractor's information per T/C 4/19/96

DATE SYSTEM APPROVED 4/19/96 INSPECTOR [Signature]

DEPARTMENT OF INSPECTIONS, LICENSES AND PERMITS 3430 COURT HOUSE DRIVE ELLICOTT CITY, MD 21043 PERMITS (410)313-2455 INSPECTIONS (410)313-1810 AUTOMATED INFORMATION (410) 313-3800	HOWARD COUNTY PERMIT APPLICATION	PERMIT NUMBER 2001
---	-------------------------------------	-----------------------

Building Address <u>481 ROUTE 32</u> <u>SYKESVILLE, MD. 21784</u>	Property Owner's Name <u>MARTIN K</u>
Suite/Apt. #: _____ SDP/WP/Petition #: _____	Address <u>481 ROUTE 32</u>
Census Tract <u>(C111)</u> Subdivision _____	City <u>SYKESVILLE</u> State <u>MD</u> Zip Code _____
Section _____ Area _____ Lot _____	Home Phone <u>(410)442-9938</u> Work Phone _____
Tax Map <u>11</u> Parcel <u>111</u> Grid <u>15</u>	Applicant's Name & Mailing Address, if other than _____
Zoning <u>RPD15</u> Map Coordinates <u>SAL6</u> Lot size _____	Phone _____ Fax _____
Existing Use <u>SFD</u>	Contractor Company <u>CONESTOGA</u>
Proposed Use <u>STORAGE</u>	Contact Person <u>DENNIS SPOC</u>
Estimated Construction Cost \$ <u>20,000</u>	Address <u>202 ORLAN ROM</u>
Description of Work <u>30' X 40' X 10'</u> <u>POLE BUILDING - STORAGE</u> <u>OF CARS & MOTORCYCLE, LAWN EQUIP</u>	City <u>NEW HOLLAND</u> State <u>PA</u> Zip Code _____
Occupant or Tenant <u>SALE AS</u>	License No. _____
Contact Name <u>PROPERTY OWNER</u>	Phone <u>(800) 544-9468</u>
Address _____	Engineer or Architect Company _____
City _____ State _____ Zip Code _____	Contact Person _____
Phone _____ Fax _____	Address _____
	City _____ State _____ Zip Code _____
	Phone _____ Fax _____

BUILDING DESCRIPTION - <u>COMMERCIAL</u>		BUILDING DESCRIPTION - <u>RESIDENTIAL</u>	
Building Characteristics	Utilities	Building Characteristics	Utilities
Height: <u>10' 6"</u>	Water Supply: _____ Public _____ Private _____	SF Dwelling ☐ SF Townhouse ☐ Depth _____ Width _____	Water Supply: _____ Public _____ Private _____
No. of stories: <u>1</u>	Sewage Disposal: _____ Public _____ Private _____	1st floor: _____	Sewage Disposal: _____ Public _____ Private _____
Gross area, sq. ft. per floor: _____	Electric Yes ☐ No ☐ Gas Yes ☐ No ☐	2nd floor: _____	Electric Yes ☐ No ☐ Gas Yes ☐ No ☐
Use group: _____	Heating System: _____ Electric ☐ Oil ☐ Natural Gas ☐ Propane Gas ☐	Basement: _____	Heating System: _____ Electric ☐ Natural Gas ☐ Propane Gas ☐
Construction type: _____ Reinforced Concrete _____ Structural Steel _____ Masonry _____ Wood Frame _____	Sprinkler system: N/A ☐ Full _____ Partial _____ Other Suppression _____ # of Heads _____	Finished Basement ☐ Unfinished Basement ☐ Crawl space ☐ Slab on Grade ☐ No. of Bedrooms _____	Other Structure: <u>POLE BUILDING</u> Dimensions: <u>30' X 40' X 10'</u> Footings: _____ Roof: _____
State Certified Modular _____		Multi-family dwellings: _____ No. of efficiency units: _____ No. of 1 BR units: _____ No. of 2 BR units: _____ No. of 3 BR units: _____	Sprinkler system: _____ NFA _____ Other _____

THE UNDERSIGNED HEREBY CERTIFIES AND AGREES AS FOLLOWS: (1) THAT HE/SHE IS AUTHORIZED TO MAKE THIS APPLICATION; (2) THAT THE INFORMATION IS CORRECT; (3) THAT HE/SHE WILL COMPLY WITH ALL ORDINANCES AND REGULATIONS OF THE COUNTY WHICH ARE APPLICABLE THERE TO; (4) THAT HE/SHE WILL PERFORM NO WORK ON THE ABOVE REFERENCED PROPERTY NOT SPECIFICALLY DESCRIBED IN THIS APPLICATION; (5) THAT HE/SHE GRANTS CONSENT TO THE COUNTY TO ENTER ONTO THIS PROPERTY FOR THE PURPOSE OF INSPECTING THE WORK PERMITTED AND POSTING NOTICES.


<u>Janet Knight</u> Applicant's Signature	<u>JANET KNIGHT</u> Print Name
<u>JOINT OWNER</u> Title/Company	<u>6/26/02</u> Date

Checks payable to: DIRECTOR OF FINANCE OF HOWARD COUNTY
** PLEASE WRITE NEATLY AND LEGIBLY **

AGENCY		DATE	SIGNATURE APPROVAL	DPZ SETBACK INFORMATION	PROPERTY ID#
☒ Land Development, DPZ				Front: _____	Filing fee \$ _____
☒ State Highways				Rear: _____	Permit fee \$ _____
☒ Building Official				Side: _____	Excise tax \$ _____
☒ Dev. Engineering, DPZ				Side St: _____	Add'l per. fee \$ _____
☒ Health	<u>6/28/02</u>	<u>Rose Naman</u>		All minimum setbacks met? YES ☐ NO ☐	TOTAL FEES \$ _____
☒ Fire Protection				Is Entrance Permit required? YES ☐ NO ☐	Sub-total paid \$ _____
Is Sediment Control approval required prior to issuance? YES ☐ NO ☐				Historic District? YES ☐ NO ☐	Balance due \$ _____
CONTINGENCY CONSTRUCTION START ☐ <u>25</u>				Lot Coverage for New Town Zone _____	Check # _____
ONE STOP SHOP ☐				SDP/Red-line approval date _____	Validation # _____
Distribution of Copies:		White: Building Official	Green: LDD, DPZ	Yellow: DED, DPZ	Pink: Health
					Gold: SHA

T: Forms PERMIT-FRM

Plat showing property known as #481 Route 32, Howard County, Maryland.

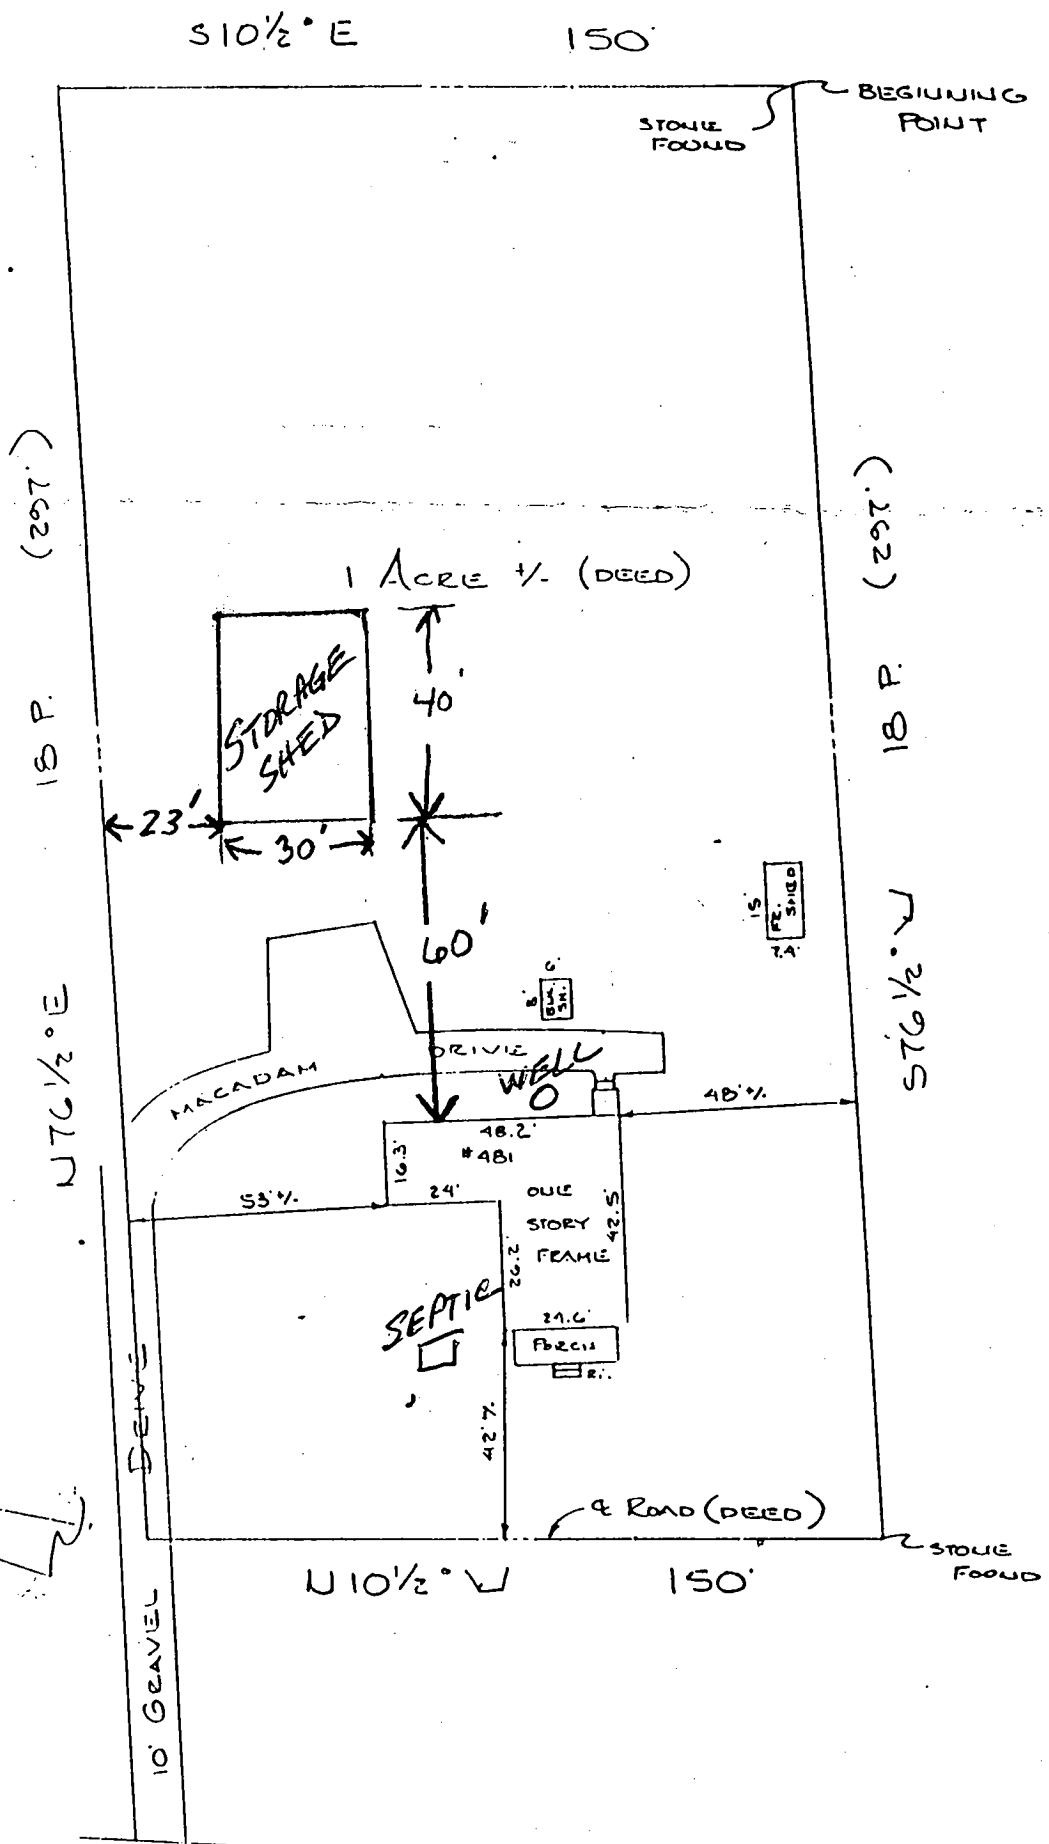

This is to certify that I have located the improvements on the lot shown hereon, and that said improvements exist, and that said improvements lie entirely within the boundaries, except as noted hereon.

ROUTE 32

10.5' MAC. SHLDC.

60' PAV.

29.4' +/- MAC.

60' PAV.

10.5' MAC. SHLDC.



J.S.T. ENGINEERING CO., INC.
3812 MARY AVENUE
BALTIMORE, MARYLAND 21206

NOT INTENDED TO BE USED TO ESTABLISH PROPERTY LINES.

SCALE: 1" = 40' DATE: 6-12-87