

5/15/96
11:00 Repair

PERMIT

SEWAGE DISPOSAL SYSTEM

DEPARTMENT OF HEALTH AND MENTAL HYGIENE

HOWARD COUNTY HEALTH DEPARTMENT

BUREAU OF ENVIRONMENTAL HEALTH

~~2010013~~

313-2640

INDEXED

P 56588C

A REPAIR

DISTRICT _____

DATE 4-30-96

DATE SYSTEM APPROVED 5/15/96

INSPECTOR Appinley

05-377056

Jack Fyock Septic Service

IS PERMITTED TO INSTALL _____ ALTER X

ADDRESS 13775 Triadelphia Road, Glenelg, MD 21737

PHONE 988-9270

SUBDIVISION White Oak Estates

LOT 20

ROAD 13054 St. Patrick's Court

PROPERTY OWNER Sheman

ADDRESS _____

SEPTIC TANK CAPACITY existing 1250 GALLONS

NUMBER OF BEDROOMS 3

150 SQUARE FEET PER BEDROOM

LINEAR FEET OF TRENCH REQUIRED 75

REPAIR - PURPOSE - SEPTIC SYSTEM HAS FAILED.

Call for inspection when ground is opened so sanitarian can recommend repairs.

Install one 75 ft long, 2 ft wide, 10 ft deep, in lot at 2 ft, 8 ft gravel fill Trench. P/P 5/15/96

PLANS APPROVED BY _____

DATE _____

vr/
COVER NO WORK UNTIL INSPECTED AND APPROVED

NEITHER THE HOWARD COUNTY COUNCIL NOR THE HEALTH DEPARTMENT IS RESPONSIBLE FOR THE SUCCESSFUL OPERATION OF ANY SYSTEM

NOTE: CLEANOUT REQUIRED EVERY 70 FEET OF SEWER LINE AND/OR AT 90° SWEEPS IN LINES FROM HOUSE TO DRAIN FIELDS, 90° ELBOWS NOT ACCEPTABLE.

NOTE: ALL PARTS OF SEPTIC SYSTEMS (I.E. TANK, DISTRIBUTION BOX TRENCHES) TO BE 100 FEET FROM WELL (UNLESS OTHERWISE SPECIFICALLY AUTHORIZED)

NOTE: IF DEEP TRENCH(ES) ARE USED CALL FOR INSPECTION BEFORE AND AFTER PLACING GRAVEL IN TRENCH(ES)

NOTE: NO DRY WELL SHALL EXCEED 15 FOOT IN DIAMETER NO ABSORPTION TRENCH TO EXCEED 100 FEET IN LENGTH

NOTE: ALL PIPE FROM HOUSE TO SEPTIC TANK MUST BE CAST IRON OR SCHEDULE 35/40 PVC OR ABS

PERMIT VOID AFTER TWO YEARS


NOTE: INSTALL STAND PIPE ON SEPTIC TANK AND DRY WELL STAND PIPES MUST BE 6 INCHES IN DIAMETER CAST IRON, CONCRETE OR TERRA COTTA OR PVA OR ABS ACCEPTED. IF TOP OF SEPTIC TANK IS DEEPER THAN 3 FEET, MANHOLE TO GRADE REQUIRED.

NOTE: DISTRIBUTION BOXES MUST HAVE BAFFLES

***INSTALLER IS RESPONSIBLE FOR OBTAINING FINAL APPROVAL ON THIS PERMIT**

P 56588C

2 yel bn LHL
 orange KSL
 34 reddish KSL-L
 6 oranges
 10'

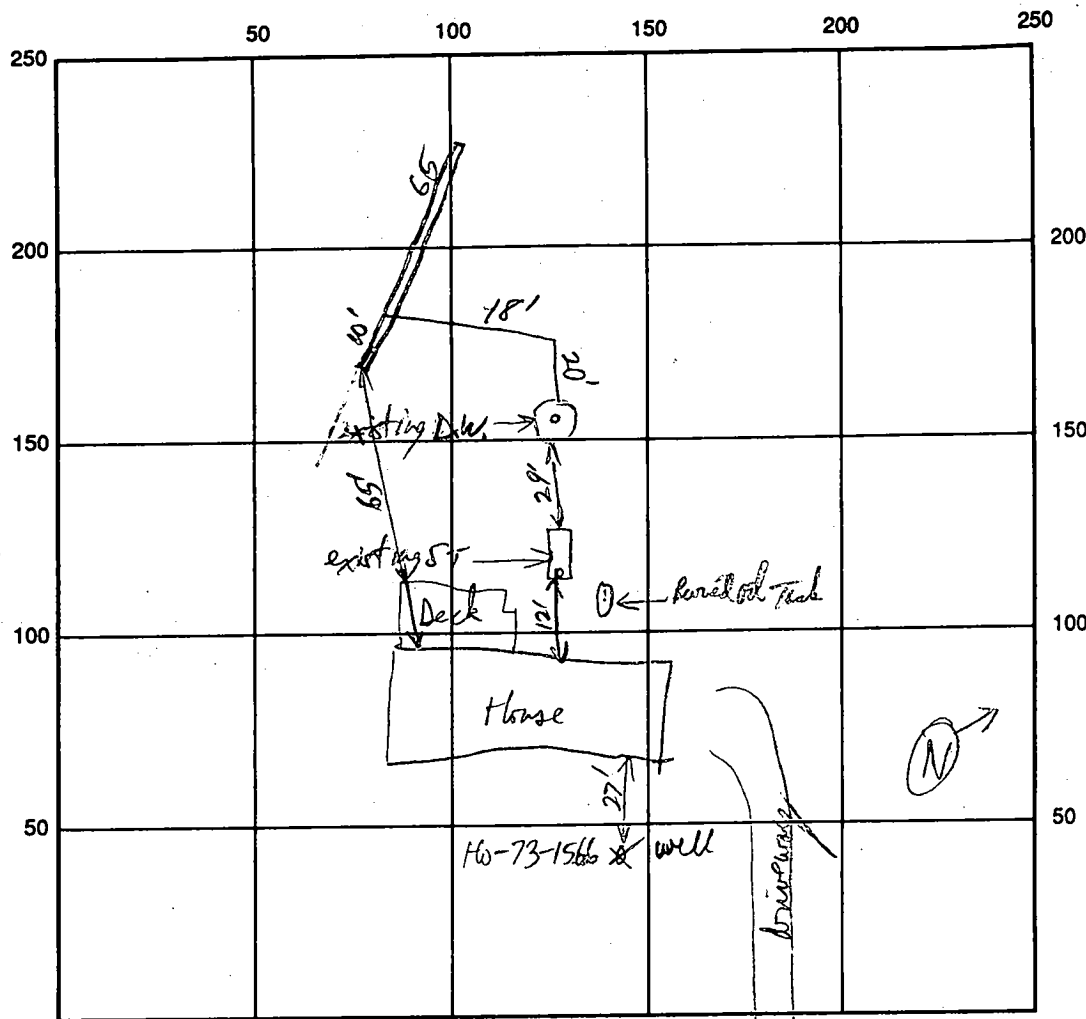

St. Patrick's Court
 INDICATE NORTH - NAME ADJOINING ROADWAY AS BASE LINE

SEPTIC TANK LEVEL existing 1200 gal or (about 1200) CLEANOUTS Dr.

DISTRIBUTION BOX LEVEL NA

DRAIN FIELD/TITLE DEPTH 10 FT. TRENCH WIDTH 2 FT. INLET DEPTH 2 FT.

EFFECTIVE GRAVEL DEPTH 8 FT. TOTAL LENGTH 75' FT.

NUMBER OF TRENCHES 1 ONE SIDEWALL/BOTTOM AREA 600 SQ. FT.

DRYWALL INSIDE DIAMETER _____ FT. EFFECTIVE DEPTH BELOW INLET _____ FT.

ABSORBENT AREA _____ SQ. FT.

REMARKS: OK to fill & cover trench 5/15/96 DW was reported full to top when repaired

DATE SYSTEM APPROVED 5/15/96 INSPECTOR David J. Smith

2/20/77 arrived noon please

PERMIT

SEWAGE DISPOSAL SYSTEM

MARYLAND STATE DEPARTMENT OF HEALTH

HOWARD COUNTY

ELLICOTT CITY

DISTRICT 5th

DATE 4/6/77

INDEXED

Jack Fyock

IS PERMITTED TO INSTALL ☒ ALTER ☐

ADDRESS 13775 Triadelphia Road, Glenelg, Md. 21737

PHONE 988-9270

A SEWAGE DISPOSAL SYSTEM LOCATED AT _____

SUBDIVISION White Oak Estates

1305A
ROAD St. Patrick's Court

LOT 20, Sec. 1

PROPERTY OWNER Mr. Paul Kottis

ADDRESS 1015 Gadsden Ave., Silver Spring, Md. 20904

Phone: _____

SPECIFICATIONS 4 bedrooms

DRAIN FIELD _____ DEPTH _____ FEET, BOTTOM AREA _____ SQ. FT.

SEEPAGE PITS _____ ABSORBENT SIDE-WALL AREA _____ SQ. FT.

SEPTIC TANK CAPACITY 1250 GALLONS

FOR GARBAGE GRINDER, INCREASE DISPOSAL AREA 22% & TANK CAPACITY 50%.

OTHER DRY WELL - To have 120 sq. ft. effective sidewall absorption area per bedroom to begin below the first 6 ft. of non-porous soil. Maximum depth permitted for dry well is 12 ft. below original grade. Place the dry well 170 ft. from the front property line and 50 ft. from the right side line as seen when facing the property from St. Patrick's Court.

NOTE: IN NO CASE IS ANY DRY WELL TO EXCEED 15 FOOT IN DIAMETER.

NOTE: ALL PIPE FROM HOUSE TO DISPOSAL AREA MUST BE CAST IRON.

PERMIT VOID AFTER THREE YEARS.

NOTE: INSTALL STAND PIPE ON SEPTIC TANK AND DRY WELL. STAND PIPES MUST BE 6 INCHES IN DIAMETER. CAST IRON, CONCRETE OR TERRA COTTA ACCEPTED.

PLANS APPROVED BY Frank Skinner


DATE 9/8/75

FILL SEPTIC TANK AND DISTRIBUTION BOX WITH WATER BEFORE CALLING FOR AN INSPECTION. COVER NO WORK UNTIL INSPECTED AND APPROVED.

NEITHER THE HOWARD COUNTY COMMISSIONERS NOR THE HEALTH DEPARTMENT IS RESPONSIBLE FOR THE SUCCESSFUL OPERATION OF ANY SYSTEM.

20510

20510

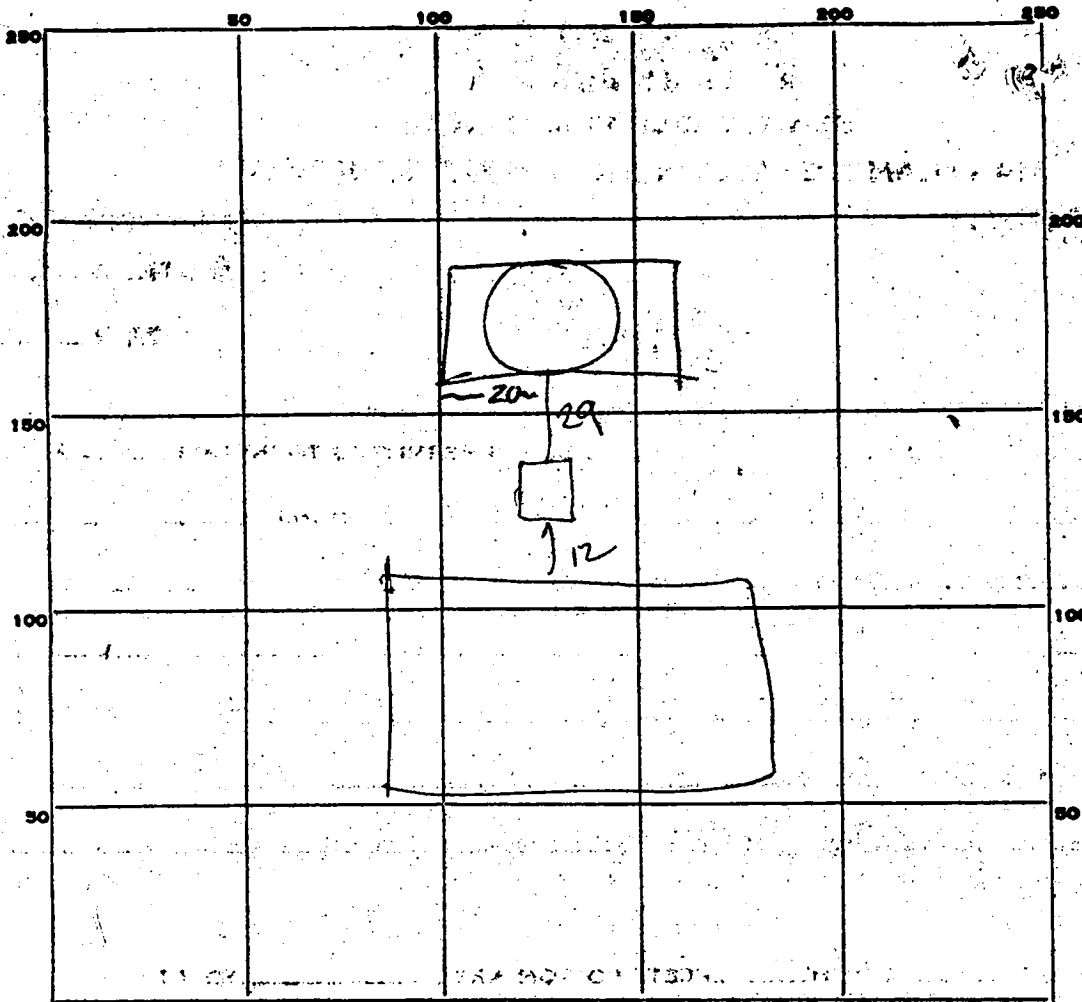

INDICATE NORTH. - NAME ADJOINING ROADWAY AS BASE LINE.

PERMIT CARD ☒SEPTIC TANK, LEVEL ☒

CLEANOUTS DW / ST

DISTRIBUTION BOX, LEVEL ☐TILE FIELD, DEPTH 9 FT. TRENCH WIDTH 2 FT.GRAVEL DEPTH 5 IN. TOTAL LENGTH 60 FT.NUMBER OF TRENCHES 1TOTAL BOTTOM AREA 240SEEPAGE PITS, INSIDE DIAMETER 44 FT. DEPTH BELOW INLET 6 FT.ABSORBENT AREA 264 SQ. FT.240 in trench = 504

REMARKS


DATE SYSTEM APPROVED

Apr 21, 77

INSPECTOR

R B 1665

20510

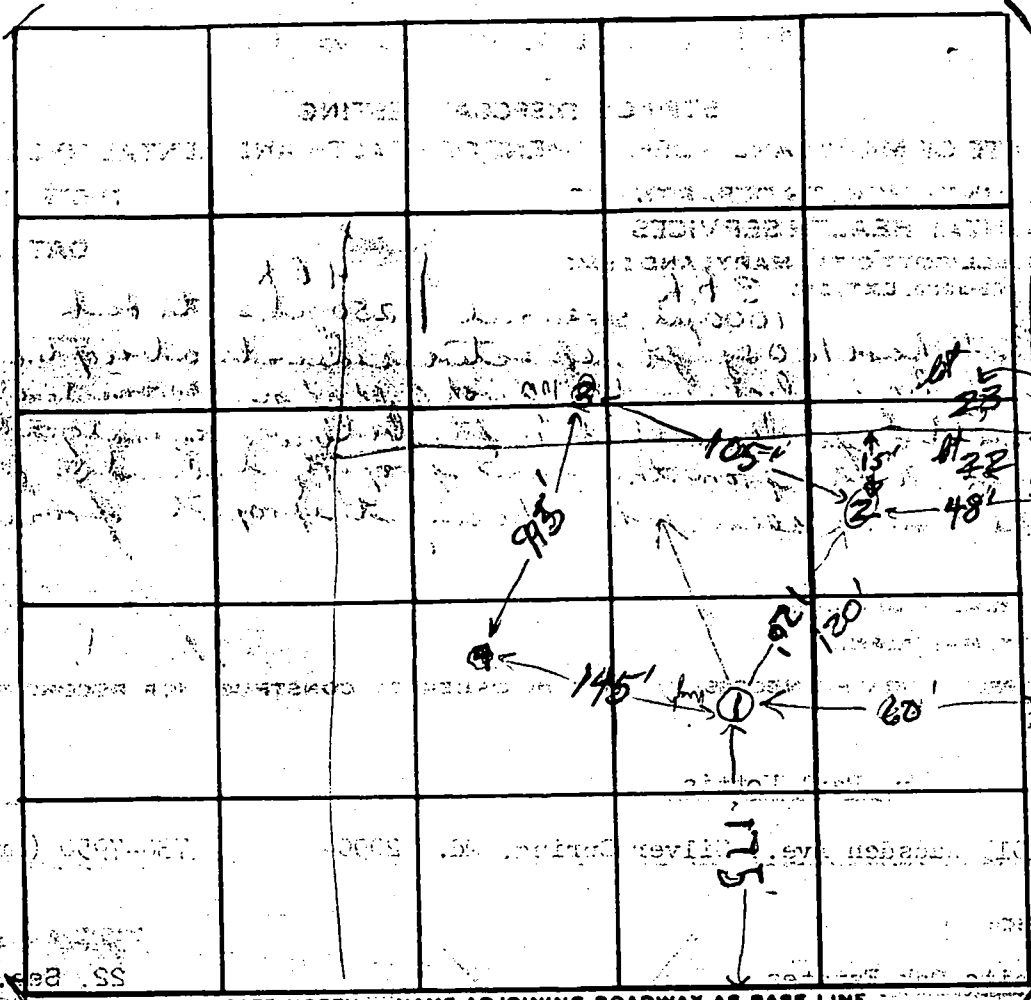

DATE	TEST NO.	DEPTH	PRE-WET		TEST - 1" DROP		TIME
			START	STOP	START	STOP	
10/2/34	1 high	6 1/2'	10:00	10:09	10:09	10:23	14 min
	1 A	12 1/2'	10:00	10:02	10:02	10:05	3 min
	2	5 1/2'	10:08	10:16	10:16	10:28	12 min
	2 A	12'	10:07	10:09	10:09	10:13	4 min
	3 low	5'	10:14	10:15	10:15	10:16	1 min
	3 A	12 1/2'	10:14	10:15	10:15	10:16	1 min
	4	12'	Visual good soil below 5' clay				

Inset 6 ft

14
3
12
4
1
35

6 min arg

lot 22 was A# 20510

REMARKS Lot 22 & 23 now combined

TYPE OF SOIL mic shale loam - some quartz like

TESTED BY E.S. ALSO PRESENT: C.B.S.