

C.D. 5-20-96 PM MEET CONTRACTOR
C.D. 5-21-96 10 AM MEET CONTRACTOR
C.D. 5-22-96 PM (1-2)

PERMIT

PAID BY CHECK #1215
ON MAY 21, 1996
Handwritten signature

SEWAGE DISPOSAL SYSTEM

DEPARTMENT OF HEALTH AND MENTAL HYGIENE

HOWARD COUNTY HEALTH DEPARTMENT
BUREAU OF ENVIRONMENTAL HEALTH
461-9933 313-2640

05-344603
INDEXED

P 56641
A REPAIR
DISTRICT _____
DATE 5-21-96
DATE SYSTEM APPROVED 5/22/96
INSPECTOR gg

L & F Company - Sam Lyons IS PERMITTED TO INSTALL _____ ALTER X
ADDRESS 10688 Scaggsville Road, Scaggsville, MD 20707 PHONE 725-3392
SUBDIVISION _____ LOT _____ ROAD 12049 Scaggsville Road
PROPERTY OWNER D.W. Brown
ADDRESS _____

SEPTIC TANK CAPACITY NA GALLONS → EXISTING SEPTIC TANK APPEARS TO BE IN GOOD
NUMBER OF BEDROOMS 2 SHAPE,
125 SQUARE FEET PER BEDROOM NOTE: SHELF TRENCH WALLS TO PROVIDE
LINEAR FEET OF TRENCH REQUIRED 100' SAFE WORKING AREA IF TRENCH
BOX NOT USED. - SOIL UNSTABLE.

REPAIR - PURPOSE - SEPTIC SYSTEM HAS FAILED.
Call for inspection when ground is opened so sanitarian can recommend repairs.

TRENCH TO BE 3' WIDE, INLET AT 9' BOTTOM AT 11'
2' STONE BELOW DIST. PIPE. INSTALL DISTRIBUTION BOX
BETWEEN TANK AND DRYWELL, CONNECT DRYWELL WITH FLOW
RESTRICTOR LIMITING FLOW TO WHEN TRENCH IS FULL


PLANS APPROVED BY gg 5/21/96 THESE SPECS DISCUSSED W/SAM LYONS gg DATE _____

- COVER NO WORK UNTIL INSPECTED AND APPROVED
- NEITHER THE HOWARD COUNTY COUNCIL NOR THE HEALTH DEPARTMENT IS RESPONSIBLE FOR THE SUCCESSFUL OPERATION OF ANY SYSTEM
- NOTE: CLEANOUT REQUIRED EVERY 70 FEET OF SEWER LINE AND/OR AT 90° SWEEPS IN LINES FROM HOUSE TO DRAIN FIELDS, 90° ELBOWS NOT ACCEPTABLE.
- NOTE: ALL PARTS OF SEPTIC SYSTEMS (I.E. TANK, DISTRIBUTION BOX TRENCHES) TO BE 100 FEET FROM WELL (UNLESS OTHERWISE SPECIFICALLY AUTHORIZED)
- NOTE: IF DEEP TRENCH(ES) ARE USED CALL FOR INSPECTION BEFORE AND AFTER PLACING GRAVEL IN TRENCH(ES)
- NOTE: NO DRY WELL SHALL EXCEED 15 FOOT IN DIAMETER NO ABSORPTION TRENCH TO EXCEED 100 FEET IN LENGTH
- NOTE: ALL PIPE FROM HOUSE TO SEPTIC TANK MUST BE CAST IRON OR SCHEDULE 35/40 PVC OR ABS
- PERMIT VOID AFTER TWO YEARS
- NOTE: INSTALL STAND PIPE ON SEPTIC TANK AND DRY WELL STAND PIPES MUST BE 6 INCHES IN DIAMETER CAST IRON, CONCRETE OR TERRA COTTA OR PVA OR ABS ACCEPTED. IF TOP OF SEPTIC TANK IS DEEPER THAN 3 FEET. MANHOLE TO GRADE REQUIRED.
- NOTE: DISTRIBUTION BOXES MUST HAVE BAFFLES

*INSTALLER IS RESPONSIBLE FOR OBTAINING FINAL APPROVAL ON THIS PERMIT

56641

2-300' TO REAR OF LOT

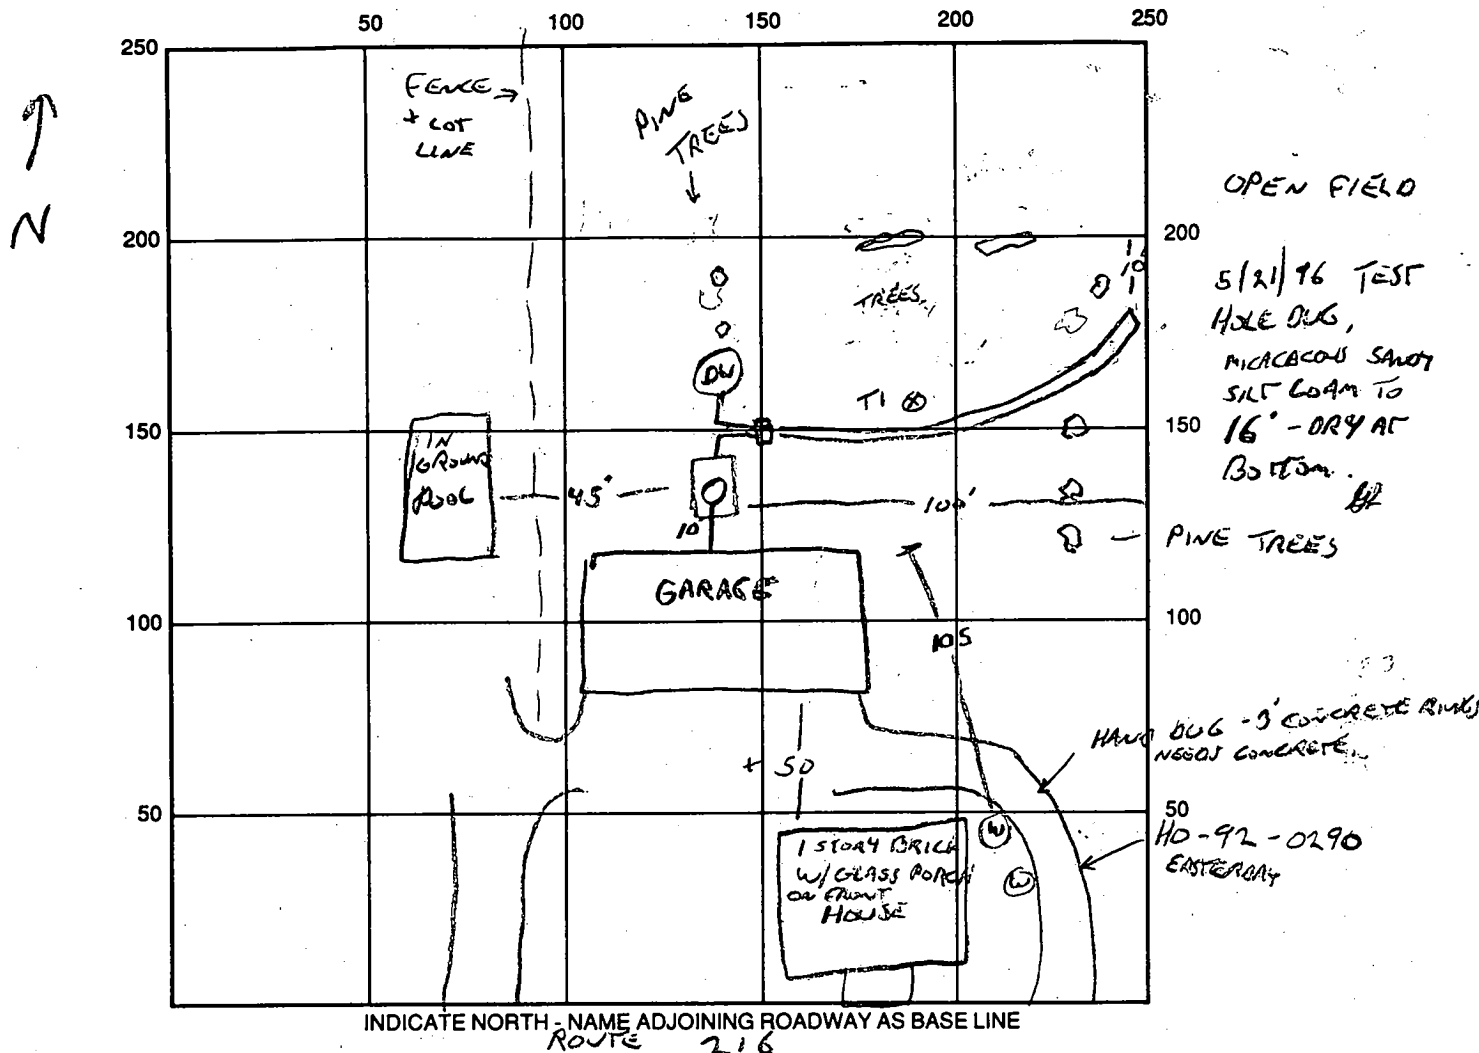

SEPTIC TANK LEVEL NA CLEANOUTS NA
 DISTRIBUTION BOX LEVEL OK - RESTRICTOR TO BE ADDED
 DRAIN FIELD/TITLE DEPTH 11 FT. TRENCH WIDTH 3 FT. INLET DEPTH 9 FT.
 EFFECTIVE GRAVEL DEPTH 2 FT. TOTAL LENGTH 105 FT.
 NUMBER OF TRENCHES 1 ONE SIDEWALL/BOTTOM AREA 315 SQ. FT.
 DRYWALL INSIDE DIAMETER - FT. EFFECTIVE DEPTH BELOW INLET - FT.
 ABSORBENT AREA - SQ. FT.

REMARKS: 5/20/96 CONTRACTOR REPORTS DRYWELL FULL, TOP OF TANK IS 7' BELOW GRADE. SEPTIC SYSTEM IS ABOUT 40 YEARS OLD. DRYWELL NOT OPEN AT TIME OF INSPECTION. REPAIR PERC TO BE DUG AS DEEP AS POSSIBLE.
5/22/96 DIST BOX IN, TRENCH STARTED OK TO CONTINUE. PM - TRENCH CIVIL/MS OK TO COVER SYSTEM. DRYWELL CLEANOUT BROKEN - CONTRACTOR WILL ATTEMPT TO REPAIR AND NOTIFY US OF RESULTS.

DATE SYSTEM APPROVED 5/22/96 INSPECTOR Shelby