

8/7/73

PERMIT

1000

SEWAGE DISPOSAL SYSTEM
MARYLAND STATE DEPARTMENT OF HEALTH
HOWARD COUNTY

ELLCOTT CITY
DISTRICT 905

INDEXED

05-360544

DATE 6/1/73

Builder Builders

IS PERMITTED TO INSTALL ☒ ALTER

ADDRESS 14869 Triadelphia Mill Road, Dayton, Md. 21036 PHONE 286-2408

A SEWAGE DISPOSAL SYSTEM LOCATED AT

SUBDIVISION Mooresfield ROAD Weyerside St. LOT 12, Blk. 2, Plan

PROPERTY OWNER Claude Kram George Lynn

ADDRESS

SPECIFICATIONS 3 bedrooms

DRAIN FIELD DEPTH FEET. BOTTOM AREA SQ. FT.

SEEPAGE PITS ABSORBENT SIDE-WALL AREA SQ. FT. 1000

SEPTIC TANK CAPACITY GALLONS

FOR GARBAGE GRINDER, INCREASE DISPOSAL AREA AND TANK CAPACITY FOR

OTHER DRY WELL - 300 sq. ft. absorbent sidewall area to begin below the first 4 ft. of non-porous soil. MAXIMUM depth permitted for dry well is 15 ft. below original grade. Locate dry well 50 ft. from right side line and 100 ft. from front lot line as shown from Weyerside road.

NOTE: ALL PIPE FROM HOUSE TO DRY WELL MUST BE CAST IRON.
PERMIT VOID AFTER THREE YEARS.

NOTE: INSTALL STAND PIPE ON SEPTIC TANK AND DRY WELL.

PLANS APPROVED BY Robert V. Torre DATE 6/21/73

FILL SEPTIC TANK AND DISTRIBUTION BOX WITH WATER BEFORE CALLING FOR AN INSPECTION. COVER NO WORK UNTIL INSPECTED AND APPROVED.


NEITHER THE HOWARD COUNTY COMMISSIONERS NOR THE HEALTH DEPARTMENT IS RESPONSIBLE FOR THE SUCCESSFUL OPERATION OF ANY SYSTEM.

BLDG. PERMIT SIGNED
AND RETURNED 10/31/96
Serial# 102892
detached garage

118592

4 57370 C

56
50
101

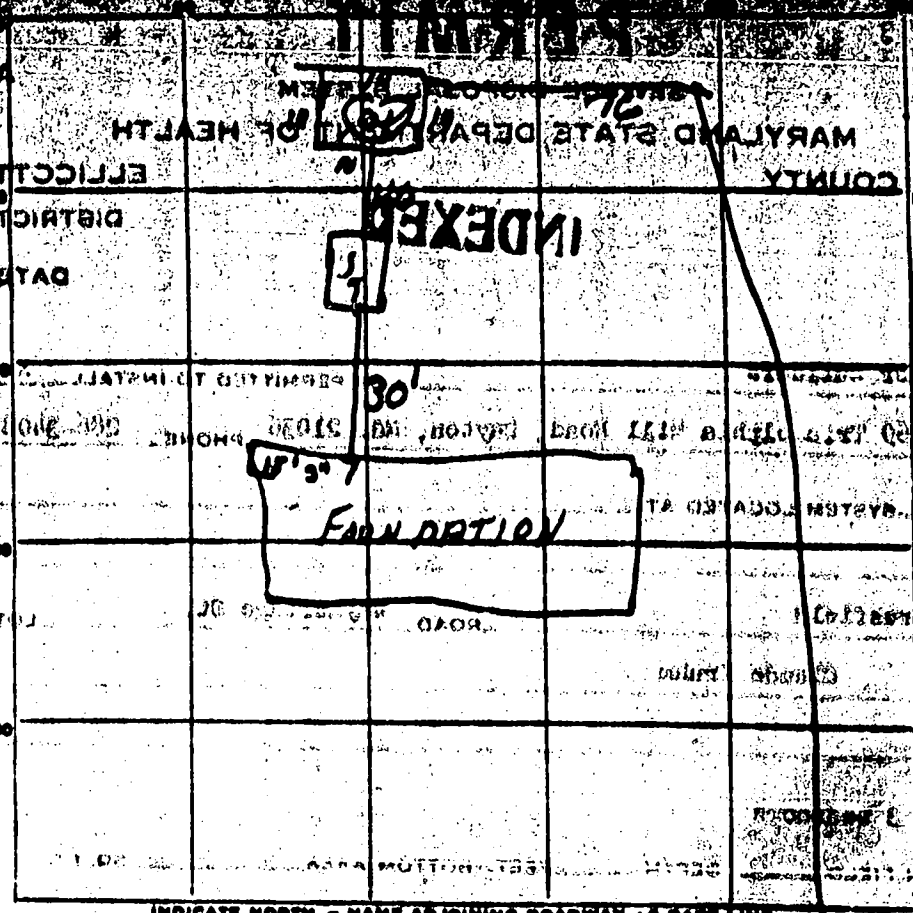

PERMIT CARD

SEPTIC TANK, LEVEL CLEANOUTS

DISTRIBUTION BOX, LEVEL

TILE FIELD, DEPTH FT. TRENCH WIDTH FT.

GRAVEL DEPTH IN. TOTAL LENGTH FT.

NUMBER OF TRENCHES TOTAL BOTTOM AREA

SEEPAGE PITS, INSIDE DIAMETER 56 FT. DEPTH BELOW INLET 6 ft + FT.

ABSORBENT AREA 336 + 00 FT.

REMARKS

DATE SYSTEM APPROVED 6/21/72 INSPECTOR

APPLICATION

12572
A-1007

SEWAGE DISPOSAL TESTING
STATE OF MARYLAND - DEPARTMENT OF HEALTH AND MENTAL HYGIENE
HOWARD COUNTY HEALTH DEPARTMENT
ENVIRONMENTAL HEALTH SERVICES
P.O. BOX 476, ELLICOTT CITY, MARYLAND 21042
TELEPHONE: 469-5000, EXT. 353

Septic Tank - 1000 gal. DISTRICT 1
Dry Well - 300 sq. ft. DATE 6/24/73

abundant sidewalk area to begin with the first
4 1/2 ft. of concrete and maximum depth permitted
for dry well is 13 ft. below original grade for the
dry well 50 ft. from right-of-way line and 180 ft.
from front lot line as seen from Washington

TO: THE COUNTY HEALTH OFFICER
ELLICOTT CITY, MARYLAND

I, HEREBY, APPLY FOR THE NECESSARY TEST IN ORDER TO CONSTRUCT (OR RECONSTRUCT) A SEWAGE DISPOSAL SYSTEM.

PROPERTY OWNER Clara E. Kohn

ADDRESS PHONE

PROPERTY LOCATION:

SUBDIVISION Map 41-1-1 LOT NO. 12, 11, 8, 7, 6, 5

ROAD AND DESCRIPTION Washington / Street

SIZE OF LOT 41,280 sq. ft. TYPE BLDG. 3747

IF NOT SINGLE RESIDENCE DESCRIBE

NUMBER OF PERSONS
(Single only, 1-10)

THE SYSTEM INSTALLED UNDER THIS APPLICATION IS ACCEPTABLE ONLY UNTIL PUBLIC FACILITIES BECOME AVAILABLE.

SIGNATURE OF APPLICANT Thos. George Mitchell

APPROVED BY Robert V. Tane FOR Dry Well DATE 6/21/73
(KIND OF SYSTEM)

REJECTED BY FOR DATE
(KIND OF SYSTEM)

HOLD PENDING FURTHER TESTS DATE

REASONS FOR REJECTION OR HOLDING

THIS IS NOT A PERMIT

APPLICATION

STATE OF MARYLAND - DEPARTMENT OF HEALTH AND MENTAL HYGIENE
 HOWARD COUNTY HEALTH DEPARTMENT
 ENVIRONMENTAL HEALTH SERVICES
 911 BOWEN STREET, BALTIMORE, MD 21201
 TEL: 333-8000 EXT. 401

DATE: 6/10/73

TEST NO. 1

DEPTH 4 1/2'

PRE-WET START 2:05 STOP 2:07

TEST - 1" DROP START 2:07 STOP 2:13

TIME 6 min

TEST NO. 2

DEPTH 13 1/2'

PRE-WET START 2:05 STOP 2:07

TEST - 1" DROP START 2:07 STOP 2:16

TIME 7 min

TEST NO. 3

DEPTH 5 1/2'

PRE-WET START 2:16 STOP 2:16

TEST - 1" DROP START 2:16 STOP 2:21

TIME 5 min

TEST NO. 4

DEPTH 13 1/2'

PRE-WET START 2:16 STOP 2:21

TEST - 1" DROP START 2:21 STOP 2:30

TIME 9 min

REMARKS R. Tom

TYPE OF SOIL

INDICATE NORTH - NAME ASSUMING ROADWAY AS BASE LINE.

DATE	TEST NO.	DEPTH	PRE-WET START	PRE-WET STOP	TEST - 1" DROP START	TEST - 1" DROP STOP	TIME
6/10/73	1	4 1/2'	2:05	2:07	2:07	2:13	6 min
	2	13 1/2'	2:05	2:07	2:07	2:16	7 min
	3	5 1/2'	2:16			2:21	5 min
	4	13 1/2'	2:16	2:21	2:21	2:30	9 min

REMARKS

R. Tom

TYPE OF SOIL

Souder Builders, Inc.

Custom Homes

R. D. 2

DAYTON, MARYLAND 21038

723-3772


Scale 1" = 50'

Existing grade

Final grade

18037 Hwy 100
10/13

Lot 12 Block B
Moorefield
Tulton Maryland

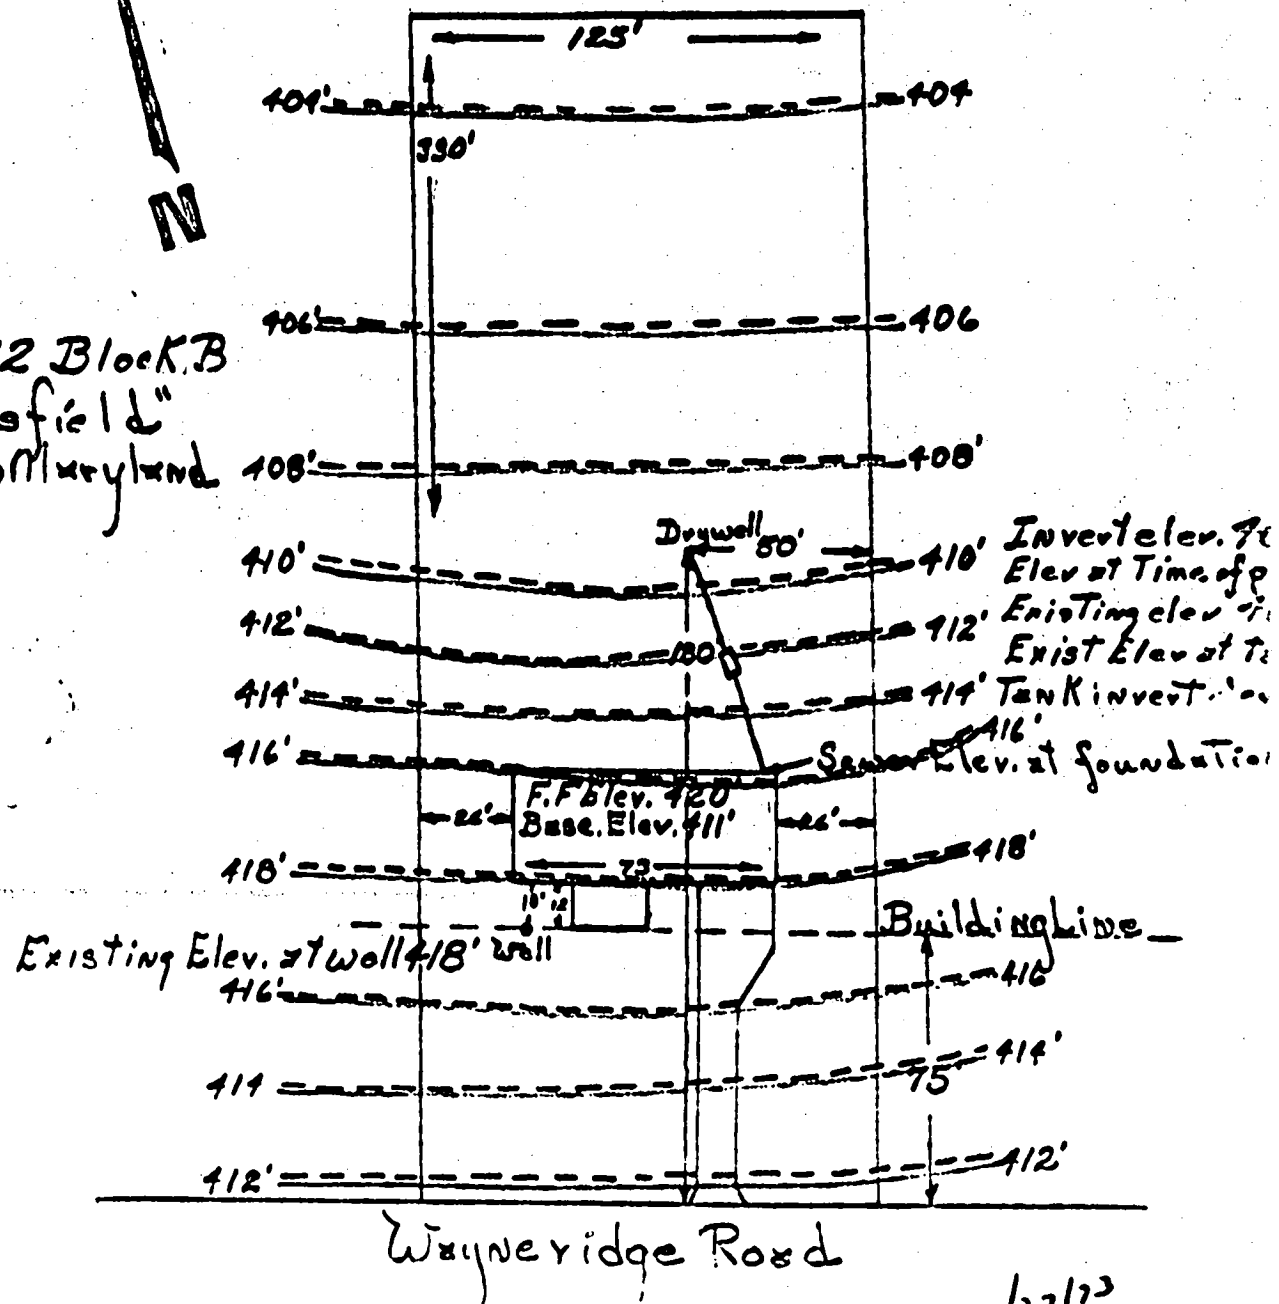

Mrs George Mitchell

7/27/73
Plans at
R.T.

State Office Building
ANNAPOLIS, MARYLAND 21401DEPARTMENT OF
WATER RESOURCES

RECEIVED

WELL COMPLETION REPORT

WELL DESCRIPTION

WELL LOG

State the kind of formations penetrated, their color, their depth, their thickness, and their bearing.

CASING AND SCREEN RECORD

State the kind and size and position of casing, liner, shoe, screen, and other accessories (if no casing used, give diameter of well).

Clay
Surface to 45 ft
Sand Stone 45 to 60
Schale Rock 60 to 100

FEET
from — to —

52 ft

6"

Steel
CasingDIAM.
(inches)FEET
from — to —

PUMPING TEST

Hours Pumped Back Test

Type of Pump Used _____

Pumping Rate _____

Gallons per Minute 10

WATER LEVEL

Distance from land surface to water: _____

Before Pumping 10 Ft.When Pumping 10 Ft.

APPEARANCE OF WATER

Clear ☒ Cloudy _____

Taste _____

Odor _____

Height of Casing Above Land

Surface 10 Ft.

PUMP INSTALLED

Type _____

Capacity _____


Gallons per Minute _____

Gallons per Hour _____

Pump Column Length _____ Ft.

LOCATION OF WELL ON LOT

Show permanent structures such as building(s), septic tank, and/or other landmarks and indicate not less than 2 distances (measurements) to well.

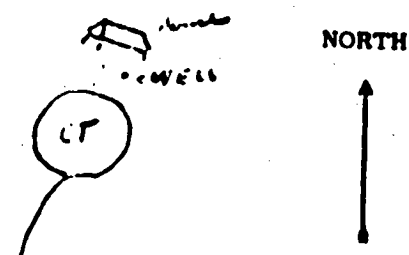

Date Well

Was Completed Nov 15 - 65Well Driller D.L.L. ONSignature [Signature]

TRIPLICATE

7632

STATE OF MARYLAND
WATER RESOURCES ADMINISTRATION
TAYES STATE OFFICE BLDG., ANNAPOLIS, MD. 21401

WELL COMPLETION REPORT

FILL IN THIS FORM COMPLETELY

COUNTY NUMBER _____

DATE OF WELL COMPLETION 11-26-73

WELL IDENTIFICATION NO. 40-73-0525

DEPTH OF WELL 100

PERMIT NO. FROM PERMIT TO DRILL WELL 273

OWNER Thit. Hall STREET OR RFD Wheeler Road St. POST OFFICE Thurston

WELL LOG

STATE THE KIND OF FORMATIONS PENETRATED, THEIR COLOR, DEPTH, THICKNESS AND IF WATER BEARING

DEPTH	DESCRIPTION	THICKNESS	WATER BEARING
0-20	Sand	20	
20-100	gray. Mica	100	

GROUTING RECORD

WELL HAS BEEN GROUTED (CHECK APPROPRIATE BOX)

TYPE OF GROUTING MATERIAL (CHECK ONE)

☒ CEMENT ☐ PORTLAND CEMENT ☐ OTHER

NO. OF BAGS 35 NO. OF POUNDS 63

GALLONS OF WATER 35

DEPTH OF GROUT SEAL (TO NEAREST FOOT)

FROM 0 FT. TO 100 FT.

CASING RECORD

TYPE OF CASING (CHECK ONE)

☒ STEEL ☐ CAST IRON ☐ PLASTIC ☐ OTHER

MAIN CASING TYPE 51 NOMINAL DIAMETER (NEAREST INCH) 6 TOTAL DEPTH OF MAIN CASING (NEAREST FOOT) 100

OTHER CASING (IF USED)

DIAMETER (INCH) _____ DEPTH (FEET) _____

SCREEN RECORD

TYPE OF SCREEN (CHECK ONE)

☒ STEEL ☐ CAST IRON ☐ PLASTIC ☐ OTHER

DIAMETER OF SCREEN _____ INLARGEST (INCH) _____

GRAVEL PACK _____

IF WELL DRILLED WAS A FLOWING WELL (CHECK ONE) ☐ YES ☒ NO

OUR USE ONLY (NOT TO BE FILLED IN BY DRILLER)

TELESCOPE CASING ☐ YES ☒ NO LOG INDICATOR ☐ YES ☒ NO OTHER DATA AVAILABLE ☐ YES ☒ NO

CIRCLE APPROPRIATE BOXES

☐ A WELL HAS ABANDONED AND SEALED WHEN THIS WELL WAS COMPLETED

☐ B ELECTRIC LOG OBTAINED

☐ C TEST WELL CONVERTED TO PRODUCTION WELL

I HEREBY CERTIFY THAT I HAVE COMPLIED WITH ALL CONDITIONS STATED ON THE ABOVE-CAPTIONED "PERMIT TO DRILL WELL", AND THAT INFORMATION CONTAINED IN THIS REPORT IS TRUE, ACCURATE, AND COMPLETE TO THE BEST OF MY KNOWLEDGE, INFORMATION AND BELIEF.

DRILLER'S NAME Ralph Mayne

SIGNATURE Ralph Mayne

PUMPING TEST

WELL PUMPED (TO NEAREST GALLON) _____

PUMPING DATE _____

WATER LEVEL (DISTANCE FROM LAND SURFACE) _____

TYPE OF PUMP USED (CHECK APPROPRIATE BOX)

☐ AIR ☐ PISTON ☐ TURBINE ☐ CENTRIFUGAL ☐ ROTARY ☐ OTHER (DESCRIBE BELOW) _____

PUMP INSTALLED

TYPE OF PUMP (CHECK APPROPRIATE LETTER IN BOX) _____

DRILLER WILL INSTALL PUMP (CHECK APPROPRIATE BOX) ☐ YES ☒ NO

PUMP HORSE POWER _____

PUMP COLUMN LENGTH (NEAREST FOOT) _____


CASING HEIGHT (CHECK APPROPRIATE BOX AND ENTER CASING HEIGHT)

☐ ABOVE ☐ BELOW _____

LOCATION OF WELL ON LOT

SHOW PERMANENT STRUCTURE SUCH AS BUILDING, SEPTIC TANK, AND/OR OTHER LAND MARKS AND INDICATE NOT LESS THAN TWO DISTANCE MEASUREMENTS TO WELL.

WAYNERIDGE ST.

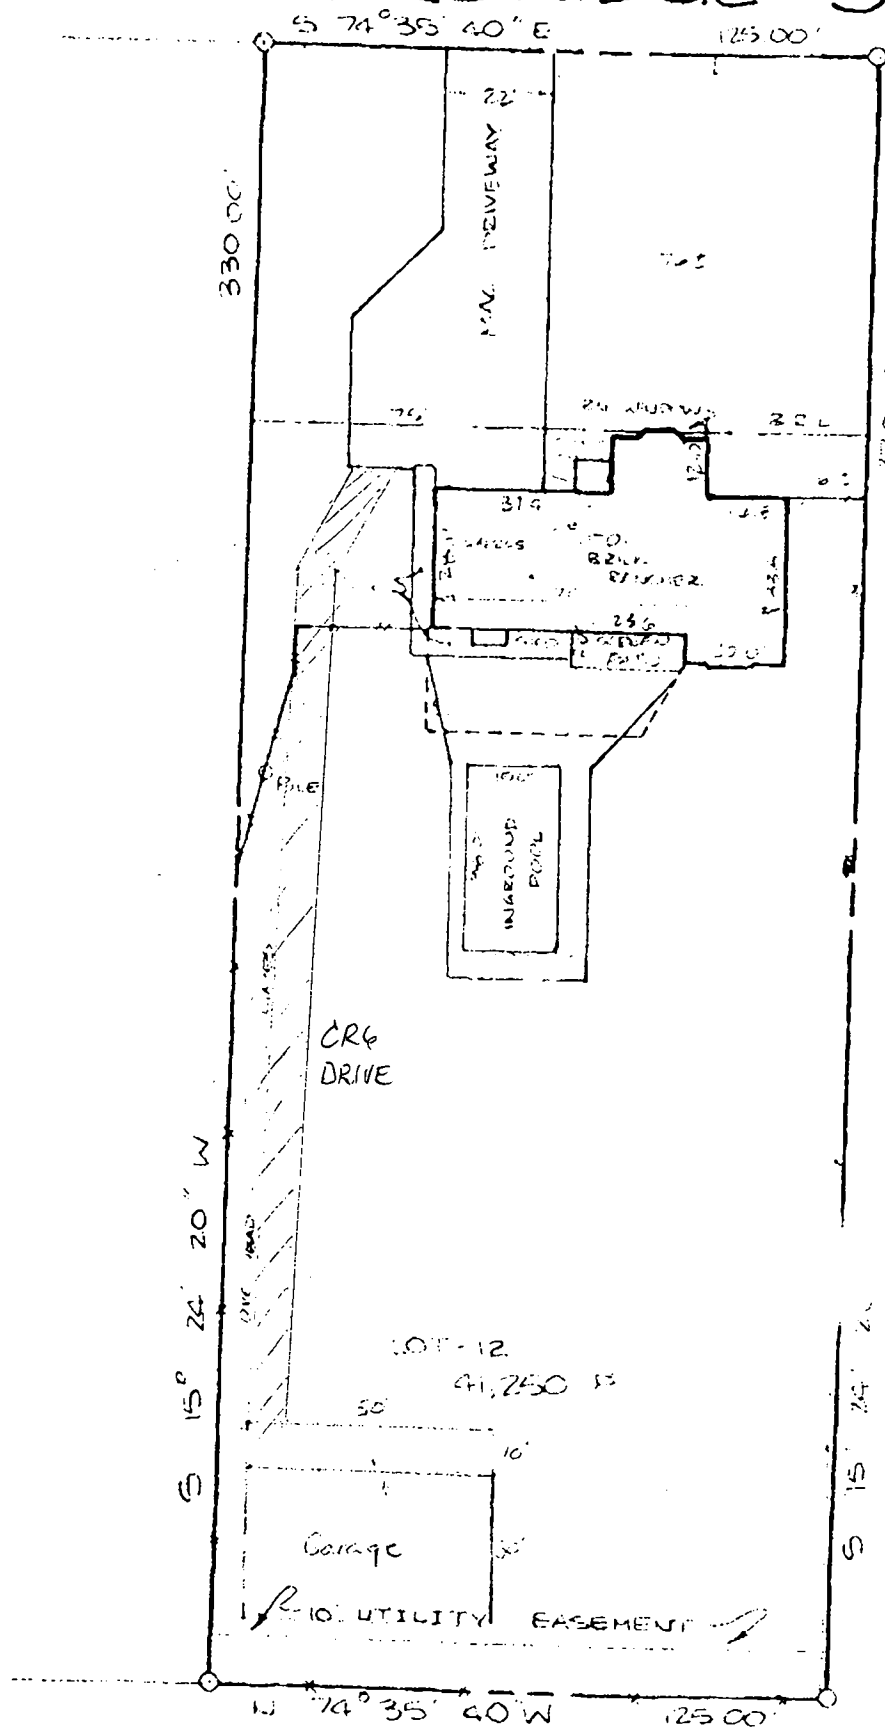

10/31/96
 The proposed detached garage will have no impact on the existing well or septic
 OK to proceed.
 A McMillen

LOCATION PLAT OF
 "11701 WAYNERIDGE STREET"
 3rd ELECTION DISTRICT
 HOWARD COUNTY, MD

LOT: 12
 PLAT BOOK: 9
 DATE: 10/31/96

BLOCK: B
 PLAT NO: 40
 SCALE: 1" = 40'