

PERMIT

SEWAGE DISPOSAL SYSTEM

DEPARTMENT OF HEALTH AND MENTAL HYGIENE

INDEXED

HOWARD COUNTY HEALTH DEPARTMENT

BUREAU OF ENVIRONMENTAL HEALTH

~~XXXXXX~~

313-2640

P 58469

A 57655

DISTRICT 5th

DATE 5-19-97

DATE SYSTEM APPROVED 9-30-98

INSPECTOR AK

David Bassler - CELL PHONE 410-977-2203 IS PERMITTED TO INSTALL ☒ ALTER ☐

ADDRESS 4990 Sheppard Lane, Ellicott City, Md. PHONE 410-531-2193

SUBDIVISION _____ LOT _____ ROAD 5070 Sheppard Lane

PROPERTY OWNER _____ Basslers, Inc. (Hayland Farm)

ADDRESS _____

SEPTIC TANK CAPACITY 1000 GALLONS MOBIL HOME

NUMBER OF BEDROOMS 3

210 SQUARE FEET PER BEDROOM

LINEAR FEET OF TRENCH REQUIRED 210

TRENCHES - Trench to be 3 feet wide. Inlet 4.5 feet below original grade. Bottom maximum depth 6.5 feet below original grade. Effective area begins at 4.5 feet below original grade. 2 feet of stone below distribution pipe.

LOCATION - Start the first trench at the highest part of the septic area, or approximately as follows: 200' off the souther property boundary and 120 feet off the gravel driveway. Run trenches on contour

NOTES - No trench to exceed 100 feet in length. provide 6" - 8" diameter cleanout and cap to grade or above on septic tank. ok(w)

PLANS APPROVED BY Mark Rifkin DATE 5/08/97

COVER NO WORK UNTIL INSPECTED AND APPROVED

NEITHER THE HOWARD COUNTY COUNCIL NOR THE HEALTH DEPARTMENT IS RESPONSIBLE FOR THE SUCCESSFUL OPERATION OF ANY SYSTEM

NOTE: CLEANOUT REQUIRED EVERY 70 FEET OF SEWER LINE AND/OR AT 90° SWEEPS IN LINES FROM HOUSE TO DRAIN FIELDS, 90° ELBOWS NOT ACCEPTABLE.

NOTE: ALL PARTS OF SEPTIC SYSTEMS (I.E. TANK, DISTRIBUTION BOX TRENCHES) TO BE 100 FEET FROM WELL (UNLESS OTHERWISE SPECIFICALLY AUTHORIZED)

NOTE: IF DEEP TRENCH(ES) ARE USED CALL FOR INSPECTION BEFORE AND AFTER PLACING GRAVEL IN TRENCH(ES)

NOTE: NO DRY WELL SHALL EXCEED 15 FOOT IN DIAMETER NO ABSORPTION TRENCH TO EXCEED 100 FEET IN LENGTH


NOTE: ALL PIPE FROM HOUSE TO SEPTIC TANK MUST BE CAST IRON OR SCHEDULE 35/40 PVC OR ABS

PERMIT VOID AFTER TWO YEARS

NOTE: INSTALL STAND PIPE ON SEPTIC TANK AND DRY WELL STAND PIPES MUST BE 6 INCHES IN DIAMETER CAST IRON. CONCRETE OR TERRA COTTA OR PVA OR ABS ACCEPTED. IF TOP OF SEPTIC TANK IS DEEPER THAN 3 FEET. MANHOLE TO GRADE REQUIRED.

NOTE: DISTRIBUTION BOXES MUST HAVE BAFFLES

***INSTALLER IS RESPONSIBLE FOR OBTAINING FINAL APPROVAL ON THIS PERMIT**

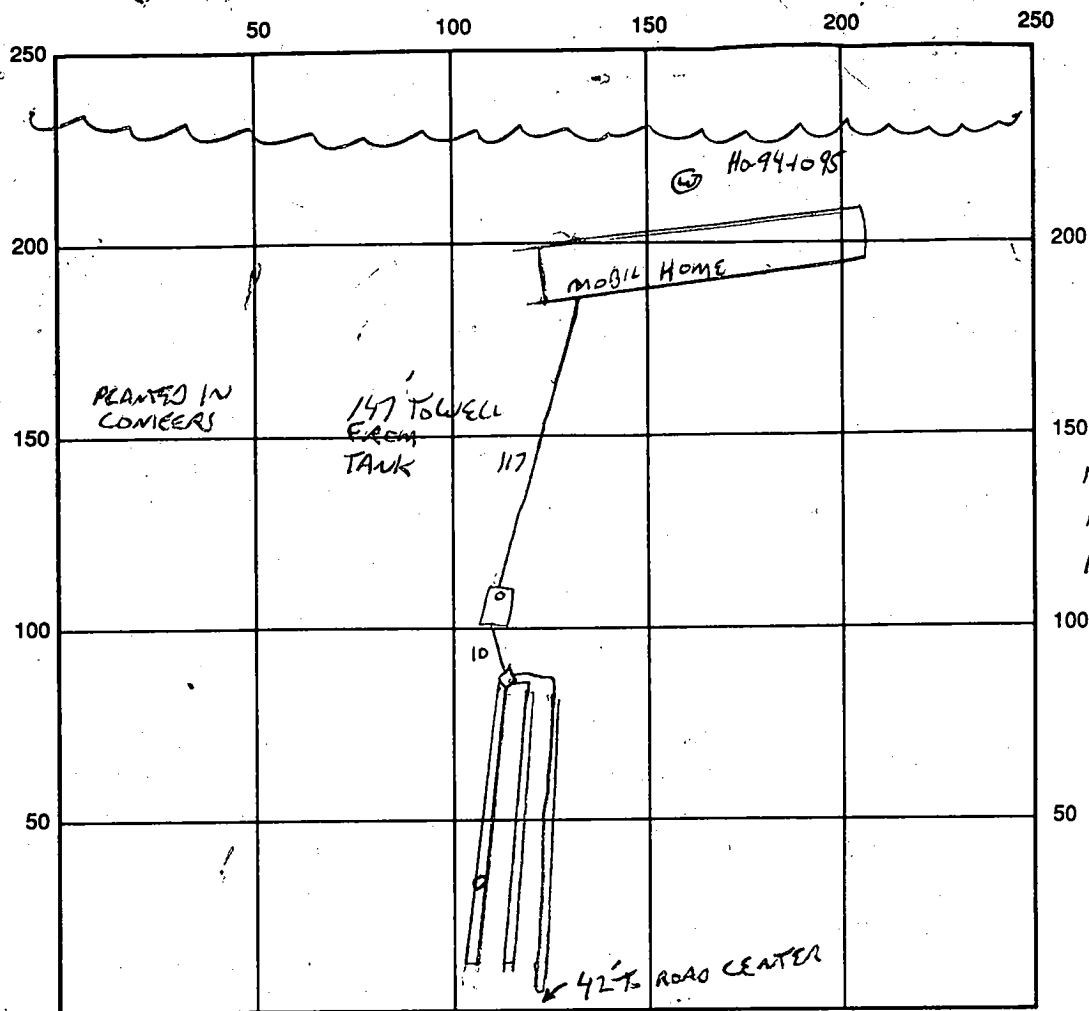

INDICATE NORTH - NAME ADJOINING ROADWAY AS BASE LINE
GRAVEL DRIVE

SEPTIC TANK LEVEL OK - 1500 GALLON

CLEANOUTS 1 ON ST - 1 TO BE INSTALLED AT TIE IN TO 2ND MOBILE HOME

DISTRIBUTION BOX LEVEL OK

DRAIN FIELD/TITLE DEPTH 6.5 FT.

TRENCH WIDTH 3 FT.

INLET DEPTH 4.5 FT.

EFFECTIVE GRAVEL DEPTH 2 FT.

TOTAL LENGTH 2x90, FT. $1-100 = 280$

NUMBER OF TRENCHES 3

ONE SIDEWALL/BOTTOM AREA _____ SQ. FT.

DRYWALL INSIDE DIAMETER _____ FT.

EFFECTIVE DEPTH BELOW INLET _____ FT.

ABSORBENT AREA ✓ SQ. FT.

REMARKS: 5/4/98 NEEDS LINE FROM TRAILER TO S.T., DIST BOX CLEARED OUT OK TO CONTINUE. BY

5/8/98 SYSTEM INSTALLED, WE MISSED INSPECTION, APPLICANT COVERED WORK

DUE TO IMPROVING RAIN OK PER CLW, SKETCH OF SYSTEM TO BE COMPLETED BY MA.

BAJSLER. BY 5/8/98 TRENCHES VERIFIED - DIST BOX OK. COVER ALL WORK, WRITE

OK - NEED INSTALLATION SHEET, CLEANOUT LINE TO ST + PERC CERT, SITE

PLAN FOR TRAILER 2 REQ FOR FINAL - AGREED BY D. BAJSLER. BY 9/30/98 New sold

DATE SYSTEM APPROVED 9-30-98

INSPECTOR J. McMiller

house
conn
to
septic
at

Septic Data

Mobile Home

of bedrooms 2

First floor 376.00

Invert 373.00

Septic Tank

Size 1500 gal.

Existing grade 372.00

Invert in 368.30

Invert out 367.90

Distribution Box

Existing grade 371.30

Invert 367.80

Trenches

of trenches 2


Length 70.0'

Width 3.0'

2' of stone below pipe

Well # HO-94-1095

Perc # A57655

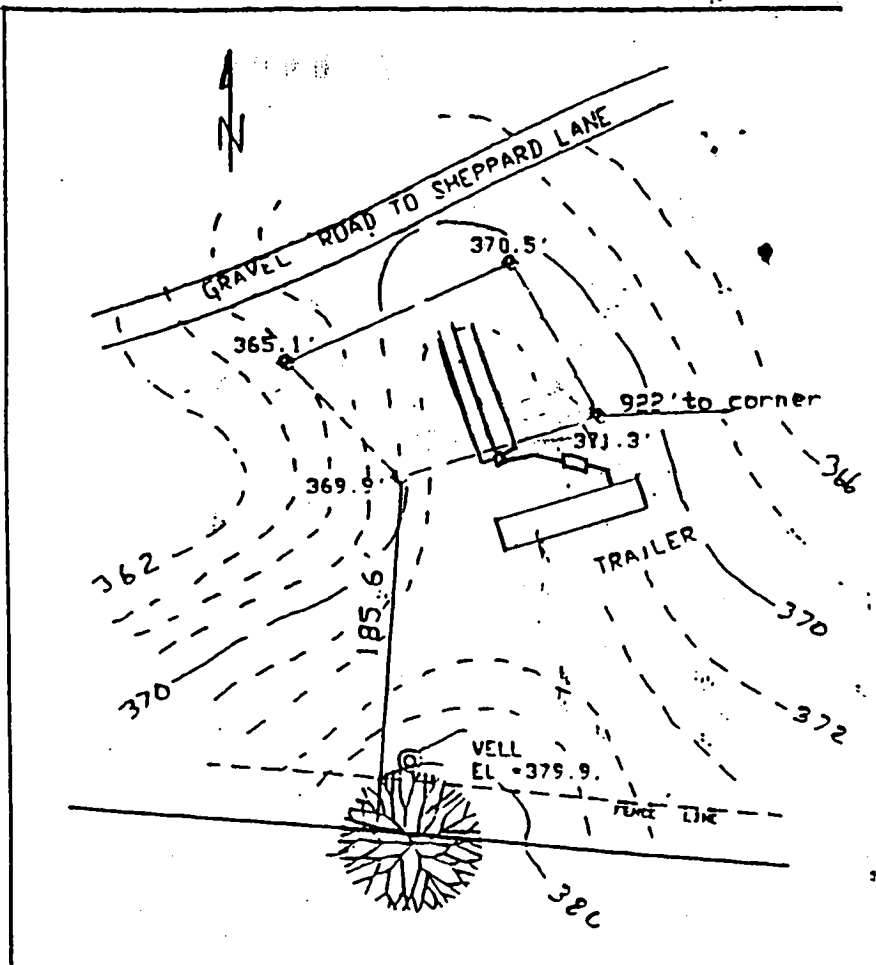

I certify the above measurements and elevations are actual and correct for this property.

David C. Bassler

Scale: 1"=100"

Owner:

Basslers Inc.	Deed ref.: 516/ 763	Acreage: 429.1 ac.
4994 Sheppard Ln.	Map: 28	Zoning: RC-DEO
Ellicott City, MD 21042	Parcel: 49	

Contact Person: David Bassler

Home: (410) 531-3589

Pager: (410) 395-0633

Approved Septic System Plan
Howard County Health Department

B00105134

Mark E. Rifkin 5/8/97
Signature Date

10' MINIMUM BETWEEN
TRAILER AND SEPTIC TANK

20' MINIMUM BETWEEN
TRAILER AND DRAINFIELDS

5-4-98
Repair Peric Sometime
200 (M) C.O. Insp
5/1/98 130

PERMIT

SEWAGE DISPOSAL SYSTEM

DEPARTMENT OF HEALTH AND MENTAL HYGIENE

P 58984
A 57655

DISTRICT _____

DATE 9/22/97

HOWARD COUNTY HEALTH DEPARTMENT

BUREAU OF ENVIRONMENTAL HEALTH
~~251-5001~~ 410-313-2640

DATE SYSTEM APPROVED _____

INSPECTOR _____

CELL PHONE
410 977-2203

David Bassler _____ IS PERMITTED TO INSTALL X ALTER _____

ADDRESS 4990 Sheddard Lane, Ellicott City, MD 21042 PHONE 410-531-2193

SUBDIVISION _____ LOT _____ ROAD 5070 Sheppard Lane

PROPERTY OWNER Basslers, Inc.

ADDRESS 5070 Sheppard Lane, Ellicott City, MD 21042

SEPTIC TANK CAPACITY 1500 GALLONS Combined Admended Permit on 5/7/98.

NUMBER OF BEDROOMS _____

_____ SQUARE FEET PER BEDROOM

LINEAR FEET OF TRENCH REQUIRED 70' Addition of 70' of trench to existing specs.

PURPOSE - To establish soil conditions sufficient to support the septic system requirements for a second dwelling unit, and if successful, to permit connection of the additional trailer to the installed system serving the existing trailer, once system installation plans have been reviewed and approved. Monitoring pipe(s) to be installed at the Health Department's request as previously discussed, 5/7/98.

OK 5/8/98

ACCEPTABLE PERL CERT AND SITE PLAN REQUIRED FOR FINAL APPROVAL.

PLANS APPROVED BY Glen Savage DATE 9/22/97

COVER NO WORK UNTIL INSPECTED AND APPROVED

NEITHER THE HOWARD COUNTY COUNCIL NOR THE HEALTH DEPARTMENT IS RESPONSIBLE FOR THE SUCCESSFUL OPERATION OF ANY SYSTEM

NOTE: CLEANOUT REQUIRED EVERY 70 FEET OF SEWER LINE AND/OR AT 90° SWEEPS IN LINES FROM HOUSE TO DRAIN FIELDS, 90° ELBOWS NOT ACCEPTABLE.

NOTE: ALL PARTS OF SEPTIC SYSTEMS (I.E. TANK, DISTRIBUTION BOX TRENCHES) TO BE 100 FEET FROM WELL (UNLESS OTHERWISE SPECIFICALLY AUTHORIZED)

NOTE: IF DEEP TRENCH(ES) ARE USED CALL FOR INSPECTION BEFORE AND AFTER PLACING GRAVEL IN TRENCH(ES)

NOTE: NO DRY WELL SHALL EXCEED 15 FOOT IN DIAMETER NO ABSORPTION TRENCH TO EXCEED 100 FEET IN LENGTH

NOTE: ALL PIPE FROM HOUSE TO SEPTIC TANK MUST BE CAST IRON OR SCHEDULE 35/40 PVC OR ABS

PERMIT VOID AFTER TWO YEARS

NOTE: INSTALL STAND PIPE ON SEPTIC TANK AND DRY WELL STAND PIPES MUST BE 6 INCHES IN DIAMETER CAST IRON. CONCRETE OR TERRA COTTA OR PVA OR ABS ACCEPTED. IF TOP OF SEPTIC TANK IS DEEPER THAN 3 FEET. MANHOLE TO GRADE REQUIRED.

NOTE: DISTRIBUTION BOXES MUST HAVE BAFFLES

***INSTALLER IS RESPONSIBLE FOR OBTAINING FINAL APPROVAL ON THIS PERMIT**

	50	100	150	200	250
250					
200					200
150					150
100					100
50					50

INDICATE NORTH - NAME ADJOINING ROADWAY AS BASE LINE

SEPTIC TANK LEVEL _____ CLEANOUTS _____

DISTRIBUTION BOX LEVEL _____

DRAIN FIELD/TITLE DEPTH _____ FT. TRENCH WIDTH _____ FT. INLET DEPTH _____ FT.

EFFECTIVE GRAVEL DEPTH _____ FT. TOTAL LENGTH _____ FT.

NUMBER OF TRENCHES _____ ONE SIDEWALL/BOTTOM AREA _____ SQ. FT.

DRYWALL INSIDE DIAMETER _____ FT. EFFECTIVE DEPTH BELOW INLET _____ FT.

ABSORBENT AREA _____ SQ. FT.

REMARKS: _____

DATE SYSTEM APPROVED _____ INSPECTOR _____



DEPARTMENT OF PLANNING & ZONING

Joseph W. Rutter, Jr., Director

October 10, 1997

Mr. David Bassler
4990 Sheppard Lane
Ellicott City, MD 21042

Dear Mr. Bassler:

RE: Proposed Farm Tenant Dwelling
4990 Sheppard Lane

5-4-98
PERC ESTABLISHMENT
OF 2ND 10 KZIFT
OK, MA BASSLER REQUEST
BUILDING PERMIT RELEASE PRIOR TO
PERC CERT DOCUMENT REVIEW
IN ORDER TO COMPLETE POWER LINE
INSTALLATION. OK CONDITIONAL THAT
REUSO PERC CERT BE PROVIDED PRIOR
TO OCCUPANCY APPROVAL. AGRESSO
TO BY DAVID BASSLER, OWNER. JWR
OK-JEE PERC RESPONSE
S/T JWR

This correspondence is in response to your letter of September 23, in which you requested confirmation that constructing a farm tenant mobile home on your farm would be permitted by the Howard County Zoning Regulations. According to your letter, your farm contains 429 acres, and currently contains 7 houses and one mobile home. The addition of the mobile home would bring the total number of dwellings to nine. In your telephone conversation with Stephen Bockmiller on October 9, you informed this office that all accessory dwellings on the subject property are used as residences by employees of the farm, horse care or composting operations on the property.

Your property is located in the RC-DEO (Rural Conservation-Density Exchange Option) Zoning District. Section 104.C.2 of the Zoning Regulations, which addresses the permitted accessory uses in the RC District permits:

2. Accessory houses, limited to the following:
 - a. Farm tenant houses and similar uses customarily accessory to agricultural uses, provided that these uses shall not be permitted on parcels of less than 50 acres, and one unit shall be permitted for each 25 acres of that parcel;...

Based on this regulation, your farm has one permitted principal dwelling and seven farm tenant dwellings. A farm of 429 acres would be permitted a total of seventeen farm tenant dwellings. Therefore, the installation of one mobile home for use by a farm employee is permitted by the Zoning Regulations. Please be aware that all farm tenant dwellings must be occupied by persons actively employed in bona fide agricultural operations on the farm. Farm tenant dwellings are not intended for use as rental units or for individuals who are engaged in non-farming activities on the property. Use of these dwellings for families where no one is involved in the farm operation is a violation of the Zoning Regulations.

Based on the above information, the installation of one mobile home on the subject property as a farm tenant dwelling is permitted by the Zoning Regulations, and this Division will approve a building permit for the mobile home, provided that it meets the required 75 foot front, 30 foot side and 60 foot rear setback requirements set forth in Section 104.E of the Zoning Regulations, and meets the definition of a farm tenant house.

Should you have any questions regarding this matter, please contact Stephen Bockmiller of this Division at the telephone number listed below.

Sincerely,

WFO-Brian

William F. O'Brien, Chief
Division of Comprehensive Planning
and Zoning Administration


WFO/SRB/srb
Attachment: Sec. 103.A.43

DEED CALLS

L1	N 85°20'10" V	2883.6'
L2	S 42°36'30" V	161.2'
L3	N 04°32'43" V	780.3'
L4	N 40°42'20" V	3564.8'
L5	N 30°45'40" E	176.6'
L6	N 06°20'40" E	176.5'
L7	N 18°57'20" E	396.0'
L8	N 00°37'20" E	180.1'
L9	N 11°26'34" V	1167.3'
L10	N 26°38'10" V	156.7'
L11	N 31°59'44" E	583.4'
L12	S 33°30'02" E	638.9'
L13	N 82°00'17" E	135.1'
L14	N 13°36'43" V	611.3'
L15	N 70°08'47" E	250.3'
L16	S 41°34'46" E	1177.8'
L17	N 54°49'30" E	119.6'
L18	S 57°22'30" E	3943.5'
L19	N 38°15'10" E	1122.1'
L20	S 12°34'37" E	233.9'
L21	S 11°13'40" E	3852.5'
L22	S 78°24'10" E	680.5'
L23	S 11°35'30" E	251.6'


U. R. HOBLEY DEED CALLS

L1	S 77°41'00" V	806.8'
L2	S 80°11'00" V	806.8'
L3	S 77°41'00" E	410.0'
L4	S 80°11'00" E	176.1'
L5	S 77°41'00" V	806.8'

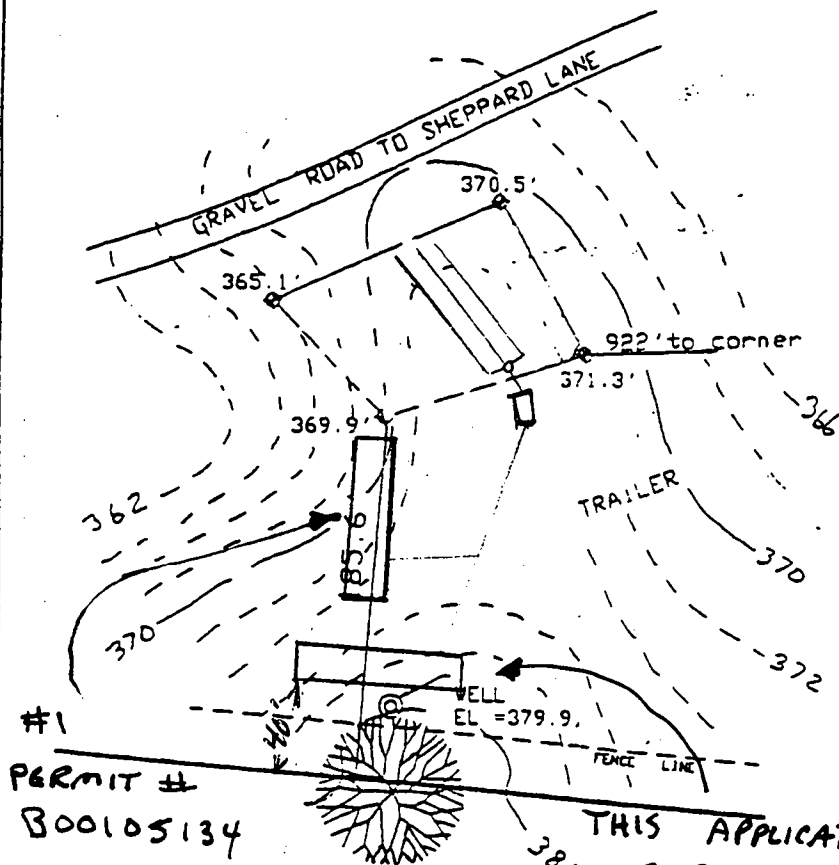

PERMIT #
B00105134

THIS APPLICATION
FOR #2

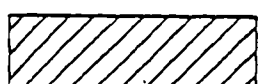

This area designates a private sewage easement of approximately 10,000 square feet as required by the Maryland State Department of Health and Mental Hygiene for individual sewage disposal. Improvements of any nature in this area are restricted until public sewerage is available and servicing any residential structures constructed on this building site. These easements shall become null and void upon connection to a public sewage system. The County Health Officer shall have the authority to grant variances for encroachments into the private sewage easement. Recordation of a modified sewage easement shall not be necessary.

All percolation test holes have been field located and shown thus

All wells and septic systems within 100' of property line have been shown.



APPROVED: FOR PRIVATE WATER AND SEWER
HOWARD COUNTY HEALTH DEPARTMENT

HOWARD COUNTY HEALTH OFFICER DATE

PERC TEST SITE

PERCOLATION CERTIFICATION PLAT
HAYLAND FARM SHEPPARD LANE
APPLICATION # 57655
5TH ELECTION DISTRICT
HOWARD COUNTY, MARYLAND
SCALE 1"=1200' & 1"=100'
DATE MARCH 13 1997

NTT ASSOCIATES, INC.
16205 OLD FREDERICK ROAD
MT. AIRY, MARYLAND 21771
PH. 410 442 2031
FAX 410 442 1315

APPLICATION

HOWARD COUNTY

SERIAL NUMBER

PERMIT APPLICATION

DEPARTMENT OF INSPECTIONS, LICENSES & PERMIT
3430 COURT HOUSE DRIVE, ELLICOTT CITY, MARYLAND 21043

B0011090

BUILDING ADDRESS (HOUSE NO., STREET, TOWN OR AREA)

5074 SHEPPARD LN
ELLICOTT CITY MD 21042GRADING/SEDIMENT CONTROL ☐ YES ☐ NO

SDP #

DESCRIPTION OF WORK AUTHORIZED

PLACEMENT OF MOBILE HOME
16 x 70 for Tenant

LOT NO.	PARCEL NO.	SEC.	AREA	BLOCK NO.	LIBER	FOLIO
	49	-	-	16	516	763
SUB DIVISION		ZONE	ZONE MAP	ELEC. DIST.	CENSUS TR.	
		DEU	28	5	6051.01	

OWNER NAME AND ADDRESS

PHONE NO.

BASSLER INC.
4994 SHEPPARD LN
ELLICOTT CITY MD

410-531-2193

SIZE OF BLDG.

FRONT

DEPTH

HEIGHT

16'

70'

12'

TYPE OF BLDG.

AREA

VOLUME

ROOF

B. ROOMS

ROOMS

BATHS

FIREPLACES

OCCUPANT'S NAME AND ADDRESS

PHONE NO.

ARCHITECT OR ENGINEER'S NAME AND ADDRESS

PHONE NO.

CONTRACTOR'S NAME AND ADDRESS

PHONE NO.

DAVID BASSLER
4990 SHEPPARD LA

410-977-2203

UTILITIES

WATER/WELL

SEWER/SEPTIC

GAS

ELECTRICITY

TYPE OF HEAT

AC

I have carefully examined and read this application and know the same is true and correct, and that is doing this work, all provisions of Howard County Ordinances and the State Laws of Maryland will be complied with, whether specified or not; and I will notify the Department of Inspections, and Permits twenty-four hours in advance when I am ready for the inspections called for elsewhere in the application; and that no work will be covered up until such inspections have been complied with.

EXISTING USE

PROPOSED USE

Farm

SF MOBILE HOME

EST. CONSTRUCTION COST

LICENSE NUMBER

PERMIT FEE

\$15,000.00

SIGNATURE

TITLE

4-15-98
DATE

W/S CODE

FOR OFFICE USE ONLY

DISTANCE IN FEET FROM R/W LINE TO FRONT BUILDING LINE

SIDE YARD

(DISTANCE IN FEET FROM SIDE BLDG. LINE TO SIDE PROPERTY LINE)

TO SIDE BUILDING LINE

DISTANCE IN FEET, REAR YD. REQUIRING SET

BACK (CORNER LOT ONLY)

SDP #

Check payable to: DIRECTOR OF FINANCE OF HOWARD COUNTY

CAUTION

To begin construction before a permit placard has been issued and displayed on the job is a violation of the law.

Use and occupancy permit must be applied for two weeks before it will be issued.

IMPORTANT: PLEASE SHOW ZIP CODES AND AREA CODES WHEREVER REQUIRED.

LP-69-591

FUNCTION	DATE	SIGNATURE APPROVAL
ZONING/PLANNING	X	
SHA		
SEDIMENT/GRADING		
BUILDING OFFICIAL	X	
WATER & SEWER		
HEALTH DEPT.	X 5/6/98	Blalby
FIRE PROTECTION		
STORM WATER MGMT.	X	

APPROVED

DATE

Distribution of Copies:
White - Building Official
Green - Planning and Zoning

Yellow - Engineering
Pink - Health Dept.
Gold - S.H.A.

R 3003



DEPARTMENT OF PLANNING & ZONING

Joseph W. Rutter, Jr., Director
November 20, 1996

Mr. David C. Bassler
12773 Folly Quarter Road
Ellicott City, MD 21042

RE: Farm Tenant Dwellings
4994 Sheppard Lane
Tax Map 28, Grid 12, Parcel 49

Dear Mr. Bassler:

This is in response to your letter dated June 7, 1995 and received November 14, 1996, requesting zoning approval for information on a farm tenant house or mobile home for the property referenced above. It is zoned RC-DEO (Rural Conservation-Density Exchange Option). In the Zoning Regulations for the RC district, farm tenant houses or mobile homes ("Farm Tenant Dwellings") are permitted as an accessory use on farm parcels, provided that the parcel is greater than or equal to 50 acres and that the maximum density for such farm tenant houses on a parcel is one unit for each 25 acres. This 429 acre parcel with a total of seven single-family houses does not exceed the density requirement.

The following provisions are applicable for all Farm Tenant Dwellings:

1. A Farm Tenant Dwelling shall be primarily occupied by a person who is actively employed in farm operations by the farm located on the parcel upon which the Farm Tenant Dwelling is located ("Farm Tenant"). The occupancy of a Farm Tenant Dwelling by the immediate family of the Farm Tenant, or other persons, is considered as an accessory to this primary occupancy.
2. A Farm Tenant Dwelling shall be occupied in perpetuity by a person who qualifies as a Farm Tenant, or by subsequent persons who so qualify. Any occupancy which does not conform with this provision voids the accessory use status of the dwelling as a Farm Tenant Dwelling and may require the removal of the dwelling from the parcel.


David C. Bassler
Page 2
November 20, 1996

3. A building permit application for a Farm Tenant Dwelling shall be made in the name of the farm owner or business entity for whom the Farm Tenant is an employee. Such a building permit shall expressly state that the proposed use either is an accessory farm tenant house or mobile home.

Provided the preceding provisions 1, 2 and 3 are followed, a mobile home is permitted as a Farm Tenant Dwelling at this property.

If you should have any further questions, please contact Ms. Dace Blaumani's, Planner I, at (410) 313-2393.

Sincerely,

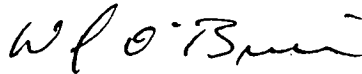

William F. O'Brien, Chief
Division of Comprehensive Planning
and Zoning Administration

DB
WFO/DB:vv
Enclosure

RECEIVED
SEP 19 1997

HOWARD COUNTY HEALTH DEPARTMENT
10001 CC CAMPBELL RD. ELICOTT CITY, MD 21043

David Bassler
Hayland Farm
5070 Sheppard Ln
Ellicott City, Md

9-22-97

We are requesting two mobil homes that could be served by a common septic and well on our farm. The mobil homes are each 2 bedroom and would be on a temporary basis (until future development)

PAY \$25 REPAIR FEE, TO TEST
TO EXPAND AREA AT TIME OF
SYSTEM INSTALLATION (CW)

FILED PAID
P 58984 (CW)

David Bassler

DAVE — UPON FURTHER DISCUSSION WITH YOU, IT IS
OUR UNDERSTANDING THAT "TEMPORARY" IS YOUR INTENT,
BUT CANNOT BE GUARANTEED BASED ON ANY EXISTING
LIMITATION ON YOUR PERMITS ON SITE PLAN.

THEREFORE 2 SEPARATE SEPTIC EASEMENTS MUST
BE ESTABLISHED TO SATISFY THE COMAN REQUIREMENT OF
10,000 SQ FT PER DWELLING UNIT.

AFTER THAT, THERE WOULD BE NO OBJECTION TO
A COMMON SUPPLY SINCE THE YIELD IS SUFFICIENT AND A COMMON
SEPTIC SYSTEM SINCE ALL ARE UNDER COMMON OWNERSHIP
AND THE USE IS NOT LIKELY TO BE LARGE. (CW) HAW CO. 10

* 9/22/97 MA BASSLER AGREED TO PROVIDE AN OPPORTUNITY FOR MONITORING THE FUNCTIONING
OF THIS SYSTEM - WILL INSTALL AT LEAST 1 MONITORING PIPE + ALLOW ANYTIME ACCESS

APPLICATION

PERCOLATION TESTING

A 57655

P _____

HOWARD COUNTY HEALTH DEPARTMENT

BUREAU OF ENVIRONMENTAL HEALTH

3525-H ELLICOTT MILLS DRIVE/ELLICOTT CITY, MARYLAND 21043
TELEPHONE: 313-2640

DISTRICT _____

DATE 1-29-98

TO: THE COUNTY HEALTH OFFICER
ELLICOTT CITY, MARYLAND

GO IN MAIN ENTRANCE
THRU TUNNEL INTO GRAVEL DRIVE
TOWARD "STUMP DUMP"

I HEREBY APPLY FOR THE NECESSARY TEST PRIOR TO APPLICATION FOR PERMIT TO CONSTRUCT (OR RECONSTRUCT) A SEWAGE DISPOSAL SYSTEM.

PROPERTY OWNER BASSLER'S INC

ADDRESS 4994 Sheppard Ln EC PHONE 410 531-2193

AGENT OR PROSPECTIVE BUYER NONE

ADDRESS _____ PHONE _____

PROPERTY LOCATION:

SUBDIVISION Hayland Farm LOT NO. _____

ROAD AND DESCRIPTION 4994 Sheppard Ln. ENTER ON GRAVEL TRUCK

ENTRANCE 9 1500' BACK ON LEFT

TAX MAP 28 PARCEL # 49

SIZE OF LOT 429.2 AC TYPE BLDG. 2 bedroom mobile home
(SINGLE FAMILY DWELLING OR COMMERCIAL)

THE SYSTEM INSTALLED UNDER THIS APPLICATION IS ACCEPTABLE ONLY UNTIL PUBLIC FACILITIES BECOME AVAILABLE. I FULLY UNDERSTAND THE

FEE CONNECTED WITH THE FILING OF THIS PERC TEST APPLICATION IS NON-REFUNDABLE UNDER ANY CIRCUMSTANCES. I ALSO AGREE TO

COMPLY WITH ALL M.O.S.H.A. REQUIREMENTS IN TESTING THIS LOT. David C Bassler
(SIGNATURE OF APPLICANT)

APPROVED BY [Signature] FOR _____ DATE 5/7/98

DISAPPROVED BY _____ FOR _____ DATE _____


HOLD PENDING FURTHER TESTS _____

REASONS FOR REJECTION OR HOLDING _____


PERCOLATION TEST PLAT/PRELIMINARY PLAT - TITLE OR I.D. # _____ DATE _____

SITE DEVELOPMENT PLAN/FINAL PLAT - TITLE OR I.D. # _____ DATE _____

THIS IS NOT A PERMIT

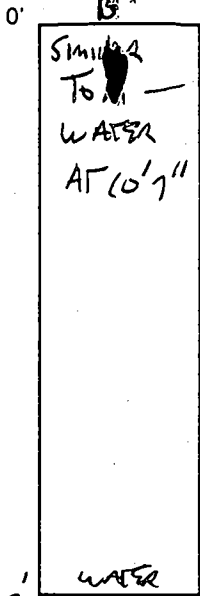

SOIL PROFILE

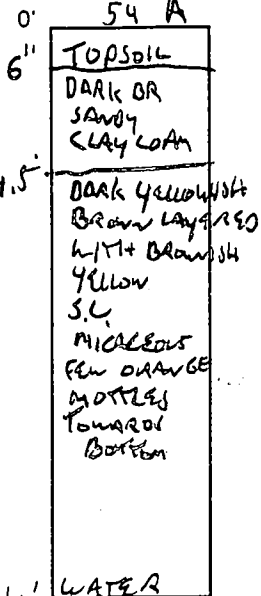

INDICATE NORTH - NAME ADJOINING ROADWAY AS BASE LINE.

DATE	TEST NO.	DEPTH	PRE-WET START	PRE-WET STOP	TEST - 1" DROP START	TEST - 1" DROP STOP	TIME
5/9/98	54A	5' / 11V	10:41	11:02	→	11:32	30 MIN
			10:57				
	54B	3' 9" / 167"	11:10	11:33	→	12:02	29 MIN
	54C	10V	H2O @ 9.5	ABANDONED BY APPLICANT			

REMARKS ^{AREA} PLANTED IN 3-6' CONIFERS, 1 AND 2, PERC OF 2/1/97 - PREVIOUSLY APPROVED

TYPE OF SOIL

TESTED BY G. SAVAGE ALSO PRESENT D. BASSLER

TRENCH DESIGN DATA: AVERAGE PERCOLATION TIME TRENCH WIDTH

INLET DEPTH MAXIMUM BOTTOM DEPTH SQ. FT./BEDROOM

APPLICATION

PERCOLATION TESTING

A 57655

P _____

HOWARD COUNTY HEALTH DEPARTMENT

BUREAU OF ENVIRONMENTAL HEALTH

3525-H ELLICOTT MILLS DRIVE/ELLICOTT CITY, MARYLAND 21043
TELEPHONE: 313-2640

DISTRICT _____

DATE 1-29-97

TO: THE COUNTY HEALTH OFFICER
ELLICOTT CITY, MARYLAND

GO IN MAIN ENTRANCE
THEN TURN ONTO GRAVEL DRIVE
TOWARD "STUMP DUMP"

I HEREBY APPLY FOR THE NECESSARY TEST PRIOR TO APPLICATION FOR PERMIT TO CONSTRUCT (OR RECONSTRUCT) A SEWAGE DISPOSAL SYSTEM.

PROPERTY OWNER Bassler's Inc

ADDRESS 4994 Sheppard Ln E.C PHONE 410 531-2193

AGENT OR PROSPECTIVE BUYER NONE

ADDRESS _____ PHONE _____

PROPERTY LOCATION:

~~SUBDIVISION~~ Hayland Farm LOT NO. _____

ROAD AND DESCRIPTION 4994 Sheppard Ln. ENTER ON GRAVEL TRUCK

ENTRANCE 9 1500' BACK ON LEFT

TAX MAP 28 PARCEL # 49

SIZE OF LOT 429.2 AC TYPE BLDG. 2 bedroom mobile home
(SINGLE FAMILY DWELLING OR COMMERCIAL)

THE SYSTEM INSTALLED UNDER THIS APPLICATION IS ACCEPTABLE ONLY UNTIL PUBLIC FACILITIES BECOME AVAILABLE. I FULLY UNDERSTAND THE
FEE CONNECTED WITH THE FILING OF THIS PERC TEST APPLICATION IS NON-REFUNDABLE UNDER ANY CIRCUMSTANCES. I ALSO AGREE TO
COMPLY WITH ALL M.O.S.H.A. REQUIREMENTS IN TESTING THIS LOT. David C Bassler
(SIGNATURE OF APPLICANT)

APPROVED BY _____ FOR _____ DATE _____

DISAPPROVED BY _____ FOR _____ DATE _____

HOLD PENDING FURTHER TESTS _____

REASONS FOR REJECTION OR HOLDING _____

PERCOLATION TEST PLAT/PRELIMINARY PLAT - TITLE OR I.D. # _____ DATE _____

SITE DEVELOPMENT PLAN/FINAL PLAT - TITLE OR I.D. # _____ DATE _____

THIS IS NOT A PERMIT

A57655

COUNTY #

SOIL PROFILE

①

0'	topsoil
1.0'	Clay Lm or/red/br
4.08'	Silty loam lt. tan/ orange 5-10% rock
11.0'	

②

0'	topsoil
1.0'	Clay Loam or/red/br
4.0'	Silty loam lt. tan/ orange 5-10% rock
11.5'	


③

0'	topsoil
1.0'	Clay loam or/red/br
4.0'	Silty loam lt. tan/ orange 5-10% rock
11.5'	

SOIL PROFILE

④

0'	topsoil
1.0'	Clay loam or/red/br
4.0'	lt. tan/ orange Silty loam 5-10% rock
11.5'	

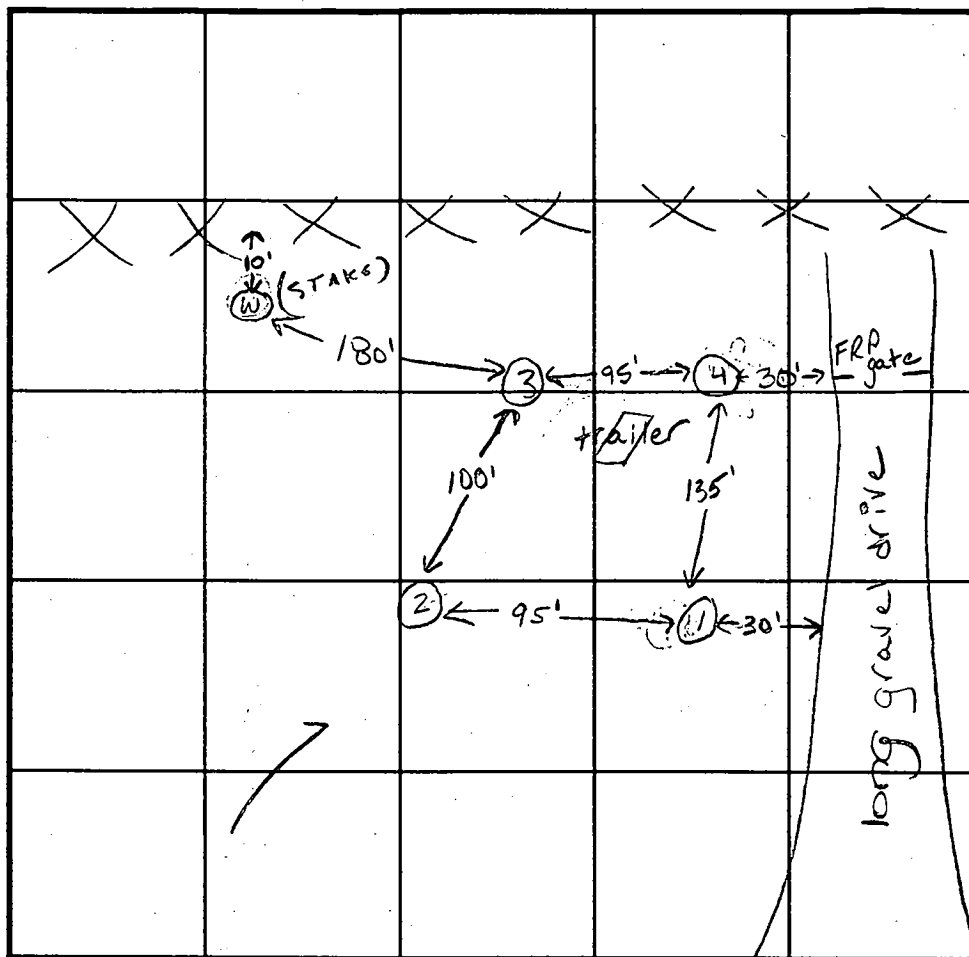

INDICATE NORTH - NAME ADJOINING ROADWAY AS BASE LINE.

Sheppard Lane

DATE	TEST NO.	DEPTH	PRE-WET		TEST - 1" DROP		TIME
			START	STOP	START	STOP	
2-21-97	1	4.0's	10:22	10:36	10:36	10:59	23 min
	1	11.0' d	visual ok - see profile				
	2	4.2"s	11:00	11:04	11:04	11:12	8 min
		11.5' d	visual ok - see profile				
	3	3.5's	10:40	10:47	10:47	11:01	14 min
		11.0' d	visual ok - see profile				
	4	3.5's	11:08	11:17	11:17	11:30	13 min
		11.5' d	visual ok - see profile				

REMARKS test holes not Staked, well site appraised at time of perc test

TYPE OF SOIL

TESTED BY D. Soe / K. Maiste

ALSO PRESENT Mr. Bassler

TRENCH DESIGN DATA: AVERAGE PERCOLATION TIME 74

TRENCH WIDTH 3'

INLET DEPTH 4.5'

MAXIMUM BOTTOM DEPTH 6.5'

SQ. FT./BEDROOM 210

C1		6007		SEQUENCE NO. (MDE USE ONLY)		STATE OF MARYLAND WELL COMPLETION REPORT FILL IN THIS FORM COMPLETELY PLEASE PRINT OR TYPE		THIS REPORT MUST BE SUBMITTED WITHIN 45 DAYS AFTER WELL IS COMPLETED.	
1 2 3 (THIS NUMBER IS TO BE PUNCHED IN COLS. 3-6 ON ALL CARDS)		DATE RECEIVED MM DD YY 8 13		DATE WELL COMPLETED MM DD YY 4 7 97		Depth of Well 22 265 26 (TO NEAREST FOOT)		COUNTY NUMBER A 57655	
ST/CO USE ONLY DATE RECEIVED MM DD YY 8 13		DATE WELL COMPLETED MM DD YY 4 7 97		Depth of Well 22 265 26 (TO NEAREST FOOT)		PERMIT NO. FROM "PERMIT TO DRILL WELL" HO-94-1095		28 29 30 31 32 33 34 35 36 37	
OWNER Bassler last name		Alfred first name		STREET OR RFD Sheppard Lane		TOWN Ellicott City		SUBDIVISION Nayland Farm	
SECTION		LOT		WELL LOG Not required for driven wells		GROUTING RECORD yes no WELL HAS BEEN GROUTED (Circle appropriate box) TYPE OF GROUTING MATERIAL (Circle one) CEMENT (CM) BENTONITE CLAY (BC) NO. OF BAGS 8 NO. OF POUNDS 800 GALLONS OF WATER 48 DEPTH OF GROUT SEAL (to nearest foot) from 0 ft. to 240 ft. (enter 0 if from surface)			
STATE THE KIND OF FORMATIONS PENETRATED, THEIR COLOR, DEPTH, THICKNESS AND IF WATER BEARING		DESCRIPTION (Use additional sheets if needed)		FEET FROM TO check if water bearing		Casing types insert appropriate code below STEEL (ST) CONCRETE (CO) PLASTIC (PL) OTHER (OT) MAIN CASING TYPE PL 6 26 Nominal diameter top (main) casing (nearest inch) Total depth of main casing (nearest foot)			
Top Soil 0 2 Sandy 2 15 Sandstone 15 18 MICKA 18 28 Sandstone 28 30 MICKA 30 140 Flint Rock 140 145 MICKA 145 265						OTHER CASING (if used) diameter inch depth (feet) from to SCREEN RECORD screen type or open hole insert appropriate code below STEEL (ST) BRASS (BR) OPEN HOLE (HO) BRONZE (PL) PLASTIC (OT) OTHER (OT)			
NUMBER OF UNSUCCESSFUL WELLS: 0		WELL HYDROFRACTURED yes (Y) no (N)		CIRCLE APPROPRIATE LETTER A A WELL WAS ABANDONED AND SEALED WHEN THIS WELL WAS COMPLETED E ELECTRIC LOG OBTAINED P TEST WELL CONVERTED TO PRODUCTION WELL		DEPTH (nearest ft.) HO 24 265 EACH CASING 1 8 9 11 15 17 21 2 23 24 26 30 32 36 3 38 39 41 45 47 51 SLOT SIZE 1 2 3 DIAMETER OF SCREEN (NEAREST INCH) 56 60 from to			
DRILLERS LIC. NO. M S D 116 Ralph Mayne DRILLERS SIGNATURE (MUST MATCH SIGNATURE ON APPLICATION)		LIC. NO. M S D 117 Ralph E. Mayne		SITE SUPERVISOR (sign. of driller or journeyman responsible for sitework if different from permittee)		MDE USE ONLY (NOT TO BE FILLED IN BY DRILLER) T (E.R.O.S.) W Q 70 72 74 75 76 TELESCOPE CASING LOG INDICATOR OTHER DATA			
LOCATION OF WELL ON LOT SHOW PERMANENT STRUCTURE SUCH AS BUILDING, SEPTIC TANKS, AND /OR LANDMARKS AND INDICATE NOT LESS THAN TWO DISTANCES (MEASUREMENTS TO WELL)		PUMP INSTALLED DRILLER WILL INSTALL PUMP YES (YES) NO (NO) IF DRILLER INSTALLS PUMP, THIS SECTION MUST BE COMPLETED FOR ALL WELLS. TYPE OF PUMP INSTALLED PLACE (A,C,J,P,R,S,T,O) IN BOX 29 CAPACITY: GALLONS PER MINUTE (to nearest gallon) 31 35 PUMP HORSE POWER 37 41 PUMP COLUMN LENGTH (nearest ft.) 43 47 CASING HEIGHT (circle appropriate box and enter casing height) + above } LAND SURFACE - below } 2 (nearest foot)		PUMPING TEST HOURS PUMPED (nearest hour) 3 PUMPING RATE (gal. per min.) 10 METHOD USED TO MEASURE PUMPING RATE: Bucket WATER LEVEL (distance from land surface) BEFORE PUMPING 29 ft. WHEN PUMPING 55 ft. TYPE OF PUMP USED (for test) A air P piston T turbine C centrifugal R rotary O other (describe below) J jet S submersible		COUNTY			

Owner Bassler

Static water level (S.W.L.) below M.P. 29

Total time 15 min to reach pumping water level 55 ft. below M.P.

HD-224 26th Casing 240 pen 8 Bays

B 1 <div style="border: 1px solid black; padding: 2px; display: inline-block;">8277</div>	SEQUENCE NO. (MDE USE ONLY)	STATE OF MARYLAND PERMIT TO DRILL WELL please print or type	STATE PERMIT NUMBER <div style="border: 1px solid black; padding: 2px; display: inline-block;">HD-94-1095</div>
Date Received (APA) <div style="border: 1px solid black; padding: 2px; display: inline-block;">32797</div>		B 3 LOCATION OF WELL	
OWNER INFORMATION <div style="border: 1px solid black; padding: 2px; display: inline-block;">BASSLER ALFRED</div>		<div style="border: 1px solid black; padding: 2px; display: inline-block;">HOWARD</div>	
<div style="border: 1px solid black; padding: 2px; display: inline-block;">4994 SHEPPARD LA</div>		<div style="border: 1px solid black; padding: 2px; display: inline-block;">HAYLAND FARM</div>	
<div style="border: 1px solid black; padding: 2px; display: inline-block;">ELLICOTT CITY MD 21042</div>		<div style="border: 1px solid black; padding: 2px; display: inline-block;">CLARKSON ETC</div>	
DRILLER INFORMATION Driller's Name: <u>Ralph Mayne</u> Firm Name: <u>Ralph Mayne Well Drilling</u> Address: <u>9120 Brown Church Rd. Mt. Airy</u> Signature: <u>Ralph Mayne</u> Date: <u>3/27/97</u>		52 NEAREST TOWN <div style="border: 1px solid black; padding: 2px; display: inline-block;">2 MI</div>	
B 2 WELL INFORMATION APPROX. PUMPING RATE (GAL. PER MIN.) <u>5</u> AVERAGE DAILY QUANTITY NEEDED (GAL. PER DAY) <u>500</u>		B 4 DIRECTION OF WELL FROM TOWN (CIRCLE BOX) 	
USE FOR WATER (CIRCLE APPROPRIATE BOX) <input checked="" type="checkbox"/> D HOME (SINGLE OR DOUBLE HOUSEHOLD UNIT ONLY) <input type="checkbox"/> F FARMING (LIVESTOCK WATERING & AGRICULTURAL IRRIGATION) <input type="checkbox"/> I INDUSTRIAL, COMMERCIAL, STATE AND FEDERAL GOV. OTHER (REQUIRES APPROPRIATION PERMIT) <input type="checkbox"/> P PUBLIC OR PRIVATE WATER COMPANY (REQUIRES APPROPRIATION PERMIT AND STATE HEALTH DEPARTMENT APPROVAL) <input type="checkbox"/> T TEST, OBSERVATION, MONITORING (MAY REQUIRE APPROPRIATION PERMIT)		ON WHICH SIDE OF ROAD (CIRCLE APPROPRIATE BOX) <div style="border: 1px solid black; padding: 2px; display: inline-block;">1200</div> DISTANCE FROM ROAD ENTER FT OR MI <u>42</u>	
APPROXIMATE DEPTH OF WELL <u>1150</u> FEET APPROXIMATE DIAMETER OF WELL <u>6"</u> INCH		NOT TO BE FILLED IN BY DRILLER HEALTH DEPARTMENT APPROVAL <u>Howard</u> COUNTY NAME <u>AS 7655</u> COUNTY NO. STATE SIGNATURE _____ DATE ISSUED <u>4/1/98</u> <div style="border: 1px solid black; padding: 2px; display: inline-block;">040297</div> SIGNATURE <u>Southern</u> EXP. DATE NORTH GRID <u>511000</u> EAST GRID <u>0813000</u>	
METHOD OF DRILLING (circle one) <input checked="" type="checkbox"/> BORED (or Augered) <input type="checkbox"/> JETTED <input type="checkbox"/> Jetted & DRIVEN <input checked="" type="checkbox"/> AIR-ROTARY <input type="checkbox"/> AIR-PERCussion <input type="checkbox"/> ROTARY (Hydraulic Rotary) <input type="checkbox"/> CABLE <input type="checkbox"/> REVERSE-ROTARY <input type="checkbox"/> Drive-POINT other _____		SHOW MAJOR FEATURES OF BOX & LOCATE WELL WITH AN X SOURCES OF DRILLING WATER 1. well 2. 3. WRITE THE BOX NUMBER FROM THE MAP HERE <div style="border: 1px solid black; padding: 2px; display: inline-block;">8123</div> <div style="border: 1px solid black; padding: 2px; display: inline-block;">50011</div>	
REPLACEMENT OR DEEPEMED WELLS (CIRCLE APPROPRIATE BOX) <input checked="" type="checkbox"/> N THIS WELL WILL NOT REPLACE AN EXISTING WELL <input type="checkbox"/> Y THIS WELL WILL REPLACE A WELL THAT WILL BE ABANDONED AND SEALED <input type="checkbox"/> S THIS WELL WILL REPLACE A WELL THAT WILL BE USED AS A STANDBY-CONTACT LOCAL APPROVING AUTHORITY FOR POLICY ON STANDBY WELLS <input type="checkbox"/> D THIS WELL WILL DEEPEMED AN EXISTING WELL PERMIT NUMBER OF WELL TO BE REPLACED OR DEEPEMED (IF AVAILABLE) <u>15-75</u>		DRAW A SKETCH BELOW SHOWING LOCATION OF WELL IN RELATION TO NEARBY TOWNS AND ROADS AND GIVE DISTANCE FROM WELL TO NEAREST ROAD JUNCTION 	
Not to be filled in by driller (MDE OR COUNTY USE ONLY) APPROP. PERMIT NUMBER <u>GAP</u> FORCE <u>DS</u> WRITE INITIALS IN BOX PERMIT NO. <u>HD-94-1095</u>			
SPECIAL CONDITIONS NOTE - APPROVING AUTHORITIES SHOULD USE SEPARATE SHEET IF NEEDED			

Pump test
9:30 (3hrs)

Well Permit No. HO - 94-1095
Location of property (road) Sheppard Lane
Subdivision Nayland Farm Lot Block Plat Sec.
Well Driller R. Mayne Owner Bassler

Depth of well 265'
Distance of measuring point (M.P.) above ground 2'
Static water level (S.W.L.) below M.P. 29'

Time pump started 8:30 Pumping rate 12 gpm
Total time 15 min to reach pumping water level 55 ft. below M.P.

[illegible]

DEED CALLS


L1	N 85°20'10" V	2803.6'
L2	S 43°36'50" V	161.2'
L3	N 84°32'45" V	780.3'
L4	N 40°42'20" V	3564.8'
L5	N 50°45'40" E	176.6'
L6	N 06°20'40" E	176.5'
L7	N 18°57'20" E	396.0'
L8	N 00°57'20" E	100.1'
L9	N 11°26'34" V	1167.3'
L10	N 26°38'10" V	156.7'
L11	N 31°59'44" E	585.4'
L12	S 53°33'02" E	658.9'
L13	N 82°03'17" E	155.1'
L14	N 13°56'43" V	611.3'
L15	N 70°08'47" E	230.3'
L16	S 41°34'46" E	1177.8'
L17	N 54°49'30" E	119.6'
L18	S 57°25'30" E	3943.5'
L19	N 38°15'10" E	1122.8'
L20	S 12°54'37" E	233.9'
L21	S 11°13'40" E	3052.5'
L22	S 78°24'10" V	680.5'
L23	S 11°35'50" E	351.6'

L. R. MOBLEY DEED CALLS

L1	S 87°48'00" V	300.5'
L2	N 52°18'40" V	586.2'
L3	N 47°47'00" E	418.0'
L4	N 89°28'20" E	170.5'
L5	S 35°09'40" E	886.0'
L6	S 27°41'00" V	110.9'

BASSLER FARM
LIBER 516/F763
508.3 ACRES

4/2/97.
well site
OK - site insp.
made at time
of perc.
DKS

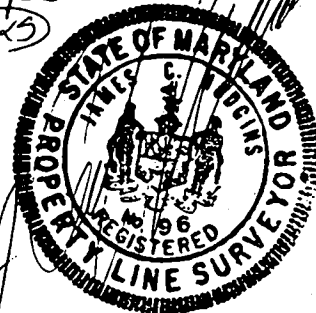

APPROVED: FOR PRIVATE WATER AND SEWER
HOWARD COUNTY HEALTH DEPARTMENT

HOWARD COUNTY HEALTH OFFICER DATE


PERCOLATION CERTIFICATION PLAT
HAYLAND FARM SHEPPARD LANE
APPLICATION # 57655
5TH ELECTION DISTRICT
HOWARD COUNTY, MARYLAND
SCALE 1"=1200' & 1"=100'
DATE MARCH 13 1997

NTT ASSOCIATES, INC.
16205 OLD FREDERICK ROAD
MT. AIRY, MARYLAND 21771
PH. 410 442 2031
FAX 410 442 1315

This area designates a private sewage easement of approximately 10,000 square feet as required by the Maryland State Department of Health and Mental Hygiene for individual sewage disposal. Improvements of any nature in this area are restricted until public sewerage is available and servicing any residential structures constructed on this building site. These easements shall become null and void upon connection to a public sewage system. The County Health Officer shall have the authority to grant variances for encroachments into the private sewage easement. Recordation of a modified sewage easement shall not be necessary.

All percolation test holes have been field located and shown thus

All wells and septic systems within 100' of property line have been shown.

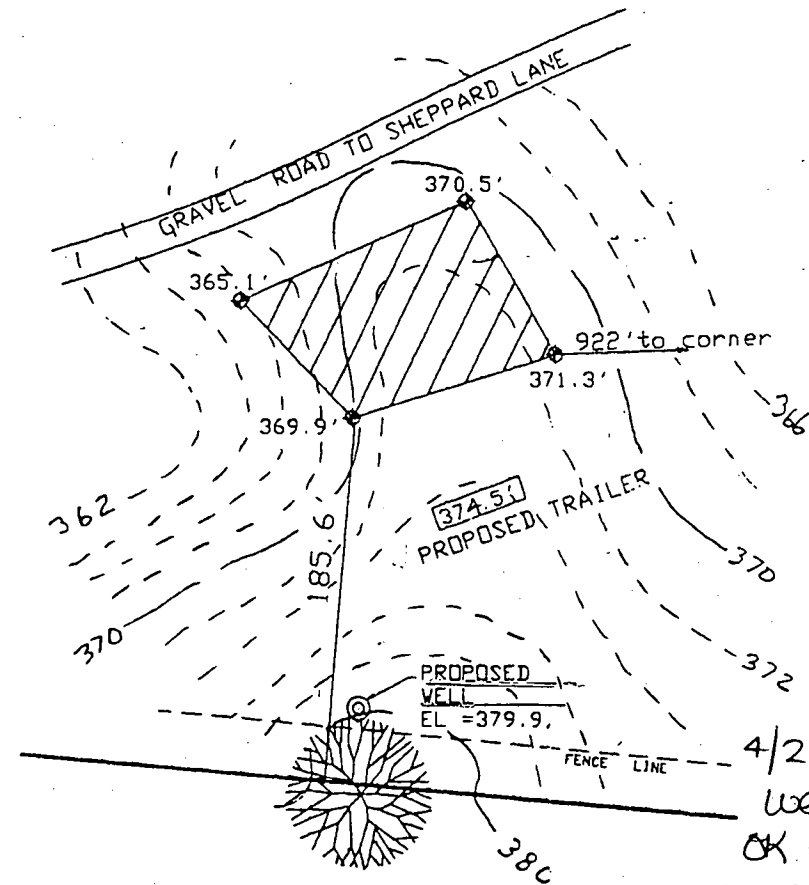

HOWARD COUNTY HEALTH DEPARTMENT
Bureau of Environmental Health
3525-H Ellicott Mills Drive
Ellicott City, MD 21043

~~461-9939~~ 313-2640 313-2648 (fax)

APPLICATION FOR PITLESS ADAPTER, WELL PUMP AND PRESSURE TANK INSTALLATION

New Installation X
Replacement _____

Receipt # _____
Date 5-20-97

Name of Installer Robert Thurman

Telephone 410-531-1724

License Number 17380

Certified Well Pump Installer _____ Well Driller _____ Registered Plumber X

Name of Property Owner Bassler Inc.

Telephone 410-531-3589

Subdivision _____ Lot # _____

Well Tag # 40-94-1095

Site Address 5070 SHEPPARD LN E.C. 21042

Pump

1. Type

- a. Deep well jet _____
b. Shallow well jet _____
c. Submersible X

2. Make JACUZZI

3. Model # 75410 R1152

4. Capacity 10 GPM

5. Pump exceeds well capacity Yes _____ No X

6. If Yes, is low pressure cutoff switch installed? Yes X No _____

7. What methods are used to protect the pump and electrical wiring from vibrations? Torque arrestors _____ Cable guards X Other _____

Motor

1. Horsepower 3/4

2. RPM 3450

3. Voltage _____

a. 110 _____

b. 220 X

Pitless Adapter

1. Make _____

2. Model # 1"

3. Depth 48"

Tank

1. Capacity X-TAOC

2. Pressure relief valve? YES

Piping

1. Type POLY

2. Size 1"

3. NSF and/or BOCA Code approved _____

4. Depth of supply line 46'

Well data

1. Depth 265 ft.

2. Yield 10 GPM

3. Static water level 29 ft.

4. Will water supply be disinfected by installer? YES

I understand that it is my responsibility to notify the Howard County Health Department when the installation is ready for inspection (otherwise this permit is null and void).

All information given above is true to the best of my knowledge.

Signature of Applicant: David Smith

Date: 5-20-97


Note: A sticker indicating approval/status of the installation will be placed on the well casing at the time of the inspection.

DEED CALLS

L1	N 05°20'10" V	2803.6'
L2	S 43°36'30" V	161.8'
L3	N 04°32'45" V	788.3'
L4	N 48°48'20" V	2544.0'
L5	N 58°45'40" E	176.6'
L6	N 06°20'40" E	176.5'
L7	N 18°37'20" E	396.0'
L8	N 00°57'20" E	100.1'
L9	N 11°26'34" V	1167.3'
L10	N 26°38'10" V	156.7'
L11	N 31°59'44" E	583.4'
L12	S 55°53'02" E	658.9'
L13	N 82°03'17" E	153.1'
L14	N 13°56'43" V	611.3'
L15	N 70°08'47" E	230.3'
L16	S 41°34'46" E	1177.8'
L17	N 54°49'30" E	119.6'
L18	S 37°25'30" E	3943.5'
L19	N 38°15'10" E	1122.0'
L20	S 12°34'37" E	233.9'
L21	S 11°13'40" E	3032.5'
L22	S 78°24'10" V	680.5'
L23	S 11°35'50" E	351.6'

L. R. HUBLEY DEED CALLS

L1	S 87°40'00" V	328.8'
L2	N 63°18'40" V	358.8'
L3	N 47°47'20" E	418.8'
L4	N 09°00'00" E	178.3'
L5	S 35°08'40" E	884.8'
L6	S 87°40'00" V	118.8'

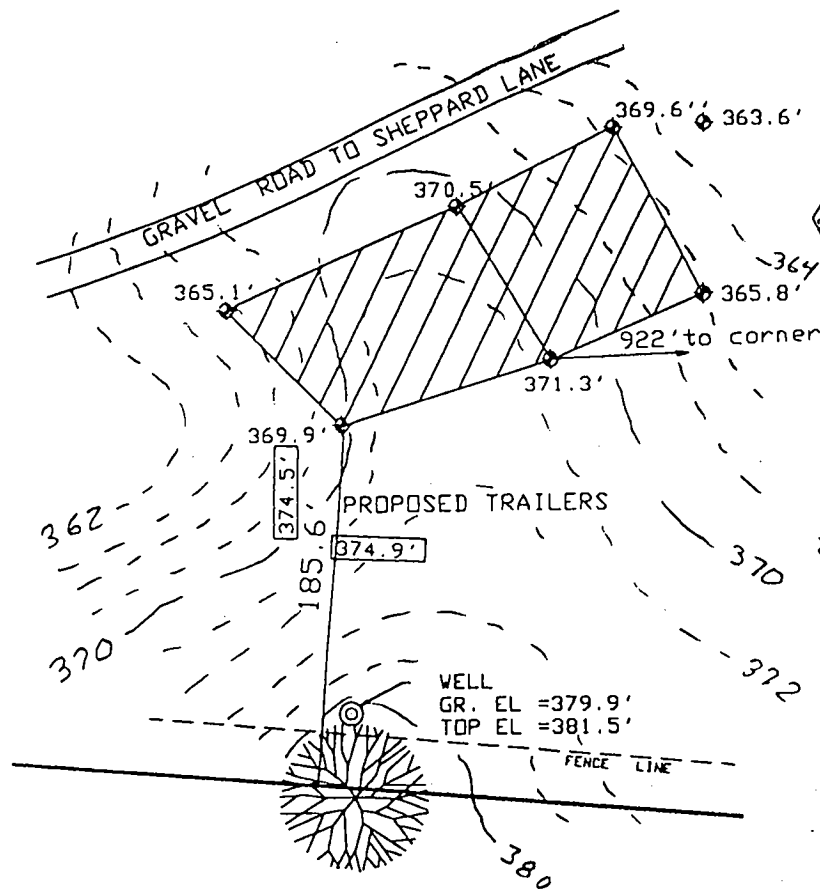


BASSLER FARM
LIBER 516/F763
508.3 ACRES

PERC TEST SITE

GRAVEL ROAD TO SHEPPARD LANE
922'

PERCOLATION CERTIFICATION PLAT
HAYLAND FARM SHEPPARD LANE
APPLICATION # 57655
5TH ELECTION DISTRICT
HOWARD COUNTY, MARYLAND
SCALE 1"=1200' & 1"=100'
DATE AUGUST 7, 1998

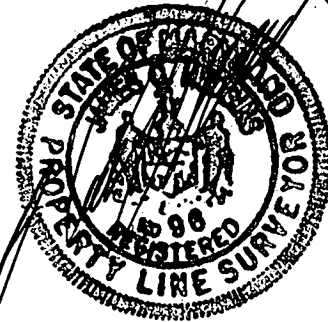

APPROVED FOR PRIVATE WATER AND SEWER
HOWARD COUNTY HEALTH DEPARTMENT

John Bradley 10-23-98
HOWARD COUNTY HEALTH OFFICER DATE

NTT ASSOCIATES, INC.
16205 OLD FREDERICK ROAD
MT. AIRY, MARYLAND 21771
PH. 410 442 2031
FAX 410 442 1315

This area designates a private sewage easement of approximately 20,000 square feet as required by the Maryland State Department of The Environment for individual sewage disposal. Improvements of any nature in this area are restricted until public sewerage is available and servicing any residential structures constructed on this building site. These easements shall become null and void upon connection to a public sewage system. The County Health Officer shall have the authority to grant variances for encroachments into the private sewage easement. Recordation of a modified sewage easement shall not be necessary. All percolation test holes have been field located and shown thus

All wells and septic systems within 100' of property line have been shown.
APPROXIMATELY 20,000 SQ. FT. OF SEWAGE AREA DEDICATED TO SEWER TWO RESIDENCES

DEED CALLS

L1	N 85°20'10" V	2803.6'
L2	S 45°36'50" V	161.2'
L3	N 84°32'45" V	780.3'
L4	N 40°42'20" V	3564.8'
L5	N 50°43'40" E	176.6'
L6	N 06°20'40" E	176.5'
L7	N 18°57'20" E	396.0'
L8	N 00°57'20" E	100.1'
L9	N 11°26'34" V	1167.3'
L10	N 26°38'10" V	156.7'
L11	N 31°39'44" E	585.4'
L12	S 55°53'02" E	658.9'
L13	N 82°03'17" E	155.1'
L14	N 13°56'43" V	611.3'
L15	N 70°08'47" E	230.3'
L16	S 41°34'46" E	1177.8'
L17	N 54°49'30" E	119.6'
L18	S 57°25'30" E	3943.5'
L19	N 38°15'10" E	1122.0'
L20	S 12°54'37" E	233.9'
L21	S 11°13'40" E	3052.5'
L22	S 78°24'10" V	680.5'
L23	S 11°35'50" E	351.6'

L. R. MOBLEY DEED CALLS

L1	S 87°48'00" V	220.8'
L2	N 63°18'45" V	800.0'
L3	N 47°17'00" E	418.0'
L4	N 09°08'20" E	178.8'
L5	S 35°29'49" E	800.0'
L6	S 27°48'20" V	118.9'

BASSLER FARM
LIBER 516/F763
508.3 ACRES





APPROVED: FOR PRIVATE WATER AND SEWER
HOWARD COUNTY HEALTH DEPARTMENT

John M. Boykin 4.9.97
HOWARD COUNTY HEALTH OFFICER DATE

PERCOLATION CERTIFICATION PLAT
HAYLAND FARM SHEPPARD LANE
APPLICATION # 57655
5TH ELECTION DISTRICT
HOWARD COUNTY, MARYLAND
SCALE 1"=1200' & 1"=100'
DATE MARCH 13 1997

NTT ASSOCIATES, INC.
16205 OLD FREDERICK ROAD
MT. AIRY, MARYLAND 21771
PH. 410 442 2031
FAX 410 442 1315

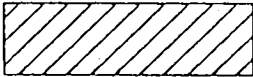 This area designates a private sewage easement of approximately 10,000 square feet as required by the Maryland State Department of The Environment for individual sewage disposal. Improvements of any nature in this area are restricted until public sewerage is available and servicing any residential structures constructed on this building site. These easements shall become null and void upon connection to a public sewage system. The County Health Officer shall have the authority to grant variances for encroachments into the private sewage easement. Recordation of a modified sewage easement shall not be necessary. All percolation test holes have been field located and shown thus 

All wells and septic systems within 100' of property line have been shown.

