

7/25/96
11:00

PERMIT

SEWAGE DISPOSAL SYSTEM

DEPARTMENT OF HEALTH AND MENTAL HYGIENE

HOWARD COUNTY HEALTH DEPARTMENT

BUREAU OF ENVIRONMENTAL HEALTH

461-9933

313-2640

05-380960

INDEXED

P 57041

A REPAIR

DISTRICT _____

DATE 7/23/96

DATE SYSTEM APPROVED 7-25-96

INSPECTOR DKS

Jack Fyock Septic Service

IS PERMITTED TO INSTALL _____ ALTER X

ADDRESS 13775 Triadelphia Road Glenelg, MD 21737 PHONE 988-9270

SUBDIVISION The Heritage LOT 62 ROAD 4128 Sharp Road

PROPERTY OWNER Roy David Weaver

ADDRESS _____

SEPTIC TANK CAPACITY 1000 GALLONS

NUMBER OF BEDROOMS 3

125 SQUARE FEET PER BEDROOM

LINEAR FEET OF TRENCH REQUIRED 63'±

REPAIR - PURPOSE - DRYWELL IS FULL SYSTEM FAILING

Call for inspection when ground is opened so sanitarian can recommend repair.

Install trench off existing system on contour.

PLANS APPROVED BY Donna K. Goe DATE 7/25/96 vr/

COVER NO WORK UNTIL INSPECTED AND APPROVED

NEITHER THE HOWARD COUNTY COUNCIL NOR THE HEALTH DEPARTMENT IS RESPONSIBLE FOR THE SUCCESSFUL OPERATION OF ANY SYSTEM

NOTE: CLEANOUT REQUIRED EVERY 70 FEET OF SEWER LINE AND/OR AT 90° SWEEPS IN LINES FROM HOUSE TO DRAIN FIELDS, 90° ELBOWS NOT ACCEPTABLE.

NOTE: ALL PARTS OF SEPTIC SYSTEMS (I.E. TANK, DISTRIBUTION BOX TRENCHES) TO BE 100 FEET FROM WELL (UNLESS OTHERWISE SPECIFICALLY AUTHORIZED)

NOTE: IF DEEP TRENCH(ES) ARE USED CALL FOR INSPECTION BEFORE AND AFTER PLACING GRAVEL IN TRENCH(ES)

NOTE: NO DRY WELL SHALL EXCEED 15 FOOT IN DIAMETER NO ABSORPTION TRENCH TO EXCEED 100 FEET IN LENGTH

NOTE: ALL PIPE FROM HOUSE TO SEPTIC TANK MUST BE CAST IRON OR SCHEDULE 35/40 PVC OR ABS


PERMIT VOID AFTER TWO YEARS

NOTE: INSTALL STAND PIPE ON SEPTIC TANK AND DRY WELL STAND PIPES MUST BE 6 INCHES IN DIAMETER CAST IRON, CONCRETE OR TERRA COTTA OR PVA OR ABS ACCEPTED. IF TOP OF SEPTIC TANK IS DEEPER THAN 3 FEET, MANHOLE TO GRADE REQUIRED.

NOTE: DISTRIBUTION BOXES MUST HAVE BAFFLES

*INSTALLER IS RESPONSIBLE FOR OBTAINING FINAL APPROVAL ON THIS PERMIT

A 57041

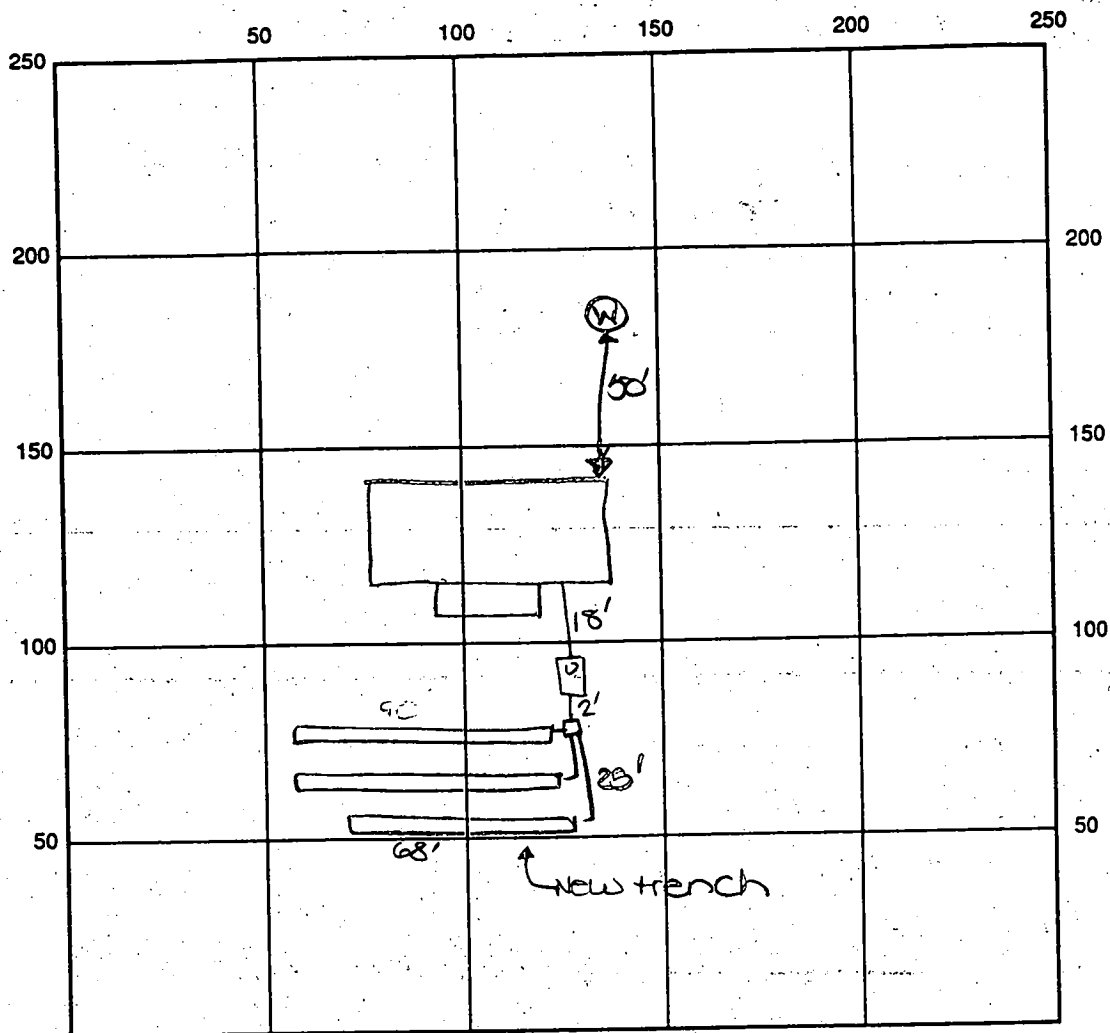

INDICATE NORTH - NAME ADJOINING ROADWAY AS BASE LINE

Sharp Road

SEPTIC TANK LEVEL Existing CLEANOUTS Existing

DISTRIBUTION BOX LEVEL Existing

DRAIN FIELD/TITLE DEPTH 10 FT. TRENCH WIDTH 2 FT. INLET DEPTH 4 FT.

EFFECTIVE GRAVEL DEPTH 6 FT. TOTAL LENGTH 68 FT.

NUMBER OF TRENCHES 1 ONE SIDEWALL ~~BOTTOM~~ AREA 408 SQ. FT. Existing

DRYWALL INSIDE DIAMETER FT. EFFECTIVE DEPTH BELOW INLET FT.

ABSORBENT AREA 408 SQ. FT. Existing

REMARKS: 7/25/96 FINAL - OK TO COVER ALL WORK. DKS

DATE SYSTEM APPROVED

7/25/96

INSPECTOR

S. J. M. & S. J. S.

W.P.T.
11-25-85
PERMIT

SEWAGE DISPOSAL SYSTEM

MARYLAND STATE DEPARTMENT OF HEALTH

HOWARD COUNTY
BUREAU OF ENVIRONMENTAL HEALTH
992-2330

INDEXED

ELLICOTT CITY

DISTRICT _____

DATE 4/22/85

Tim Rollan

IS PERMITTED TO INSTALL ☒ ALTER _____

ADDRESS 11974 Route 216, Fulton, Maryland 20759 PHONE 725-2397

SUBDIVISION The Heritage ROAD 4128 Sharp Road LOT 62

PROPERTY OWNER Roy David Weaver

ADDRESS _____

IF GARBAGE GRINDER IS USED INCREASE SEPTIC TANK CAPACITY BY 50% AND ABSORPTION AREA BY 22%.

GARBAGE GRINDER? YES _____ NO ☒

SEPTIC TANK CAPACITY 1000 GALLONS NUMBER OF BEDROOMS 1

TRENCHES - 180 sq. ft. per bedroom. Trench to be 3 feet wide. Inlet 2 1/2 feet below original grade. Bottom maximum depth 4 feet below original grade. Effective area begins at 3 feet below original grade. 1 1/2 feet of stone below distribution pipe. LOCATION: Start the first trench 115 feet from the front property line and 20 feet from the left property line as seen when facing the property from Sharp Road. NOTE: No trench to exceed 100 feet in length. If more than one trench used, a distribution box is required. Trenches to be installed on level ground. Call for inspection of trench(s) before and after gravel is installed. Provide 6" - 8" diameter cleanout and cap to grade or above on septic tank.

PLANS APPROVED BY C. Williams DATE 4/22/85

COVER NO WORK UNTIL INSPECTED AND APPROVED

NEITHER THE HOWARD COUNTY COUNCIL NOR THE HEALTH DEPARTMENT IS RESPONSIBLE FOR THE SUCCESSFUL OPERATION OF ANY SYSTEM.

NOTE IF TRENCH IS USED CALL FOR INSPECTION BEFORE AND AFTER PLACING GRAVEL IN TRENCH

NOTE NO DRY WELL SHALL EXCEED 15 FOOT IN DIAMETER. NO ABSORPTION TRENCH TO EXCEED 100 FEET IN LENGTH

NOTE ALL PIPE FROM HOUSE TO SEPTIC TANK MUST BE CAST IRON OR SCHEDULE 40 PVC OR ABS.

REPAIR VOID AFTER THREE YEARS


NOTE INSTALL STAND PIPES ON SEPTIC TANK AND DRY WELL. STAND PIPES MUST BE 6 INCHES IN DIAMETER. CAST IRON, CONCRETE OR TERRA COTTA. OR TWO OR ARE ACCEPTED IF TOP OF SEPTIC TANK IS DEEPER THAN 3 FEET MANHOLE TO GRADE REQUIRED

INSTALLER IS RESPONSIBLE FOR OBTAINING FINAL APPROVAL ON THIS PERMIT

CALL 992-2330 FOR INSPECTION OF SEPTIC SYSTEMS.

EH - 7-1082

A 22411

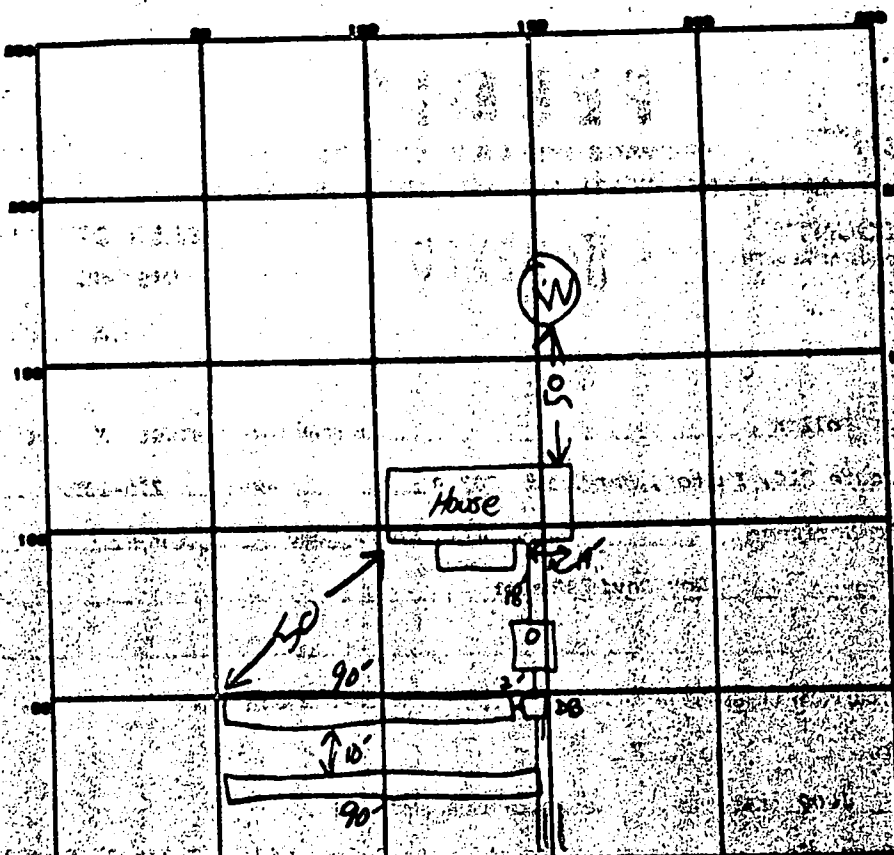

INDICATE NORTH - NAME ADJOINING ROADWAY AS SIDE LINE

SHARP Rd.

PERMIT CARD

SEPTIC TANK LEVEL ✓ 2500

CLEANOUTS STV

OK 4/25/85

DISTRIBUTION BOX LEVEL ✓

TILE FIELD, DEPTH 4.5 FT. TRENCH WIDTH 40 inches

TAKE 3'

GRAVEL DEPTH 18 IN. TOTAL LENGTH 180

NUMBER OF TRENCHES 2 TOTAL BOTTOM AREA 594

KEEPAGE PITS, INSIDE DIAMETER — FT. DEPTH BELOW INLET — FT.

ABSORBENT AREA 594 SQ. FT.

REMARKS 4-24-85 OK TO CONTINUE WORK, TRENCH INLET SLIGHTLY WIDER ROUTE

OUTLET FROM HOUSE LOWER THAN EXISTED, NEED PIPE IN BOTH TRENCHES AND CEMENT

AROUND CLEANOUT. SMO-1

4/25/85 PIPE PUT IN TRENCHES & CLEANOUT
PUT ON TANK

DATE SYSTEM APPROVED

4/25/85

INSPECTOR

Raymond Hodge

4-12' Lot
10,000 ft.

APPLICATION

22411

Laboratory

SEWAGE DISPOSAL TESTING

STATE OF MARYLAND - DEPARTMENT OF HEALTH AND MENTAL HYGIENE

HOWARD COUNTY HEALTH DEPARTMENT
ENVIRONMENTAL HEALTH SERVICES

P. O. BOX 476, ELLICOTT CITY, MARYLAND 21043
TELEPHONE: 485-5600, EXT. 355

DISTRICT 5

DATE 10/27/75

TO: THE COUNTY HEALTH OFFICER
ELLICOTT CITY, MARYLAND

I, HEREBY, APPLY FOR THE NECESSARY TEST IN ORDER TO CONSTRUCT (OR RECONSTRUCT) A SEWAGE DISPOSAL SYSTEM.

PROPERTY OWNER 7440 Squire Street, The Town Co.

ADDRESS Roy David Weaver
4444 Sharp Road
Laurel, Maryland

PHONE H-776-0212
W-237-5700

PROPERTY LOCATION:

SUBDIVISION 7440 Squire Street LOT NO. 989

ROAD AND DESCRIPTION 4428 Sharp Road

SIZE OF LOT _____ TYPE BLDG. 1 and 1/2

IF NOT SINGLE RESIDENCE DESCRIBE _____

THE SYSTEM INSTALLED UNDER THIS APPLICATION IS ACCEPTABLE ONLY UNTIL PUBLIC FACILITIES BECOME AVAILABLE.

SIGNATURE OF APPLICANT Roy David Weaver

APPROVED BY _____ FOR _____ DATE _____
(KIND OF SYSTEM)

REJECTED BY _____ FOR _____ DATE _____
(KIND OF SYSTEM)



HOLD PENDING FURTHER TESTS _____ DATE _____

REASONS FOR REJECTION OR HOLDING _____

BLDG. PERMIT SIGNED
AND RETURNED 10/27/75

THIS IS NOT A PERMIT

~~87~~
~~79~~
new 62

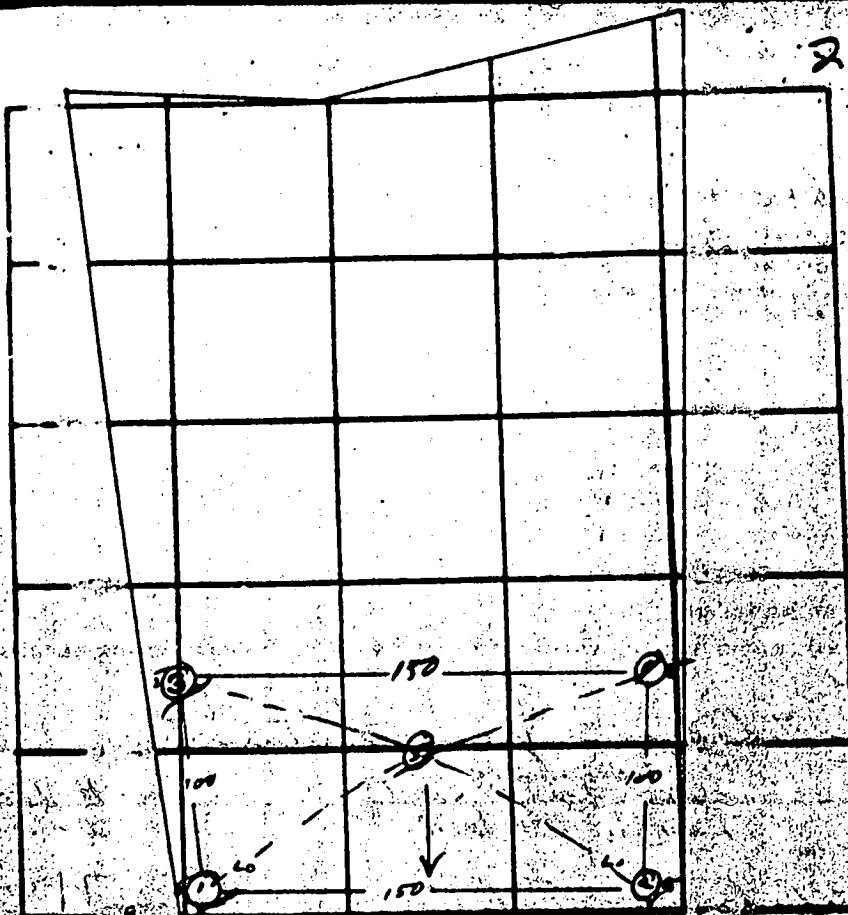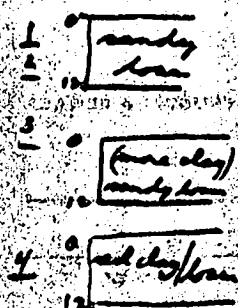

DIRECTION NORTH - NAME ADJOINING ROADWAY AS SHOWN ON

DATE	TEST NO.	DEPTH	PRE-WET		TEST - 1" DROP		TIME
			START	STOP	START	STOP	
5/13	1	2	2	5	5	11	6
	1A	6	2	10	10	21	11
	(1B)	(12)	water	12	—	—	—
	2	2	0	4	4	6	2
	2A	7	0	4	4	6	2
	2B	12	0	6	6	26	20
5/14	3	2	2	6	6	17	8
	3A	6	1	8	8	19	8
	3B	13	0	7	7	18	11
	4	2	-1	3	3	8	5
	4A	7	-1	5	5	13	8
	(4B)	(12)	water	12	10/16	—	—
	5	2	0	4	4	13	9
	5A	7	0	7	7	35	28
	(5B)	(12)	water	@ 12	—	—	—

REMARKS

TYPE OF SOIL

TESTED BY

ALSO PRESENT

C1 3310 SEQUENCE NO. (OEP USE ONLY)

STATE OF MARYLAND
WELL COMPLETION REPORT
FILL IN THIS FORM COMPLETELY
PLEASE PRINT OR TYPE

THIS REPORT MUST BE SUBMITTED WITHIN
45 DAYS AFTER WELL IS COMPLETED

COUNTY NUMBER A22411

DATE RECEIVED: [] [] [] [] [] []

DATE WELL COMPLETED 07/28/87

Depth of Well 275 (TO NEAREST FOOT)

PERMIT NO. 10-87-0625

OWNER Weaver

STREET OR RPD last name Sharp Road first name TOWN Glenelg

SUBDIVISION The Heritage SECTION LOT 62

WELL LOG
Not required for driven wells

GYATE THE KIND OF FORMATIONS
PENETRATED, THEIR COLOR, DEPTH,
THICKNESS AND IF WATER BEARING

DESCRIPTION (Use additional sheets if needed)	FEET		Check (water bearing)
	FROM	TO	
Brown Shale	0	38	
Caray mica rock	38	215	

GROUTING RECORD

WELL HAS BEEN GROUTED
(Circle Appropriate Box)

TYPE OF GROUTING MATERIAL
CEMENT CM BENTONITE CLAY BC

NO. OF BAGS 14 NO. OF POUNDS 1376

GALLONS OF WATER 24

DEPTH OF GROUT SEAL (to nearest foot)
from 0 to 10 ft. (to nearest foot)

CASING RECORD

Casing types: insert appropriate code below

STEEL SY CONCRETE CB
PLASTIC PL OTHER OT

MAIN CASING TYPE

Nominal diameter top (main) casing (nearest inch)

Total depth of main casing (nearest foot)

OTHER CASING (if used)

diameter (nearest inch)

depth (nearest foot)

SCREEN TYPE / SCREEN RECORD

(insert appropriate code below)

STEEL SY BRASS BR HO OPEN HOLE
BRONZE PL OT
PLASTIC PL OTHER OT

DEPTH (nearest ft.)

40 275 275

SLOT SIZE

DIAMETER OF SCREEN (NEAREST INCH)

from to

GRAVEL PACK

IF WELL DRILLED WAS
FLOWING WELL INSERT
P IN BOX 65

OEP USE ONLY:
(NOT TO BE FILLED IN BY DRILLER)

T TELESCOPE CASING LOG INDICATOR

WG OTHER DATA

PUMPING TEST

HOURS PUMPED (nearest hour) 1

PUMPING RATE (gal. per min. to nearest gal.) 52

METHOD USED TO MEASURE PUMPING RATE: bucket

WATER LEVEL (distance from land surface) 17

BEFORE PUMPING 17

WHEN PUMPING 27

TYPE OF PUMP USED (for use)

A air P piston T turbine
C centrifugal H rotary O other (specify below)

PUMP INSTALLED

DRILLER WILL INSTALL PUMP (CIRCLE) YES NO

IF DRILLER INSTALLS PUMP, THIS SECTION MUST BE COMPLETED FOR ALL WELLS EXCEPT HOME USE

TYPE OF PUMP INSTALLED

PLACE (A.C./P./R./T./O.) IN BOX - SEE ABOVE

CAPACITY: GALLONS PER MINUTE (to nearest gallon) 52

PUMP HORSE POWER 1

PUMP COLUMN LENGTH (nearest ft.) 275

CASING HEIGHT (circle appropriate box and enter casing height)

above L. NO SURFACE below

LOCATION OF WELL ON LOT

SHOW PERMANENT STRUCTURE (SUCH AS BUILDING, SEPTIC TANKS, AND/OR LANDMARKS) AND INDICATE NOT LESS THAN TWO DISTANCES (MEASUREMENTS TO WELL)

SHARP R.D.

40' 224'

CIRCLE APPROPRIATE LETTER

A A WELL WAS ABANDONED AND SEALED WHEN THIS WELL WAS COMPLETED

E ELECTRIC LOG OBTAINED

P TEST WELL CONVERTED TO PRODUCTION WELL

I HEREBY CERTIFY THAT THIS WELL HAS BEEN CONSTRUCTED IN
ACCORDANCE WITH COMAR 10.17.13 "WELL CONSTRUCTION"
AND IN CONFORMANCE WITH ALL CONDITIONS STATED IN THE
ABOVE CAPTIONED PERMIT, AND THAT THE INFORMATION
PRESENTED HEREIN IS ACCURATE AND COMPLETE TO THE BEST
OF MY KNOWLEDGE.

DRILLER'S IDENT. NO. 238

DRILLER'S SIGNATURE Joseph P. Morgan

(MUST MATCH SIGNATURE ON APPLICATION)

SITE SUPERVISOR (sign. of driller or journeyman responsible for sitework if different from permittee)

22411

July 2, 1966

Mr. Roy David Weaver
4128 Sharp Road
Glenald, Maryland 21787

Dear Mr. Weaver:

The water sample recently submitted for testing was free of coliform and fecal coliform bacteria at the time of sampling and is bacteriologically safe for drinking.

FINAL CERTIFICATE OF POTABILITY

This certifies that all sampling requirements of COMAR 10.17.13 "Well Regulations" have been met for the water supply system installed under permit(s) HQ-81-0625.

May 20, 1966
Date of Final Sampling

May 27, 1966
Date of Acceptance

Craig Williams
Craig Williams, Director
Water and Sewerage Program

CN/JS:JR

Date Well Approved: 7/18/64
Date Septic Approved: 4/28/65
Water Sample Dates: 11/21/65
5/22/71