

PERMIT

SEWAGE DISPOSAL SYSTEM

DEPARTMENT OF HEALTH AND MENTAL HYGIENE

HOWARD COUNTY HEALTH DEPARTMENT

BUREAU OF ENVIRONMENTAL HEALTH

XXXXXXXXXX

313-2640

INDEXED

P 58472A

A REPAIR

DISTRICT 5th

DATE 5-20-97

DATE SYSTEM APPROVED 5/21/77

INSPECTOR M. R. K. K.

Hatfields Equipment

 IS PERMITTED TO INSTALL ALTER X

ADDRESS 13785 Burntwoods Road, Glenelg, Maryland PHONE 410-854-6172

SUBDIVISION _____ LOT _____ ROAD 12003 Route 216

PROPERTY OWNER Norman Hill

Norman Hill

12003 Route 216

ADDRESS Fulton, Maryland 21059

Fulton, Maryland 21059

SEPTIC TANK CAPACITY 1000 GALLONS

NUMBER OF BEDROOMS 2

SQUARE FEET PER BEDROOM

LINEAR FEET OF TRENCH REQUIRED _____

REPAIR - PURPOSE - SEPTIC SYSTEM IS FAILING

Call for inspection when ground is opened so sanitarian can recommend repair.

05/14/97

PLANS APPROVED BY _____ DATE _____

COVER NO WORK UNTIL INSPECTED AND APPROVED

NEITHER THE HOWARD COUNTY COUNCIL NOR THE HEALTH DEPARTMENT IS RESPONSIBLE FOR THE SUCCESSFUL OPERATION OF ANY SYSTEM

NOTE: CLEANOUT REQUIRED EVERY 70 FEET OF SEWER LINE AND/OR AT 90° SWEEPS IN LINES FROM HOUSE TO DRAIN FIELDS, 90° ELBOWS NOT ACCEPTABLE.

NOTE: ALL PARTS OF SEPTIC SYSTEMS (I.E. TANK, DISTRIBUTION BOX TRENCHES) TO BE 100 FEET FROM WELL (UNLESS OTHERWISE SPECIFICALLY AUTHORIZED)

NOTE: IF DEEP TRENCH(ES) ARE USED CALL FOR INSPECTION BEFORE AND AFTER PLACING GRAVEL IN TRENCH(ES)

NOTE: NO DRY WELL SHALL EXCEED 15 FOOT IN DIAMETER NO ABSORPTION TRENCH TO EXCEED 100 FEET IN LENGTH

NOTE: ALL PIPE FROM HOUSE TO SEPTIC TANK MUST BE CAST IRON OR SCHEDULE 35/40 PVC OR ABS

PERMIT VOID AFTER TWO YEARS

NOTE: INSTALL STAND PIPE ON SEPTIC TANK AND DRY WELL STAND PIPES MUST BE 6 INCHES IN DIAMETER CAST IRON. CONCRETE OR TERRA COTTA OR PVA OR ABS ACCEPTED. IF TOP OF SEPTIC TANK IS DEEPER THAN 3 FEET. MANHOLE TO GRADE REQUIRED.


NOTE: DISTRIBUTION BOXES MUST HAVE BAFFLES

***INSTALLER IS RESPONSIBLE FOR OBTAINING FINAL APPROVAL ON THIS PERMIT**

*CALL 461-9933 FOR INSPECTION OF SEPTIC SYSTEM.

HD-260(6-90)

A 58472-H

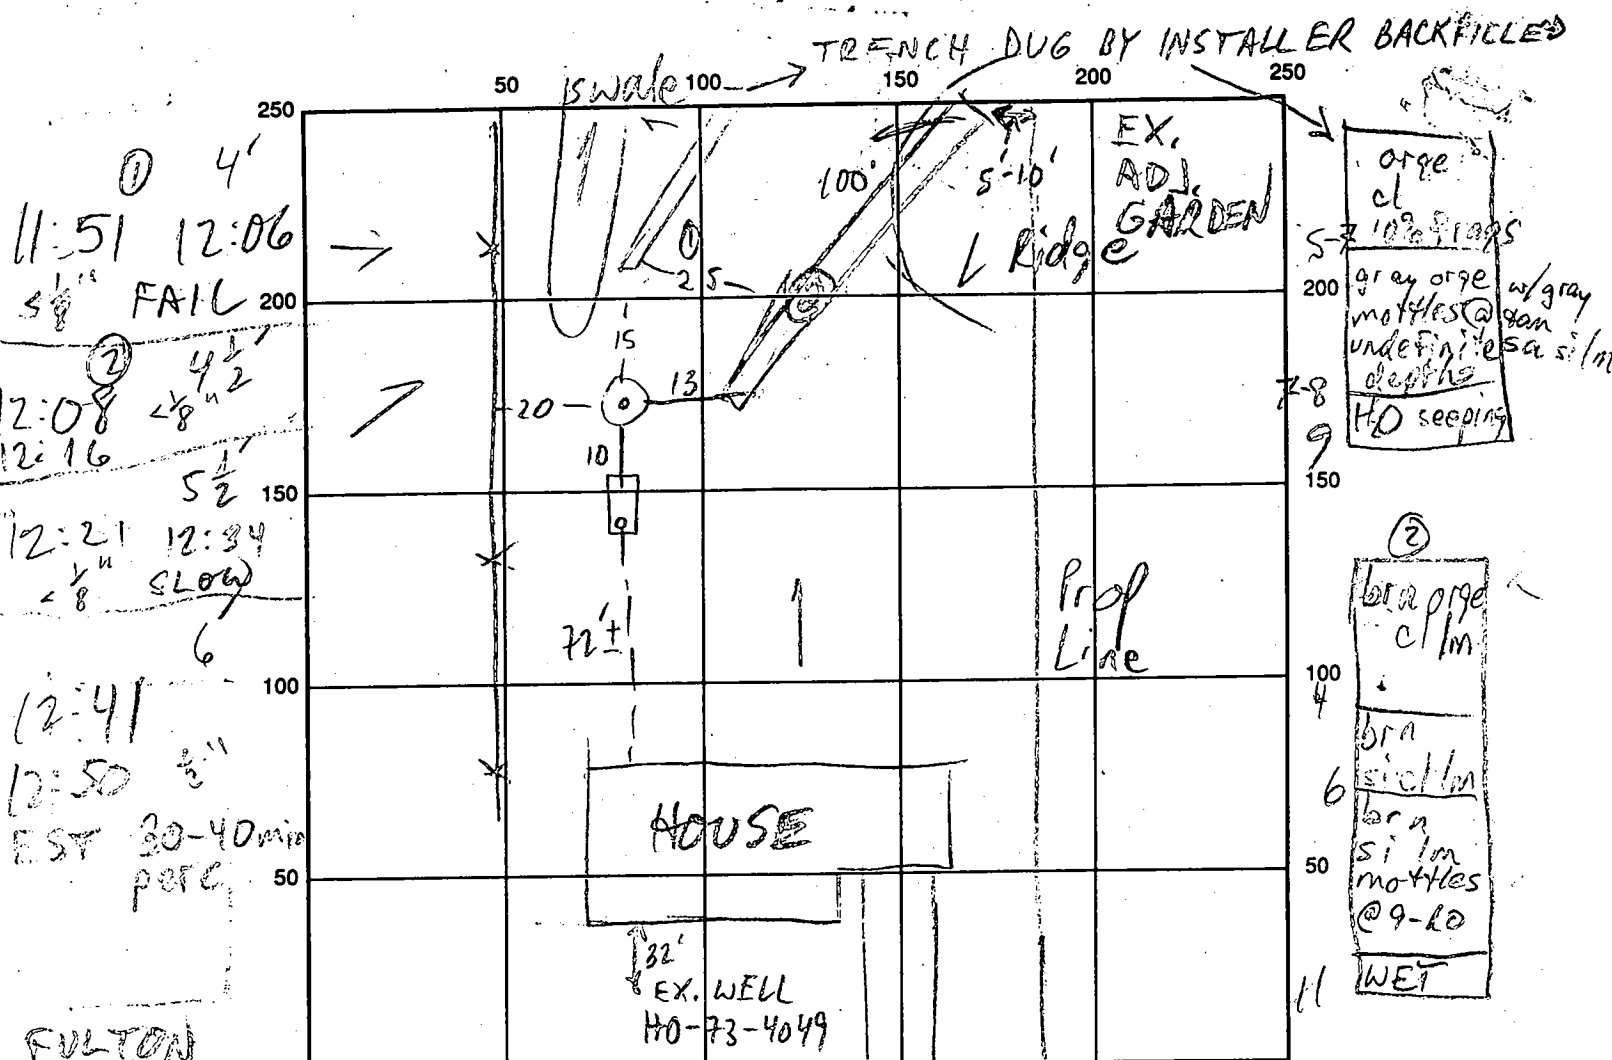

← RT. 216 INDICATE NORTH - NAME ADJOINING ROADWAY AS BASE LINE

← FINDERELL SCH. RD

SEPTIC TANK LEVEL 1000 GAL CLEANOUTS S.T. RD/W - OK

DISTRIBUTION BOX LEVEL

DRAIN FIELD/TITLE DEPTH 7 FT. TRENCH WIDTH 3 FT. INLET DEPTH 5 FT.

EFFECTIVE GRAVEL DEPTH 2 FT. TOTAL LENGTH 100 FT.

NUMBER OF TRENCHES 1 ONE SIDEWALL/BOTTOM AREA 300 SQ. FT.

DRYWALL INSIDE DIAMETER FT. EFFECTIVE DEPTH BELOW INLET FT.

ABSORBENT AREA 300 SQ. FT.

REMARKS: 5/21/97 #1 OK TO START DESIGN WAS BEST POSSIBLE IN LIMITED CIRCUMSTANCES; EX. D/W DEPTH 7' (MR)

5/21/97 #2 OK TO FINISH & COVER; EXTRA STONE ON TOP OF PIPE (MR)

DATE SYSTEM APPROVED 5/21/97 INSPECTOR M. Riskin

9/28/71
INDEXED

PERMIT

SEWAGE DISPOSAL SYSTEM

MARYLAND STATE DEPARTMENT OF HEALTH

HOWARD COUNTY

OFF 9.22.71
DUMY
P 16290

A

ELLICOTT CITY

DISTRICT 5

DATE 9/18/71

Jack Fyock

IS PERMITTED TO INSTALL ALTER X

ADDRESS Ten Oaks Road, Glenely, Md. PHONE 286-2939

A SEWAGE DISPOSAL SYSTEM LOCATED AT

SUBDIVISION 12003 ROAD Route 216 LOT

PROPERTY OWNER Mormon Hill 776-2965

ADDRESS

SPECIFICATIONS

DRAIN FIELD DEPTH FEET. BOTTOM AREA SQ. FT.

SEEPAGE PITS ABSORBENT SIDE-WALL AREA SQ. FT.

SEPTIC TANK CAPACITY GALLONS

FOR GARBAGE GRINDER, INCREASE DISPOSAL AREA 22% & TANK CAPACITY 80%.


OTHER REPAIR - Call for inspection of ground when opened up and Sanitarian
will recommend repair system.

PLANS APPROVED BY Palmer P. Wine DATE 9/18/71

FILL SEPTIC TANK AND DISTRIBUTION BOX WITH WATER BEFORE CALLING FOR AN INSPECTION COVER NO WORK UNTIL INSPECTED AND APPROVED.

NEITHER THE HOWARD COUNTY COMMISSIONERS NOR THE HEALTH DEPARTMENT IS RESPONSIBLE FOR THE SUCCESSFUL OPERATION OF ANY SYSTEM

16290

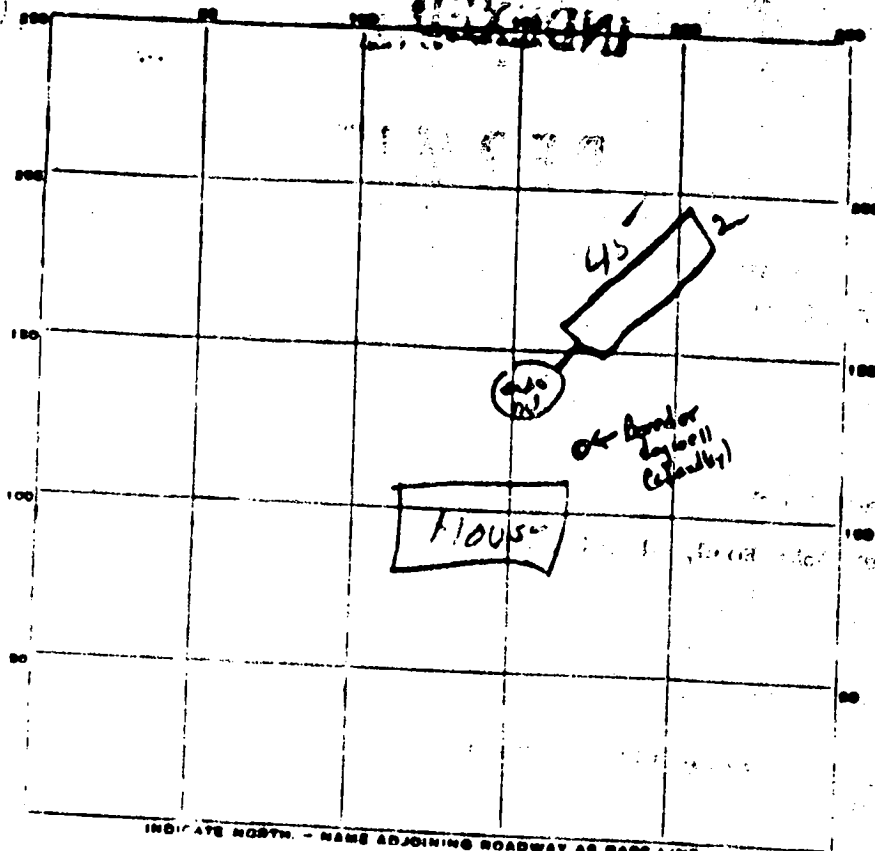

PERMIT CARD 011

SEPTIC TANK LEVEL _____

CLEANOUTS _____

DISTRIBUTION BOX LEVEL _____

PILE FIELD DEPTH 7 1/2 FT. TRENCH WIDTH 2 FT.

GRAVEL DEPTH 72 IN. TOTAL LENGTH 45 FT.

NUMBER OF TRENCHES 1 TOTAL BOTTOM AREA 90

SEPTAGE PITS, INSIDE DIAMETER _____ FT. DEPTH BELOW INLET _____ FT.

ABSORBENT AREA 540 SQ. FT.

REMARKS _____

DATE SYSTEM APPROVED 01/27/71 INSPECTOR [Signature]

DATE RECEIVED (OEP use only)
DATE WELL COMPLETED 12/19/17
Depth of Well 165
TO NEAREST FOOT
PERMIT NO. 14-213-10419
FROM PERMIT TO DRILL WELL

OWNER Hill
STREET OR RD 2023 Mt. Rd 216
TOWN Fulton
SUBDIVISION

Not required for wells with
STATE THE KIND OF FORMATIONS
PENETRATED, THEIR COLOR, DEPTH,
THICKNESS AND IF WATER BEARING

DESCRIPTION (Use additional sheets if needed)	FROM	TO	THICKNESS
Shale	0	30	
	30	68	
Argillaceous	68	165	

SECTION C 3

WELL HAS BEEN GROUDED (Circle appropriate box)
TYPE OF GROUTING MATERIAL
CEMENT ☒ M BENTONITE CLAY ☒ C
NO. OF BAGS 10 NO. OF POUNDS 950
GALLONS OF WATER 60
DEPTH OF GROUT SEAL (to nearest foot)
from 0 ft. to 33 ft. (insert 0 if from surface)
Casing Type (insert appropriate code below)
STEEL ☒ CO CONCRETE
PL PLASTIC OT OTHER
MAIN CASING TYPE
Nominal diameter (to nearest inch) 6 Total depth of main casing (nearest foot) 13
OTHER CASING (if used)
Nominal diameter (to nearest inch) depth (feet) to
SCREEN RECORD
screen type or opening
STEEL ☒ BR BRASS
PL PLASTIC HO OPEN HOLE
OT OTHER
DEPTH (nearest ft.)
40 71 165

PUMPING TEST
HOURS PUMPED (nearest hour) 3
PUMPING RATE (gal. per min. to nearest gal.) 15
METHOD USED TO MEASURE PUMPING RATE Air
WATER LEVEL (distance from land surface) BEFORE PUMPING 35
WHEN PUMPING 90
TYPE OF PUMP USED (Use test)
A piston P turbine
C centrifugal R rotary D other (describe below)
J jet S submersible

PUMP INSTALLED YES NO
DRILLER WILL INSTALL PUMP (CIRCLE APPROPRIATE BOX) Y N
IF DRILLER INSTALLS PUMP, THIS SECTION MUST BE COMPLETED FOR ALL WELLS EXCEPT HOME USE
TYPE OF PUMP (WRITE APPROPRIATE LETTER IN BOX - SEE ABOVE: (A, C, J, P, R, S, T, O))
CAPACITY: GALLONS PER MINUTE
to nearest gallon
PUMP HORSE POWER
PUMP COLUMN LENGTH (nearest ft.)
CASING HEIGHT (circle appropriate box and enter casing height)
LAND SURFACE
2 (nearest foot)

CIRCLE APPROPRIATE BOX
A A WELL WAS ABANDONED AND SEALED WHEN THIS WELL WAS COMPLETED
E ELECTRIC LOG OBTAINED
P TEST WELL CONVERTED TO PRODUCTION WELL
I HEREBY CERTIFY THAT THIS WELL HAS BEEN CONSTRUCTED IN ACCORDANCE WITH COMAR 10.17.13 "WELL CONSTRUCTION" AND IN CONFORMANCE WITH ALL CONDITIONS STATED IN THE ABOVE CAPTIONED PERMIT, AND THAT THE INFORMATION PRESENTED HEREIN IS ACCURATE AND COMPLETE TO THE BEST OF MY KNOWLEDGE
DRILLERS IDENT NO.
DRILLERS SIGNATURE
MUST MATCH SIGNATURE ON APPLICATION
SUPERVISOR: sign of driller or journeyman responsible for sitework if different from permittee

SLOT SIZE
DIAMETER OF SCREEN (NEAREST INCH)
GRAVEL PACK
IF WELL DRILLED WAS FLOWING WELL CIRCLE BOX F
OEP USE ONLY (NOT TO BE FILLED IN BY DRILLER)
T (E.R.O.S.)
TELESCOPE CASING LOG INDICATOR
W O
OTHER DATA

