

MARYLAND STATE DEPARTMENT OF HEALTH
HOWARD COUNTY

INDEXED

ELLICOTT CITY

DISTRICT 3rd

DATE 4/7/71

Jack Fyock

IS PERMITTED TO INSTALL X ALTER

ADDRESS Ten Oaks Road, Glenelg, Maryland

PHONE 286-2939

A SEWAGE DISPOSAL SYSTEM LOCATED AT _____

SUBDIVISION Woodmark

ROAD 12244 Yearling Court

LOT 40, Blc

PROPERTY OWNER Mr. and Mrs. James Openshaw

Sec 9?

ADDRESS 13908 Briarwood Drive, Laurel, Maryland

Phone: 776-1499

SPECIFICATIONS 3 bedrooms

DRAIN FIELD _____ DEPTH _____ FEET. BOTTOM AREA _____ SQ. FT.

RECEIVE PITS _____ ABSORBENT SIDE-WALL AREA _____ SQ. FT.

SEPTIC TANK CAPACITY 1000 GALLONS

FOR GARBAGE GRINDER, INCREASE DISPOSAL AREA 25% & TANK CAPACITY 50%.

OTHER DRY WELL - 120 sq. ft. absorbent sidewall area per bedroom to begin below the first 4 ft. of original grade. Maximum depth permitted for dry well is 11 ft. below original grade. Place dry well 60 ft. from front lot line and 65 ft. from left sidewalk as seen when facing lot from Etchison Road.

NOTE: ALL PIPE FROM HOUSE TO DISPOSAL AREA MUST BE CAST IRON.
PERMIT VOID AFTER THREE YEARS.

NOTE: INSTALL STAND PIPE ON SEPTIC TANK AND DRY WELL. STAND PIPES MUST BE 6 IN IN DIAMETER. CAST IRON, CONCRETE OR TERRA COTTA ACCEPTED.

PLANS APPROVED BY Donald W. Monaghan

DATE 9/28/72

FILL SEPTIC TANK AND DISTRIBUTION BOX WITH WATER BEFORE CALLING FOR AN INSPECTION. COVER MUST BE UNTIL INSPECTED AND APPROVED.

NEITHER THE HOWARD COUNTY COMMISSIONERS NOR THE HEALTH DEPARTMENT IS RESPONSIBLE FOR SUCCESSFUL OPERATION OF ANY SYSTEM.

**BUILDING PERMIT SIGNED
AND RETURNED**


4/20/01 600147370 - FINISHED BASEMENT

CITY ENGINEER SIGNED

DATE 4-23-97

Serial # B7106399
attached garage & shed

A58515-B

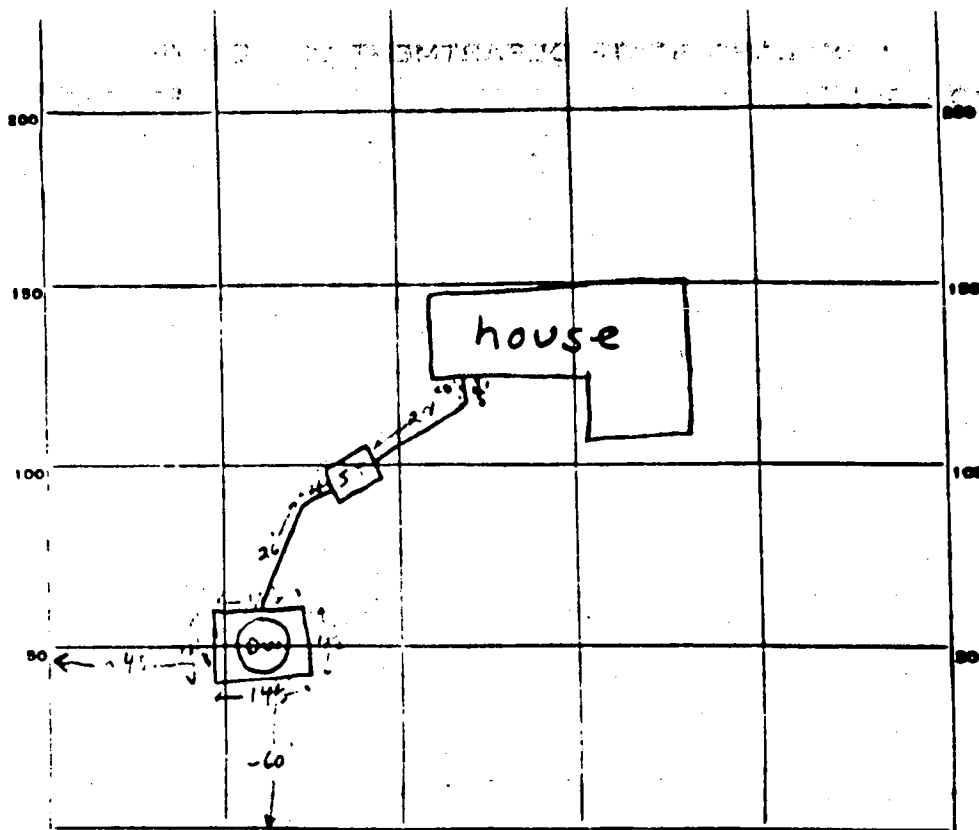

INDICATE NORTH. - NAME ADJOINING ROADWAY AS BASE LINE.

Etchison Rd

PERMIT CARD ☒ final, corrected

S.T. | D.W.

SEPTIC TANK, LEVEL ☒

CLEANOUTS ☒ ☒

DISTRIBUTION BOX, LEVEL na

TILE FIELD, DEPTH FT. TRENCH WIDTH FT.

GRAVEL DEPTH IN. TOTAL LENGTH FT.

NUMBER OF TRENCHES TOTAL BOTTOM AREA


OUTSIDE PERIMETER 55 FT. DEPTH BELOW INLET 6 1/2-7 FT.

ABSORBENT AREA ±358 SQ. FT.

REMARKS

DATE SYSTEM APPROVED 4/2/76 INSPECTOR Frank Skinner

ELLICOTT City 78P-7467

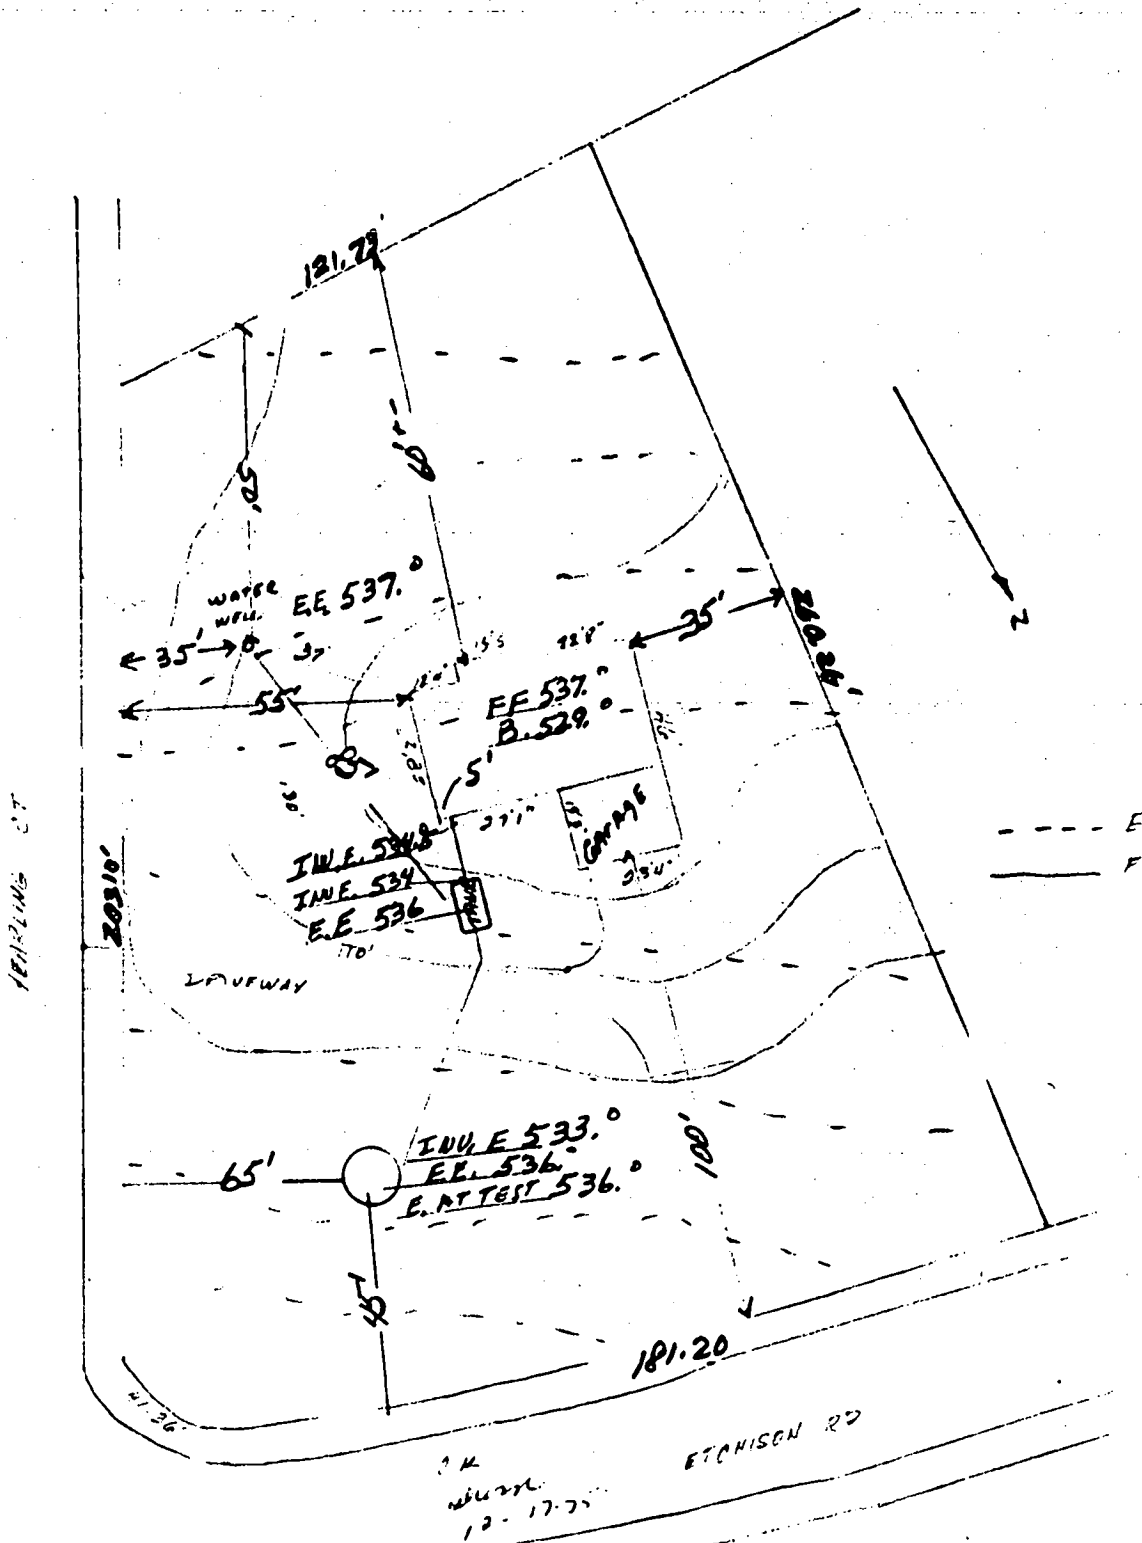

NOT TO SCALE
WOODED LOT
MIN. CLEARING

12244 YEARLING

JAMES L. OR
LOT 40 ELLICOTT
WOODMAN

DATE WELL COMPLETED 300 (TO NEAREST FOOT)

DRILLER IDENTIFICATION NO. 4

OWNER Overstair James STREET OR RFD 13908 Briarwood Dr. POST OFFICE Laurel Md

WELL LOG

STATE THE KIND OF FORMATIONS PENETRATED, THEIR COLOR, DEPTH, THICKNESS AND IF WATER BEARING

DESCRIPTION (USE APPROPRIATE SHEETS IF NECESSARY)	FEET FROM	TO	WATER BEARING
Top Soil	0	3	
Shale	3	40	
Green Rock	40	100	✓
Water	100	220	
Grey Rock	220	300	✓

WELL ABANDONMENT

WELL HAS BEEN ORIGINATED (CIRCLE APPROPRIATE BOX)

TYPE OF GROUTING MATERIAL (CIRCLE BOX)

CEMENT ☒ BENTONITE CLAY ☐

NO. OF BAGS 22 NO. OF POUNDS 2280

DEPTH OF GROUT SEAL (TO NEAREST FOOT)

FROM 0 FT. TO 50 FT.

CASING RECORD

INSERT APPROPRIATE CODE BELOW

STEEL ☐ CONCRETE ☐

PLASTIC ☐ OTHER ☐

MAIN CASING TYPE

NOMINAL DIAMETER FOR MARKING (NEAREST INCH)

TOTAL DEPTH OF MAIN CASING (NEAREST FOOT)

ST 6 56

OTHER CASING (IF USED)

DIAMETER (INCH)

DEPTH (FEET)

SCREEN RECORD

INSERT APPROPRIATE CODE BELOW

STEEL ☐ BRASS OR BRONZE ☐ OPEN HOLE ☐

PLASTIC ☐ OTHER ☐

DEPTH (NEAREST WHOLE FOOT)

HO 54 300

DIAMETER OF SCREEN (NEAREST INCH)

FROM 11 TO 11

GRAVEL PACK ☐

IF WELL DRILLED WAS A FLOWING WELL CIRCLE BOX ☐

WHA USE ONLY (NOT TO BE FILLED IN BY DRILLER)

TELESCOPE CASING ☐ LOG INDICATOR ☐ 74 TO 76 OTHER DATA AVAILABLE ☐

PUMPING TEST

HOURS PUMPED (TO NEAREST HOUR)

PUMPING RATE (GALLONS PER MINUTE TO NEAREST GALLON)

WATER LEVEL (DISTANCE FROM DEPTH OF PUMPING)

50

TYPE OF PUMPED USED (CIRCLE BOX)

A C J

PUMP INSTALL

TYPE OF PUMP (WRITE APPROPRIATE BOX - SEE ABOVE)

DRILLER WILL INSTALL PUMP (CIRCLE APPROPRIATE BOX)

CAPACITY:

GALLONS PER MINUTE (TO NEAREST GALLON)

PUMP HORSE POWER

PUMP COLUMN LENGTH (NEAREST FOOT)

CASING HEIGHT (CIRCLE APPROPRIATE AND ENTER)

+ ABOVE 2 LAND SURFACE

- BELOW 45

LOCATION OF WELL

SHOW PERMANENT STRUCTURE, SEPTIC TANKS, AND/OR OTHER. INDICATE NOT LESS THAN TWO (2) MEASUREMENTS TO WELL.

well

40

How

CIRCLE APPROPRIATE BOXES

☐ A WELL WAS ABANDONED AND SEALED WHEN THIS WELL WAS COMPLETED

☐ ELECTRIC LOG OBTAINED


☐ TEST WELL CONVERTED TO PRODUCTION WELL

I HEREBY CERTIFY THAT I HAVE COMPLIED WITH ALL CONDITIONS STATED ON THE ABOVE-CAPTIONED "PERMIT TO DRILL WELL", AND THAT INFORMATION CONTAINED IN THIS REPORT IS TRUE, ACCURATE, AND COMPLETE TO THE BEST OF MY KNOWLEDGE, INFORMATION AND BELIEF.

DRILLER'S NAME James Overstair

PLEASE PRINT: James Overstair

SIGNATURE: James Overstair

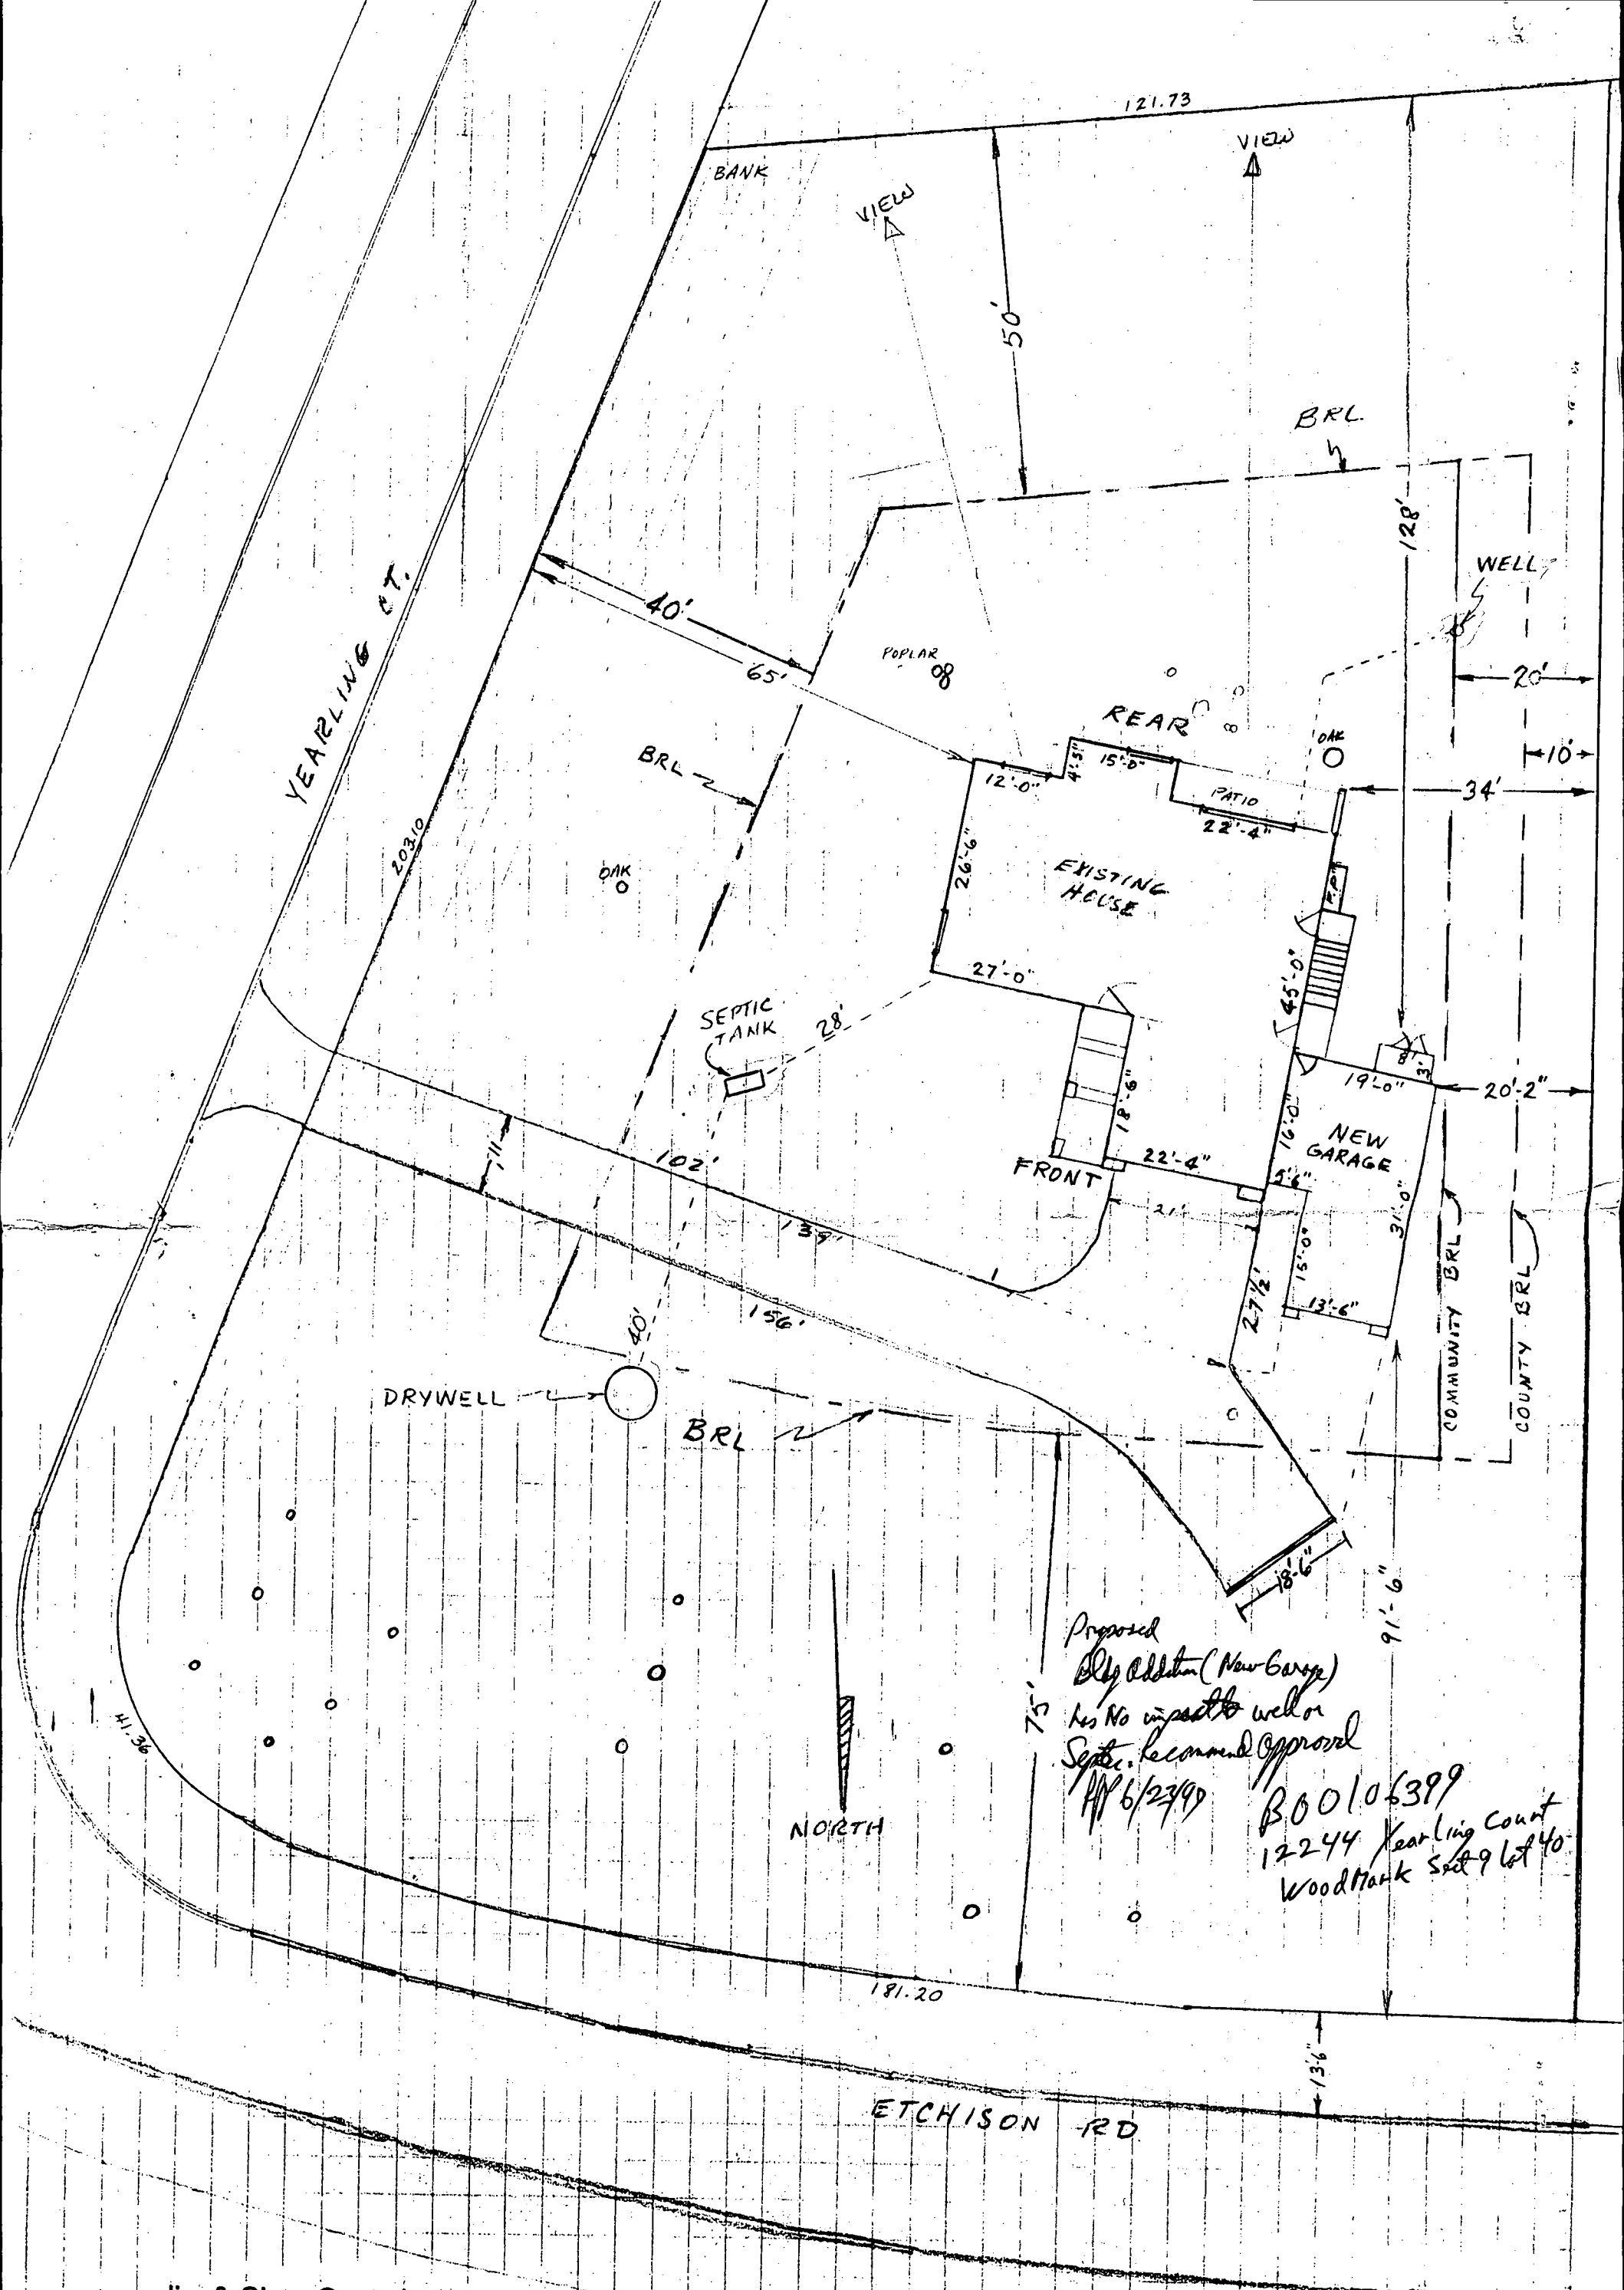


Proposed
 Additions (New Garage)
 has No impact to well or
 Septic. Recommended Approval
 6/23/97
 B00106399
 12244 Yearling Court
 Woodmark Sect 9 Lot 40

Jim & Clare Openshaw 6/18/97
 12244 Yearling Court, Ellicott City, MD 21042
 Woodmark, Howard County
 Lot #40, Block B, Section 9, Etchison Road
 Plat Book 23, Folio 74
 40,204 sq. ft. Scale: 1" = 20'

Owens Corning Basement Finishing System

Taylor Made Construction
P.O. Box 979, 2301 Willoughby Beach Road
Edgewood, MD 21040, 1-800-917-PINK (7465)

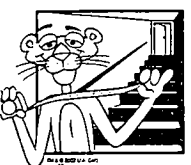

Customer Name: M/M O'NEILL


Address: _____

Phone: _____

Notes: _____

Customer Initials: _____

- Legend:
- | | |
|------------------|-------------------------|
| OC Owens Corning | FL Fluorescent Lights |
| SR Sheet rock | RC Recessed Can Lights |
| MS Metal Studs | SM Surface Mount Lights |
| OF Open Framing | LU Luan |
- 1 Box (1/4") = 1 Foot

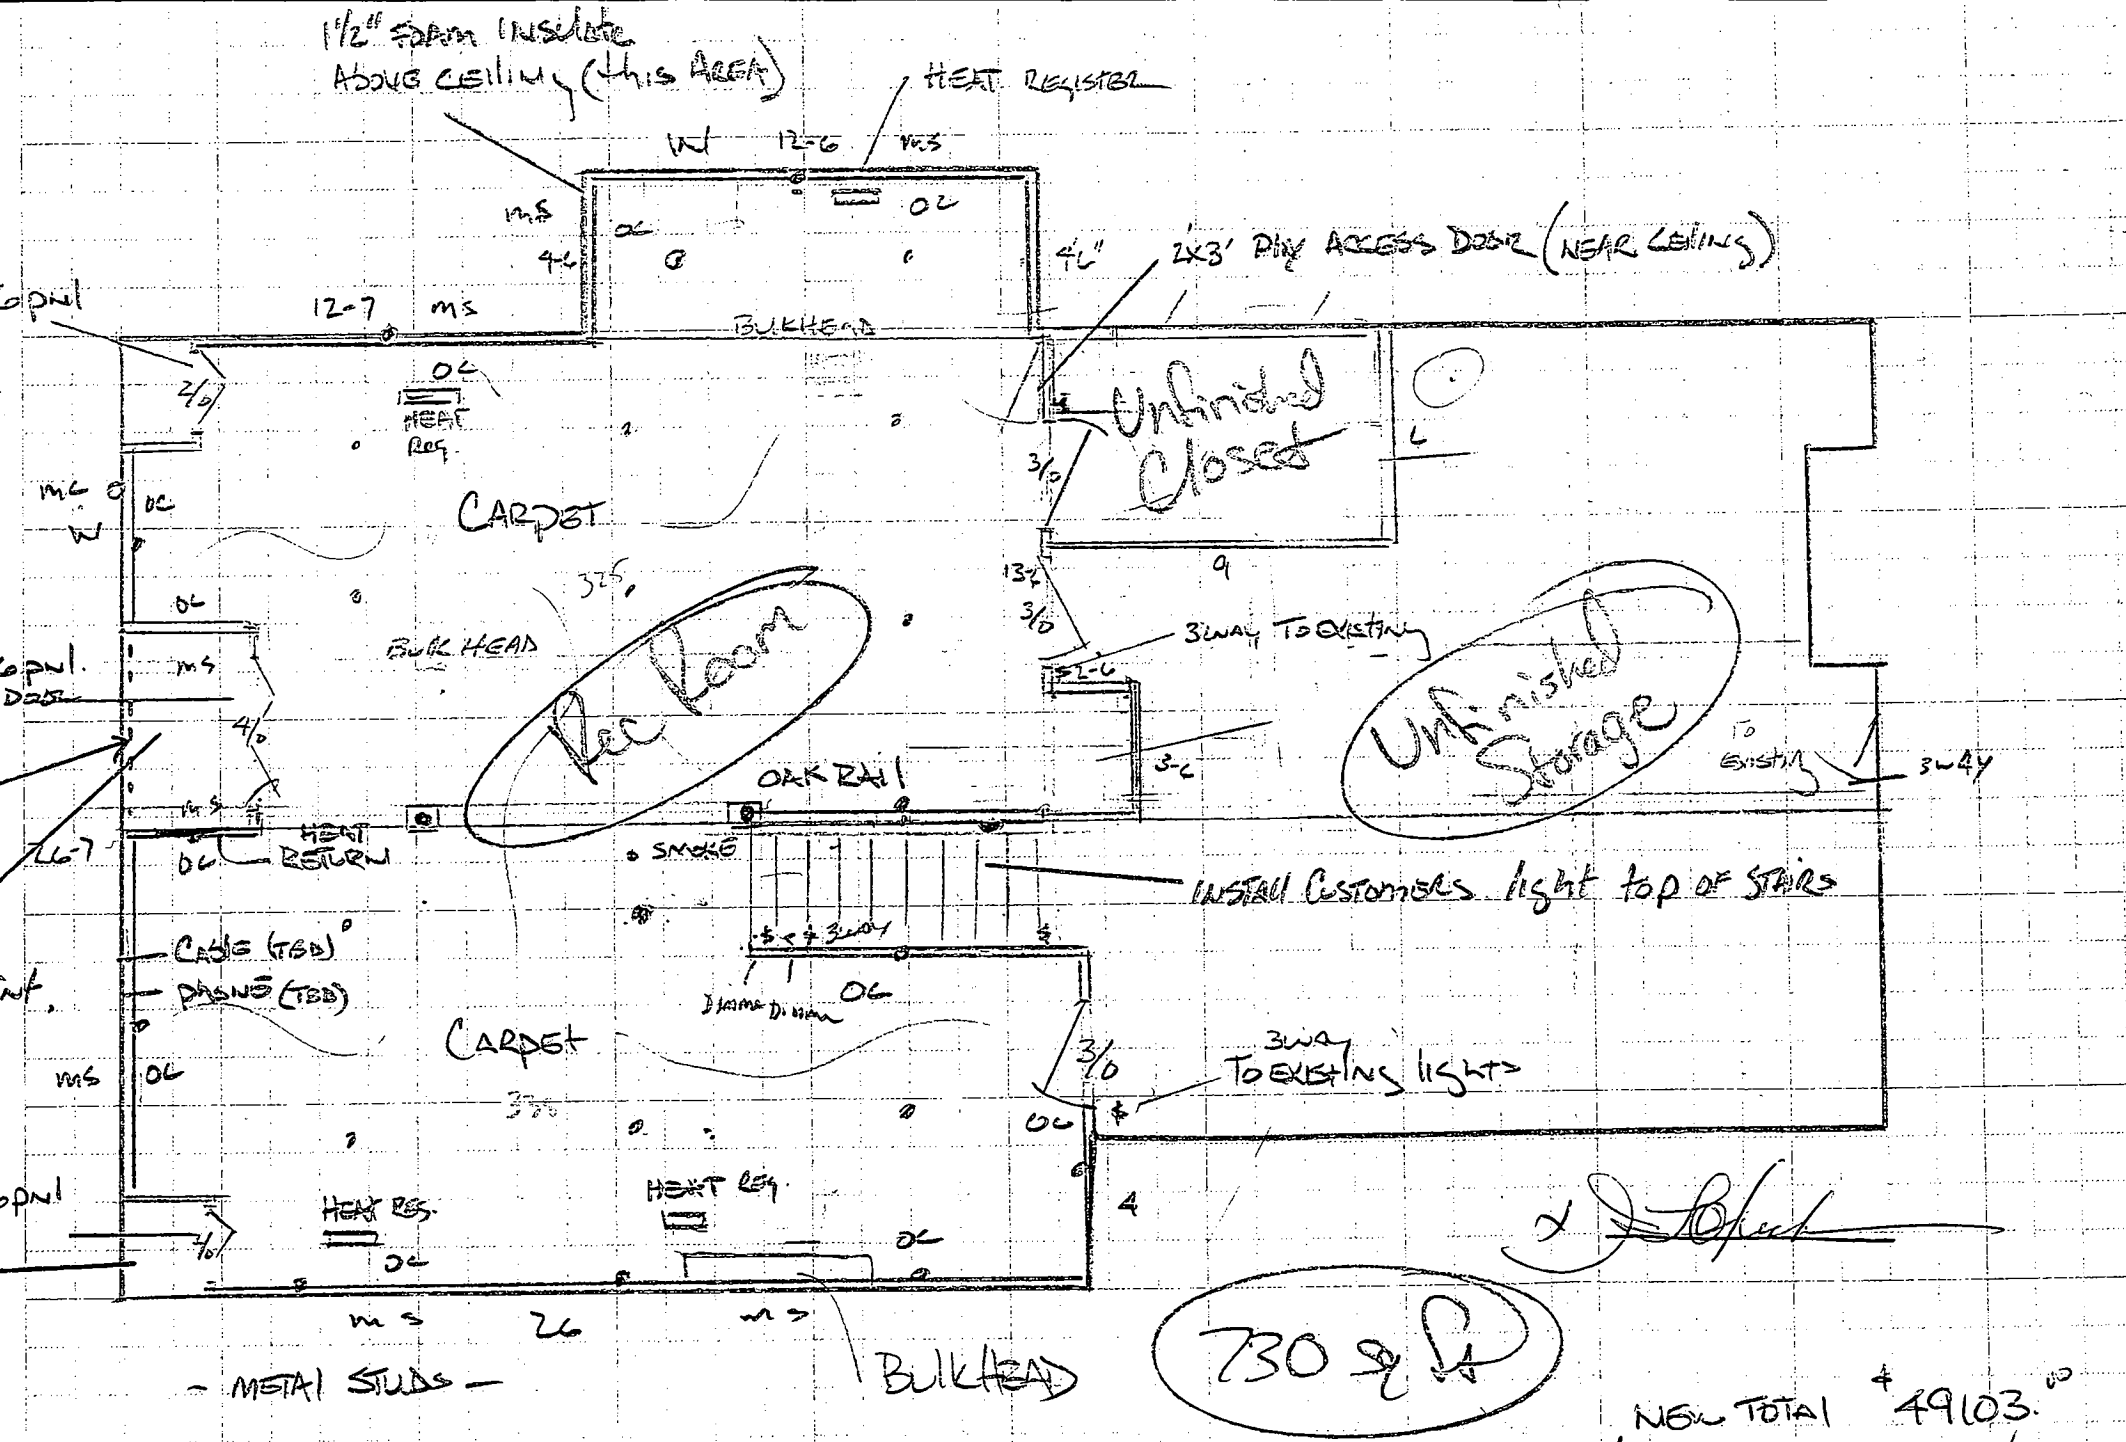

No ↑ in bed rooms
PART PERC Profile/times indic. Luan

730 & P
B00147370 OK'd
FINISH BASEMENT KN

NEW TOTAL \$49103.⁰⁰