

10/25/60 - Ch out - around 3:00
10/26/60 approved R.H.
9/11/97/1

PERMIT INDEXED

P 03065
58905-C
A 02893

SEWAGE DISPOSAL SYSTEM

MARYLAND STATE DEPARTMENT OF HEALTH

HOWARD COUNTY

03-284190

ELLICOTT CITY

DISTRICT

3

DATE 10/17/60

INDEXED

Howard Pickett

IS PERMITTED TO INSTALL ☒ ALTER

ADDRESS Mt. Airy

PHONE Mt. Airy 143 W 1

A SEWAGE DISPOSAL SYSTEM LOCATED AT

SUBDIVISION River Park Estates

ROAD

1141 River Road
corner River Rd.
and Rt. 32.

LOT

1

PROPERTY OWNER

William Dixon
Smegell, Benjamin

(Wallace E. Norris

ADDRESS

Rt. 30, Mt. Airy

SPECIFICATIONS

DRAIN FIELD ☒ DEPTH FEET, BOTTOM AREA 325 SQ. FT.

SEEPAGE PITS ABSORBENT SIDE-WALL AREA SQ. FT.

SEPTIC TANK CAPACITY 750 GALLONS

FOR GARBAGE GRINDER, INCREASE DISPOSAL AREA 22% & TANK CAPACITY 50%.

OTHER: Locate on front of lot in front of house. Trenches to start 20 to 25 ft.
from front property line.

PLANS APPROVED BY James E. Hennigan

DATE 8/31/60


FILL SEPTIC TANK AND DISTRIBUTION BOX WITH WATER BEFORE CALLING FOR AN INSPECTION. COVER NO WORK UNTIL INSPECTED AND APPROVED.

NEITHER THE HOWARD COUNTY COMMISSIONERS NOR THE HEALTH DEPARTMENT IS RESPONSIBLE FOR THE SUCCESSFUL OPERATION OF ANY SYSTEM.

BLDG. PERMIT SIGNED
AND RETURNED 9/24/64

Serial # 58603
Storage for Lawn Equip.

A 58905-C
28643

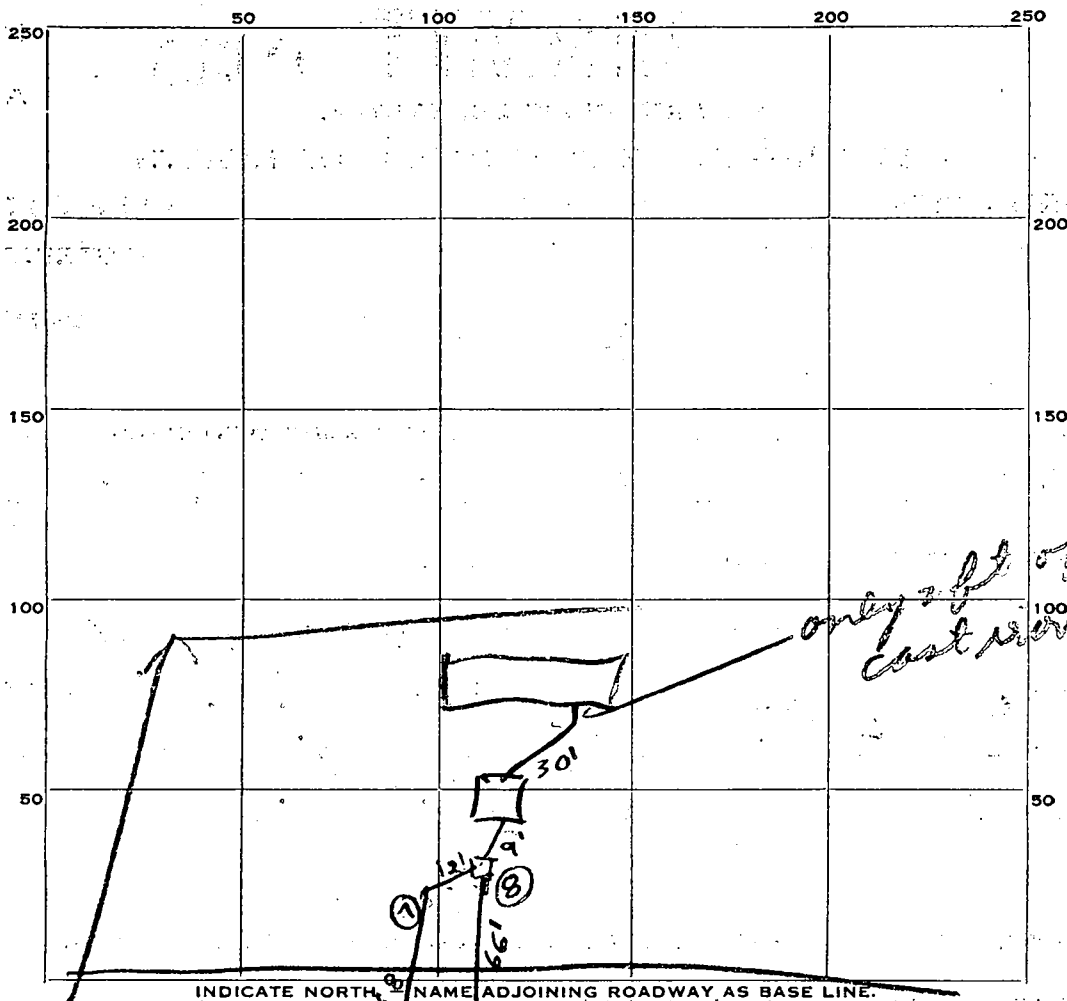

PERMIT CARD

SEPTIC TANK, LEVEL OK 750

CLEANOUTS

DISTRIBUTION BOX, LEVEL

TILE FIELD, DEPTH 4 to 6 FT. TRENCH WIDTH 3 FT.

GRAVEL DEPTH 12 IN. TOTAL LENGTH 146 FT.

NUMBER OF TRENCHES 2 TOTAL BOTTOM AREA 438

SEEPAGE PITS, INSIDE DIAMETER _____ FT. DEPTH BELOW INLET _____ FT.

ABSORBENT AREA _____ SQ. FT.

REMARKS

Both trenches are too deep in the ground
House sewer leaves house at 4 ft below grade
Only 2 ft of cast iron pipe leading from the house
10/26/60 Percolation test run in bottom of the trench
& size of tile field is OK

DATE SYSTEM APPROVED 10/26/60

INSPECTOR

Raymond Hodge

APPLICATION

SEWAGE DISPOSAL TESTING

MARYLAND STATE DEPARTMENT OF HEALTH

HOWARD COUNTY

ELLICOTT CITY

02893
A ~~03065~~
P 03065

DISTRICT 3

DATE Aug. 26, 1960

325 sq. ft of tile field located
on front of lot in front of house.
Trenches to start 20 to 25 ft from front
property line.

750 gal septic Tank.

TO: THE COUNTY HEALTH OFFICER
ELLICOTT CITY, MARYLAND

I, HEREBY, APPLY FOR THE NECESSARY TESTS IN ORDER TO CONSTRUCT (OR RECONSTRUCT) A SEWAGE DISPOSAL SYSTEM.

PROPERTY OWNER Swogell, Benjamin, Wallace E. Norris
Route 30 Mt. Airy Mt. Airy 574
ADDRESS 1 Court Sq. Building, Balto. PHONE Pl 2 6572

PROPERTY LOCATION:

SUBDIVISION River Park Estates LOT NO. 1
corner of
ROAD AND DESCRIPTION River Road and Route 32
between River Road & Route 40

OCCUPANT _____ PHONE _____

PERSON TO CONSTRUCT SYSTEM _____
X
X

ADDRESS _____ PHONE _____

SIZE OF LOT 1 acre TYPE BLDG. 3
NUMBER OF BEDROOMS

IF NOT SINGLE RESIDENCE DESCRIBE _____

SIGNATURE OF APPLICANT Wallace E. Norris


APPROVED BY J. Hanning FOR Tile Field DATE 8-31-60
(KIND OF SYSTEM)

REJECTED BY ✓ FOR _____ DATE _____
(KIND OF SYSTEM)

HOLD PENDING FURTHER TESTS _____ DATE _____

REASONS FOR REJECTION OR HOLDING _____

THIS IS NOT A PERMIT

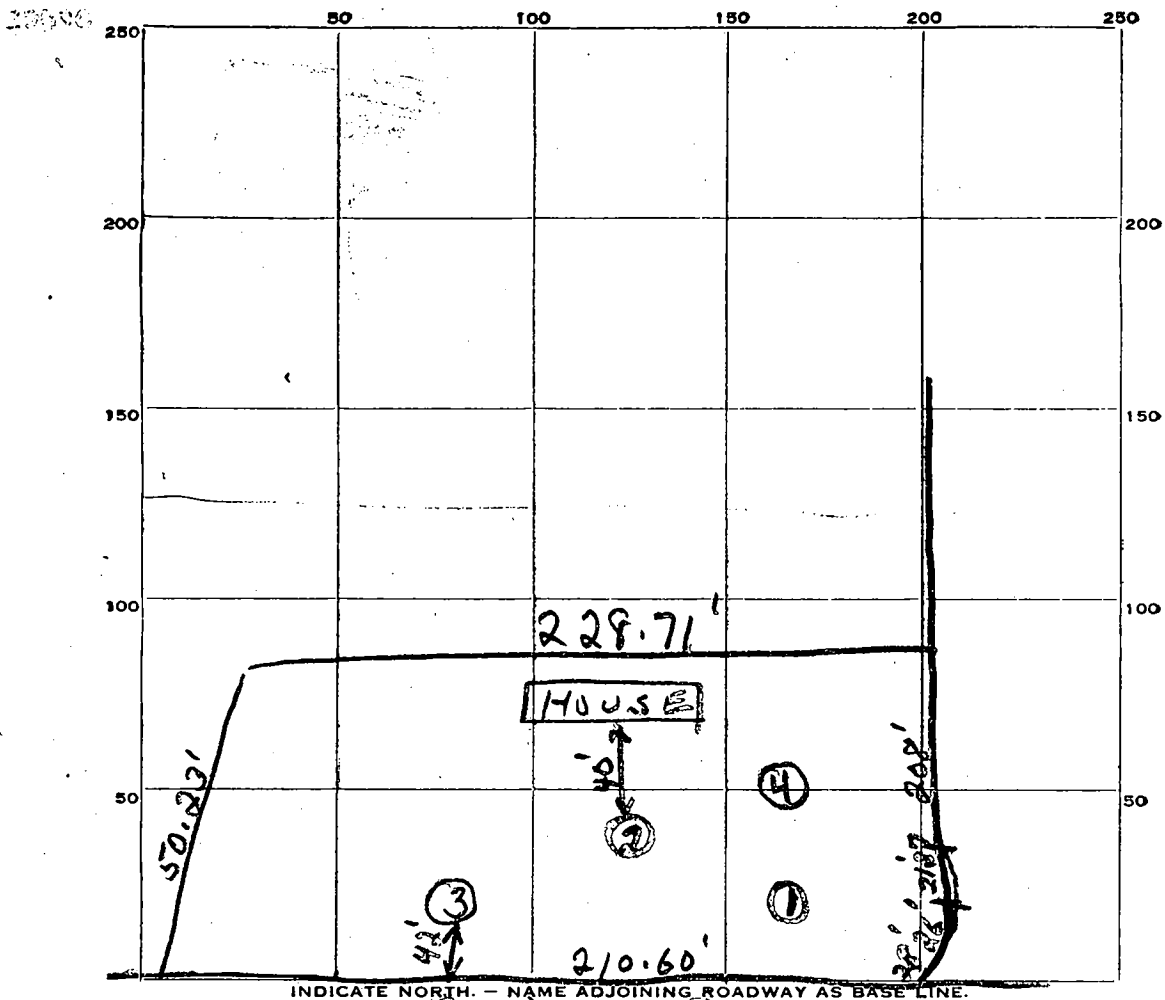

River Road

DATE	TEST NO.	DEPTH	PRE-WET		TEST - 1" DROP		TIME
			START	STOP	START	STOP	
8-31-60	1	3 1/2 FT	1:26	1:28	1:28	1:33	5 min
	2		1:28	1:31	1:31	1:36	5 min
	3		1:29	1:38	1:38	1:53	5 min
	4		1:35	overtime			
10-26-60	5	5	2:53	2:58	2:58	3:04	6 min
" "	6	6	2:55	2:58	2:58	3:02	4 min
" "	7	5	2:57	3:03	3:03		5 min for 1st inch
" "	8	6	2:59	3:00	3:00	3:04	4 min

SOIL AUGER FINDING

TESTED BY

REMARKS

ALSO PRESENT

J. Hanning 10/2

10/26/60 Hole location is shown on sketch. Holes were dug in bottom of 2nd field

Wallace E. Norris LOT NO. 1

End of 60' R/W of River Road
owned by the Md. S.R.C.

N 30° 30' 33" E 38.50'

R=62.38' L=173.85'
Chd.=N 38° 38' 00" E
173.26'

Lot 1

43,877 SQ. FT.

S 0° 31' 05" W 228.71'

N 88° 28' 09" W 208.00'

N 39° 48' 00" W 28.26'


60' R/W


R=25.75' L=21.87'
Chd.=N 64° 08' 16" W 21.22'



PLAT OF SURVEY
FOR
BENJAMIN SWOGELL
THIRD ELECTION DISTRICT OF HOWARD COUNTY
SYKESVILLE, MARYLAND
SCALE: 1 IN. = 100 FT. AUGUST 22, 1900

Claude M. Skinner, Jr.
Claude M. Skinner, Jr. Reg. Land Surveyor No. 2237

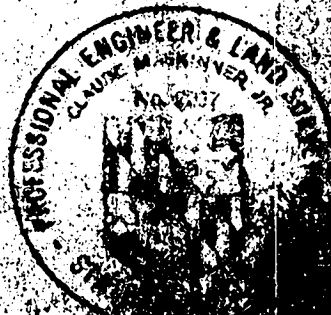

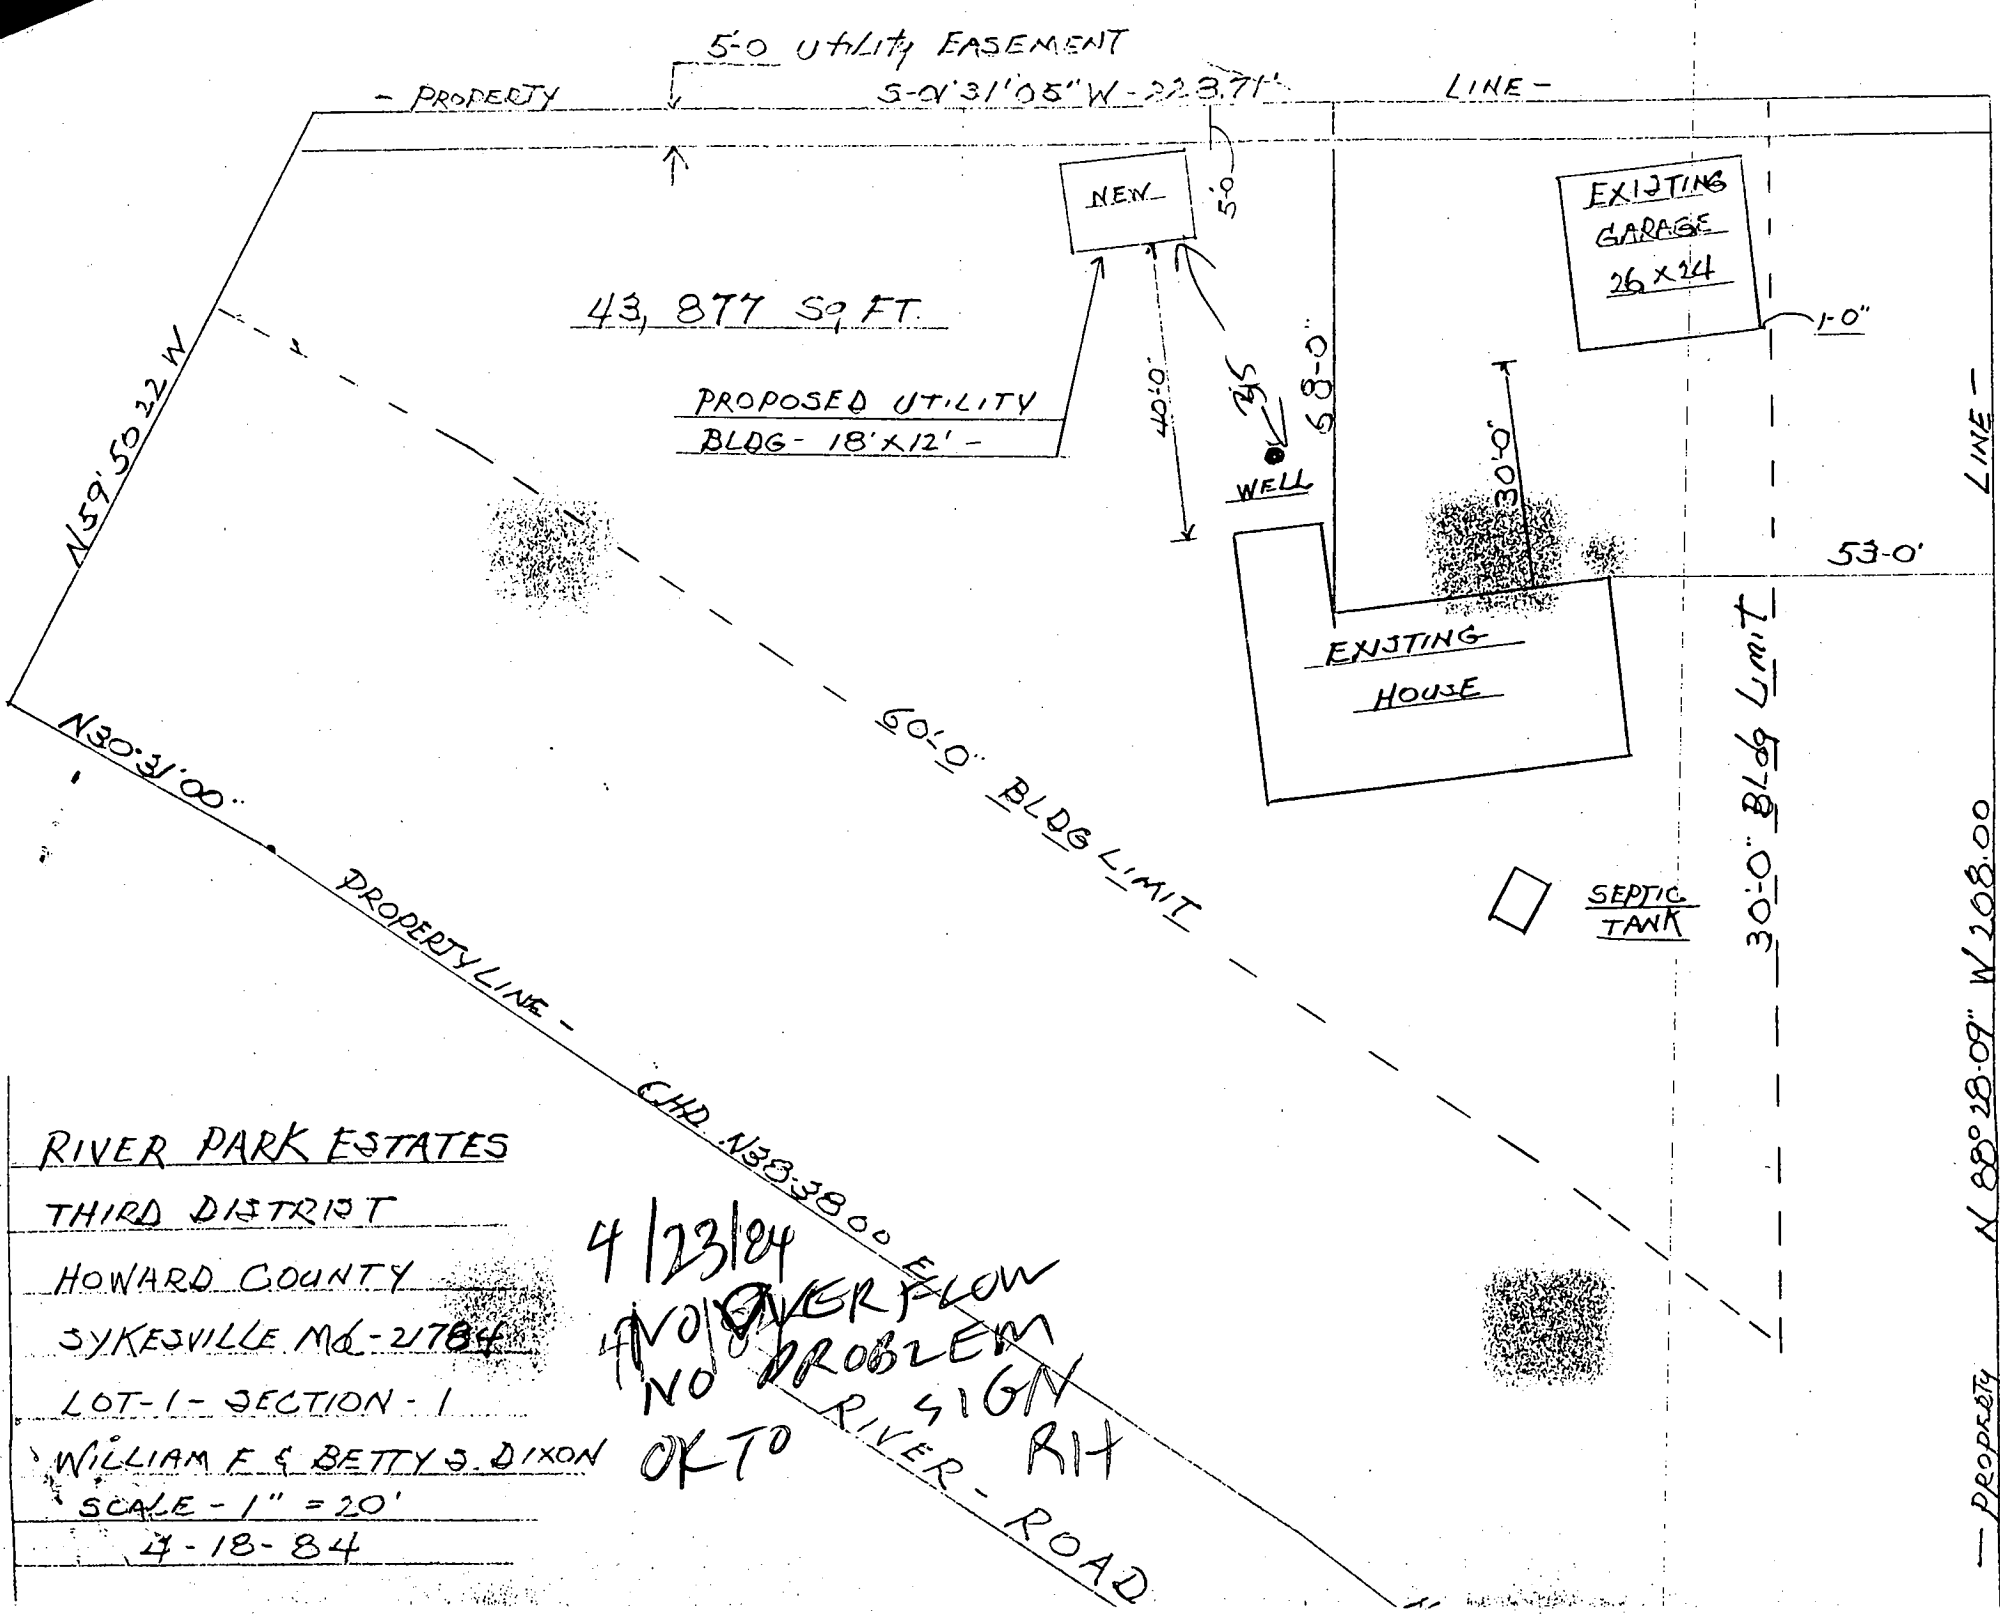

RIVER PARK ESTATES

THIRD DISTRICT

HOWARD COUNTY

SYKESVILLE MD-21784

LOT-1-SECTION-1

WILLIAM F & BETTY S. DIXON

SCALE - 1" = 20'

4-18-84