

PERMIT

SEWAGE DISPOSAL SYSTEM

MARYLAND STATE DEPARTMENT OF HEALTH

HOWARD COUNTY

INDEXED

ELLICOTT CITY

DISTRICT 4

04-309227

DATE 9/4/64

P 08966
A 58905-6
A 08803

Edgar J. Barnes

IS PERMITTED TO INSTALL X ALTER

ADDRESS Woodbine, Maryland

PHONE HU 9-4616

A SEWAGE DISPOSAL SYSTEM LOCATED AT

SUBDIVISION

ROAD

1818 Route 94

LOT

PROPERTY OWNER same as above

ADDRESS

SPECIFICATIONS 3 bedrooms

DRAIN FIELD DEPTH FEET, BOTTOM AREA SQ. FT.

SEEPAGE PITS ABSORBENT SIDE-WALL AREA SQ. FT.

SEPTIC TANK CAPACITY 750 GALLONS

FOR GARBAGE GRINDER, INCREASE DISPOSAL AREA 22% & TANK CAPACITY 50%.

OTHER Dry well - 468 sq. ft. absorbent side wall area below inlet

pipe. Inlet pipe to be 4 ft. below original grade.


Locate dry well 60 ft. from front on trailer in area tested.

PLANS APPROVED BY R. D. Fletcher

DATE 8/23/64

FILL SEPTIC TANK AND DISTRIBUTION BOX WITH WATER BEFORE CALLING FOR AN INSPECTION. COVER NO WORK UNTIL INSPECTED AND APPROVED.

NEITHER THE HOWARD COUNTY COMMISSIONERS NOR THE HEALTH DEPARTMENT IS RESPONSIBLE FOR SUCCESSFUL OPERATION OF ANY SYSTEM.

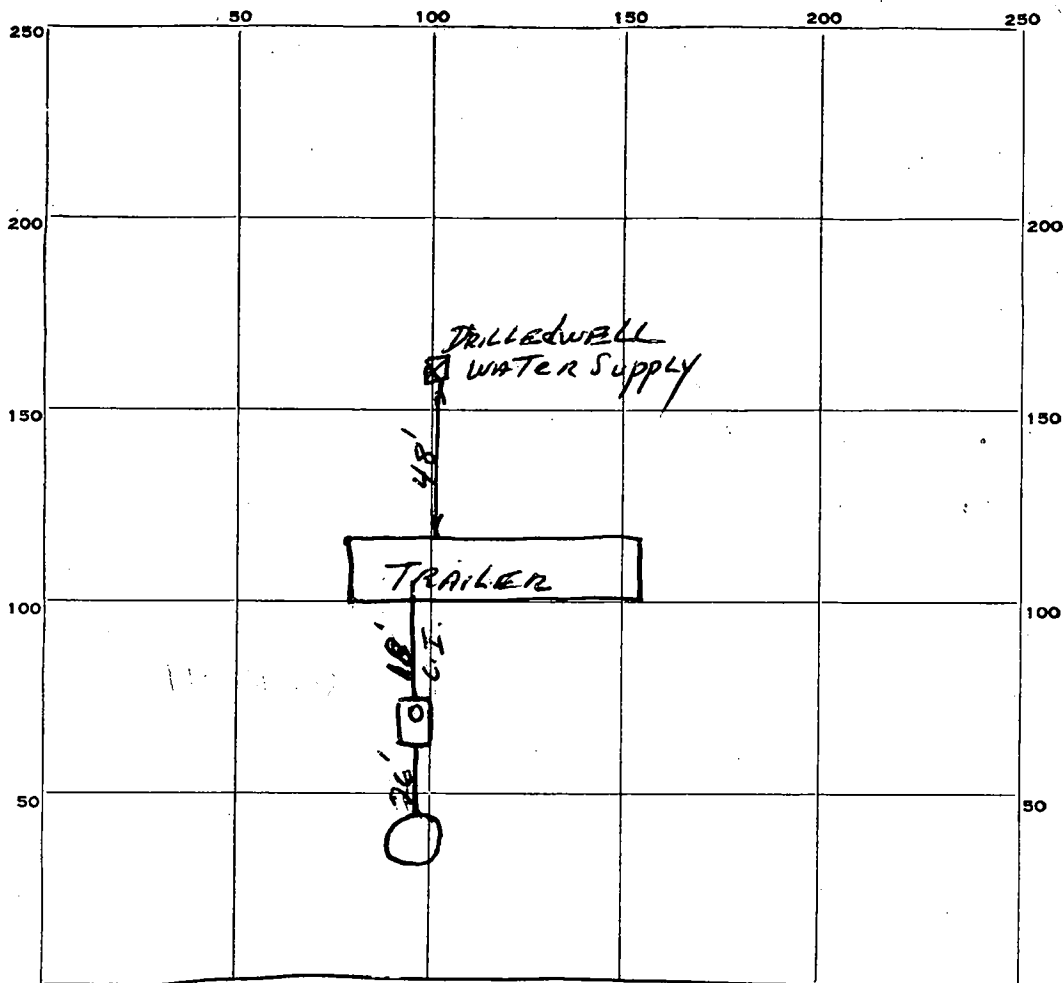

INDICATE NORTH. - NAME ADJOINING ROADWAY AS BASE LINE.

PRIVATE Rd.

To Florence Rd.

PERMIT CARD yes

SEPTIC TANK, LEVEL 4750 gal concrete

CLEANOUTS OK.

DISTRIBUTION BOX, LEVEL none

TILE FIELD, DEPTH _____ FT. TRENCH WIDTH _____ FT.

GRAVEL DEPTH _____ IN. TOTAL LENGTH _____ FT.

NUMBER OF TRENCHES _____ TOTAL BOTTOM AREA _____

SEEPAGE PITS, INSIDE DIAMETER 15' FT. DEPTH BELOW INLET 9'8" FT.

ABSORBENT AREA _____ SQ. FT.

9-21-64 NA enough stone around dry well.
 MARKS 9-22-64 OK stone JH

EM APPROVED

9-22-64

INSPECTOR

J. H. Horgan

APPLICATION

SEWAGE DISPOSAL TESTING

A 08803

P _____

MARYLAND STATE DEPARTMENT OF HEALTH

HOWARD COUNTY

ELLICOTT CITY

Septic tank - 750 gal.

DISTRICT 4

Drywell - 468 sq. ft. absorbent sidewalk
area below inlet pipe. Inlet pipe to be
4 ft below original grade.

DATE 7/23/64

Locate drywell 60 ft. from front on trailer in
area tested.

TO: THE COUNTY HEALTH OFFICER
ELLICOTT CITY, MARYLAND

I, HEREBY, APPLY FOR THE NECESSARY TESTS IN ORDER TO CONSTRUCT (OR RECONSTRUCT) A SEWAGE
DISPOSAL SYSTEM.

PROPERTY OWNER Edgar J. Barnes

ADDRESS Woodbine, Maryland PHONE HU 9-4616

PROPERTY LOCATION:

SUBDIVISION _____ LOT NO. _____

ROAD AND DESCRIPTION Lisbon turn on Florence Rd. - 1 1/2 mile south - ~~first~~ road -
turn right where ^{sign} says Edgar J. Barnes ~~sign~~ that lane.
follow

OCCUPANT _____ PHONE _____

PERSON TO CONSTRUCT SYSTEM _____

ADDRESS _____ PHONE _____

SIZE OF LOT 1 acre TYPE BLDG. 3

NUMBER OF BEDROOMS

IF NOT SINGLE RESIDENCE DESCRIBE _____

SIGNATURE OF APPLICANT William E. Barnes

APPROVED BY J.D. G. [signature] FOR Dannell DATE 6/25/64

(KIND OF SYSTEM)

REJECTED BY _____ FOR _____ DATE _____

(KIND OF SYSTEM)


HOLD PENDING FURTHER TESTS _____ DATE _____

REASONS FOR REJECTION OR HOLDING _____

THIS IS NOT A PERMIT

A 58905-6

40
26
66
18.5
4 | 66

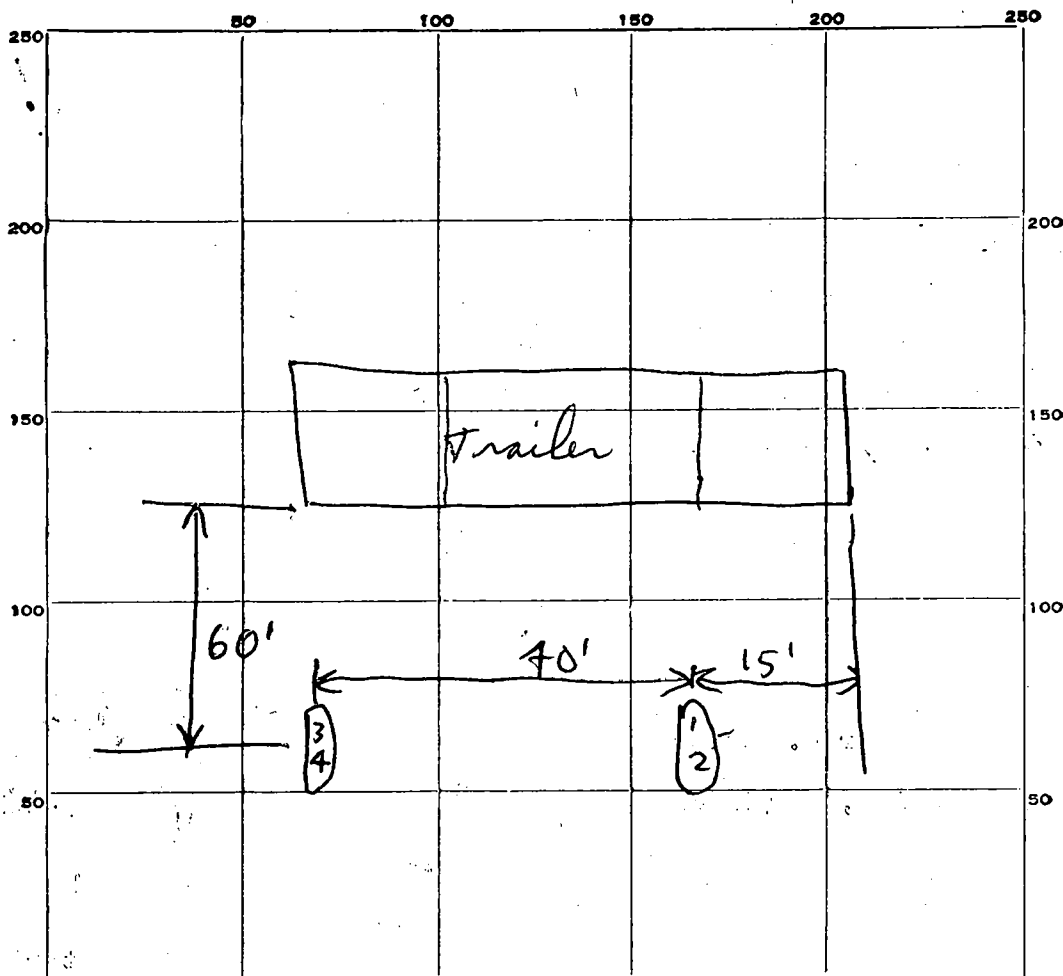

INDICATE NORTH. NAME ADJOINING ROADWAY AS BASE LINE.

Private Rd

→ To Florence Rd

DATE	TEST NO.	DEPTH	PRE-WET		TEST - 1" DROP		TIME
			START	STOP	START	STOP	
8/25/64	1	9 ft	959	1002	1002	1010	8 min.
	2	4 ft	10:00	Overtime on 1st nail Stop Test			
	3	9 ft	1003	1007	1007	1015	8 min.
	4	4 ft	1004	1009	1009	1019	10 min.

SOIL AUGER FINDING

TESTED BY ADE 8/25/64

REMARKS

ALSO PRESENT

William E. Barnes

LOT NO.

OFFICE OF THE ZONING COMMISSIONER
OF HOWARD COUNTY

APPLICATION FOR PERMIT TO PARK TRAILER COACH

Application No. 103

Permit No. _____

Application Date 7/23/64

Zone R-40

District 4th

Use of Trailer Tenant

21.0112

Pursuant to ~~Section 14, Paragraph A, Sub-paragraph X~~ of the Zoning Regulations of Howard County, application is hereby made to the Zoning Commissioner for a Permit to Park a Trailer Coach on property located on W side of Maryland Route 94 ~~Street/Road~~ 1 1/2 ~~mi.~~ South of Maryland Route 144 ~~Street/Road~~.

Acreage 124 A Lot Size x Lot No. Blk. Section

Subdivision or Locality Woodbine, Maryland

Property Owner Edgar J. Barnes Address Woodbine, Maryland

Trailer Coach Owner William E. Barnes Address Woodbine, Maryland

Location of Trailer Coach on property East end of above described property
1000 ft. from nearest public road, 100 ft. from nearest property line.

HEALTH DEPARTMENT OF HOWARD COUNTY

APPROVED: Date 8/25/64 BY Ronald Fletcher

Date Issued _____	Period of _____	Expiration Date _____	Fee Pd. \$ _____
Date Renewed _____	Period of _____	Expiration Date _____	Fee Pd. \$ _____
Date Renewed _____	Period of _____	Expiration Date _____	Fee Pd. \$ _____
Date Renewed _____	Period of _____	Expiration Date _____	Fee Pd. \$ _____

STATE OF MARYLAND
DEPARTMENT OF WATER RESOURCESState Office Building
ANNAPOLIS, MARYLAND 21401No. 30
DEPT. OF
WATER RESOURCES
ANNAPOLIS, MD.
1964 AUG 27 AM 8:48

APPLICATION FOR PERMIT TO DRILL WELL

An application must be submitted and permit received before drilling a well

Owner William C. Barnes
Street or R. F. D. _____
Post Office Woodbine Md.Driller J. Flanagan License Number 132
Street or R. F. D. _____
Post Office St. Marys Md.
Date Aug 24/64Quantity of Water Needed (G.P.M.) 5
Use for Water Trailer
Approximate Depth of Well (feet) 100
Method of Drilling to be used RotaryLocation of Well
County Howard
Nearest Town Lifton
Distance from Town 1 mile
Direction from Town SPERMIT TO DRILL WELL
(Permit to be returned to Driller)

NOT TO BE FILLED IN BY DRILLER

Permit No. HO-65-W-193Samples of Cuttings ☒ Yes
Required by Department ☐ NoOwner Requires Permit ☒ Yes
to Appropriate Water ☐ NoOwner Has Permit ☒ Yes
to Appropriate Water ☐ No

The applicant is herewith granted a permit to drill this well subject to the conditions stipulated.

Baul W. McKee

Director

Date AUG 28 1964

Special conditions that may apply:

Health Department Approval of Application

Howard County Department of Healthor ☐ State Department of HealthApproved by Chas. F. WenzTitle Chief SanitarianDate 8/26/64

Mailed 8/26/64 (HEALTH DEPARTMENT COPY)


Description of Location of Well

(This information should be definite enough to permit locating well on a county map).

Near what road 94On which side of road ✓
(North, East, South, West)Distance from road 300 yds

Draw a sketch below showing location of well in relation to nearby towns, roads and streams with north in the direction of the arrow, and give distance from well to nearest road junction or stream crossing shown on the sketch.

NORTH

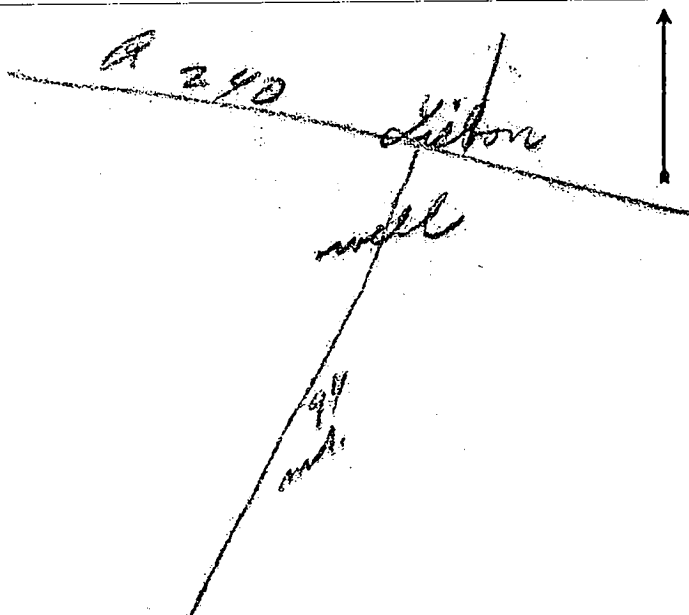

APPLICATION

PERCOLATION TESTING

A 48976

P _____

HOWARD COUNTY HEALTH DEPARTMENT
BUREAU OF ENVIRONMENTAL HEALTH
3525-H ELLICOTT MILLS DRIVE/ELLICOTT CITY, MARYLAND 21043
TELEPHONE: 313-2640

DISTRICT _____

DATE 2/24/93

TO: THE COUNTY HEALTH OFFICER
ELLICOTT CITY, MARYLAND

EX HOUSE
INDEXED AS
A 08803

PROPOSAL IS FOR
TENANT HOUSE
(POTENTIALLY TO
BECOME 1 ACRE LOT)

EXISTING HOUSE ON PROPERTY
IS FAR ENOUGH AWAY (APPROX 1000')
TO NOT BE RELATED TO THIS TRANSACTION
2/24/93 (W)

I HEREBY APPLY FOR THE NECESSARY TEST PRIOR TO APPLICATION FOR PERMIT TO CONSTRUCT (OR RECONSTRUCT) A SEWAGE DISPOSAL SYSTEM.

PROPERTY OWNER

William E Barnes

ADDRESS

1878 RT. 94 Woodbine Md 21797 PHONE 410-489-4465

AGENT OR PROSPECTIVE BUYER _____

ADDRESS _____

PHONE _____

PROPERTY LOCATION:

SUBDIVISION _____

LOT NO. _____

ROAD AND DESCRIPTION

RT. 94 2 mi. South of Lisbon

TAX MAP

7

PARCEL #

246

SIZE OF LOT

70+ ACRES

TYPE BLDG.

S.F.D. - Tent Trailer
(SINGLE FAMILY DWELLING OR COMMERCIAL)

THE SYSTEM INSTALLED UNDER THIS APPLICATION IS ACCEPTABLE ONLY UNTIL PUBLIC FACILITIES BECOME AVAILABLE. I FULLY UNDERSTAND THE

FEE CONNECTED WITH THE FILING OF THIS PERC TEST APPLICATION IS NON-REFUNDABLE UNDER ANY CIRCUMSTANCES. I ALSO AGREE TO

COMPLY WITH ALL M.O.S.H.A. REQUIREMENTS IN TESTING THIS LOT.

William E Barnes
(SIGNATURE OF APPLICANT)

APPROVED BY

R HODGES

FOR

TENANT HOUSE

DATE

3/30/93

DISAPPROVED BY _____

FOR _____

DATE _____

HOLD PENDING FURTHER TESTS _____

REASONS FOR REJECTION OR HOLDING _____

PERCOLATION TEST PLAT/PRELIMINARY PLAT - TITLE OR I.D. # _____

DATE _____

SITE DEVELOPMENT PLAN/FINAL PLAT - TITLE OR I.D. # _____

DATE _____

THIS IS NOT A PERMIT

A48976


COUNTY #

SOIL PROFILE

0' TAN CLAY
 3' TOPSOIL
 BRN
 TAN
 PINK
 SAND
 LOAM
 FLAKE

4' (2)
 TOPSOIL
 TAN CLAY
 TAN
 PINK
 FLAKE
 SAND
 LOAM

11' (3)
 TOPSOIL
 TAN CLAY
 TAN
 PINK
 FLAKE
 SAND
 LOAM
 HARD

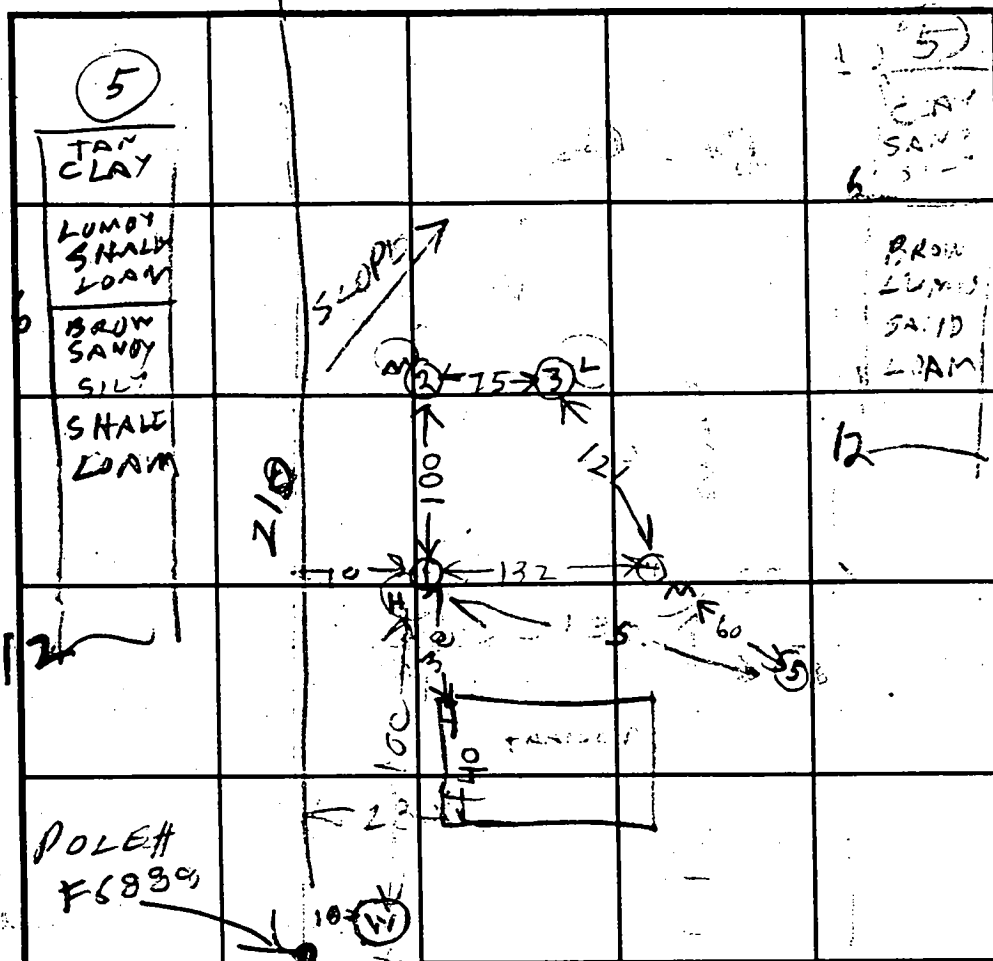

SOIL PROFILE

0' TOPSOIL
 TAN CLAY
 PINK
 TAN
 BROWN
 FLAKE
 SAND
 LOAM

HOLE ELEVATION

(1) = HIGH
 (2) = MEDIUM
 (3) = LOW

INDICATE NORTH - NAME ADJOINING ROADWAY AS BASE LINE.

DATE	TEST NO.	DEPTH	PRE-WET		TEST - 1" DROP		TIME
			START	STOP	START	STOP	
3/30/93	15	5	1113	1114	1113	1122	5
"	14	5	1114	1119	1119	1131	13
"	14	5	OK				
"	23	5	1122	1147	1147	1212	25
"	24	8	1127	1147	1147	1215	28
"	24	11	OK				
"	33	5	1134	1151	1151	1210	19
"	34	8	1134	1151	1151	1210	19
"	34	13	2				
"	35	6 1/2	1237	104	104	155	50
"	40	8	1153	1157	1157	1202	5
"	45	4 1/2	1209	1217	1217	1240	23
"	44	12 1/2	OK	HEAVY			
"	55	5	221	225	225	240	2
"	56	5	230	233	233	242	2

REMARKS

TYPE OF SOIL EXISTING HOUSES ON FARM - NO OVERFLOW

TESTED BY R. HODGES

BACKLASH OWNER
ALSO PRESENT WILLIAM E. RAY

TRENCH DESIGN DATA: AVERAGE PERCOLATION TIME TRENCH WIDTH 2

INLET DEPTH 5 MAXIMUM BOTTOM DEPTH 10 SQ. FT./BEDROOM

210 X 210 SODAS LAND PRESENTATION IN FUTURE