

9/1/66 - Approved JHK

P 12145  
A 58905-H  
A 10955

# PERMIT

SEWAGE DISPOSAL SYSTEM

MARYLAND STATE DEPARTMENT OF HEALTH

HOWARD COUNTY

ELLICOTT CITY

DISTRICT 5

DATE 8/31/66

INDEXED

Not found

Excavating Contractors, Inc. IS PERMITTED TO INSTALL ☒ ALTER

ADDRESS Autumn Hill Dr., Ellicott City, Md. PHONE HO 5-3849

A SEWAGE DISPOSAL SYSTEM LOCATED AT

SUBDIVISION ROAD Rt. 108 - Highland LOT

PROPERTY OWNER Sylvester Fowler

ADDRESS Highland, Maryland

SPECIFICATIONS - 2 bedrooms

DRAIN FIELD DEPTH FEET, BOTTOM AREA SQ. FT.

SEEPAGE PITS ABSORBENT SIDE-WALL AREA SQ. FT.

SEPTIC TANK CAPACITY 750 GALLONS

FOR GARBAGE GRINDER, INCREASE DISPOSAL AREA 22% & TANK CAPACITY 50%.

OTHER Dry well - 300 sq. ft. sidewall absorbent area below the inlet pipe located 18 ft. from left side property line and 18 ft. from right rear corner of large shed as seen when facing lot from Rt. 108.


PLANS APPROVED BY J. H. Kilmore DATE 10/7/65

FILL SEPTIC TANK AND DISTRIBUTION BOX WITH WATER BEFORE CALLING FOR AN INSPECTION. COVER NO WORK UNTIL INSPECTED AND APPROVED.

NEITHER THE HOWARD COUNTY COMMISSIONERS NOR THE HEALTH DEPARTMENT IS RESPONSIBLE FOR THE SUCCESSFUL OPERATION OF ANY SYSTEM.

NOTIFY THE HEALTH DEPARTMENT 48 HOURS BEFORE EXCAVATIONS ARE TO BE BACK FILLED.

58905-H  
10955

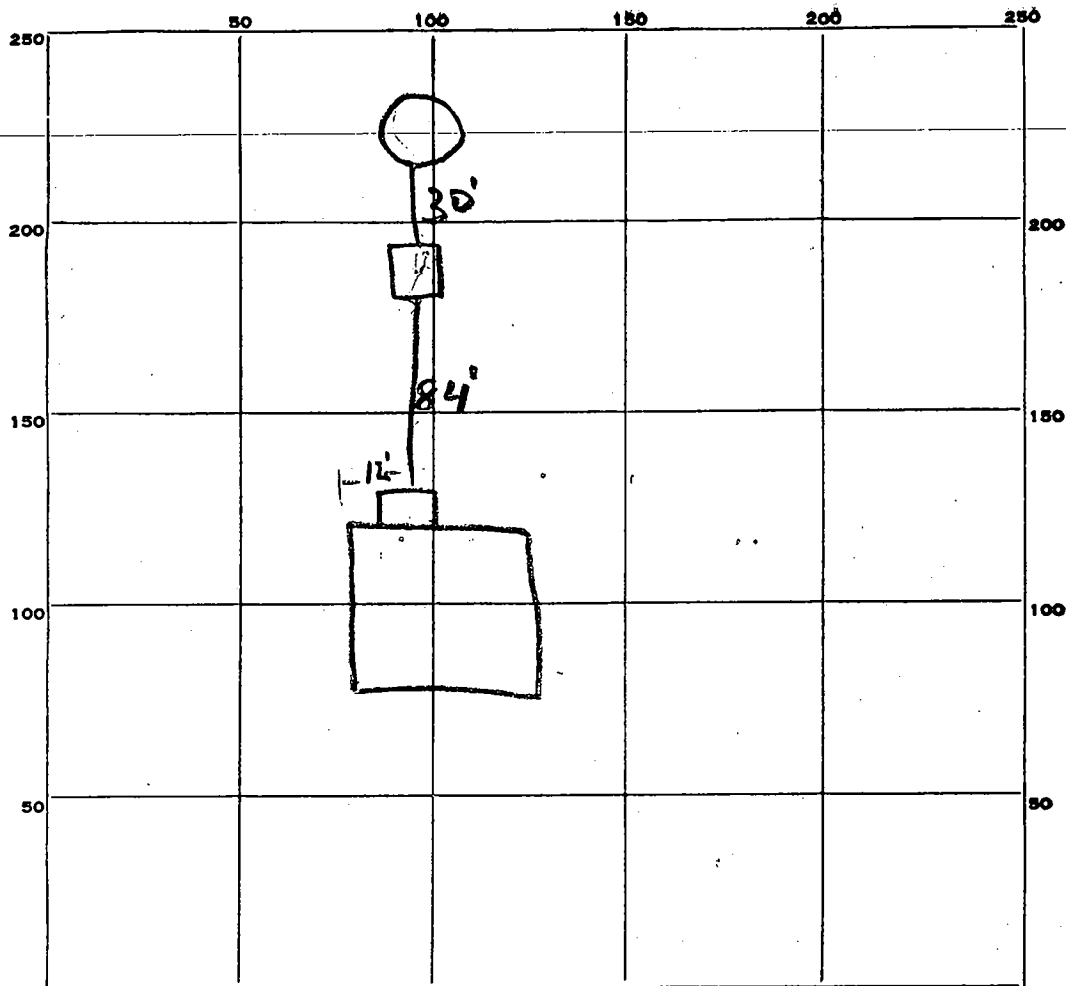

INDICATE NORTH. - NAME ADJOINING ROADWAY AS BASE LINE.

PERMIT CARD Not posted Rte 108

SEPTIC TANK, LEVEL OK CLEANOUTS OK

DISTRIBUTION BOX, LEVEL \_\_\_\_\_

TILE FIELD, DEPTH \_\_\_\_\_ FT. TRENCH WIDTH \_\_\_\_\_ FT.

GRAVEL DEPTH \_\_\_\_\_ IN. TOTAL LENGTH \_\_\_\_\_ FT.

NUMBER OF TRENCHES \_\_\_\_\_ TOTAL BOTTOM AREA \_\_\_\_\_

SEEPAGE PITS, INSIDE DIAMETER 14 FT. DEPTH BELOW INLET 9 FT.

ABSORBENT AREA 395 SQ. FT.

750 or +

REMARKS \_\_\_\_\_

\_\_\_\_\_

\_\_\_\_\_

DATE SYSTEM APPROVED 9/1/66 INSPECTOR JH Kilmore