

3/25/97 noon

PERMIT

SEWAGE DISPOSAL SYSTEM

DEPARTMENT OF HEALTH AND MENTAL HYGIENE

P 58007B

A REPAIR

DISTRICT

DATE 03/06/97

HOWARD COUNTY HEALTH DEPARTMENT

BUREAU OF ENVIRONMENTAL HEALTH

~~X 313-2640~~

313-2640

302628
INDEXED

DATE SYSTEM APPROVED 3/25/97

INSPECTOR M. Ripkin

Jack Fyock Septic Service, Inc.

IS PERMITTED TO INSTALL ALTER X

ADDRESS 13775 Triadelphia Road, Glenelg, Maryland 21737 PHONE 988-9270

SUBDIVISION Henryton Heights LOT 8, Sec.1 ROAD 11857 Ramsburg Road

PROPERTY OWNER Lewis Tringali

ADDRESS 11857 Ramsburg Road
Marriottsville, Maryland 21104

SEPTIC TANK CAPACITY 1000 GALLONS

NUMBER OF BEDROOMS 3

125 SQUARE FEET PER BEDROOM

LINEAR FEET OF TRENCH REQUIRED 95±

REPAIR - PURPOSE - SEPTIC SYSTEM HAS FAILED.

Call for inspection when ground is opened so sanitarian can recommend repair,
03/06/97

INV 2½ BOT 6½ 2' WIDE 4' STONE

PLANS APPROVED BY DATE

COVER NO WORK UNTIL INSPECTED AND APPROVED

NEITHER THE HOWARD COUNTY COUNCIL NOR THE HEALTH DEPARTMENT IS RESPONSIBLE FOR THE SUCCESSFUL OPERATION OF ANY SYSTEM

NOTE: CLEANOUT REQUIRED EVERY 70 FEET OF SEWER LINE AND/OR AT 90° SWEEPS IN LINES FROM HOUSE TO DRAIN FIELDS, 90° ELBOWS NOT ACCEPTABLE.

NOTE: ALL PARTS OF SEPTIC SYSTEMS (I.E. TANK, DISTRIBUTION BOX TRENCHES) TO BE 100 FEET FROM WELL (UNLESS OTHERWISE SPECIFICALLY AUTHORIZED)

NOTE: IF DEEP TRENCH(ES) ARE USED CALL FOR INSPECTION BEFORE AND AFTER PLACING GRAVEL IN TRENCH(ES)

NOTE: NO DRY WELL SHALL EXCEED 15 FOOT IN DIAMETER NO ABSORPTION TRENCH TO EXCEED 100 FEET IN LENGTH

NOTE: ALL PIPE FROM HOUSE TO SEPTIC TANK MUST BE CAST IRON OR SCHEDULE 35/40 PVC OR ABS


PERMIT VOID AFTER TWO YEARS

NOTE: INSTALL STAND PIPE ON SEPTIC TANK AND DRY WELL STAND PIPES MUST BE 6 INCHES IN DIAMETER CAST IRON. CONCRETE OR TERRA COTTA OR PVA OR ABS ACCEPTED. IF TOP OF SEPTIC TANK IS DEEPER THAN 3 FEET. MANHOLE TO GRADE REQUIRED.

NOTE: DISTRIBUTION BOXES MUST HAVE BAFFLES

*INSTALLER IS RESPONSIBLE FOR OBTAINING FINAL APPROVAL ON THIS PERMIT

P 58007-B

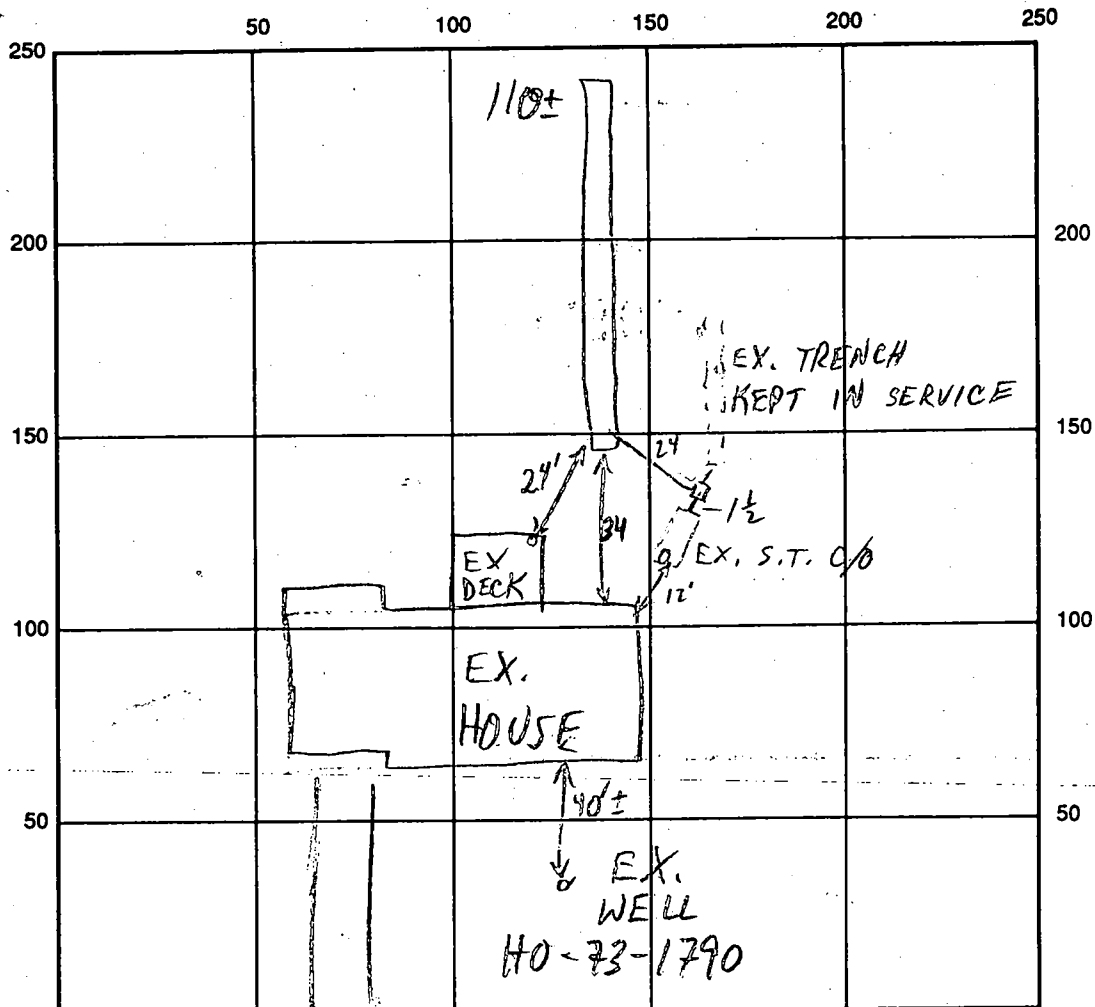

RAMSBURG RD INDICATE NORTH - NAME ADJOINING ROADWAY AS BASE LINE

SEPTIC TANK LEVEL EX-OK CLEANOUTS EX. ON S.T. OK
 DISTRIBUTION BOX LEVEL OK-BAFFLE IN
 DRAIN FIELD/TITLE DEPTH 10 1/2 FT. TRENCH WIDTH 2 FT. INLET DEPTH 2 1/2 FT.
 EFFECTIVE GRAVEL DEPTH 4 FT. TOTAL LENGTH 110± FT.
 NUMBER OF TRENCHES 1 ONE SIDEWALL/BOTTOM AREA 440 SQ. FT.
 DRYWALL INSIDE DIAMETER — FT. EFFECTIVE DEPTH BELOW INLET — FT.
 ABSORBENT AREA 440 SQ. FT.

REMARKS: 3/25/97 OK TO FINISH & COVER MR

DATE SYSTEM APPROVED

3/28/97

INSPECTOR

M. Ripkin

19293

PERMIT
SEWAGE DISPOSAL SYSTEM
MARYLAND STATE DEPARTMENT OF HEALTH
HOWARD COUNTY

INDICATE NORTH - NAME ADJOINING ROADWAY AS BASE LINE
RAMSBURG RD

DATE 6/1/77 DISTRICT 1 CITY ELICOTT CITY

ADDRESS 1073 PINE PHONE 5073 1990

LOCATION OF SEWAGE DISPOSAL SYSTEM LOCATED AT location on per spec

PROPERTY OWNER James T. B. B. B. ADDRESS 1073 PINE

SPECIFICATIONS 3 1/2" DIA

DEPT. BOTTOM BELL 1073 PINE DRAIN FIELD

INDICATE NORTH - NAME ADJOINING ROADWAY AS BASE LINE
RAMSBURG RD

PERMIT CARD ☒

SEPTIC TANK, LEVEL 1000 gal or

CLEANOUTS ☒

DISTRIBUTION BOX, LEVEL 5

DEEP TRENCH

FIELD, DEPTH 8 FT. TRENCH WIDTH 2 FT.

GRAVEL DEPTH 4 FT.

TOTAL LENGTH 98 FT.

NUMBER OF TRENCHES 1

TOTAL BOTTOM AREA 392

392

SEEPAGE PITS, INSIDE DIAMETER 1 FT.

DEPTH BELOW INLET 1 FT.

ABSORBENT AREA 1 SQ. FT.

REMARKS

6/1/77 Touch OK for stone WW2

6/2/77 OK to cover

DATE SYSTEM APPROVED 6/2/77

INSPECTOR H. H. Jupp, T. Ogle

