

PERMIT

SEWAGE DISPOSAL SYSTEM

DEPARTMENT OF HEALTH AND MENTAL HYGIENE

HOWARD COUNTY HEALTH DEPARTMENT

BUREAU OF ENVIRONMENTAL HEALTH

XXXXXXXX 313-2640

P 58053D

A REPAIR

DISTRICT _____

DATE 03/28/97

DATE SYSTEM APPROVED 4/10/97

INSPECTOR JKS

352894

INDEXED

Jack Fyock Septic Service

IS PERMITTED TO INSTALL _____ ALTER ☒ X

ADDRESS 13775 Triadelphia Road, Glenelg, Maryland 21737 PHONE 988-9270

Parcel 125

SUBDIVISION Heritage Heights LOT 6, Block D ROAD 6105 Thompson Drive

PROPERTY OWNER Hedrick

ADDRESS 6105 Thompson Drive
Clarksville, Maryland 21029

SEPTIC TANK CAPACITY Existing GALLONS

NUMBER OF BEDROOMS 3

125 SQUARE FEET PER BEDROOM

LINEAR FEET OF TRENCH REQUIRED 60'±

REPAIR - PURPOSE - SEPTIC SYSTEM HAS FAILED.

Call for inspection when ground is opened so sanitarian can recommend repair.
03/28/97

total 2-30' trenches, 6' wide, 1' dia 2.0', bottom 3.5',
slope 1.5'

Trenches to be installed on exterior, w/dig. box
off existing septic tank.

PLANS APPROVED BY J. Fyock DATE 4/10/97

COVER NO WORK UNTIL INSPECTED AND APPROVED

NEITHER THE HOWARD COUNTY COUNCIL NOR THE HEALTH DEPARTMENT IS RESPONSIBLE FOR THE SUCCESSFUL OPERATION OF ANY SYSTEM

NOTE: CLEANOUT REQUIRED EVERY 70 FEET OF SEWER LINE AND/OR AT 90° SWEEPS IN LINES FROM HOUSE TO DRAIN FIELDS, 90° ELBOWS NOT ACCEPTABLE.

NOTE: ALL PARTS OF SEPTIC SYSTEMS (I.E. TANK, DISTRIBUTION BOX TRENCHES) TO BE 100 FEET FROM WELL (UNLESS OTHERWISE SPECIFICALLY AUTHORIZED)

NOTE: IF DEEP TRENCH(ES) ARE USED CALL FOR INSPECTION BEFORE AND AFTER PLACING GRAVEL IN TRENCH(ES)

NOTE: NO DRY WELL SHALL EXCEED 15 FOOT IN DIAMETER NO ABSORPTION TRENCH TO EXCEED 100 FEET IN LENGTH

NOTE: ALL PIPE FROM HOUSE TO SEPTIC TANK MUST BE CAST IRON OR SCHEDULE 35/40 PVC OR ABS

PERMIT VOID AFTER TWO YEARS

NOTE: INSTALL STAND PIPE ON SEPTIC TANK AND DRY WELL STAND PIPES MUST BE 6 INCHES IN DIAMETER CAST IRON. CONCRETE OR TERRA COTTA OR PVA OR ABS ACCEPTED. IF TOP OF SEPTIC TANK IS DEEPER THAN 3 FEET. MANHOLE TO GRADE REQUIRED.

NOTE: DISTRIBUTION BOXES MUST HAVE BAFFLES


*INSTALLER IS RESPONSIBLE FOR OBTAINING FINAL APPROVAL ON THIS PERMIT

P 58053-D

[illegible]

Thompson Drive

DATE SYSTEM APPROVED 4/10/97 INSPECTOR [Signature]

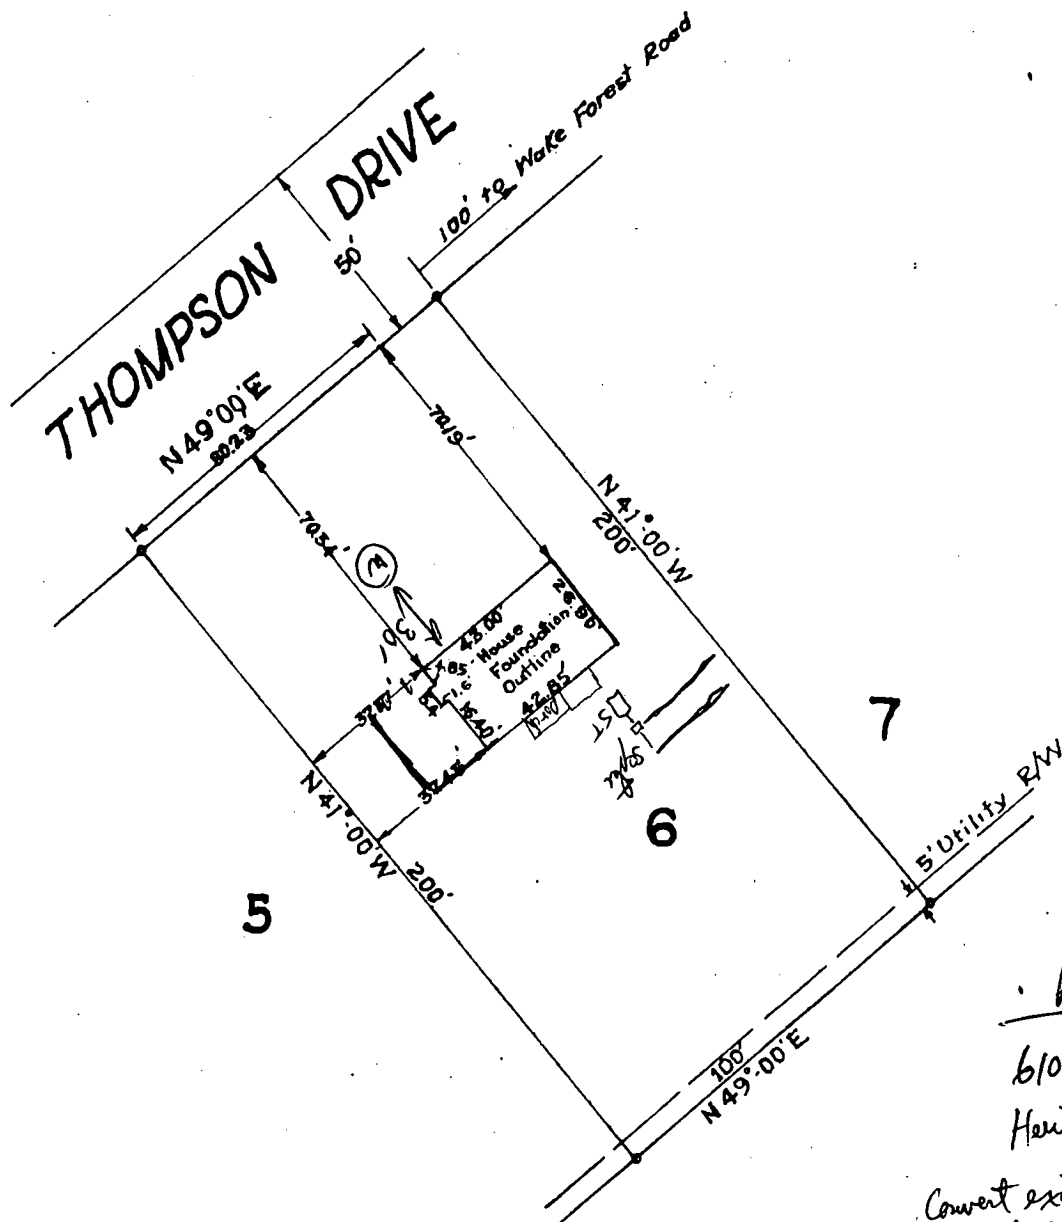

N


B00127374
 6105 Thompson Dr
 Heritage Htgs 6th
 Convert existing Garage to
 Family Room, No change in
 # of Bdrms.
 Recommended approval
 11/9/00

LOCATION SURVEY
 for
 WILLIAM M. ROBBINS
 Lot No. 6-BLOCK D
 HERITAGE HEIGHTS
 Clarksville, Maryland
 Scale: 1"=50 August 21, 1957

ENGINEER'S CERTIFICATE

I hereby certify that the improvements shown hereon have been located by a transit-tape survey and there are no encroachments.

Claude M. Skinner, Jr.
 CLAUDE M. SKINNER REG. ENGINEER &
 LAND SURVEYOR No. 2237

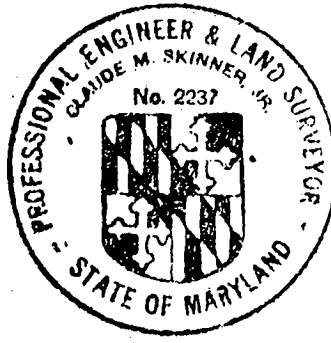

FILE No. 1423