

8/25/97
12-1

PERMIT

SEWAGE DISPOSAL SYSTEM

DEPARTMENT OF HEALTH AND MENTAL HYGIENE

04-356306

HOWARD COUNTY HEALTH DEPARTMENT

BUREAU OF ENVIRONMENTAL HEALTH

461-9933 313-2640

INDEXED

P 58917

A REPAIR

DISTRICT

DATE 8-13-97

DATE SYSTEM APPROVED 8/25/97

INSPECTOR

Jack Fyock Septic Service

IS PERMITTED TO INSTALL ALTER ☒

ADDRESS 4105 Ten Oaks Road Glenelg, MD 21737 PHONE (410) 988-9270

SUBDIVISION Gwyndyl Oak Estates LOT 33 ROAD 2840 Rolling Fork Way

PROPERTY OWNER Mr. Earl Arnette

ADDRESS

SEPTIC TANK CAPACITY 1250 GALLONS

NUMBER OF BEDROOMS 4

SQUARE FEET PER BEDROOM

LINEAR FEET OF TRENCH REQUIRED

REPAIR - PURPOSE - IN SUPPORT OF BUILDING PERMIT B00107405.- SEPTIC TANK TO BE RELOCATED.

Call for inspection when septic tank has been relocated so sanitarian can approve location. 08/13/97

Plan change - change by eliminating Septic Trench #1 and add a replacement trench (65 ft) parallel to + down slope (on right hand side) of old Trench #2 (65 ft long). Change approved conversation Jack Fyock (Ch/Padg) 8/17/97

PLANS APPROVED BY Amy Mc Millen

DATE 08/13/97

COVER NO WORK UNTIL INSPECTED AND APPROVED

NEITHER THE HOWARD COUNTY COUNCIL NOR THE HEALTH DEPARTMENT IS RESPONSIBLE FOR THE SUCCESSFUL OPERATION OF ANY SYSTEM

NOTE: CLEANOUT REQUIRED EVERY 70 FEET OF SEWER LINE AND/OR AT 90° SWEEPS IN LINES FROM HOUSE TO DRAIN FIELDS, 90° ELBOWS NOT ACCEPTABLE.

NOTE: ALL PARTS OF SEPTIC SYSTEMS (I.E. TANK, DISTRIBUTION BOX TRENCHES) TO BE 100 FEET FROM WELL (UNLESS OTHERWISE SPECIFICALLY AUTHORIZED)

NOTE: IF DEEP TRENCH(ES) ARE USED CALL FOR INSPECTION BEFORE AND AFTER PLACING GRAVEL IN TRENCH(ES)

NOTE: NO DRY WELL SHALL EXCEED 15 FOOT IN DIAMETER NO ABSORPTION TRENCH TO EXCEED 100 FEET IN LENGTH

NOTE: ALL PIPE FROM HOUSE TO SEPTIC TANK MUST BE CAST IRON OR SCHEDULE 35/40 PVC OR ABS

PERMIT VOID AFTER TWO YEARS

NOTE: INSTALL STAND PIPE ON SEPTIC TANK AND DRY WELL STAND PIPES MUST BE 6 INCHES IN DIAMETER CAST IRON, CONCRETE OR TERRA COTTA OR PVA OR ABS ACCEPTED. IF TOP OF SEPTIC TANK IS DEEPER THAN 3 FEET, MANHOLE TO GRADE REQUIRED.

NOTE: DISTRIBUTION BOXES MUST HAVE BAFFLES

*INSTALLER IS RESPONSIBLE FOR OBTAINING FINAL APPROVAL ON THIS PERMIT

HD-260(6-90)

*CALL 461-9933 FOR INSPECTION OF SEPTIC SYSTEM.

BUILD PERMIT SIGN


AND RETURNED 8-13-97

Serial # B00107405

Original prd.

58917

for details of
original Sept
permit

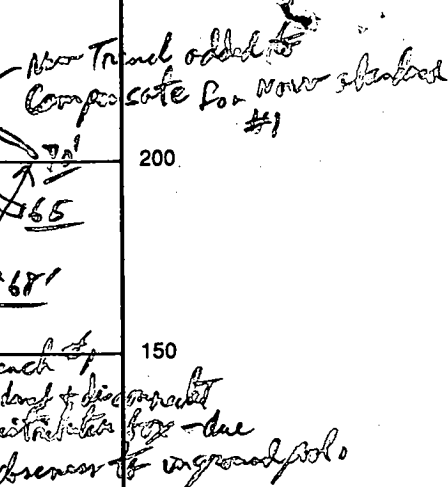

SEPTIC TANK LEVEL Near 1250 gal (Midseason) (Replaces old 1250 gal which was abandoned (collapsed) & filled to ground)
CLEANOUTS ✓

EFFECTIVE GRAVEL DEPTH 2 FT. TOTAL LENGTH 70 FT. (245 Lin Ft total, Not counting Discards)

ABSORBENT AREA _____ SQ. FT.

REMARKS: Old section of ditch, collapsed & gravel filled in place. New S.T. New Trench connects to old. Last box was ok to cover - old #1 trench is connected just at last box. JEP 8/25/87

18th

C.O. 2:00
10-15-96

PERMIT

SEWAGE DISPOSAL SYSTEM

DEPARTMENT OF HEALTH AND MENTAL HYGIENE

HOWARD COUNTY HEALTH DEPARTMENT
BUREAU OF ENVIRONMENTAL HEALTH

313-2640

INDEXED

P 57072A

A 44261

DISTRICT _____

DATE 8/27/96

DATE SYSTEM APPROVED 10/16/96

INSPECTOR ALM

South Carroll Backhoe, Inc.

IS PERMITTED TO INSTALL ☒ ALTER

ADDRESS 4410 Salem Bottom Road, Westminster, Maryland 21157 PHONE 875-4197

SUBDIVISION Gwyndyl Oak Estates LOT 33 ROAD 2840 Rolling Fork Way

PROPERTY OWNER NV Homes Earl Arnette

ADDRESS _____

SEPTIC TANK CAPACITY 1250 GALLONS

NUMBER OF BEDROOMS 4

180 SQUARE FEET PER BEDROOM

LINEAR FEET OF TRENCH REQUIRED 240

TRENCHES - Trench to be 3 feet wide. Inlet 3 feet below original grade. Bottom maximum depth 5 feet below original grade. Effective area begins at 3 feet below original grade. 2 feet of stone below distribution pipe.

LOCATION - Place distribution box 175' up the right lot line (338.21) and 75' off that same lot line as seen when facing the lot from Rolling Fork Way. Run trenches on contour in both directions.

NOTES - No trench to exceed 100 feet in length. Provide 6" - 8" diameter cleanout and cap to grade or above on septic tank. OK 8/17/96 DKS

PLANS APPROVED BY Amy McMillen

DATE 7/19/96

COVER NO WORK UNTIL INSPECTED AND APPROVED

NEITHER THE HOWARD COUNTY COUNCIL NOR THE HEALTH DEPARTMENT IS RESPONSIBLE FOR THE SUCCESSFUL OPERATION OF ANY SYSTEM

NOTE: CLEANOUT REQUIRED EVERY 70 FEET OF SEWER LINE AND/OR AT 90° SWEEPS IN LINES FROM HOUSE TO DRAIN FIELDS, 90° ELBOWS NOT ACCEPTABLE.

NOTE: ALL PARTS OF SEPTIC SYSTEMS (I.E. TANK, DISTRIBUTION BOX TRENCHES) TO BE 100 FEET FROM WELL (UNLESS OTHERWISE SPECIFICALLY AUTHORIZED)

NOTE: IF DEEP TRENCH(ES) ARE USED CALL FOR INSPECTION BEFORE AND AFTER PLACING GRAVEL IN TRENCH(ES)

NOTE: NO DRY WELL SHALL EXCEED 15 FOOT IN DIAMETER NO ABSORPTION TRENCH TO EXCEED 100 FEET IN LENGTH

NOTE: ALL PIPE FROM HOUSE TO SEPTIC TANK MUST BE CAST IRON OR SCHEDULE 35/40 PVC OR ABS

PERMIT VOID AFTER TWO YEARS


NOTE: INSTALL STAND PIPE ON SEPTIC TANK AND DRY WELL STAND PIPES MUST BE 6 INCHES IN DIAMETER CAST IRON, CONCRETE OR TERRA COTTA OR PVA OR ABS ACCEPTED. IF TOP OF SEPTIC TANK IS DEEPER THAN 3 FEET, MANHOLE TO GRADE REQUIRED.

NOTE: DISTRIBUTION BOXES MUST HAVE BAFFLES

*INSTALLER IS RESPONSIBLE FOR OBTAINING FINAL APPROVAL ON THIS PERMIT

BLDG. PERMIT SIGNED
AND RETURNED 11/14/96
Bulld # B10103042
Install 1-500 gal. under septic tank

A 44261

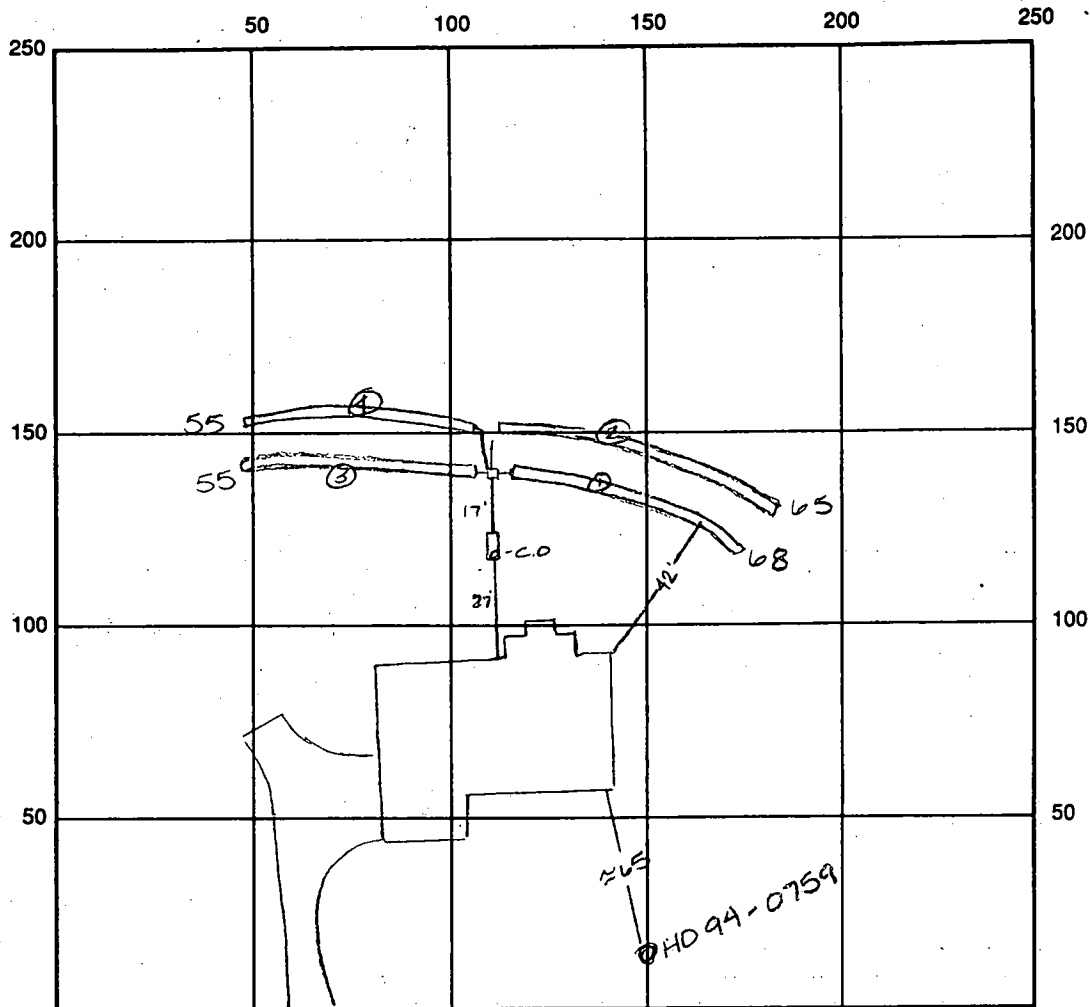

INDICATE NORTH - NAME ADJOINING ROADWAY AS BASE LINE Rolling Fork Way

SEPTIC TANK LEVEL 1250 gal CLEANOUTS OK

DISTRIBUTION BOX LEVEL OK baffle 15 in

DRAIN FIELD/TITLE DEPTH 5.0 FT. TRENCH WIDTH 3.0 FT. INLET DEPTH 3.0 FT.

EFFECTIVE GRAVEL DEPTH 2.0 FT. TOTAL LENGTH 243 FT.

NUMBER OF TRENCHES 4 ONE SIDEWALL/BOTTOM AREA 729 SQ. FT.

DRYWALL INSIDE DIAMETER FT. EFFECTIVE DEPTH BELOW INLET FT.

ABSORBENT AREA SQ. FT.

REMARKS: 10/15/96 OK to cover trenches 1, 2, 3 leave end of 4 open
for inspection - OK to cover house to distribution box ALM
10/16/96 OK to cover all work final - Last 50' of trench #4
not seen - inspection missed ALM

DATE SYSTEM APPROVED 10/16/96 INSPECTOR A. McMillen

APPLICATION

PERCOLATION TESTING

HOWARD COUNTY HEALTH DEPARTMENT
BUREAU OF ENVIRONMENTAL HEALTH
PO BOX 476 ELLICOTT CITY, MARYLAND 21043
TELEPHONE: 461-9933

DISTRICT 4th

DATE _____

TO: THE COUNTY HEALTH OFFICER
ELLICOTT CITY, MARYLAND

I, HEREBY, APPLY FOR THE NECESSARY TEST IN ORDER TO CONSTRUCT (OR RECONSTRUCT) A SEWAGE DISPOSAL SYSTEM.

PROPERTY OWNER Pettit and Griffin, Inc. NV Homes

ADDRESS 18205-D Flower Hill Way PHONE 301-975-1020
Gaithersburg, Maryland 20879

PROSPECTIVE BUYER _____

ADDRESS _____ PHONE _____

PROPERTY LOCATION:

SUBDIVISION McKendree Estates LOT NO. 34 32

ROAD AND DESCRIPTION McKendree Road and Route 97

(2840 Rolling Fork Way)

TAX MAP 14 PARCEL # 123

SIZE OF LOT 3 AC. +

BLDG. PERMIT SIGNED

AND RETURNED 7/19/94

Serial # B00101163 TYPE BLDG Single Family 4 Bed
(SINGLE FAMILY DWELLING OR COMMERCIAL)

THE SYSTEM INSTALLED UNDER THIS APPLICATION IS ACCEPTABLE ONLY UNTIL PUBLIC FACILITIES BECOME AVAILABLE. I FULLY UNDERSTAND THE

FEE CONNECTED WITH THE FILING OF THIS PERC TEST APPLICATION IS NON-REFUNDABLE UNDER ANY CIRCUMSTANCES. I ALSO AGREE TO COMPLY

WITH ALL M.O.S.H.A. REQUIREMENTS IN TESTING THIS LOT. _____

(SIGNATURE OF APPLICANT)

APPROVED BY _____ FOR _____ DATE _____

REJECTED BY _____ FOR _____ DATE _____

HOLD PENDING FURTHER TESTS _____ DATE _____

REASONS FOR REJECTION OR HOLDING 6/30/94 Per OK Hold for Permit B/H

THIS IS NOT A PERMIT

SOIL PROFILE

0
CLAY
3
GRAY
SAND
LOAM
FEW
ROCKS
9
ROCK

Hand-drawn stratigraphic column for station 2. The column is divided into three layers. The top layer is labeled "RED BROWN CLAY" and is marked with a "0" at the top. The middle layer is labeled "BROWN SAND SILT" and is marked with a "3" on the left. The bottom layer is labeled "LOAM".

6
3

RED CLAY


OLIVE
BROWN
SAND
SILT
LOAM

91

3

(4)

3 CLAY
BRN
SAND
SILT
LOPM

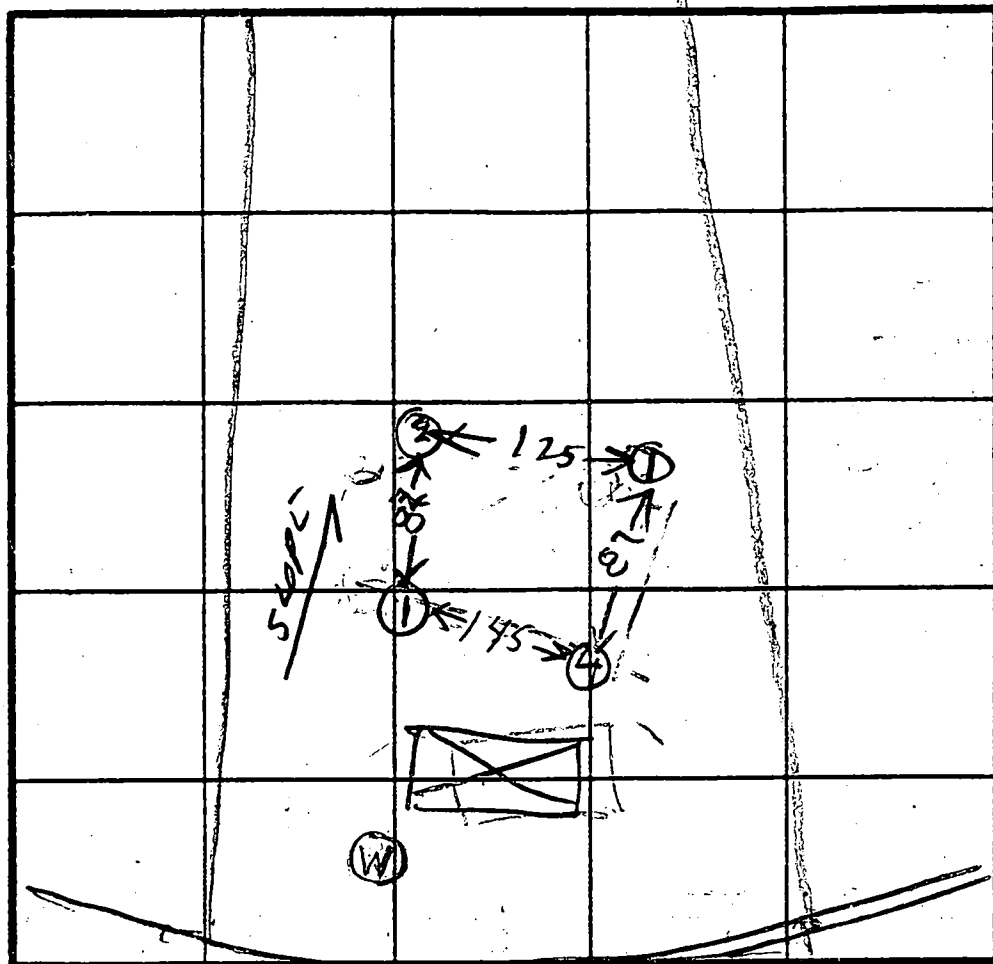

INDICATE NORTH - NAME ADJOINING ROADWAY AS BASE LINE

ROAD

[illegible]

AV
TIME
5min

MAX
DEPTH
3 FT

REMARKS

TYPE OF SOIL

TESTED BY

Hydr (3) (4) Per Test Plat 1/6 @ 1/4 slight different

R. HODGES

ALSO PRESENT

O. Kettnerman Jr
& Dale

C 1		SEQUENCE NO. (MDE USE ONLY)	STATE OF MARYLAND WELL COMPLETION REPORT		THIS REPORT MUST BE SUBMITTED WITHIN 45 DAYS AFTER WELL IS COMPLETED.	
1403			FILL IN THIS FORM COMPLETELY PLEASE PRINT OR TYPE		COUNTY NUMBER A 44261	
DATE RECEIVED		DATE WELL COMPLETED		Depth of Well		
8. 13		15 20		22 26		
0 5 0 7 9 6		250		(TO NEAREST FOOT)		
OWNER Griffin + Pettit		TOWN Stenwood		LOT 33		
STREET OR RFD 2440 Rolling Fork Way		SECTION		LOT 33		
SUBDIVISION Gwynedd Oak Est		SECTION		LOT 33		
WELL LOG		GROUTING RECORD		PUMPING TEST		
Not required for driven wells		WELL HAS BEEN GROUTED (Circle Appropriate Box)		HOURS PUMPED (nearest hour)		
STATE THE KIND OF FORMATIONS PENETRATED, THEIR COLOR, DEPTH, THICKNESS AND IF WATER BEARING		TYPE OF GROUTING MATERIAL (Circle one)		PUMPING RATE (gal. per min.)		
DESCRIPTION (Use additional sheets if needed)		CEMENT CM BENTONITE CLAY BC		METHOD USED TO MEASURE PUMPING RATE timer		
FEET		NO. OF BAGS 18 NO. OF POUNDS 1800		WATER LEVEL (distance from land surface)		
FROM TO		GALLONS OF WATER 108		BEFORE PUMPING		
dirt 0 5		DEPTH OF GROUT SEAL (to nearest foot)		WHEN PUMPING		
soft brown rock 5 59		from 0 ft. to 65 ft.		TYPE OF PUMP USED (for test)		
hard gray rock 58 68		Casing types insert appropriate code below		A air P piston T turbine		
med hard brown rock 68 69		Casing RECORD		C centrifugal R rotary O other (describe below)		
hard gray rock 69 91		STEEL CONCRETE		J jet S submersible		
hard tan rock 91 94		PLASTIC OTHER		PUMP INSTALLED		
hard gray rock 94 130		MAIN CASING TYPE		DRILLER WILL INSTALL PUMP (YES NO)		
med hard brown rock 130 133		Nominal diameter top (main) casing (nearest inch)		IF DRILLER INSTALLS PUMP, THIS SECTION MUST BE COMPLETED FOR ALL WELLS.		
hard gray rock 133 142		Total depth of main casing (nearest foot)		TYPE OF PUMP INSTALLED		
med hard brown rock 142 146		P L 6 67		PLACE (A,C,J,P,R,S,T,O) IN BOX 29		
hard gray rock 146 250		OTHER CASING (if used)		CAPACITY: GALLONS PER MINUTE (to nearest gallon)		
		diameter inch depth (feet) from to		PUMP HORSE POWER		
		SCREEN RECORD		PUMP COLUMN LENGTH (nearest ft.)		
		screen type or open hole		CASING HEIGHT (circle appropriate box and enter casing height)		
		ST BR HO		LAND SURFACE		
		STEEL BRASS BRONZE OPEN HOLE		2 (nearest foot)		
		PL PLASTIC OTHER		LOCATION OF WELL ON LOT		
NUMBER OF UNSUCCESSFUL WELLS: 0		C 2		SHOW PERMANENT STRUCTURE SUCH AS BUILDING, SEPTIC TANKS, AND /OR LANDMARKS AND INDICATE NOT LESS THAN TWO DISTANCES (MEASUREMENTS TO WELL)		
WELL HYDROFRACTURED		DEPTH (nearest ft.)		Drilled on		
yes Y no N		H O 65 250		Approved state		
CIRCLE APPROPRIATE LETTER		SLOT SIZE 1 2 3				
A A WELL WAS ABANDONED AND SEALED WHEN THIS WELL WAS COMPLETED		DIAMETER OF SCREEN				
E ELECTRIC LOG OBTAINED		GRAVEL PACK IF WELL DRILLED WAS FLOWING WELL INSERT F IN BOX 68				
P TEST WELL CONVERTED TO PRODUCTION WELL		MDE USE ONLY (NOT TO BE FILLED IN BY DRILLER) (E.R.O.S.)				
I HEREBY CERTIFY THAT THIS WELL HAS BEEN CONSTRUCTED IN ACCORDANCE WITH COMAR 26.04.04 "WELL CONSTRUCTION" AND IN CONFORMANCE WITH ALL CONDITIONS STATED IN THE ABOVE CAPTIONED PERMIT, AND THAT THE INFORMATION PRESENTED HEREIN IS ACCURATE AND COMPLETE TO THE BEST OF MY KNOWLEDGE		TELESCOPE CASING LOG INDICATOR OTHER DATA				
TYPE MWD/MSD/MGD						
DRILLERS LIC. NO. 304						
DRILLERS SIGNATURE David Kelly						
LIC. NO. JWD075						
DRILLERS SIGNATURE Arnold Johnson						
SITE SUPERVISOR (sign. of driller or journeyman responsible for sitework if different from permittee)						

*Ground work
complete*

HOWARD COUNTY HEALTH DEPARTMENT
Bureau of Environmental Health
3525-H Ellicott Mills Drive
Ellicott City, MD 21043

Fax 313-2648 313-2640

APPLICATION FOR FITLESS ADAPTER, WELL PUMP AND PRESSURE TANK INSTALLATION

New Installation ☒
Replacement ☐

Receipt #

Date

10/16/96

Name of Installer ROBERT L. FEEZER CO. INC.

Telephone 781-4655

License Number 2122

Certified Well Pump Installer ☒

Well Driller ☐

Registered Plumber ☒

Name of Property Owner NV-HOMES

Telephone 795-1405

Subdivision WILKINSON ESTATES Lot # 33

Well Tag # HO-94-0759

Site Address 2840 ROLLING ROCK WAY

GWYNETH OAKS EST.

Pump

1. Type

a. Deep well jet

b. Shallow well jet

c. Submersible ☒

2. Make ELITE WALKER

3. Model # 4F10607301

4. Capacity 10 GPM

5. Pump exceeds well capacity Yes ☐ No ☐

6. If Yes, is low pressure cutoff switch installed? Yes ☐ No ☒

7. What methods are used to protect the pump and electrical wiring from vibrations? Torque arrestors ☐ Cable guards ☒ Other ☐

Motor

1. Horsepower 3/4

2. RPM 3450

3. Voltage

a. 110

b. 220 ☒

Pitless Adapter

1. Make HARYARD

2. Model # PT800

3. Depth 42" +

Tank

1. Capacity 36 GPM

2. Pressure relief valve? YES

Piping

1. Type Roll

2. Size 1/2"

3. NSF and/or BOCA

Code approved YES

4. Depth of supply line 42"

Well data

1. Depth 250 ft.

2. Yield GPM

3. Static water level ft.

4. Will water supply be disinfected by installer? YES

I understand that it is my responsibility to notify the Howard County Health Department when the installation is ready for inspection (otherwise this permit is null and void).

All information given above is true to the best of my knowledge.

Signature of Applicant: Robert L. Feezer

Date: 10/16/96


Note: A sticker indicating approval/status of the installation will be placed on the well casing at the time of the inspection.

LOT 33

GWYNDYL OAK ESTATES
 4th ELEC. DIST. HOWARD CO., MD
 July 12, 1996 1"=50'

Notes:

1. Lot shown contains 53,843 s.f. of land and recorded at plat # 11552 among the Land Records of Howard County, Maryland.
2. Prepared by Gutschick, Little and Weber, P.A.
3. Grading around house may vary due to field conditions.
4. No construction stockpiling refuse or excess material shall be buried in septic easement.
5. Wells shown per SP-23-15.
6. Install sediment controls as required by Site Inspector. See Sediment Control Plan # GP-95-26.
7. Disturbed area shown is 16,675 s.f.
8. Pile excavated material on high side of trench when installing septic field prior to disposal of excess material.
9. Length of trench for septic system to be determined and specified by Howard County Department of Health.

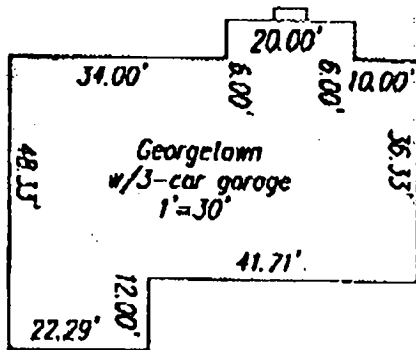

2840

Rolling Fork Way

 Permit #
 B00101162

ROLLING FORK WAY

10' PUBLIC UTILITY ESM

PROPOSED WELL

100.00'

60' L.O.D.

 GEORGETOWN
 FF=600.35
 FR=599.69
 BF1=599.50
 BF2=589.83
 HUNG SEWER

3 CAR GAR

SEPTIC TANK

SEPTIC SYSTEM DATA:

BASEMENT FLOOR AREA = 590.5'/589.83'
 INV. OUT OF HOUSE = 593.65' HUNG SEWER
 INV. IN AT SEPTIC TANK = 593.25'
 INV. OUT AT SEPTIC TANK = 593.00'
 EX. ELEV. AT SEPTIC TANK = 596.1'±
 PROP. ELEV. AT SEPTIC TANK = 596.0'
 INV. IN AT DIST. BOX = 592.5'
 EX. ELEV. AT DIST. BOX = 595.5'±

PROPANE TANK

11/14/96
 prepare final
 location OK
 as shown (DK)

338.21'

5074

5072

JUL-12-96 FRI 3:00 PM GUTSCHICK LITTLE WEBER

FAX NO. 3014214186

P. 2


LOT 33

GWYNDYL OAK ESTATES

4th ELEC. DIST.


HOWARD CO., MD

July 12, 1996
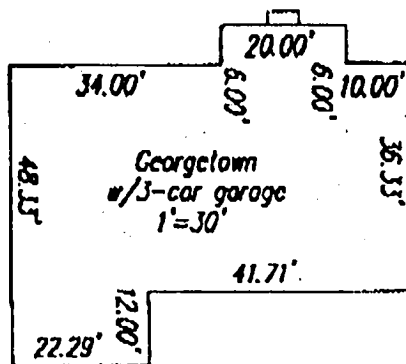
$$i'' = 50'$$


Notes:

1. Lot shown contains 53,843 s.f. of land and recorded at plot # 11552 among the Land Records of Howard County, Maryland.
2. Prepared by Gutschick, Little and Weber, P.A.
3. Grading around house may vary due to field conditions.
4. No construction stockpiling refuse or excess material shall be buried in septic easement.
5. Wells shown per SP-9J-15.
6. Install sediment controls as required by Sila Inspector. See Sediment Control Plan # GP-95-26.
7. Disturbed area shown is 16,675 s.f.
8. Pile excavated material on high side of trench when installing septic field prior to disposal of excess material.
9. Length of trench for septic system to be determined and specified by Howard County Department of Health.

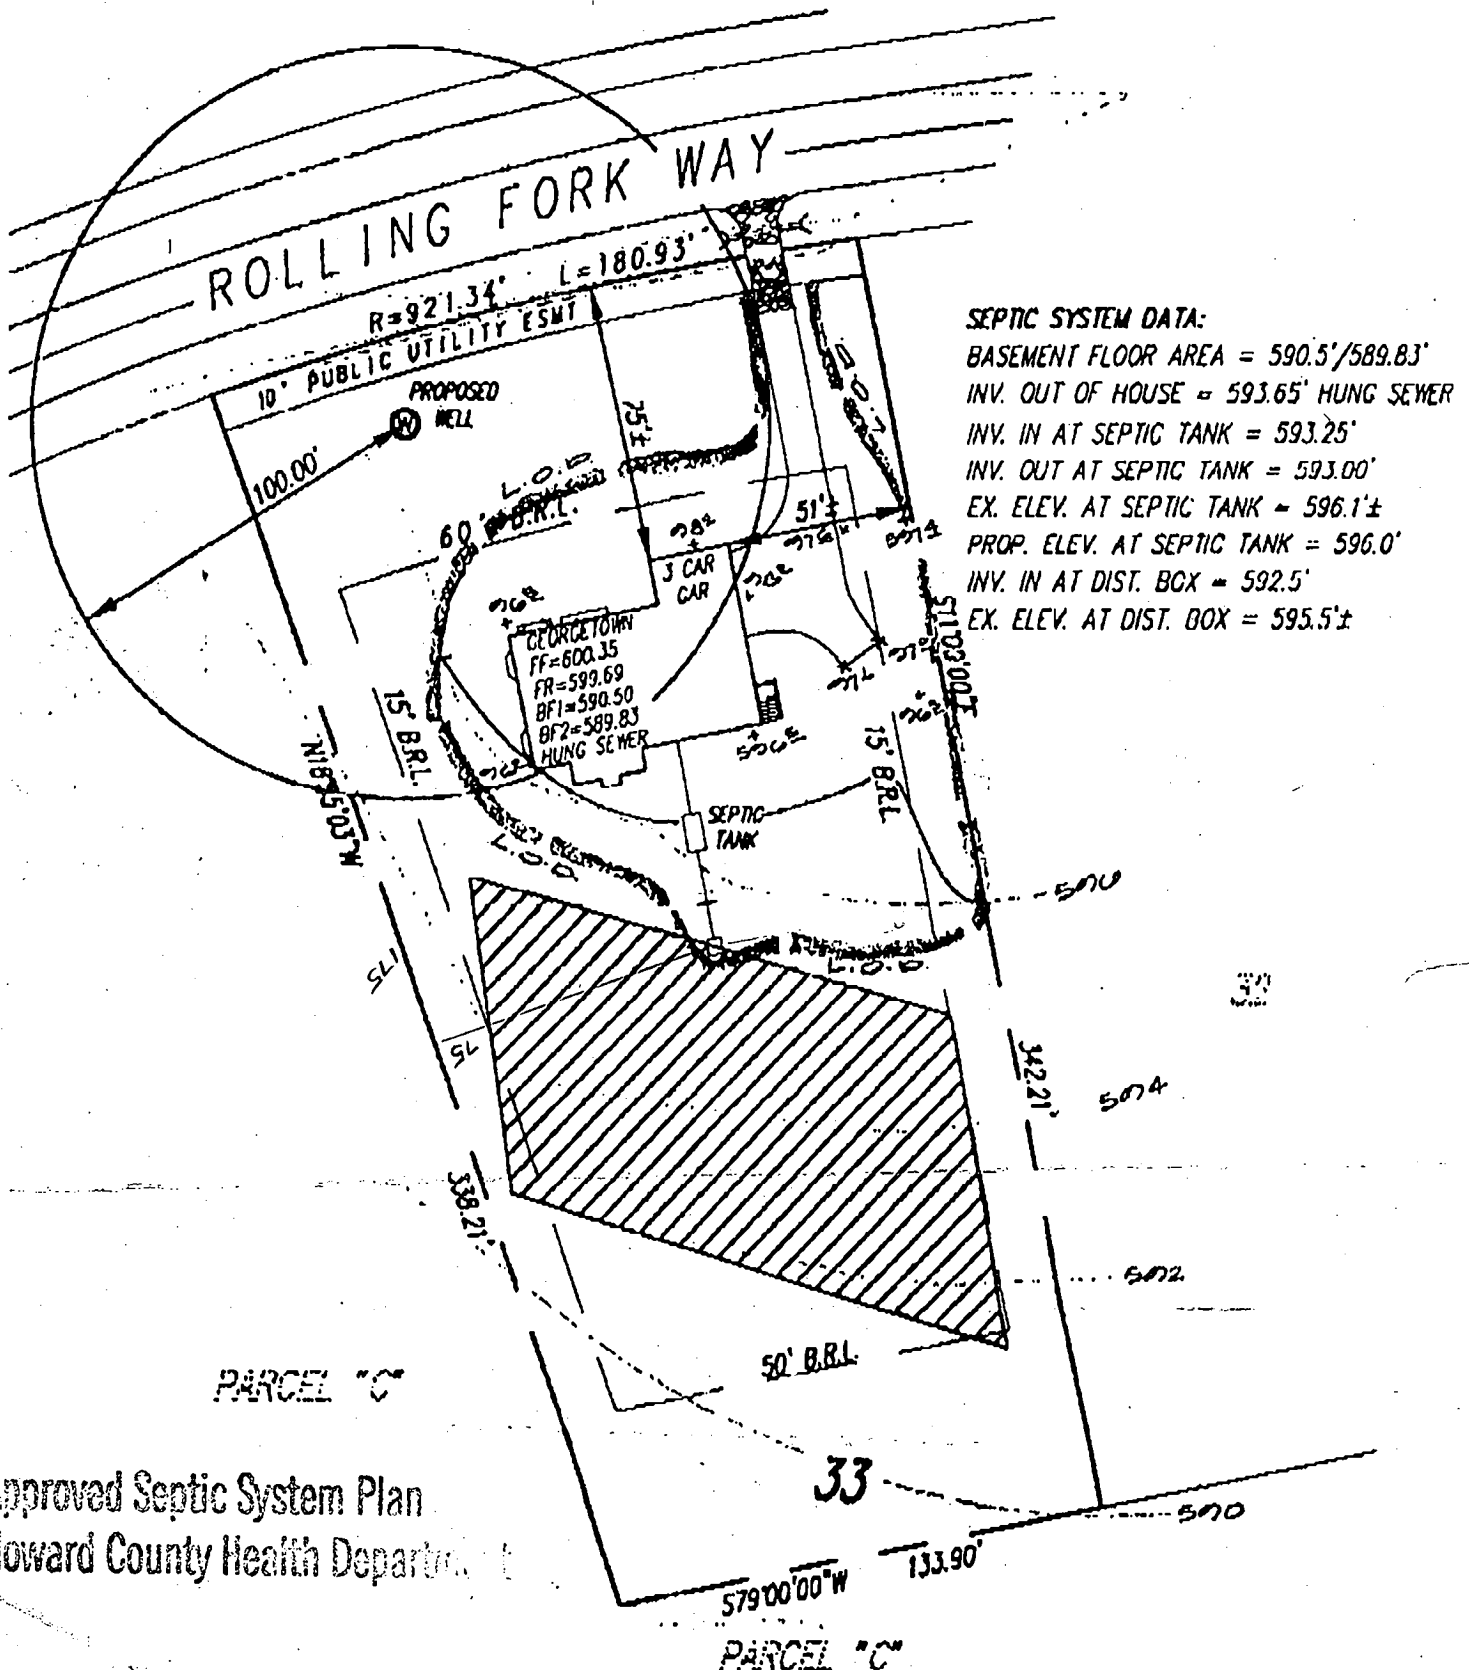

SEPTIC SYSTEM DATA:

BASEMENT FLOOR AREA = 590.5'/589.83'
INV. OUT OF HOUSE = 593.65' HUNG SEWER
INV. IN AT SEPTIC TANK = 593.25'
INV. OUT AT SEPTIC TANK = 593.00'
EX. ELEV. AT SEPTIC TANK = 596.1'±
PROP. ELEV. AT SEPTIC TANK = 596.0'
INV. IN AT DIST. BOX = 592.5'
EX. ELEV. AT DIST. BOX = 595.5'±

Approved Septic System Plan

Howard County Health Department


Amy Mc Miller
Signature

7/19/96
Date

7/19/96

SP 93-15


AREA 3

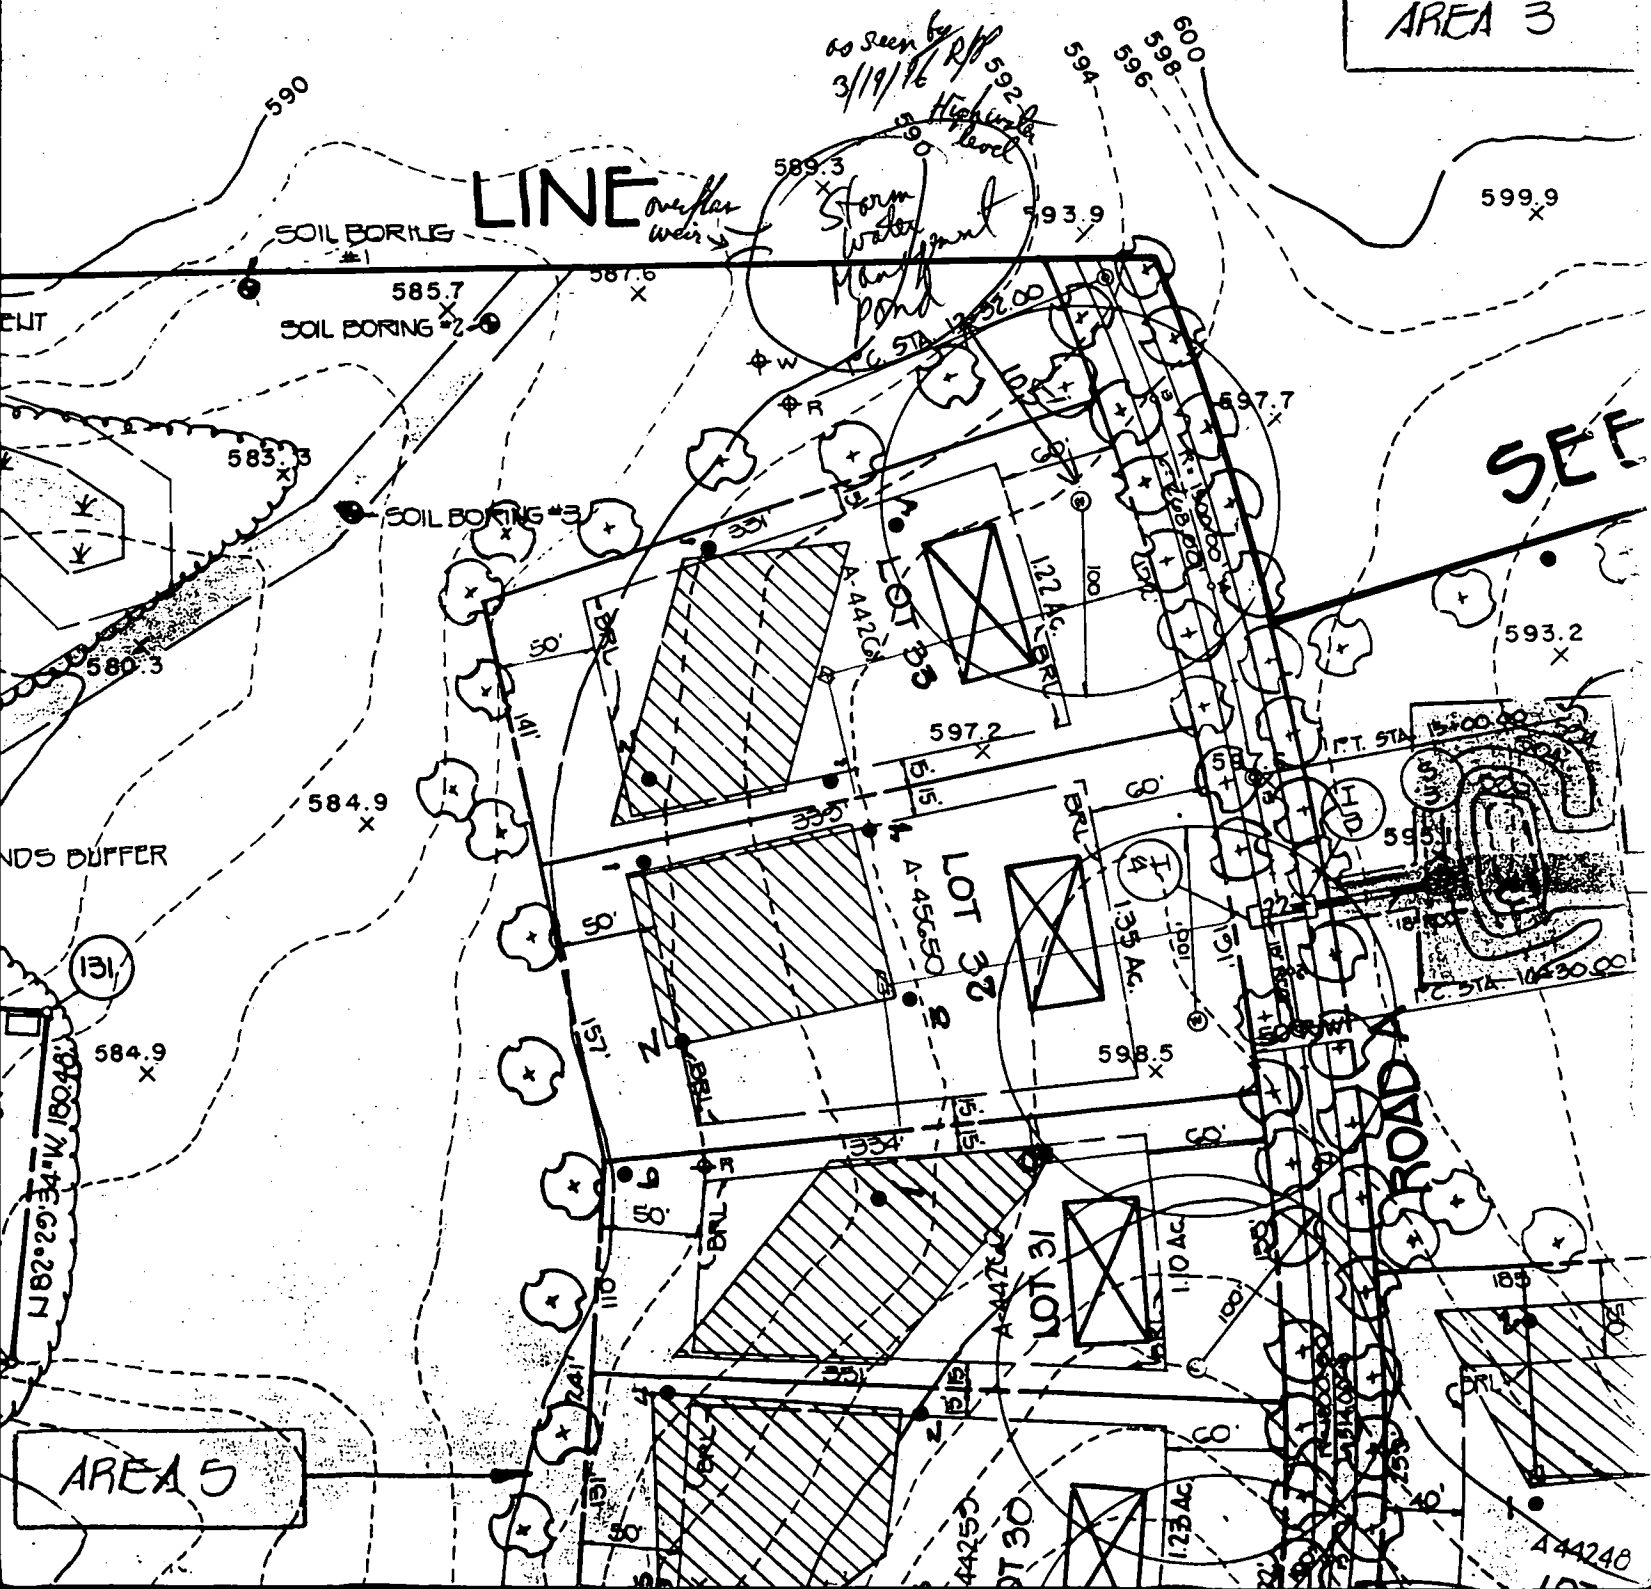

7-29-97
BP preview for
a pool

Location of pool
OK provided the
septic tank is
moved 17-10' away
from the deck.
Well is in the front.
Owner was informed
on this date about
obtaining a repair
permit prior to
BP approval
ALM

8-13-97
B00107405
Approved
ALM

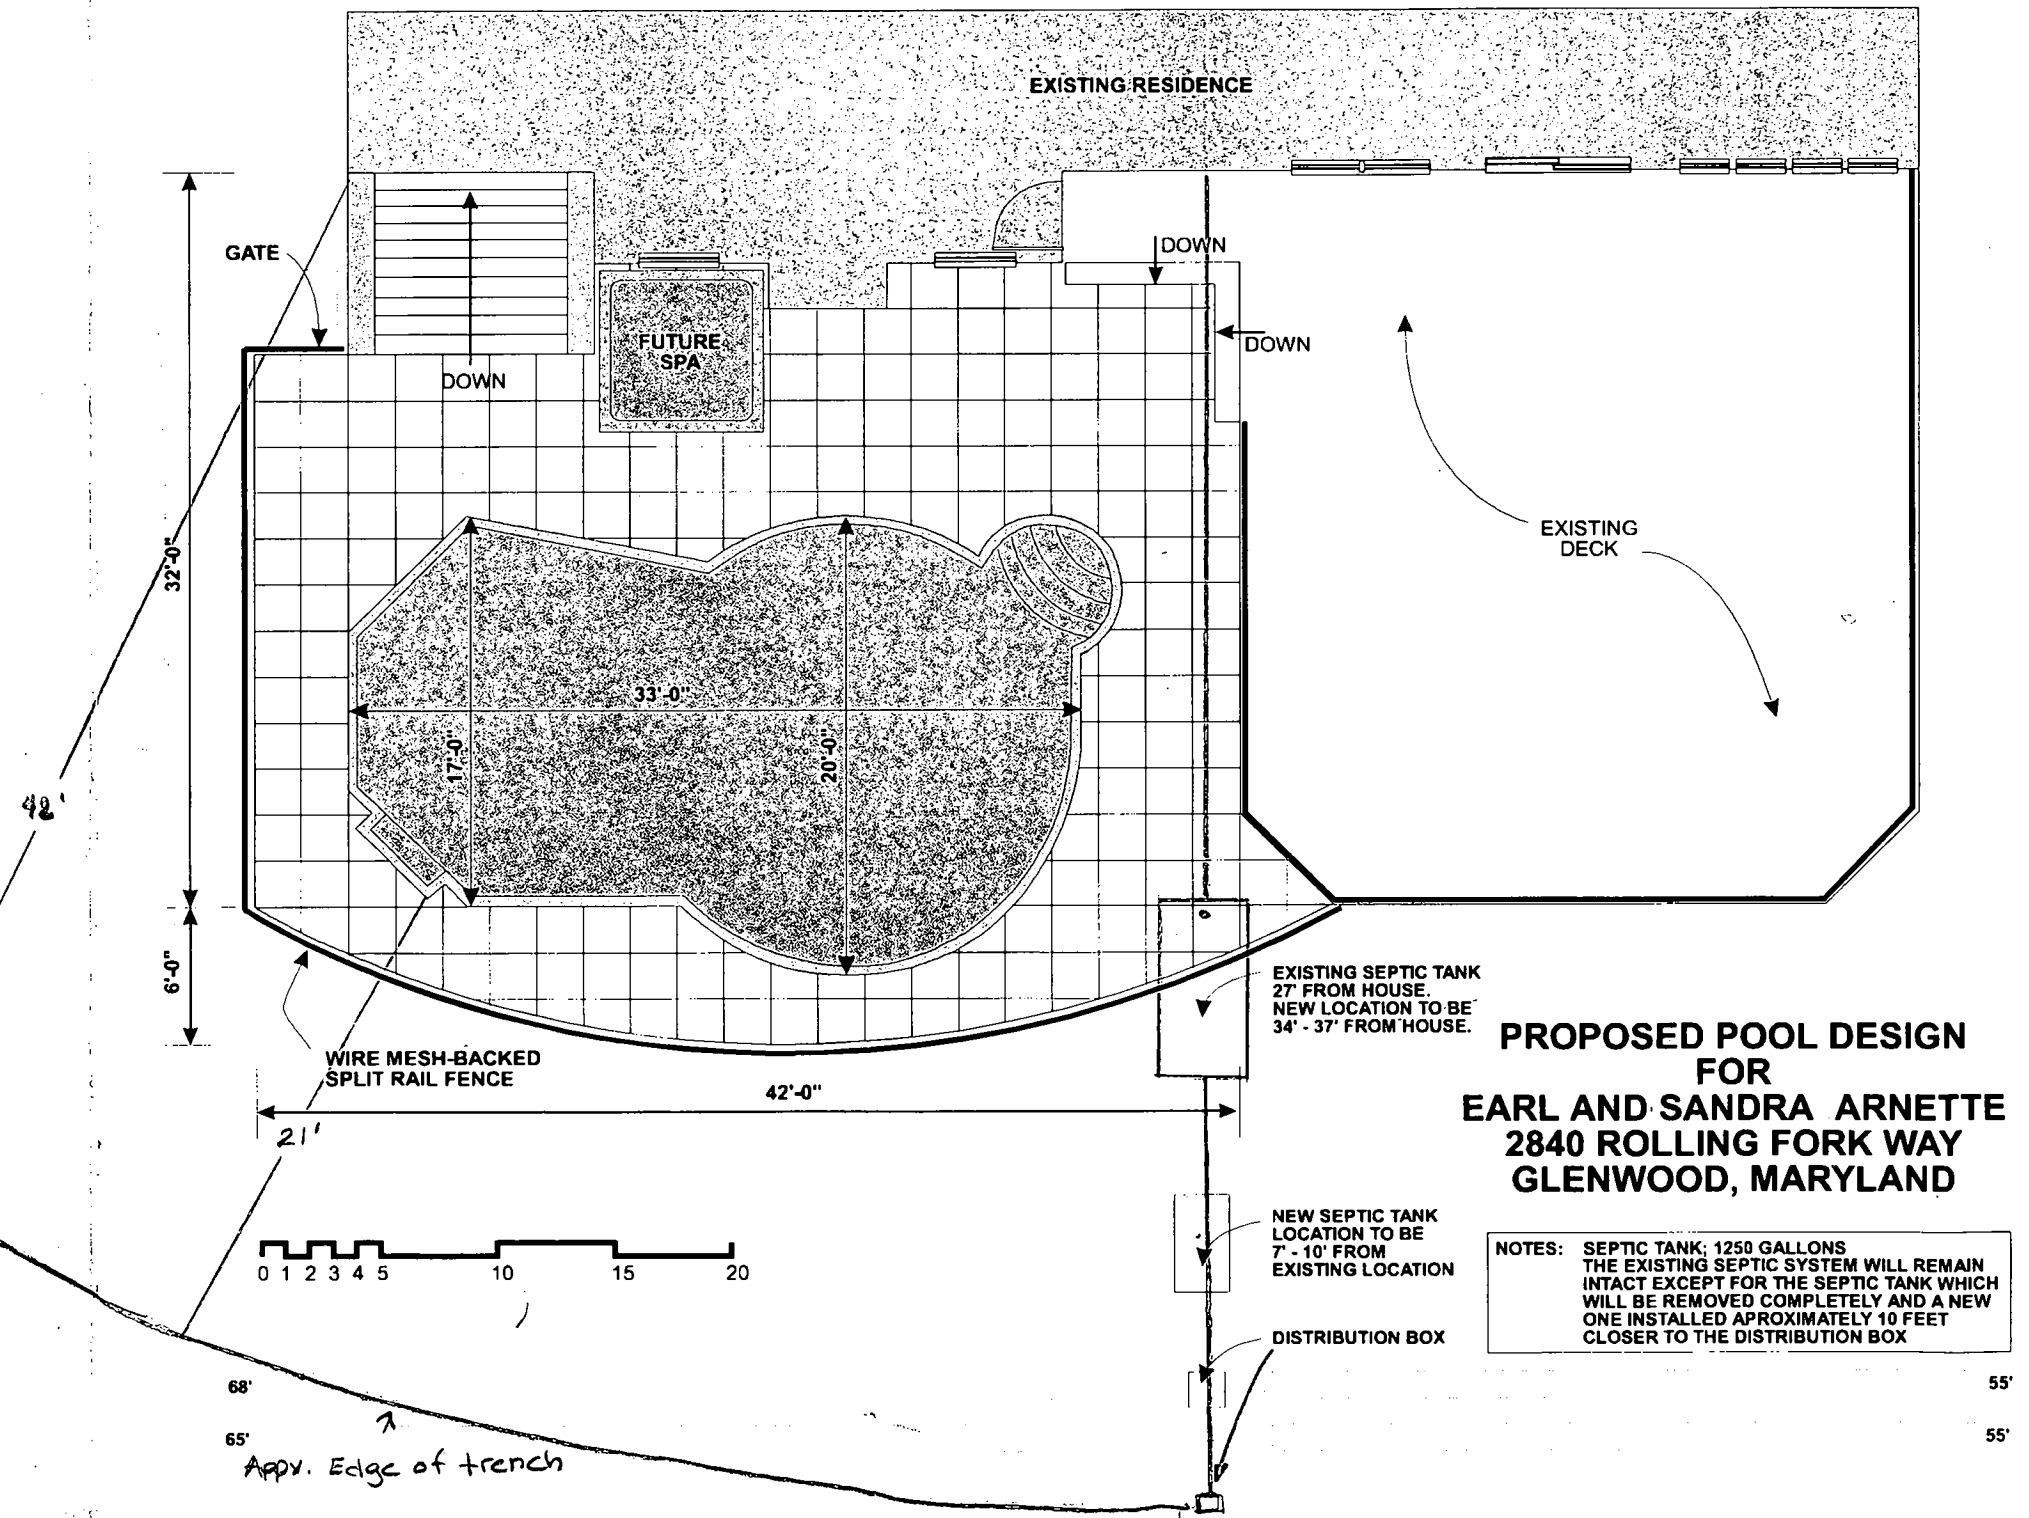

EARL ARNETTE
410-489-0044 Home
301-601-7318 Office

Mr. CRAIG WILLIAMS

HOCO ENVHEALTH

TEL NO. 4103132648

May 1, 97 11:42 No.004 P.01

C.O. 2:08
10-15-96

PERMIT

SEWAGE DISPOSAL SYSTEM

DEPARTMENT OF HEALTH AND MENTAL HYGIENE

HOWARD COUNTY HEALTH DEPARTMENT
BUREAU OF ENVIRONMENTAL HEALTH

INDEXED

P 57072A

A 44261

DISTRICT

DATE 8/27/96

DATE SYSTEM APPROVED 10/16/96

INSPECTOR ALM

South Carroll Backhoe, Inc.

IS PERMITTED TO INSTALL ☒ ALTER

ADDRESS 4410 Salem Bottom Road, Westminster, Maryland 21157 PHONE 875-4197

SUBDIVISION Gwyndyl Oak Estates LOT 33 ROAD 2840 Rolling Fork Way

PROPERTY OWNER NV Homes

ADDRESS

SEPTIC TANK CAPACITY 1250 GALLONS

NUMBER OF BEDROOMS 4

180 SQUARE FEET PER BEDROOM

LINEAR FEET OF TRENCH REQUIRED 240

TRENCHES - Trench to be 3 feet wide. Inlet 3 feet below original grade. Bottom maximum depth 5 feet below original grade. Effective area begins at 3 feet below original grade. 2 feet of stone below distribution pipe.
LOCATION - Place distribution box 175' up the right lot line. (338.21) and 75' off that same lot line as seen when facing the lot from Rolling Fork Way. Run trenches on contour in both directions.
NOTES - No trench to exceed 100 feet in length. Provide 6" - 8" diameter cleanout and cap to grade or above on septic tank. OK 8/7/96 DKS

PLANS APPROVED BY Amy McMillen

DATE 7/19/96

COVER NO WORK UNTIL INSPECTED AND APPROVED

NEITHER THE HOWARD COUNTY COUNCIL NOR THE HEALTH DEPARTMENT IS RESPONSIBLE FOR THE SUCCESSFUL OPERATION OF ANY SYSTEM

NOTE: CLEANOUT REQUIRED EVERY 70 FEET OF SEWER LINE AND/OR AT 90° SWEEPS IN LINES FROM HOUSE TO DRAIN FIELDS. 90° ELBOWS NOT ACCEPTABLE.

NOTE: ALL PARTS OF SEPTIC SYSTEMS (I.E. TANK, DISTRIBUTION BOX, TRENCHES) TO BE 100 FEET FROM WELL (UNLESS OTHERWISE SPECIFICALLY AUTHORIZED)

NOTE: IF DEEP TRENCHES ARE USED CALL FOR INSPECTION BEFORE AND AFTER PLACING GRAVEL IN TRENCHES

NOTE: NO DRY WELL SHALL EXCEED 15 FOOT IN DIAMETER NO ABSORPTION TRENCH TO EXCEED 100 FEET IN LENGTH

NOTE: ALL PIPE FROM HOUSE TO SEPTIC TANK MUST BE CAST IRON OR SCHEDULE 30/40 PVC OR ABS

PERMIT VOID AFTER TWO YEARS

NOTE: INSTALL STAND PIPE ON SEPTIC TANK AND DRY WELL STAND PIPES MUST BE 6 INCHES IN DIAMETER CAST IRON, CONCRETE OR TERRA COTTA OR PVA OR ABS ACCEPTED. IF TOP OF SEPTIC TANK IS DEEPER THAN 3 FEET, MANHOLE TO GRADE REQUIRED.

NOTE: DISTRIBUTION BOXES MUST HAVE Baffles


INSTALLER IS RESPONSIBLE FOR OBTAINING FINAL APPROVAL ON THIS PERMIT

CALL 401-6833 FOR INSPECTION OF SEPTIC SYSTEM.

HD-389(1-90)

BLDG. PERMIT SIGNED
AND RETURNED 11/14/96
Install 1-500 gal. unad. pipe

44261

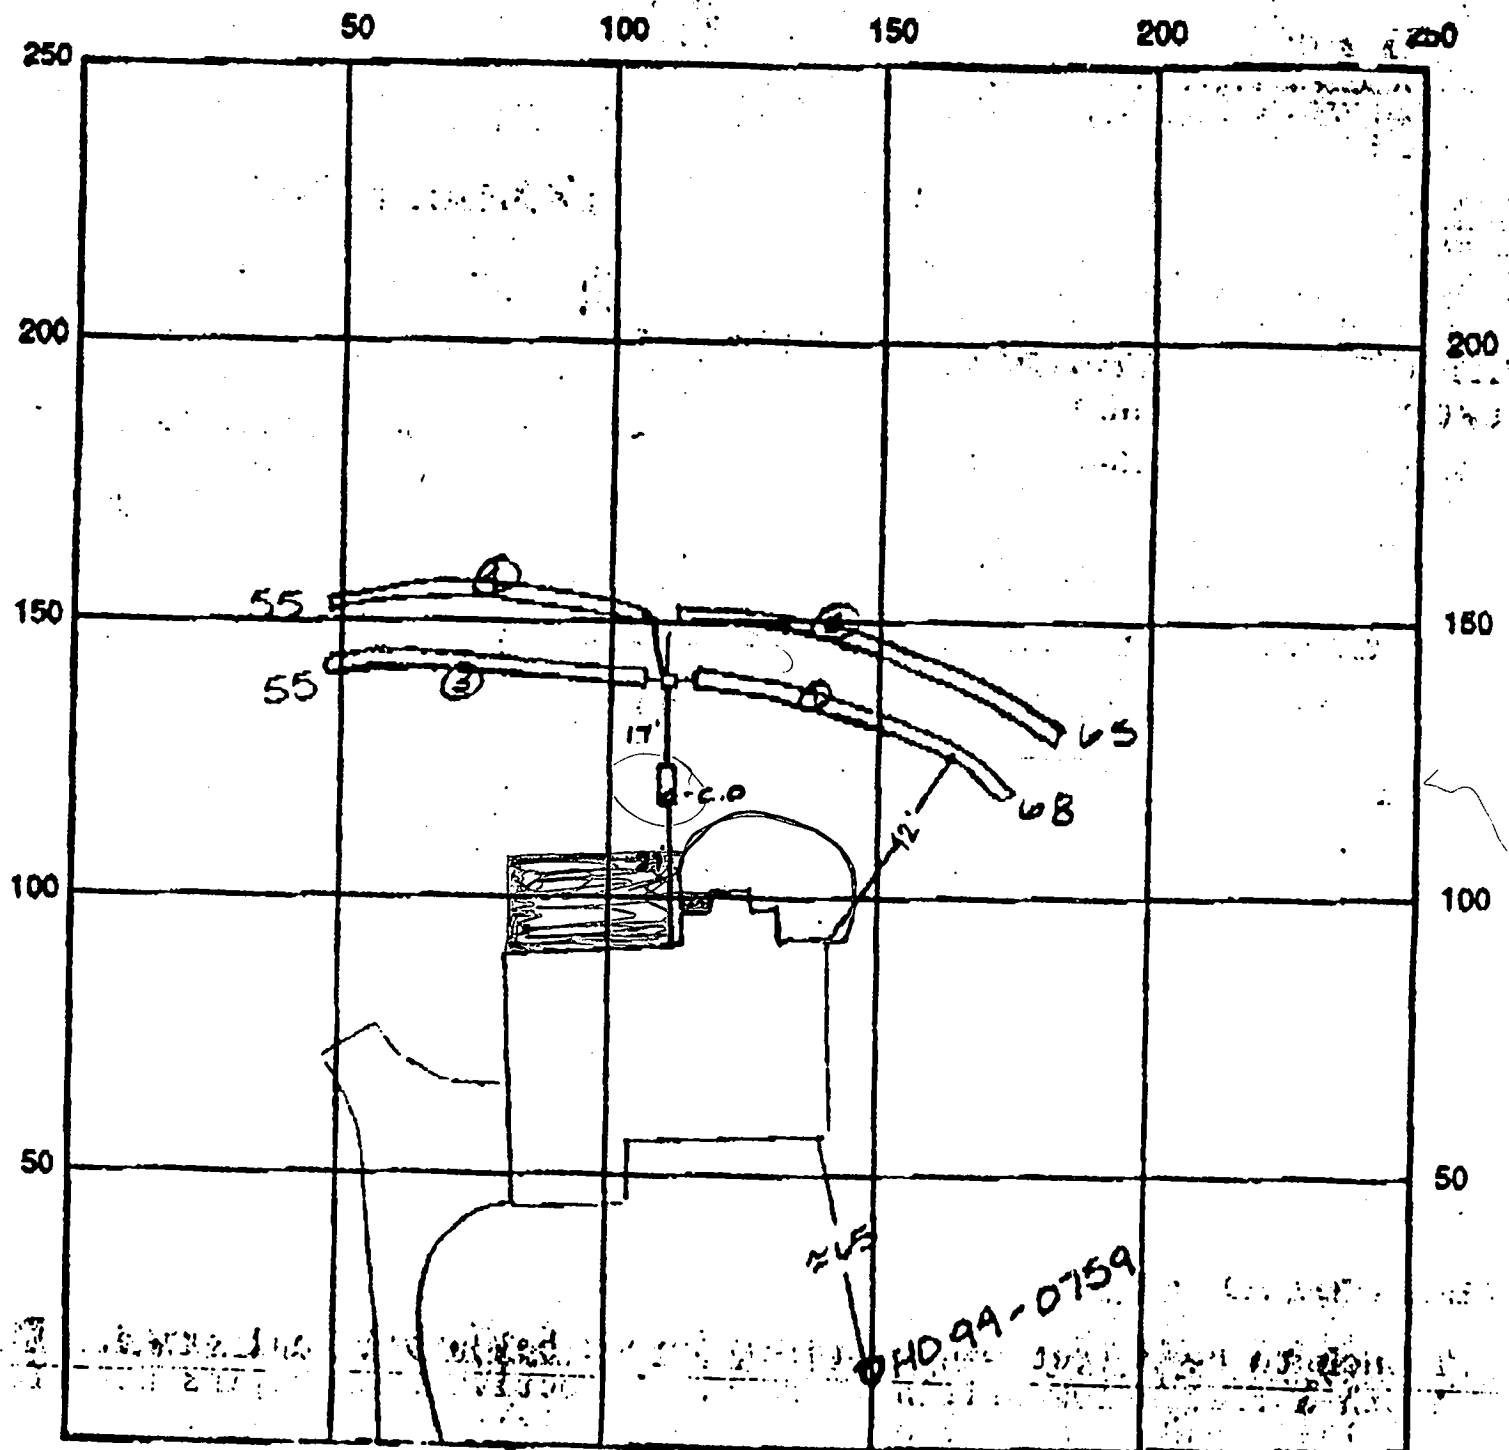

INDICATE NORTH NAME ADJOINING ROADWAY AS BASE LINE

APPLICATION

HOWARD COUNTY

PERMIT APPLICATION

DEPARTMENT OF INSPECTIONS, LICENSES & PERMIT

3430 COURT HOUSE DRIVE, ELLICOTT CITY, MARYLAND 21043

SERIAL NUMBER

B 00107105

BUILDING ADDRESS (HOUSE NO., STREET, TOWN OR AREA)

2840 Rolling Fork Way
Glenwood, MD 21738

24316

GRADING/SEDIMENT CONTROL ☐ YES ☐ NO

SDP #

DESCRIPTION OF WORK AUTHORIZED

Installation of a in-ground
Pool 17' x 33'

6' Deep

LOT NO.	PARCEL NO.	SEC.	AREA	BLOCK NO.	LIBER	FOLIO
33						

SUB DIVISION	ZONE	ZONE MAP	ELEC. DIST.	CENSUS TR.

OWNER NAME AND ADDRESS

PHONE NO.

EHL ANNETTE
2840 Rolling Fork Way
Glenwood MD 21738

410-489-0044

OCCUPANT'S NAME AND ADDRESS

PHONE NO.

Same

Same

ARCHITECT OR ENGINEER'S NAME AND ADDRESS

PHONE NO.

CONTRACTOR'S NAME AND ADDRESS

PHONE NO.

Regina Pools and Spas
3066 York Road
TIMONIA MD 21093

410-252-5116

EXISTING USE

PROPOSED USE

STD

Spa/Pool

EST. CONSTRUCTION COST

LICENSE NUMBER

PERMIT FEE

\$22,000

7125

SIGNATURE

TITLE

DATE

W/S CODE

FOR OFFICE USE ONLY

DISTANCE IN FEET FROM R/W LINE TO FRONT BUILDING LINE

SIDE YARD

(DISTANCE IN FEET FROM SIDE BLDG. LINE TO SIDE PROPERTY LINE)

TO SIDE BUILDING LINE

DISTANCE IN FEET, REAR YD. REQUIRING SET

BACK

(CORNER LOT ONLY)

SDP #

Check payable to: DIRECTOR OF FINANCE OF HOWARD COUNTY

CAUTION

To begin construction before a permit placard has been issued and displayed on the job is a violation of the law.

Use and occupancy permit must be applied for two weeks before it will be issued.

IMPORTANT: PLEASE SHOW ZIP CODES AND AREA CODES WHEREVER REQUIRED.

LP-89-591

FUNCTION	DATE	SIGNATURE APPROVAL
ZONING/PLANNING		
SHA		
SEDIMENT/GRADING		
BUILDING OFFICIAL	8/12/97	[Signature]
WATER & SEWER	08/13/97 2:44 PM	444H4149
HEALTH DEPT.	8-13-97	A. McMillan
FIRE PROTECTION	CHECK	\$125.00
STORM WATER MGM.		

APPROVED

DATE

Distribution of Copies:
White - Building Official
Green - Planning & ZoningYellow - Engineering
Pink - Health Dept.
Gold - S.H.A.

A