

10/6/97
Joan

PERMIT

SEWAGE DISPOSAL SYSTEM

DEPARTMENT OF HEALTH AND MENTAL HYGIENE

P 58973-F

A REPAIR

DISTRICT _____

DATE 09/15/97

HOWARD COUNTY HEALTH DEPARTMENT

BUREAU OF ENVIRONMENTAL HEALTH

XXXX-XXXX

410-313-2640

03298655

DATE SYSTEM APPROVED _____

INSPECTOR _____

INDEXED

Fogle's Septic Clean, Inc.

IS PERMITTED TO INSTALL _____ ALTER ☒ X

ADDRESS 580 Obrecht Road, Sykesville, Maryland 21784 PHONE 410-795-5670

SUBDIVISION _____ LOT _____ ROAD 1575 Woodstock Road

PROPERTY OWNER Carman Day PHONE: 410-461-1558

ADDRESS 1575 Woodstock Road
Woodstock, Maryland 21163

SEPTIC TANK CAPACITY 1000 GALLONS

NUMBER OF BEDROOMS 3

SQUARE FEET PER BEDROOM _____

LINEAR FEET OF TRENCH REQUIRED _____

REPAIR - PURPOSE - SEPTIC SYSTEM HAS FAILED.

Call for insepction when ground is opened so sanitarian can recommend repair.
09/15/97

PLANS APPROVED BY _____ DATE _____

COVER NO WORK UNTIL INSPECTED AND APPROVED

NEITHER THE HOWARD COUNTY COUNCIL NOR THE HEALTH DEPARTMENT IS RESPONSIBLE FOR THE SUCCESSFUL OPERATION OF ANY SYSTEM

NOTE: CLEANOUT REQUIRED EVERY 70 FEET OF SEWER LINE AND/OR AT 90° SWEEPS IN LINES FROM HOUSE TO DRAIN FIELDS, 90° ELBOWS NOT ACCEPTABLE.

NOTE: ALL PARTS OF SEPTIC SYSTEMS (I.E. TANK, DISTRIBUTION BOX TRENCHES) TO BE 100 FEET FROM WELL (UNLESS OTHERWISE SPECIFICALLY AUTHORIZED)

NOTE: IF DEEP TRENCH(ES) ARE USED CALL FOR INSPECTION BEFORE AND AFTER PLACING GRAVEL IN TRENCH(ES)

NOTE: NO DRY WELL SHALL EXCEED 15 FOOT IN DIAMETER NO ABSORPTION TRENCH TO EXCEED 100 FEET IN LENGTH

NOTE: ALL PIPE FROM HOUSE TO SEPTIC TANK MUST BE CAST IRON OR SCHEDULE 35/40 PVC OR ABS


PERMIT VOID AFTER TWO YEARS

NOTE: INSTALL STAND PIPE ON SEPTIC TANK AND DRY WELL STAND PIPES MUST BE 6 INCHES IN DIAMETER CAST IRON. CONCRETE OR TERRA COTTA OR PVA OR ABS ACCEPTED. IF TOP OF SEPTIC TANK IS DEEPER THAN 3 FEET. MANHOLE TO GRADE REQUIRED.

NOTE: DISTRIBUTION BOXES MUST HAVE BAFFLES

*INSTALLER IS RESPONSIBLE FOR OBTAINING FINAL APPROVAL ON THIS PERMIT

858973-F

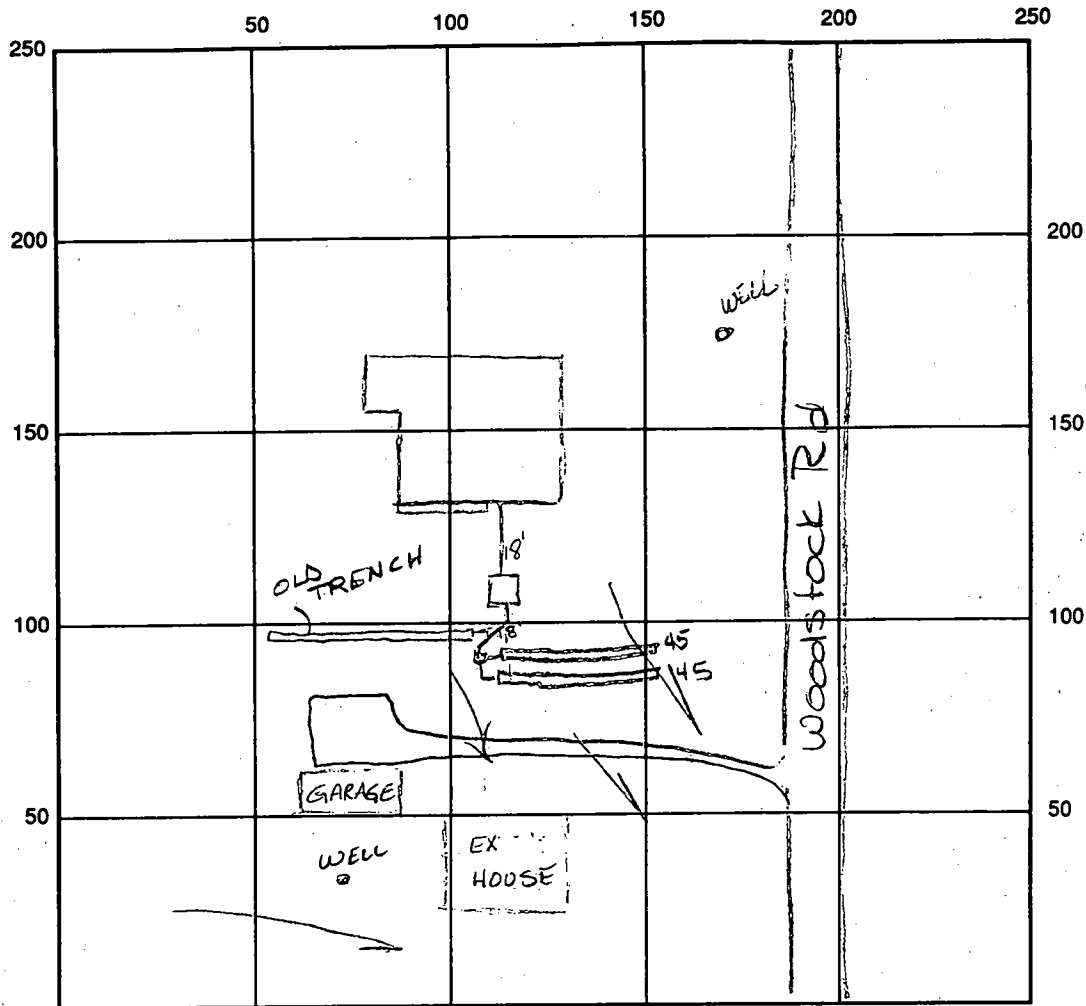

INDICATE NORTH NAME ADJOINING ROADWAY AS BASE LINE

SEPTIC TANK LEVEL N/A CLEANOUTS N/A

DISTRIBUTION BOX LEVEL OK

DRAIN FIELD/TITLE DEPTH 8.0 FT. TRENCH WIDTH 2.0 FT. INLET DEPTH 2.0 FT.

EFFECTIVE GRAVEL DEPTH 6.0 FT. TOTAL LENGTH 90 FT.

NUMBER OF TRENCHES 2 ONE SIDEWALL/BOTTOM AREA 540 SQ. FT. $\frac{90}{6} = 50$

DRYWALL INSIDE DIAMETER — FT. EFFECTIVE DEPTH BELOW INLET 6.0 FT.

ABSORBENT AREA — SQ. FT.

REMARKS: 10/7/97 Install 90' - inlet 2.0 bottom 8.0. OK to cover all work final ACM

DATE SYSTEM APPROVED 10/7/97 INSPECTOR A McMillen

B1	1400	SEQUENCE NO. (MDE USE ONLY)	STATE OF MARYLAND APPLICATION FOR PERMIT TO DRILL WELL 517442 please type	STATE PERMIT NUMBER 40-94-3496 fill in this form completely
Date Received (APA) 08-28-02		OWNER INFORMATION 9191		
DAY CARMAN		LOCATION OF WELL Howard CC#		
15 Last Name Owner First Name 34		8 COUNTY 21		
1575 WOODSTOCK RD		23 SUBDIVISION 42		
36 Street or RFD 55		SECTION <u>44</u> LOT <u>46</u>		
WOODSTOCK, MD 21042		48 50		
57 Town 70 State 72 Zip 76		52 NEAREST TOWN 71		
DRILLER INFORMATION		MILES FROM TOWN (enter 0 if in town) <u>0</u> M I		
George F. Easterday M WD 040		73 76 77 78		
Driller's Name 76 License No. 81		B 4		
L. Franklin Easterday, Inc.		1 2		
Firm Name		DIRECTION OF WELL FROM TOWN (CIRCLE BOX)		
9265 Brown Church Rd., MT. Airy, Md. 21771				
Address <u>1575 Woodstock Rd</u>		11 NEAR WHAT ROAD 30		
Signature <u>George F. Easterday</u> Date <u>8/28/02</u>		ON WHICH SIDE OF ROAD (CIRCLE APPROPRIATE BOX)		
B 2 WELL INFORMATION		DISTANCE FROM ROAD		
APPROX. PUMPING RATE (GAL. PER MIN.)		ENTER FT OR MI 38 39		
8 500 12		TAX MAP: <u>10</u> BLK: <u>18</u> PARCEL: <u>145</u>		
AVERAGE DAILY QUANTITY NEEDED (GAL. PER DAY) 14 20		NOT TO BE FILLED IN BY DRILLER HEALTH DEPARTMENT APPROVAL		
USE FOR WATER (CIRCLE APPROPRIATE BOX)		COUNTY NAME _____ COUNTY NO. _____ STATE SIGNATURE _____ INSERT S → 41 DATE ISSUED <u>8/29/02</u> CO SIGNATURE <u>Kenneth M. ...</u> EXP. DATE <u>8/29/03</u> 43 DD YY 48 CO SIGNATURE EXP. DATE NORTH GRID <u>545</u> 000 EAST GRID <u>836</u> 000 50 55 57 63		
☒ DOMESTIC POTABLE SUPPLY & RESIDENTIAL IRRIGATION ☐ FARMING (LIVESTOCK WATERING & AGRICULTURAL IRRIGATION) ☐ INDUSTRIAL, COMMERCIAL, DEWATERING ☐ PUBLIC WATER SUPPLY WELL ☐ TEST, OBSERVATION, MONITORING ☐ GEO-THERMAL		SHOW MAJOR FEATURES OF BOX & LOCATION OF WELL WITH AN X SOURCES OF POLLUTING WATER 1. wells 2. 3.		
APPROXIMATE DEPTH OF WELL <u>300</u> FEET		RECEIVED NOV 25 2002 NOV 25 2002 Well & Pump L. FRANKLIN EASTERDAY INC. TAG RETURNED & DESTROYED		
APPROXIMATE DIAMETER OF WELL <u>6</u> INCH NEAREST TOWN				
METHOD OF DRILLING (circle one)		WRITE THE BOX NUMBER FROM THE MAP, HERE		
BORED (or Augered) JETTED Jetted & DRIVEN ☒ AIR-ROTARY AIR-PERCUSION ROTARY (Hydraulic Rotary) 30 CABLE REVERSE-ROTARY DRIVE-POINT 37 other		E <u>540</u> 500 N <u>540</u> 500		
REPLACEMENT OR DEEPEMED WELLS (CIRCLE APPROPRIATE BOX)		DRAW A SKETCH BELOW SHOWING LOCATION OF WELL IN RELATION TO NEARBY TOWNS AND ROADS AND GIVE DISTANCE FROM WELL TO NEAREST ROAD JUNCTION		
☐ THIS WELL WILL NOT REPLACE AN EXISTING WELL ☐ THIS WELL WILL REPLACE A WELL THAT WILL BE ABANDONED AND SEALED ☒ THIS WELL WILL REPLACE A WELL THAT WILL BE USED AS A STANDBY-CONTACT LOCAL APPROVING AUTHORITY FOR POLICY ON STANDBY WELLS ☐ THIS WELL WILL DEEPEM AN EXISTING WELL		16 F 11 WOODSTOCK Route 79		
PERMIT NUMBER OF WELL TO BE REPLACED OR DEEPEMED (IF AVAILABLE) 41		Not to be filled in by driller (MDE OR COUNTY USE ONLY) APPROX. PERMIT NUMBER <u>G</u> PERMIT No. <u>40-94-3496</u> 70 71 72 73 74 75 76 77 78 79		
SPECIAL CONDITIONS				

B 1	1400	SEQUENCE NO. (MDE USE ONLY)	STATE OF MARYLAND APPLICATION FOR PERMIT TO DRILL WELL 517442 please type	STATE PERMIT NUMBER 40-94-3496 fill in this form completely.
Date Received (APA) 08/28/02 8 MM DD YY 13		OWNER INFORMATION		
DAY CARMAN				
15	Last Name	Owner	First Name	34
1575 WOODSTOCK RD				
36	Street or RFD			55
WOODSTOCK, MD 21042				
57	Town	70	State	72 Zip 76
DRILLER INFORMATION				
George F. Easterday		M	WD	040
Driller's Name		76	License No.	81
L. Franklin Easterday, Inc.				
Firm Name:				
9265 Brown Church Rd., MT. Airy, Md. 21771				
Address				
Signature: <i>George F. Easterday</i>		Date: 8/28/2002		
B 2	WELL INFORMATION		5	
1	APPROX PUMPING RATE (GAL PER MIN.)		8	500 12
AVERAGE DAILY QUANTITY NEEDED (GAL PER DAY)		14	20	
USE FOR WATER (CIRCLE APPROPRIATE BOX)				
☒ DOMESTIC POTABLE SUPPLY & RESIDENTIAL IRRIGATION				
☐ FARMING (LIVESTOCK WATERING & AGRICULTURAL IRRIGATION)				
22	☐ INDUSTRIAL, COMMERCIAL, DEWATERING			
☐ PUBLIC WATER SUPPLY WELL				
☐ TEST, OBSERVATION, MONITORING				
☐ GEO-THERMAL				
APPROXIMATE DEPTH OF WELL <u>300</u> FEET				
APPROXIMATE DIAMETER OF WELL <u>6</u> INCH				
METHOD OF DRILLING (circle one)				
BORED (or Augered)		JETTED		Jettied & DRIVEN
30	☒ AIR-ROTARY		AIR-PERCUSION	ROTARY (Hydraulic Rotary)
37	CABLE		REVERSE-ROTARY	DRIVE-POINT
other _____				
REPLACEMENT OR DEEPENED WELLS (CIRCLE APPROPRIATE BOX)				
☐ THIS WELL WILL NOT REPLACE AN EXISTING WELL				
☐ THIS WELL WILL REPLACE A WELL THAT WILL BE ABANDONED AND SEALED				
39	☒ THIS WELL WILL REPLACE A WELL THAT WILL BE USED AS A STANDBY-CONTACT LOCAL APPROVING AUTHORITY FOR POLICY ON STANDBY WELLS			
☐ THIS WELL WILL DEEPEEN AN EXISTING WELL				
PERMIT NUMBER OF WELL TO BE REPLACED OR DEEPEENED (IF AVAILABLE) 41 _____ 52				
Not to be filled in by driller (MDE OR COUNTY USE ONLY)				
APPROX. PERMIT NUMBER _____ G _____				
PERMIT No. 40-94-3496 70 71 72 73 74 75 76 77 78 79				
SPECIAL CONDITIONS				
NOTE: APPROVING AUTHORITIES SHOULD USE SEPARATE SHEET IF NEEDED.				

B 3 Howard LOCATION OF WELL CC#

8 COUNTY 21

23 SUBDIVISION 42

SECTION 46 LOT 48 50

Woodstock

52 NEAREST TOWN 71

MILES FROM TOWN (enter 0 if in town) 0 M 73 76 77 78

B 4

1 2 DIRECTION OF WELL FROM TOWN (CIRCLE BOX)

11 NEAR WHAT ROAD 30

ON WHICH SIDE OF ROAD (CIRCLE APPROPRIATE BOX)

34 100 37

DISTANCE FROM ROAD ENTER FT OR MI 38 39

TAX MAP 10 BLK: 18 PARCEL 145

NOT TO BE FILLED IN BY DRILLER HEALTH DEPARTMENT APPROVAL

Howard

COUNTY NAME

STATE SIGNATURE

DATE ISSUED 08/29/02 *Karen Noonan* 8/29/03

43 MM DD YY 48 CO SIGNATURE EXP. DATE

NORTH GRID 545 0 0 0 EAST GRID 836 0 0 0

50 55 57 63

SHOW MAJOR FEATURES OF BOX & LOCATE WELL WITH AN X

SOURCES OF DRILLING WATER

1 wells

2

3

WRITE THE BOX NUMBER FROM THE MAP HERE

E 8406

N 5405

000 000

DRAW A SKETCH BELOW SHOWING LOCATION OF WELL IN RELATION TO NEARBY TOWNS AND ROADS AND GIVE DISTANCE FROM WELL TO NEAREST ROAD JUNCTION

16 F 11

WOODSTOCK


Route 99

8/28/02
12:45
Easterday

SITE INSPECTION SHEET

OWNER: _____ PHONE #: _____
ADDRESS: 1575 Woodstock Rd CONTRACTOR: _____
WELL TAG #: _____
SUBDIVISION: _____ LOT: _____ COUNTY #: _____
PROPOSAL: Replacement Well - Low yield

LOCATION DIAGRAM

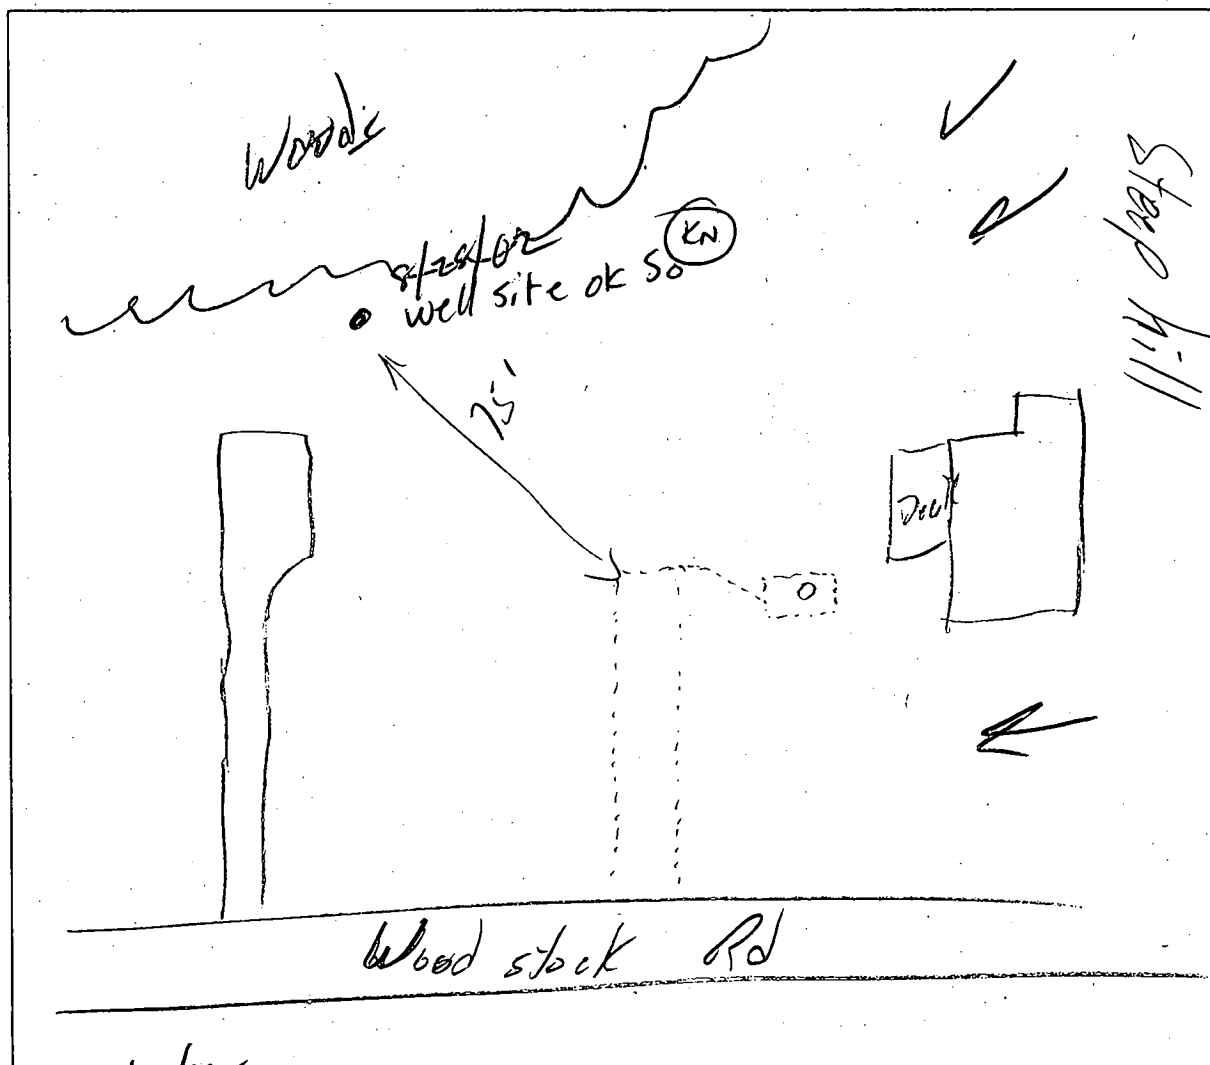

COMMENTS: 8/28/02 Can only get 75' from septic trench (SO)
8/29/02 Copy in drought file (KN)

DATE: _____ INSPECTOR: _____