

8/25/76
later
possible

58991-B

PERMIT

SEWAGE DISPOSAL SYSTEM

MARYLAND STATE DEPARTMENT OF HEALTH

HOWARD COUNTY

ELLCOTT CITY

INDEXED

DISTRICT 1

03-290360

INDEXED

DATE 9/18

Jason Brinsinger IS PERMITTED TO INSTALL X ALTER

ADDRESS 3445 Elmwood Drive, Ellicott City, Md. PHONE 441-1870

A SEWAGE DISPOSAL SYSTEM LOCATED AT

SUBDIVISION Sand Hill Acres ROAD 2485 Sand Hill Rd. LOT 2, Blk. A, Sec. 1

PROPERTY OWNER Floyd Guyton Don and Anne Torres

ADDRESS

SPECIFICATIONS - 4 bedrooms

DRAIN FIELD DEPTH FEET, BOTTOM AREA SQ. FT.

SEEPAGE PITS ABSORBENT SIDE-WALL AREA SQ. FT.

SEPTIC TANK CAPACITY 1,230 GALLONS

FOR GARBAGE GRINDER, INCREASE DISPOSAL AREA 25% & TANK CAPACITY 50%.

OTHER Dry well - 500 sq. ft. absorbent sidewall area to begin below the inlet, minimum depth permitted for dry well is 11 ft. below grade, locate dry well 60 ft. from rear property line and 45 ft. from right side line as seen from Sand Hill Road. Inlet 2 1/2 ft. below original grade for dry well.

NOTE: ALL PIPE FROM HOUSE TO DISPOSAL AREA MUST BE CAST IRON.

PERMIT VOID AFTER THREE YEARS.

NOTE: INSTALL STAND PIPE ON SEPTIC TANK AND DRY WELL. STAND PIPE MUST BE 6" IN DIA., CAST IRON CONCRETE OR TERRA COTTA ACCEPTED.

PLANS APPROVED BY R. Torres DATE 1/18/67

FILL SEPTIC TANK AND DISTRIBUTION BOX WITH WATER BEFORE CALLING FOR AN INSPECTION. COVER NO WORK UNTIL INSPECTED AND APPROVED.


NEITHER THE HOWARD COUNTY COMMISSIONERS NOR THE HEALTH DEPARTMENT IS RESPONSIBLE FOR THE SUCCESSFUL OPERATION OF ANY SYSTEM.

BLOG. PERMIT SIGNED
AND RETURNED 9-25-77
Serial # B 00108107
addition - kitchen

BLOG. PERMIT SIGNED
AND RETURNED 9/25/76
Serial # 50140
Change

BLOG. PERMIT SIGNED
AND RETURNED 9/25/74
Serial # 52250
Addition

17870
P 58991-B

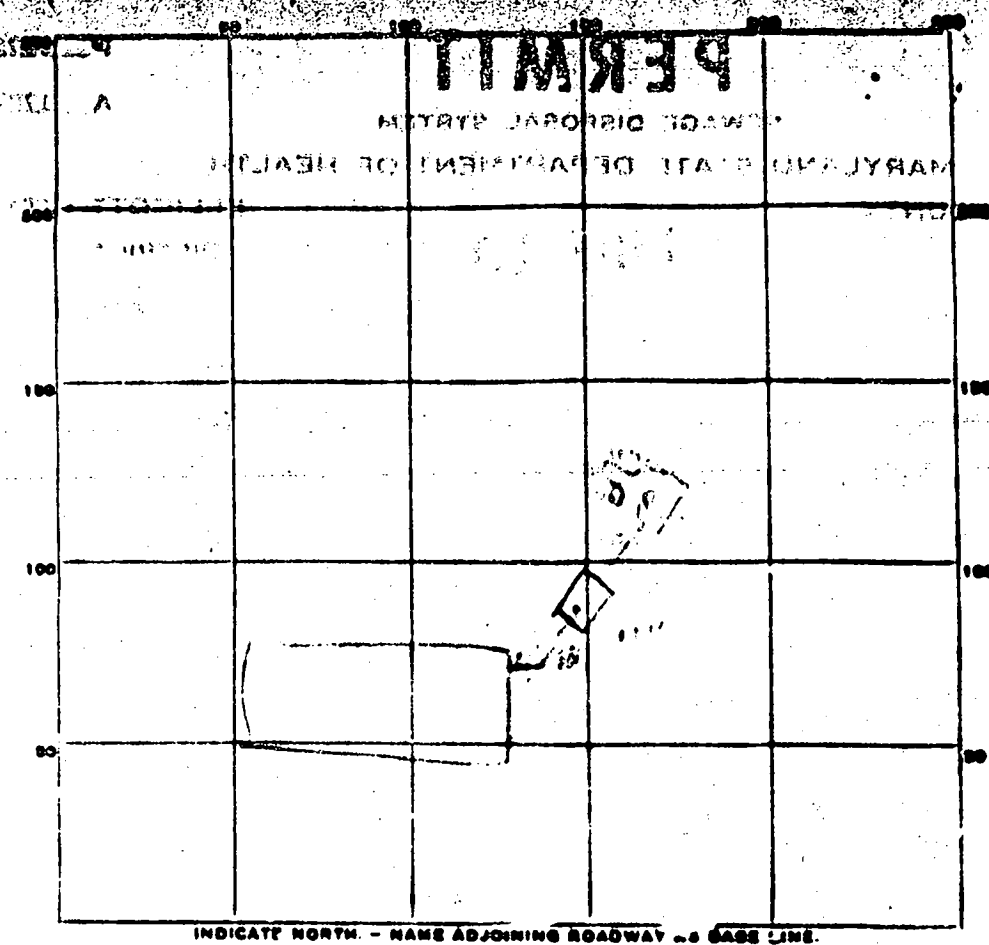

PERMIT CARD _____

SEPTIC TANK, LEVEL ✓ 64

CLEANOUTS _____

DISTRIBUTION BOX, LEVEL 64

TILE FIELD, DEPTH 1 ft. TRENCH WIDTH _____ FT.

GRAVEL DEPTH 1 ft. IN. TOTAL LENGTH _____ FT.

NUMBER OF TRENCHES 4 TOTAL BOTTOM AREA _____

SEEPAGE PITS, INSIDE DIAMETER 6 ft. DEPTH BELOW INLET 2 1/2 FT.

ABSORBENT AREA 12 SQ. FT.

REMARKS _____

DATE SYSTEM APPROVED 11/1/60

INSPECTOR A. J. N. H.

APPLICATION

SEWAGE DISPOSAL TESTING

MARYLAND STATE DEPARTMENT OF HEALTH

HOWARD COUNTY

ELLICOTT CITY

DISTRICT 3

DATE 10/18/66

TO: THE COUNTY HEALTH OFFICER
ELLICOTT CITY, MARYLAND

I, HEREBY, APPLY FOR THE NECESSARY TESTS IN ORDER TO CONSTRUCT OR RECONSTRUCT A SEWAGE DISPOSAL SYSTEM.

PROPERTY OWNER Sand Hill Joint Venture

ADDRESS 1010 Rockville Pike, Rockville, Md

PHONE 424-5103

PROPERTY LOCATION:

SUBDIVISION Sand Hill Acres

LOT NO. 2 (A)

ROAD AND DESCRIPTION Sand Hill Road

OCCUPANT

PHONE

PERSON TO CONSTRUCT SYSTEM

ADDRESS

PHONE

SIZE OF LOT 42,850 sq ft (average)

TYPE BLDG.

3

NUMBER OF BEDROOMS

IF NOT SINGLE RESIDENCE DESCRIBE

SIGNATURE OF APPLICANT

Robert H. Lovell

APPROVED BY

FOR

(KIND OF SYSTEM)

DATE

REJECTED BY

FOR

(KIND OF SYSTEM)

DATE

HOLD PENDING FURTHER TESTS

DATE


REASONS FOR REJECTION OR HOLDING

THIS IS NOT A PERMIT

2065 A 200

APPLICATION

SEWAGE DISPOSAL TESTING
HAWAIIAN STATE DEPARTMENT OF HEALTH

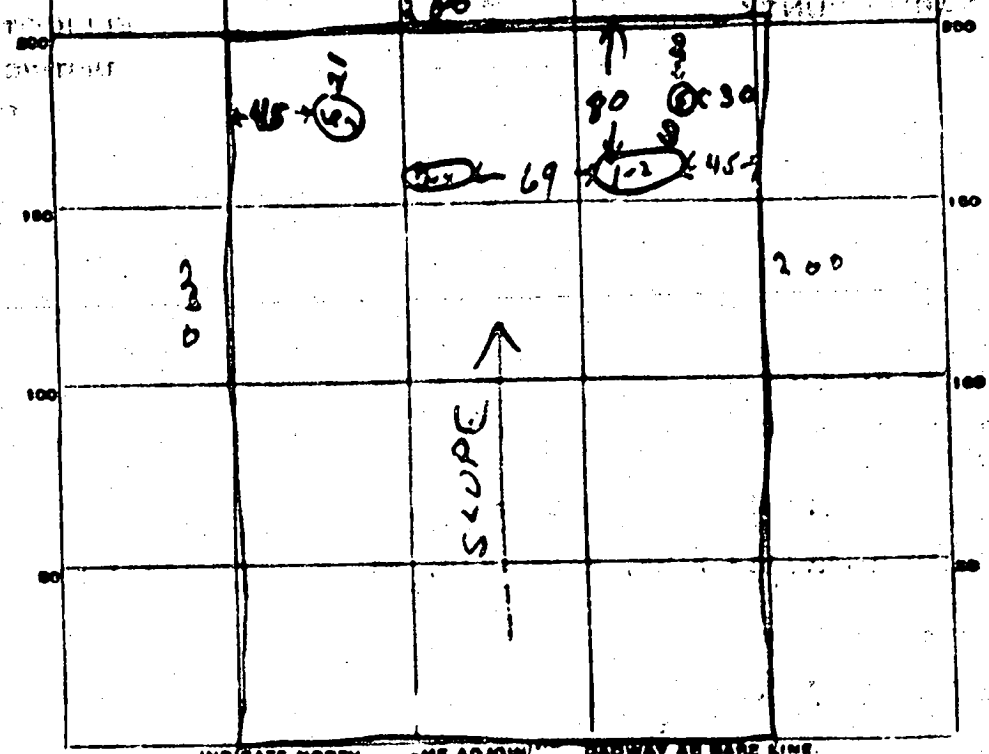

INDICATE NORTH - NAME ADJOINING ROADWAY AS BASE LINE.

Sand Hill Cr

DATE	TEST NO.	DEPTH	PRE-WET		TEST - 1" DROP		TIME
			START	STOP	START	STOP	
1-12-67	1	7 ft	10 27	10 29	10 28	10 34	4 min
1-19	2	4 ft	10 28	10 20	10 20	10 25	5 min
	3	9 ft	10 33	10 34	10 34	10 27	3 min
	4	7 ft	10 35	10 38	10 38	10 46	8 min 5 min
2/4/73	5	11 ft	Sandy		Sandy		Dry
	6	4 1/2 ft	10 37	10 35	10 34	10 47	12 min
	7	11 ft	10 37	10 39	10 39	10 43	4 min

SOIL AUGER FINDING

TESTED BY *JWM*

REMARKS *holes measured from edge to edge*

1/1/77 no present

100 21 22A

908114

'SAND HILL JOINT VENTURE' 082/010

PT UTILITY EASEMENT

10 19 37 10 11


046 02

BLOCK

LOT 8

A

LOT 1

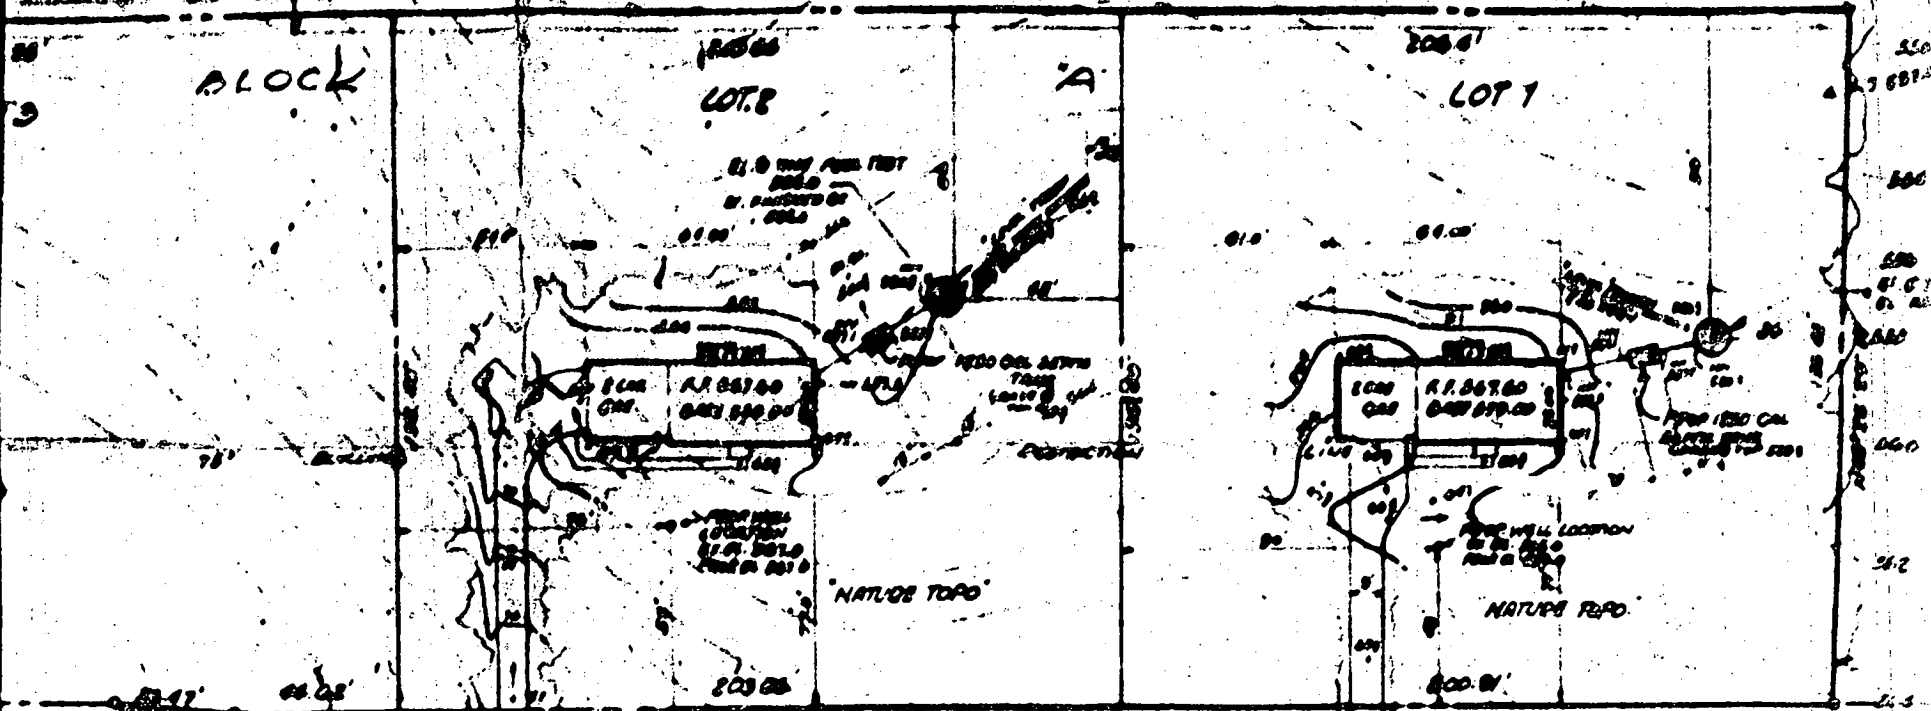

SAND

HILL

ROAD

138

DATE RECEIVED (WRA USE ONLY)

DATE WELL COMPLETED **6/22/76**

OWNER **GRAYSON**

STREET OR RFD **5501 Long Look Lane**

STATE OF MARYLAND

WATER RESOURCES ADMINISTRATION

TAVES STATE OFFICE BLDG., ANNAPOLIS, MD. 21401

WELL COMPLETION REPORT

FILL IN THIS FORM COMPLETELY

COUNTY NUMBER **A19869**

PERMIT NO. FROM "PERMIT TO DRILL WELL"

HIO-713-71938-?

DEPT. IDENTIFICATION NO. **209**

DEPTH OF WELL **150**

(TO NEAREST FOOT)

DRILLER'S IDENTIFICATION NO. **209**

POST OFFICE **Columbia, Md. 21043**

WELL LOG

STATE THE KIND OF FORMATIONS PENETRATED, THEIR COLOR, GRAIN, THICKNESS AND IF WATER BEARING

DESCRIPTION	FEET	THICKNESS
	FROM	TO
Red Soil	0	25
Red Clay	25	150

ROUTING RECORD

WELL HAS BEEN ROUTED (CIRCLE APPROPRIATE BOX)

TYPE OF ROUTING MATERIAL (CIRCLE BOX)

CEMENT ☒ BENTONITE CLAY ☒

NO. OF BAGS **7** NO. OF POUNDS **665**

GALLONS OF WATER **56**

DEPTH OF GROUT SEAL (TO NEAREST FOOT)

FROM **0** FT. TO **28** FT.

(ENTER 0 IF FROM SURFACE)

CASING RECORD

INSERT APPROPRIATE CODE


STEEL ☒ CO. ☒ PL. ☒ ST. ☒

MAIN CASING TYPE ☒ T. ☒ S. ☒ C. ☒ D. ☒ O. ☒ P. ☒ M. ☒ S. ☒ T. ☒ C. ☒ D. ☒ O.

**THIS PLAT CAN NOT BE USED TO ESTABLISH PROPERTY
LINES OR CORNERS.**



LOCATION SURVEY PLAT well & septic OK to Proceed A.I.M.
SUBJECT PROPERTY NOT LOCATED IN A FLOOD PLAIN AREA UNLESS OTHERWISE NOTED

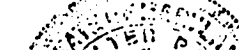CERTIFICATION	SEAL	SCALE / 70 DATE 12-2-1993
This is to certify that I have surveyed the property known as: <u>2485</u> <u>SAND HILL ROAD</u>		LAND DESIGN ENGINEERING, INC. 8835 Columbia 100 Parkway Unit N Columbia, MD 21045 (410) 715-1070
for the purpose of locating the im-		