

59921-B

SEWAGE DISPOSAL SYSTEM

MARYLAND STATE DEPARTMENT OF HEALTH

HOWARD COUNTY

ELLICOTT CITY

DISTRICT 3

DATE 3/7/74

03-284158

RE INDEXED

3/12/74 after 1 PM
7/29/74 after 12 noon

Harmon C. Sirk

IS PERMITTED TO INSTALL ☒ ALTER

ADDRESS Jennings Chapel Road, Woodbine, Md. PHONE 482-4724

A SEWAGE DISPOSAL SYSTEM LOCATED AT

SUBDIVISION Breezeood Farms ROAD Woodstock Rd. a LOT 1

PROPERTY OWNER Russell Mackett

ADDRESS Luigi & VENERA DiStefano

SPECIFICATIONS 4 bedrooms

DRAIN FIELD DEPTH 4 FT. BOTTOM 17.5 FT.

SEEPAGE PITS ABSORBENT SIDE-WALL AREA 125 SQ. FT.

SEPTIC TANK CAPACITY 1,250 GALLONS

FOR GARBAGE GRINDER, INCREASE DISPOSAL AREA 22% & TANK CAPACITY 50%

OTHER Dry well - 125 sq. ft. absorbent sidewall area per bedroom to begin below

inlet pipe. Inlet pipe to be 3 ft. below original grade. Max. depth 18 ft. below

original grade. Location 80 ft. from front property line and 100 ft. from left

property line when facing property from Woodstock Road.

NOTE: ALL PIPE FROM HOUSE TO SEPTIC TANK AND DRY WELL MUST BE CAST IRON.

PERMIT VOID AFTER THREE YEARS

NOTE: INSTALL STAND PIPE ON SEPTIC TANK AND DRY WELL,

PLANS APPROVED BY Harry J. Ebar DATE 3/7/74

FILL SEPTIC TANK AND DISTRIBUTION BOX WITH WATER BEFORE CALLING FOR AN INSPECTION. COVER NO WORKER UNTIL INSPECTED AND APPROVED.

NEITHER THE HOWARD COUNTY COMMISSIONERS NOR THE HEALTH DEPARTMENT IS RESPONSIBLE FOR THE SUCCESSFUL OPERATION OF ANY SYSTEM.

SEDC. PERMIT SIGNED

AND RETURNED

Serial # B10110741
I can garage with Florida Room

OK per F.T. 7/29/74 C.B.D.


INSPECTOR

DATE SYSTEM APPROVED

19630

5-9921-B

**INSPECTOR**

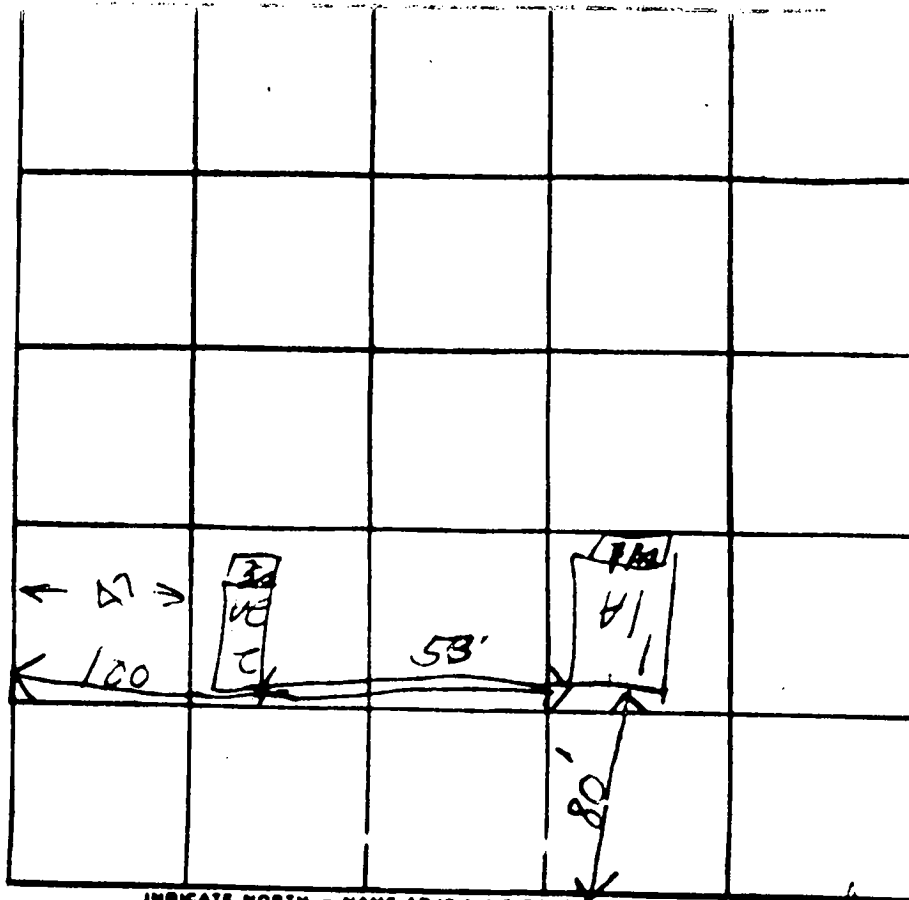

INDICATE NORTH - NAME ADJOINING ROADWAY AS BASE LINE

Proctor Rd Woodstock


DATE	TEST NO.	DEPTH	PRE-WET		TEST - 1" DROP		TIME
			START	STOP	START	STOP	
3-27	1	12'	153	157	187	201	15
↑	1A	45'	210	215	215	220	6 min
✓	2	12'	204	206	206	209	3
3-27	2A	4 1/2'	207	209	209	213	2 1/2

11'
7
18 min
(4) 62

REMARKS _____

TYPE OF SOIL _____

TESTED BY _____ ALSO PRESENT: _____

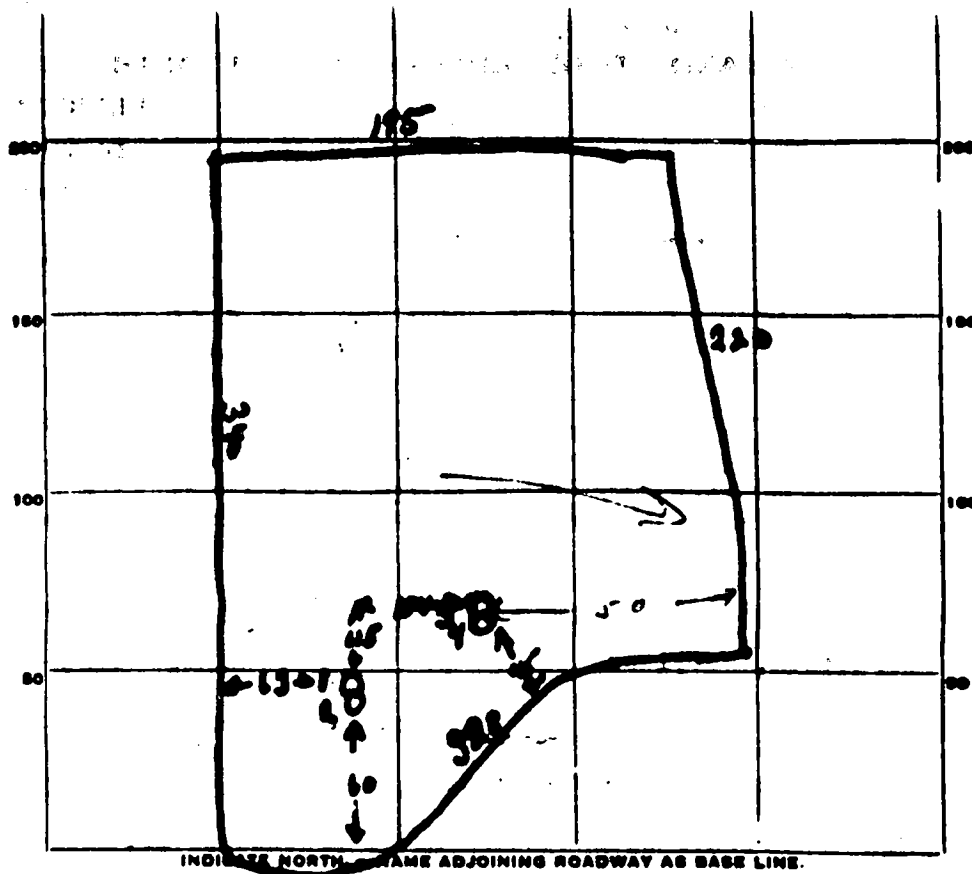

DATE	TEST NO.	DEPTH	PRE-WET		TEST - 1" DROP		TIME
			START	STOP	START	STOP	
9-9-67	1	9	135	142	142	154	12
2-9-67	2	5	137	209	209	231	22
1-9-67	3	5	209	219	219	229	10
2-9-67	4	10	209	6	→	215	4

12

SOIL AUGER FINDING _____

TESTED BY Joe Feb 9 1967

REMARKS _____

ST/CO USE ONLY
DATE RECEIVED _____
DATE WELL COMPLETED 02/01/02

Depth of Well
27 20 30
(TO NEAREST FOOT)

PERMIT NO.
FROM "PERMIT TO DRILL WELL"
HO-92-0073

OWNER D. L. FANNO
last name first name

TOWN WOODSTOCK

SECTION C3 **LOT** 3

WELL LOG
Not required for driven wells
STATE THE KIND OF FORMATIONS PENETRATED, THEIR COLOR, DEPTH, THICKNESS AND IF WATER BEARING

DESCRIPTION (Use additional sheets if needed)	FEET		Check water bearing
	FROM	TO	
F.S. Soil	0	2	
Sand	2	4	
Shale	4	10	
V. fine sand	10	15	
Clay shale	15	20	
Sand shale	20	30	
Gravelly	30	45	
Sand shale	45	47	
Gravelly	47	175	
Quartz	175	178	✓
Shale	178	260	
Quartz	260	261	✓
Gravelly	261	280	
Quartz	280	282	✓
Gravelly	282	340	

GROUTING RECORD
WELL HAS BEEN GROUTED (Circle Appropriate Box)
TYPE OF GROUTING MATERIAL
CEMENT (CM) BENTONITE CLAY (BC)
NO. OF BAGS 6 NO. OF POUNDS 66
GALLONS OF WATER
DEPTH OF GROUT SEAL (to nearest foot)
from 1 ft. to 1 ft.
(Enter 0 if from surface)

CASINO RECORD
casing types insert appropriate code below
STEEL (ST) CONCRETE (CO)
PLASTIC (PL) OTHER (OT)
MAIN CASING TYPE
Nominal diameter top (main) casing (nearest inch) 6
Total depth of main casing (nearest foot) 27

OTHER CASING (# used)
diameter inch length (feet) from to

SCREEN RECORD
screen type or open hole insert appropriate code below
STEEL (ST) BRASS (BR) HO OPEN HOLE (HO)
PLASTIC (PL) OTHER (OT)
C2
DEPTH (nearest ft.)
EACH SCREEN
1 10 19 340
2
3
SLOT SIZE 1 2 3
DIAMETER OF SCREEN (NEAREST INCH)
from to
GRAVEL PACK IF WELL DRILLED WAS FLOWING WELL INSERT F IN BOX 68
JEP USE ONLY (NOT TO BE FILLED IN BY DRILLER)
T I.E.R.O.S. W.O.
LOG INDICATOR OTHER DATA

PUMP INSTALLATION
DRILLER WILL INSTALL PUMP (CIRCLE) (YES OR NO)
IF DRILLER INSTALLS PUMP, THIS SECTION MUST BE COMPLETED FOR ALL WELLS EXCEPT HOME USE
TYPE OF PUMP INSTALLED PLACE (A,C,J,P,R,S,T,O) IN BOX - SEE ABOVE:
CAPACITY: GALLONS PER MINUTE (Nearest gallon)
PUMP HORSE POWER
PUMP COLUMN LENGTH (nearest ft.)
CASING HEIGHT (circle appropriate box and enter casing height)
LAND SURFACE (nearest foot)
LOCATION OF WELL ON LOT SHOW PERMANENT STRUCTURE SUCH AS BUILDING, SEPTIC TANKS, AND/OR LANDMARKS AND INDICATE NOT LESS THAN TWO DISTANCES (MEASUREMENTS TO WELL)
Well 60'
Woodstock Rd

CIRCLE APPROPRIATE LETTER
A A WELL WAS ABANDONED AND SEALED WHEN THIS WELL WAS COMPLETED
E ELECTRIC LOG OBTAINED
P TEST WELL CONVERTED TO PRODUCTION WELL

I HEREBY CERTIFY THAT THIS WELL HAS BEEN CONSTRUCTED IN ACCORDANCE WITH COMM. DIVISION WELL CONSTRUCTION CODE IN CONFORMANCE WITH ALL CONDITIONS STATED IN THE ABOVE CAPTIONED PERMIT AND THAT THE INFORMATION PRESENTED HEREIN IS ACCURATE AND COMPLETE TO THE BEST OF MY KNOWLEDGE

DRILLERS IDENT NO. _____

DRILLERS SIGNATURE
(MUST MATCH SIGNATURE ON APPLICATION)

TELESCOPE CASING

OWNER: LUIGI DISTEFANO

DATE REQUESTED: 5/20/92 11:00

PHONE #: 765-7724


CONTRACTOR: EASTMAN

ADDRESS: 1760 WOODSTOCK RD

WELL TAG #: H0-92-0074

MAP 10 GRASS PARCEL 188 1st/2nd COUNTY #: RW 48127

PROPOSAL: REPLACE/OUT WELL SITING.

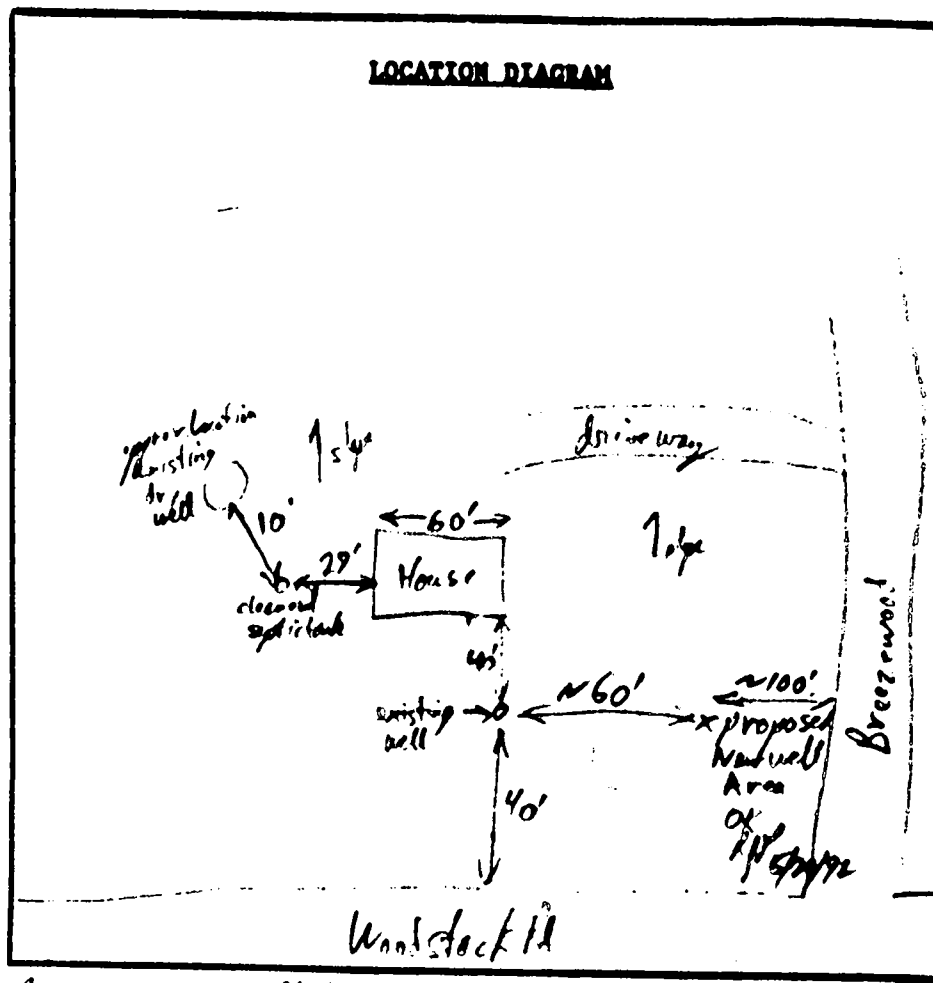


COMMENTS: Proposed New well location is at least 100ft
from septic

DATE: _____

INSPECTOR: _____

20315 Hwy 84
2-14

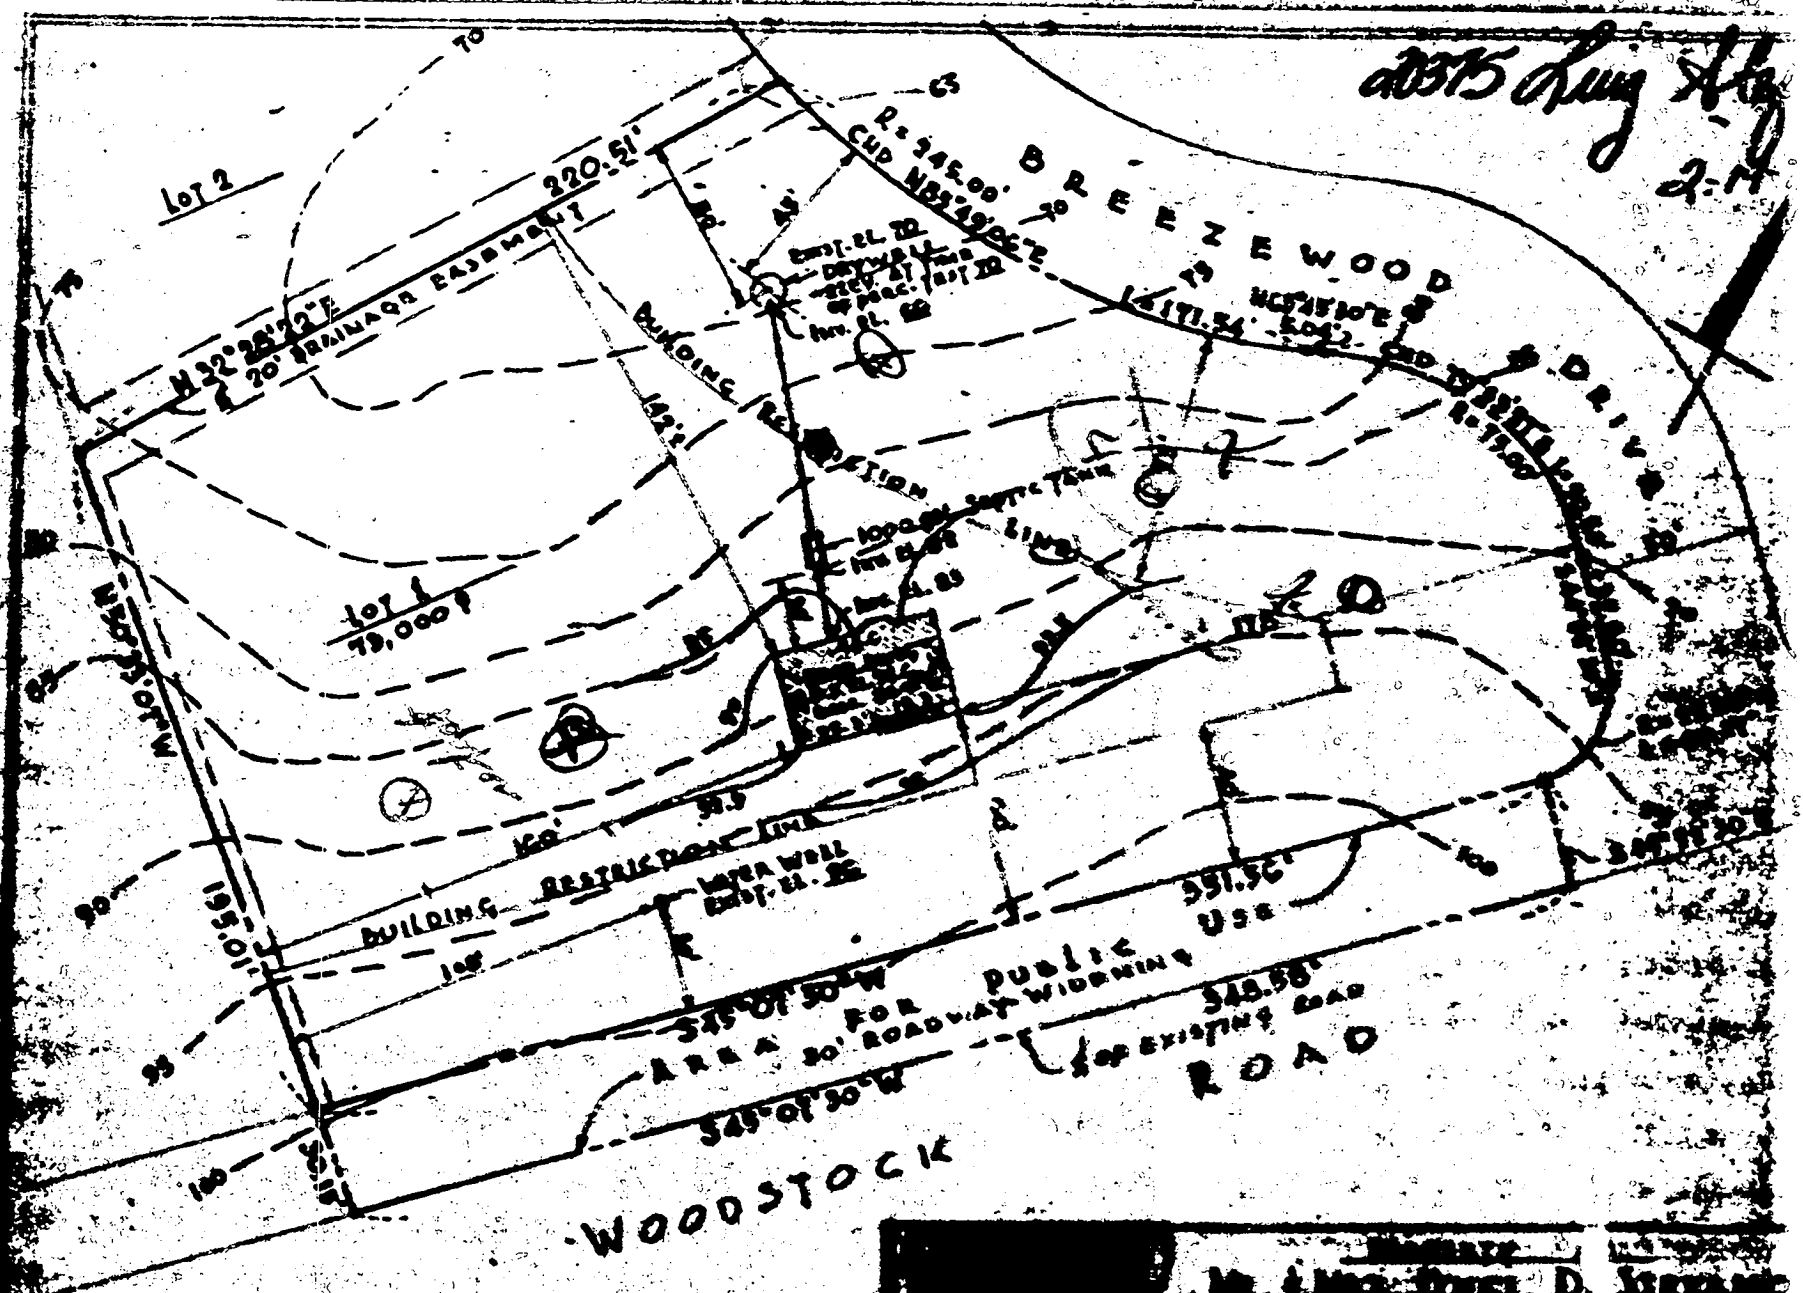

Plot Plan
Scale: 1" = 20'

Mr. & Mrs. D. D. KIRK
BREEZEWOOD DRIVE
WOODSTOCK, N.C.
28080

ELL V. BECKETT
221/42

