optional

HOWARD COUNTY HEALTH DEPARTMENT

SEWAGE DISPOSAL SYSTEM

DEPARTMENT OF HEALTH AND MENTAL HYGIENE

Ъ	21010	el L
Δ	REPAIR	•

DISTRICT

DATE SYSTEM APPRO

05-370 Ue4

BUREAU OF ENVIRONMENTAL HEALTH XXXXXXXX 410-313-2640

INDEXE

	MULKLU	INSPECTOR 29
Jack Fyock Septic Servi	ice IS	PERMITTED TO INSTALLALTER X
ADDRESS 13775 Triadelphia Road,	Glenelg, Maryland 21737	PHONE 410-988-9270
		11863 Route 216
PROPERTY OWNER		
SEPTIC TANK CAPACITY GALLON NUMBER OF BEDROOMS SQUARE FEET PER BEDROOM LINEAR FEET OF TRENCH REQUIRED 5		
	en ground is opened so that	a sanitarian can recommend repair 5/14/98
INCT 6: , BOTTO	m 12 6 STONE	
PLANS APROVED BY		DATE
EITHER THE HOWARD COUNTY COUNCIL NOR THE HI	EALTH DEPARTMENT IS RESPONSIBLE FOR THE	SUCCESSFUL OPERATION OF ANY SYSTEM

NOTE: CLEANOUT REQUIRED EVERY 70 FEET OF SEWER LINE AND/OR AT 90' SWEEPS IN LINES FROM HOUSE TO DRAIN FIELDS, 90' ELBOWS NOT ACCEPTABLE.

NOTE: ALL PARTS OF SEPTIC SYSTEMS (I.E. TANK, DISTRIBUTION BOX TRENCHES) TO BE 100 FEET FROM WELL (UNLESS OTHERWISE SPECIFICALLY AUTHORIZED)

NOTE: IF DEEP TRENCH(ES) ARE USED CALL FOR INSPECTION BEFORE AND AFTER PLACING GRAVEL IN TRENCH(ES)

NOTE: NO DRY WELL SHALL EXCEED 15 FOOT IN DIAMETER NO ABSORPTION TRENCH TO EXCEED 100 FEET IN LENGTH


NOTE: ALL PIPE FROM HOUSE TO SEPTIC TANK MUST BE CAST IRON OR SCHEDULE 35/40 PVC OR ABS

PERMIT VOID AFTER TWO YEARS

NOTE: INSTALL STAND PIPE ON SEPTIC TANK AND DRY WELL STAND PIPES MUST BE 6 INCHES IN DIAMETER CAST IRON. CONCRETE OR TERRA COTTA OR PVA OR ABS ACCEPTED. IF TOP OF SEPTIC TANK IS DEEPER THAN 3 FEET. MANHOLE TO GRADE REQUIRED.

NOTE: DISTRIBUTION BOXES MUST HAVE BAFFLES

*INSTALLER IS RESPONSIBLE FOR OBTAINING FINAL APPROVAL ON THIS PERMIT *CALL 461-9933 FOR INSPECTION OF SEPTIC SYSTEM.

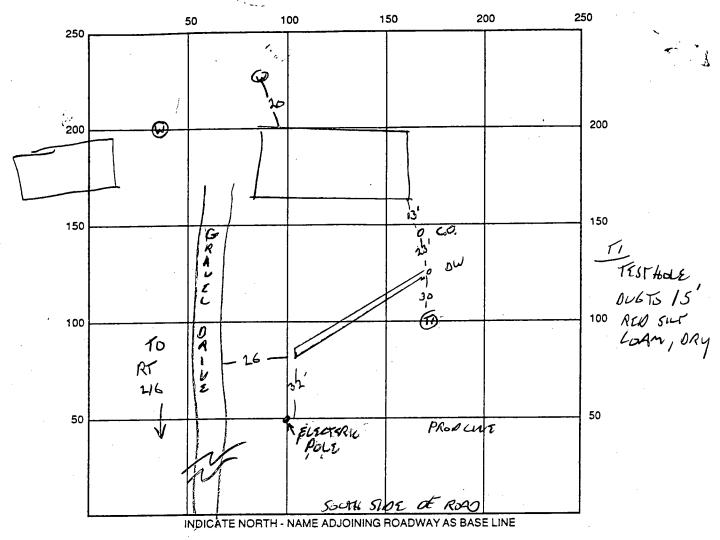

SEPTIC TANK LEVEL NA CLEANOUTS TO BE INSTACCED TO GRADE
DISTRIBUTION BOX LEVEL ALA
DRAIN FIELD/TITLE DEPTH 12 FT. TRENCH WIDTH 2 FT. INLET DEPTH 6 FT.
EFFECTIVE GRAVEL DEPTH 6 FT. TOTAL LENGTH 65 FT.
NUMBER OF TRENCHES 1 ONE SIDEWALL/BOTTOM AREA 390 SQ. FT.
DRYWALL INSIDE DIAMETER FT. EFFECTIVE DEPTH BELOW INLET FT.
ABSORBENT AREASQ. FT.
REMARKS: 5/26/98 REPAIR TRENCH STARTED, OK TO COVER WORK
IE I HAVENT RETURNED 134 2-PM, Set
DATE SYSTEM APPROVED 5.26.98 INSPECTOR MAN Suy

() ")

