

PERMIT

SEWAGE DISPOSAL SYSTEM

DEPARTMENT OF HEALTH AND MENTAL HYGIENE

P 510224-BA REPAIR

DISTRICT _____

DATE 6-24-98DATE SYSTEM APPROVED 7-13-98INSPECTOR SP

HOWARD COUNTY HEALTH DEPARTMENT

BUREAU OF ENVIRONMENTAL HEALTH

~~XXXXXX~~ 410-313-2640

INDEXED

Jack Fyock Septic ServicesIS PERMITTED TO INSTALL _____ ALTER XADDRESS P.O. Box 89, Glenelg, MD 21737PHONE 410-988-9270SUBDIVISION Friendship Manor LOT 2 ROAD 12557 Route 144PROPERTY OWNER MalinowskiADDRESS 12557 Route 144, West Friendship, MD 21794SEPTIC TANK CAPACITY 1000 GALLONSNUMBER OF BEDROOMS 3125 SQUARE FEET PER BEDROOMLINEAR FEET OF TRENCH REQUIRED 85

REPAIR - PURPOSE - SEPTIC SYSTEM HAS FAILED.

Call for an inspection when the ground is opened so a sanitarian can recommend repairs.

7-8-98.

INLET 5.5, BOTTOM 10'PLANS APPROVED BY SP 7/13/98

DATE _____

COVER NO WORK UNTIL INSPECTED AND APPROVED

NEITHER THE HOWARD COUNTY COUNCIL NOR THE HEALTH DEPARTMENT IS RESPONSIBLE FOR THE SUCCESSFUL OPERATION OF ANY SYSTEM

NOTE: CLEANOUT REQUIRED EVERY 70 FEET OF SEWER LINE AND/OR AT 90° SWEEPS IN LINES FROM HOUSE TO DRAIN FIELDS. 90° ELBOWS NOT ACCEPTABLE.

NOTE: ALL PARTS OF SEPTIC SYSTEMS (I.E. TANK, DISTRIBUTION BOX TRENCHES) TO BE 100 FEET FROM WELL (UNLESS OTHERWISE SPECIFICALLY AUTHORIZED)

NOTE: IF DEEP TRENCH(ES) ARE USED CALL FOR INSPECTION BEFORE AND AFTER PLACING GRAVEL IN TRENCH(ES)

NOTE: NO DRY WELL SHALL EXCEED 15 FOOT IN DIAMETER NO ABSORPTION TRENCH TO EXCEED 100 FEET IN LENGTH

NOTE: ALL PIPE FROM HOUSE TO SEPTIC TANK MUST BE CAST IRON OR SCHEDULE 35/40 PVC OR ABS


PERMIT VOID AFTER TWO YEARS

NOTE: INSTALL STAND PIPE ON SEPTIC TANK AND DRY WELL STAND PIPES MUST BE 6 INCHES IN DIAMETER CAST IRON, CONCRETE OR TERRA COTTA OR PVA OR ABS ACCEPTED. IF TOP OF SEPTIC TANK IS DEEPER THAN 3 FEET, MANHOLE TO GRADE REQUIRED.

NOTE: DISTRIBUTION BOXES MUST HAVE BAFFLES

*INSTALLER IS RESPONSIBLE FOR OBTAINING FINAL APPROVAL ON THIS PERMIT

A 510224-B

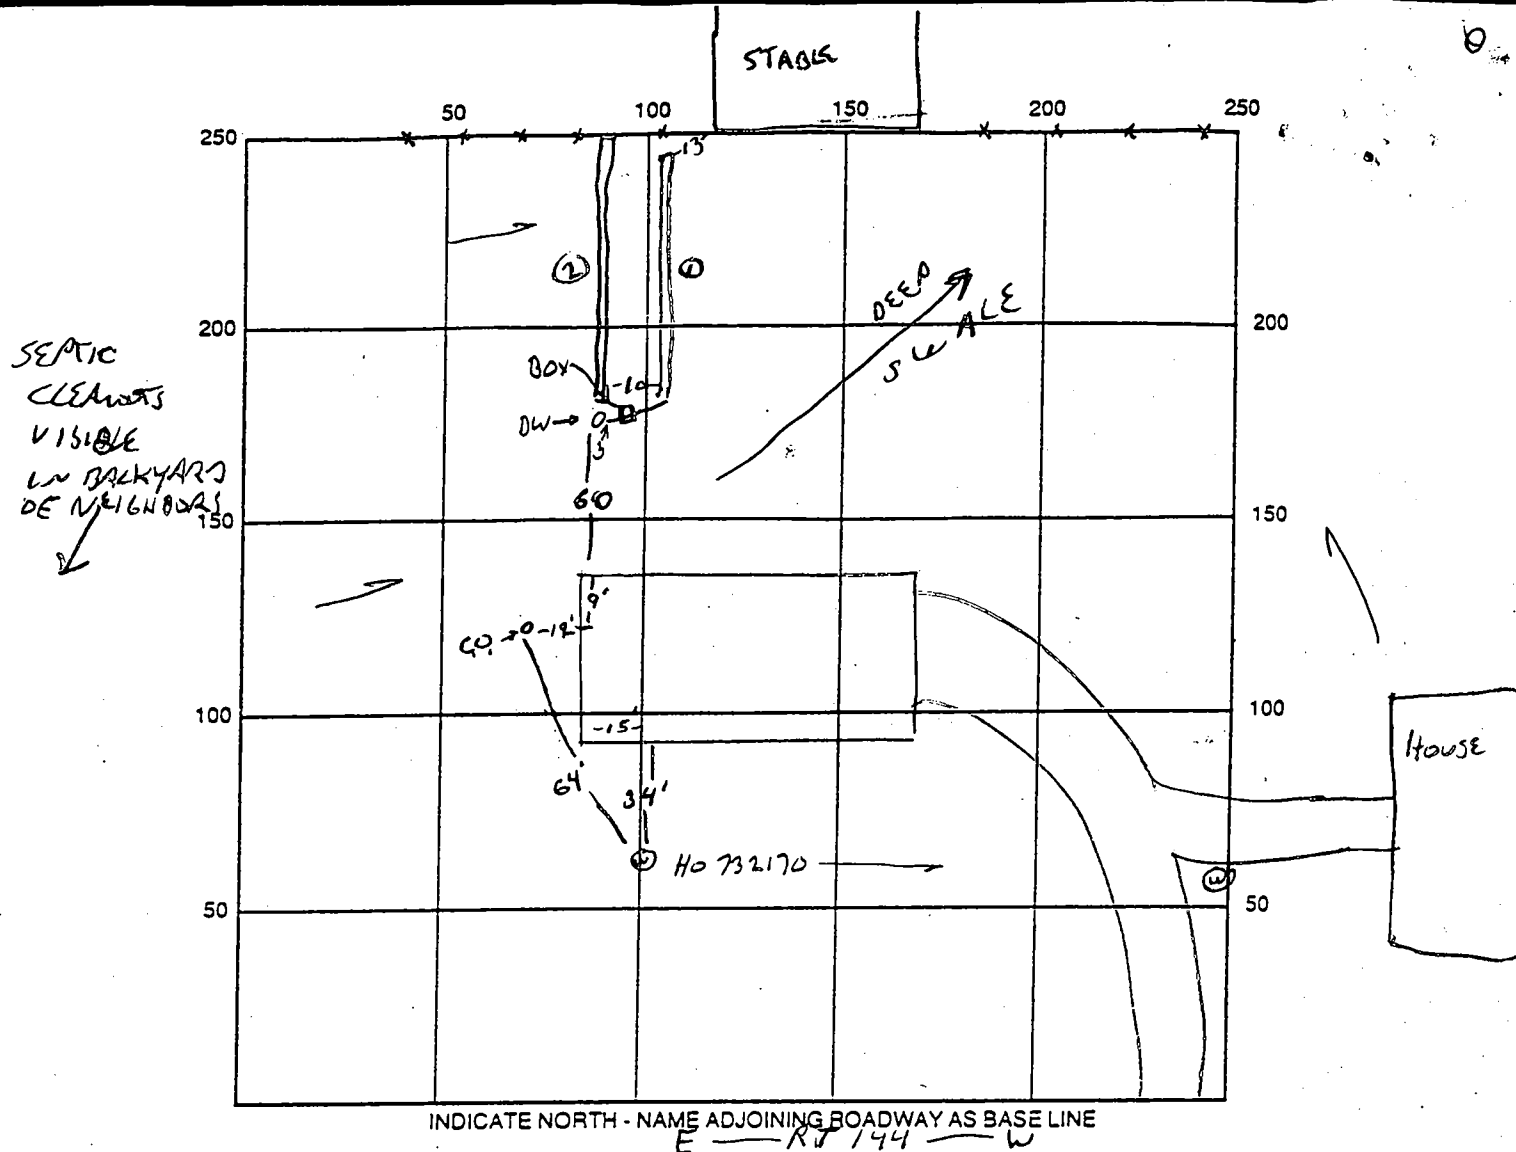

SEPTIC TANK LEVEL NA CLEANOUTS NA

DISTRIBUTION BOX LEVEL OK

DRAIN FIELD/TITLE DEPTH 10 FT. TRENCH WIDTH 2 FT. INLET DEPTH 15.5 FT.

EFFECTIVE GRAVEL DEPTH 4.5 FT. TOTAL LENGTH 45 FT. = 102

NUMBER OF TRENCHES 2 ONE SIDEWALL/BOTTOM AREA 459 SQ. FT.

DRYWALL INSIDE DIAMETER — FT. EFFECTIVE DEPTH BELOW INLET — FT.

ABSORBENT AREA ✓ SQ. FT.

REMARKS: 7.13.98 OK TO FINISH 1ST TRENCH & 7.13 FINAL COVER

ALL WORK

TEST HOLE DUG 15' DEEP DRYWALL, CLAY TO 3', MANHOLE LAMINATE BOTTOM, DRY.

DATE SYSTEM APPROVED 7.13.98

INSPECTOR SEA

PERMIT

P 27627A 25961

SEWAGE DISPOSAL SYSTEM

MARYLAND STATE DEPARTMENT OF HEALTH

HOWARD COUNTY

ELLICOTT CITY

DISTRICT 3rd

INDEX

DATE 2/24/78Diggers, Inc.IS PERMITTED TO INSTALL X ALTERADDRESS Box 127, W. Friendship, Md.

PHONE

SUBDIVISION

lot 2 section one 12557ROAD Route 144LOT 2FRIENDSHIP MANORPROPERTY OWNER Worthington B. RidgelyALBERT SCHEELADDRESS 2149 Route 97, Cooksville, Md.SPECIFICATIONS 3 bedroomsSEPTIC TANK CAPACITY 1000 GALLONS

DRAIN FIELD DEPTH FEET. BOTTOM AREA SQ. FT.

DEEP TRENCH DEPTH FEET. BOTTOM AREA SQ. FT.

SEEPAGE PITS ABSORBENT SIDE-WALL AREA 132 SQ. FT. per bedroomINLET PIPE 3 FT. BELOW ORIGINAL GRADE. MAXIMUM DEPTH 11 FT. BELOW ORIGINAL GRADE

EFFECTIVE DEPTH AT FT. BELOW ORIGINAL GRADE.

LOCATE DISPOSAL AREA 220 FT. FROM front LOT LINE AND 20 FT. FROM left LOT LINE AS SEEN WHENFACING LOT FROM Route 144

TRENCH-to be 15 ft. long for a total absorbent area of 100 sq. ft. Inlet to be 3 1/4
and maximum depth 11 ft. Come off rear of dry well, run trench directly towards rear
lot line. Keep trench on contour to keep it level.

PLANS APPROVED BY William W. ZeppDATE 10/3/77

COVER NO WORK UNTIL INSPECTED AND APPROVED.

NEITHER THE HOWARD COUNTY COUNCIL NOR THE HEALTH DEPARTMENT IS RESPONSIBLE FOR THE SUCCESSFUL OPERATION OF ANY SYSTEM.

NOTE: IF TRENCH IS USED CALL FOR INSPECTION BEFORE PLACING GRAVEL IN TRENCH.


NOTE: NO DRY WELL SHALL EXCEED 15 FOOT IN DIAMETER.

NOTE: ALL PIPE FROM HOUSE TO DISPOSAL AREA MUST BE CAST IRON.

PERMIT VOID AFTER THREE YEARS.

NOTE: INSTALL STAND PIPE ON SEPTIC TANK AND DRY WELL. STAND PIPES MUST BE 6 INCHES IN DIAMETER. CAST IRON, CONCRETE OR TERRA
COTTA ACCEPTED.***INSTALLER IS RESPONSIBLE FOR OBTAINING FINAL APPROVAL ON THIS PERMIT.**

A25961

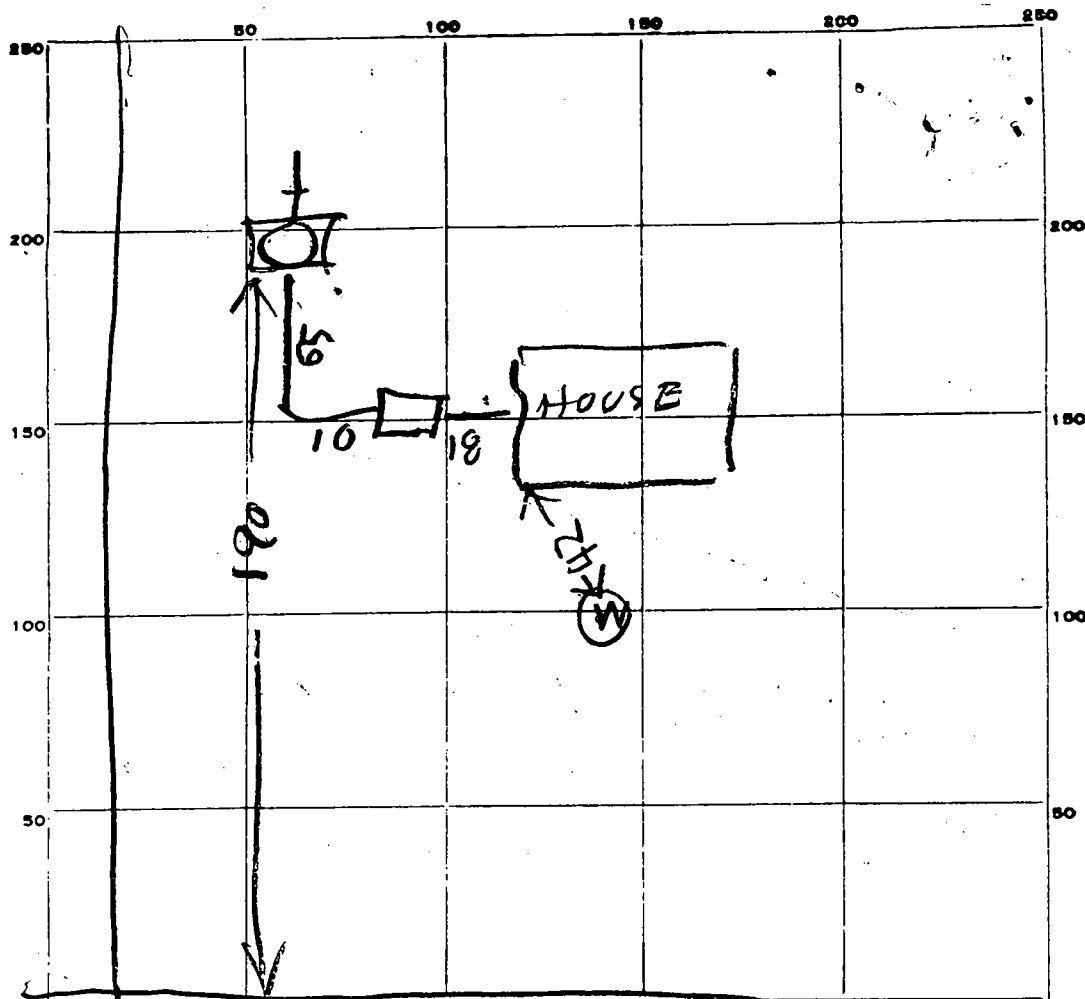

INDICATE NORTH - NAME ADJOINING ROADWAY AS BASE LINE.

PERMIT CARD

SEPTIC TANK, LEVEL OK TOP OF 9 Below CLEANOUTS OK/OK

DISTRIBUTION BOX, LEVEL

TILE FIELD, DEPTH ? FT. TRENCH WIDTH 2 FT.

GRAVEL DEPTH ? IN. TOTAL LENGTH 10 FT.

NUMBER OF TRENCHES ? TOTAL BOTTOM AREA ?

SEEPAGE PITS, INSIDE DIAMETER 55 FT. DEPTH BELOW INLET 5 FT.

ABSORBENT AREA 385 SQ. FT.

REMARKS 3/21/78 T.S.O 1100MS; ST in & connected to house, partially completed DW. (black cover) saved in on one side. No other work done.

312 R - 396 SQ FT REQUIRED RH

5/12/78 DW INLET 5 FT DEEP BELOW GRADE

OK TO PUT STONE IN DITCH COVER TANK & DW. & CALL US FOR INSPECTION OF DITCH

11/3/79 SYSTEM COVERED HOUSE VALANT RH 3/1/79 - SEE ATTACHED

DATE SYSTEM APPROVED

INSPECTOR

6/7/1967

130 Ridgely prop.

W.F.

lots 1, 2, 3

Topo shown on plat does
not agree w that actually
observed on indiv. lots.

Suggest new topo and
field located holes if
necessary.

- W.W.B.

APPLICATION

A 25961

P. _____

SEWAGE DISPOSAL TESTING

STATE OF MARYLAND - DEPARTMENT OF HEALTH AND MENTAL HYGIENE

HOWARD COUNTY HEALTH DEPARTMENT
ENVIRONMENTAL HEALTH SERVICESP. O. BOX 476, ELLICOTT CITY, MARYLAND 21043
TELEPHONE: 465-5000, EXT. 356DISTRICT 3DATE 5-31-774/22/77
1:30 pm. $\bar{t} = 9 \text{ min} \Rightarrow 110 \text{ A/BR}$
 $+20\% = 22 \text{ A/BR}$
 $\rightarrow 132 \text{ A/BR}$
$$\begin{array}{r} 132 \\ 4 \overline{) 528} \\ \underline{528} \end{array} \quad \begin{array}{r} 30 \\ 8 \overline{) 224} \\ \underline{210} \\ 14 \end{array} \quad \begin{array}{r} 30 \\ 7 \overline{) 210} \\ \underline{210} \\ 0 \end{array}$$
TO: THE COUNTY HEALTH OFFICER
ELLICOTT CITY, MARYLAND

I, HEREBY, APPLY FOR THE NECESSARY TEST IN ORDER TO CONSTRUCT (OR RECONSTRUCT) A SEWAGE DISPOSAL SYSTEM.

PROPERTY OWNER Worthington B. RidgeleyADDRESS 2149 RT #97 Cooksville Md 21723 PHONE 489-4004

PROPERTY LOCATION:

SUBDIVISION Route #144 West Friendship LOT NO. NEW LOT 2ROAD AND DESCRIPTION Route #144SIZE OF LOT 3 ac. TYPE BLDG. 4
ACRES NUMBER OF BEDROOMS


IF NOT SINGLE RESIDENCE DESCRIBE _____

THE SYSTEM INSTALLED UNDER THIS APPLICATION IS ACCEPTABLE ONLY UNTIL PUBLIC FACILITIES BECOME AVAILABLE

SIGNATURE OF APPLICANT Carol R. Clark 531-5115APPROVED BY H. H. Zipp FOR DW + trench DATE 10/3/77
(KIND OF SYSTEM)REJECTED BY _____ FOR _____ DATE _____
(KIND OF SYSTEM)HOLD PENDING FURTHER TESTS WWZ DATE 6/7/77

REASONS FOR REJECTION OR HOLDING _____

THIS IS NOT A PERMIT

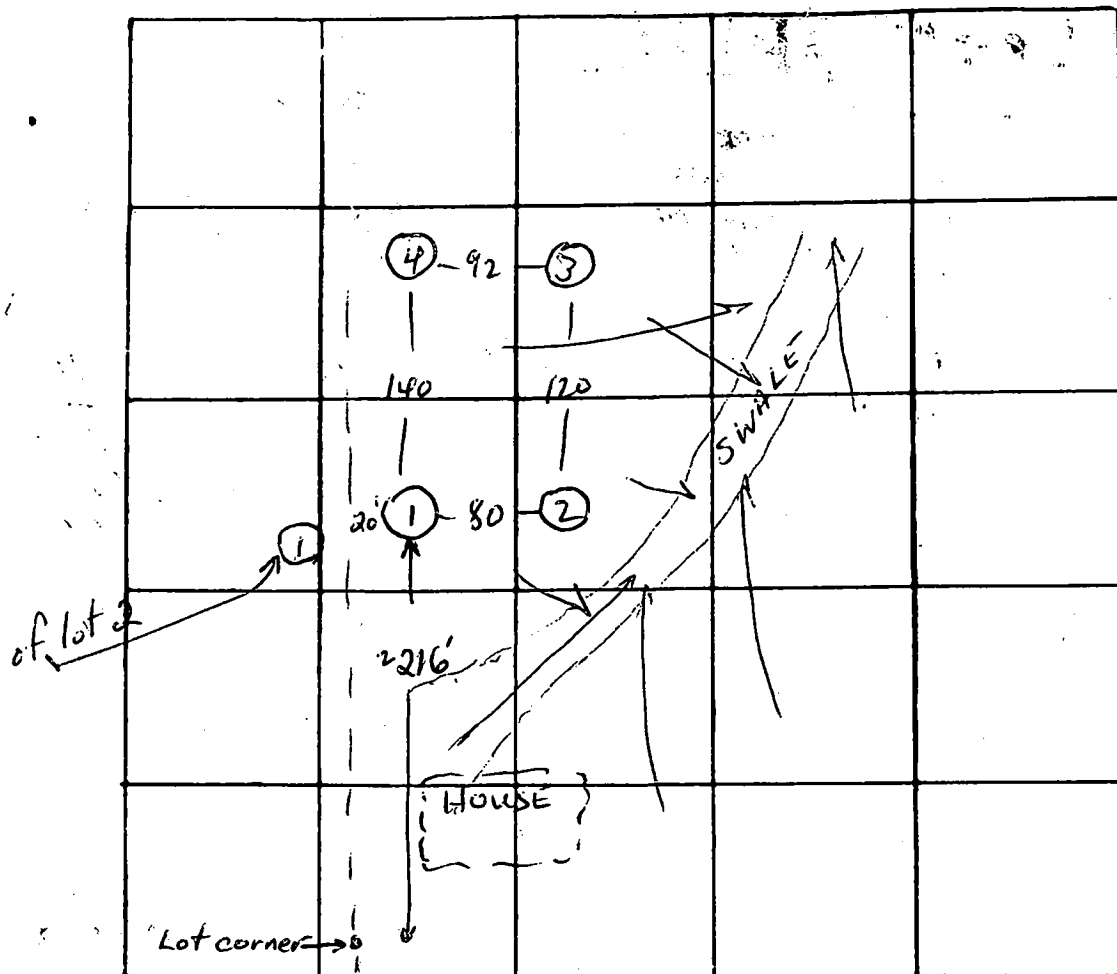

INDICATE NORTH. - NAME ADJOINING ROADWAY AS BASE LINE
E — FRED RD — W

DATE	TEST NO.	DEPTH	PRE-WET		TEST - 1" DROP		TIME	
			START	STOP	START	STOP		
6/7/77	1	3	10:32	10:34	10:34	10:39	5	13
	1-A	12 1/2	10:32	10:36	10:36	10:44	8	
	2	2 1/2	10:48	10:55	10:55	11:13	18	24
	2-A	12 3/4	10:48	10:52	10:52	11:00	8	
Lowest	3	2 1/2	11:04	11:05	11:05	11:07	2	13
	3-A	13	11:04	11:07	11:07	11:18	11	
	4	12	Visual	EXCELLENT	SANDY	LOAD	4	9
								6/52

REMARKS System in 1 → 4
sewer from house will have to cross swale to get to perc area

TYPE OF SOIL Sandy loam

TESTED BY WWZ

ALSO PRESENT: School Co

MD ROUTE 144

HOUSE

F.F. 554.0

Base 545.0

Inv. Out 551.5

SEPTIC TANK

Ex. Gr. 549.0

Fin. Gr. 552.0

Inv. In 551.0

Inv. Out 550.7

DRYWELL

Ex. Gr. 552.0

Fin. Gr. 552.0

Inv. In 549.0


WELL

Ex. Gr. 558.1

Fin. Gr. 558.1

Lot 3

Note: Topography
Based on Aerial
Topo By Howard Co.
Contractor to Set
Grades in the Field

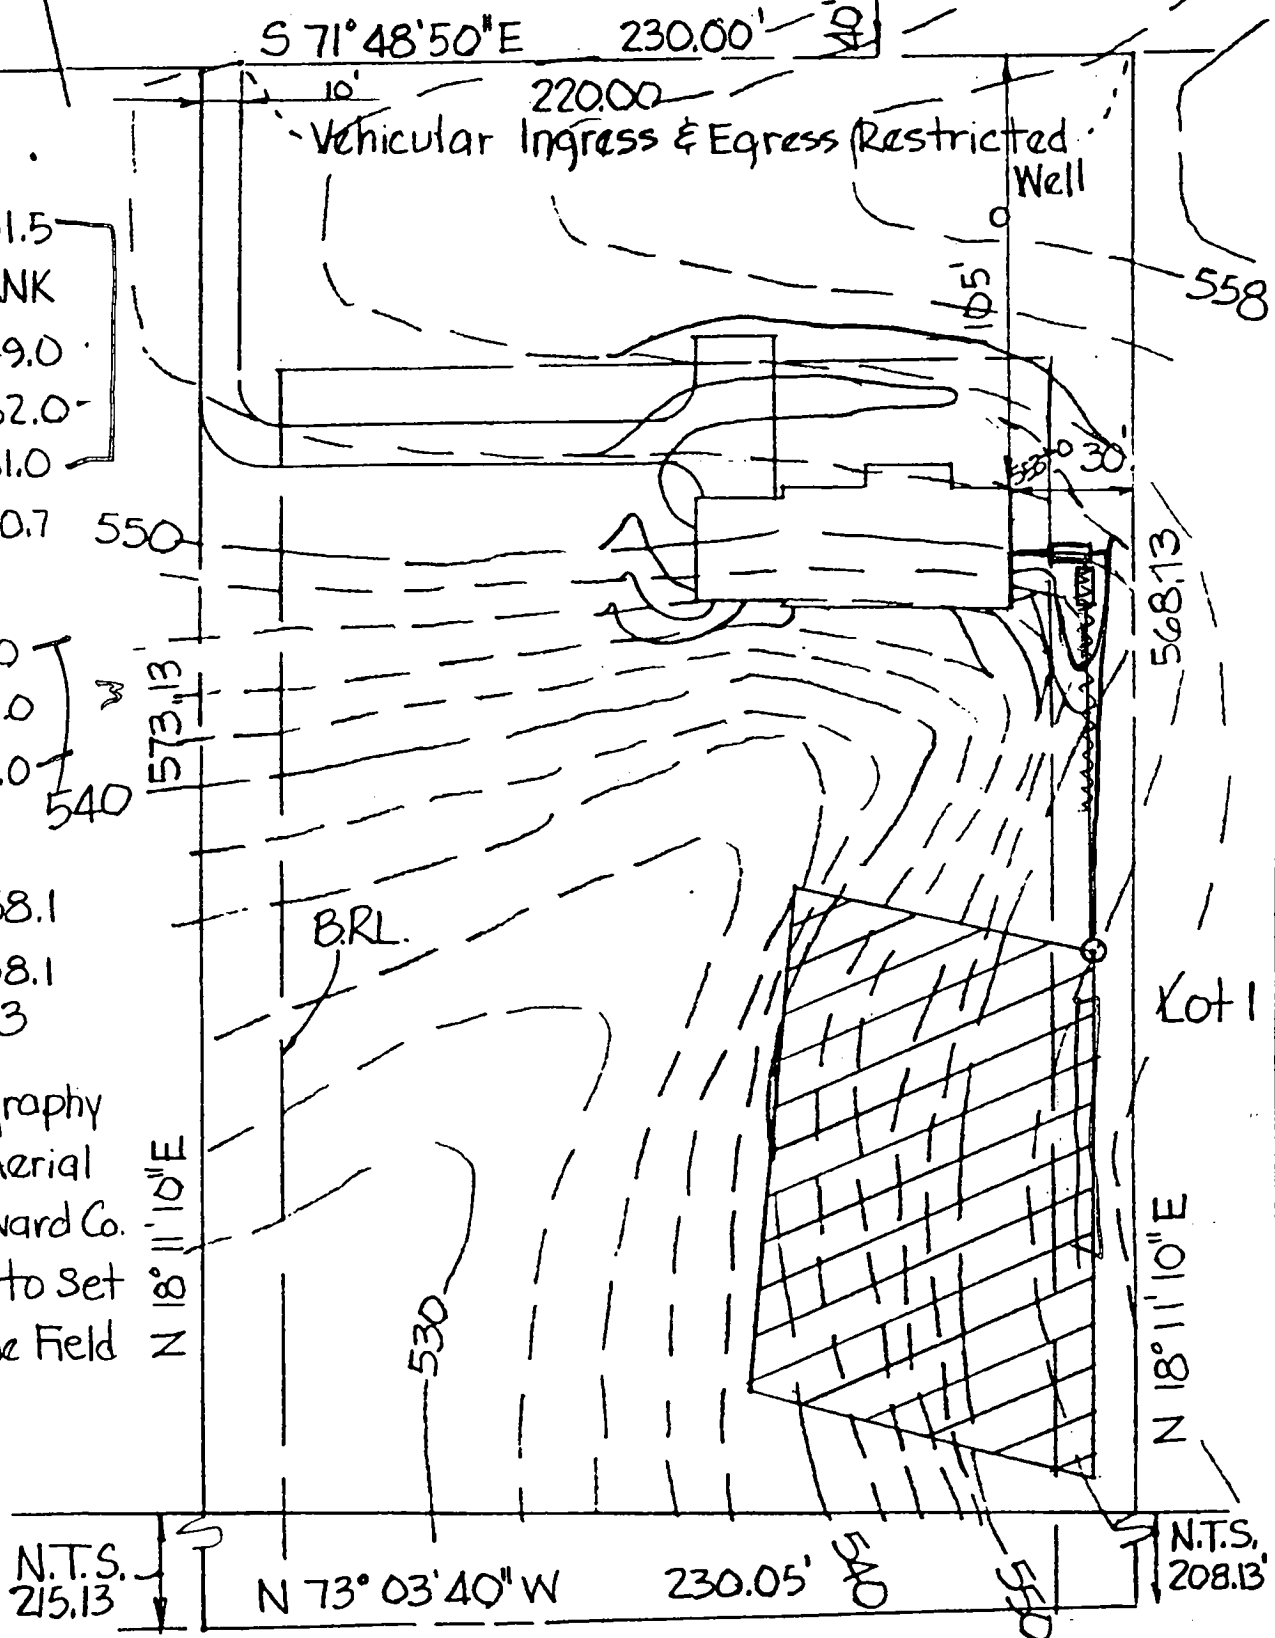

TITLE

GRADING STUDY

PROJECT

RIDGLEY ACRES SECTION ONE LOT 2

LOCATION

3rd Election District, Howard County, Md.

DATE:

8-10-77

DESIGN BY:

RM

DRAWN BY:

RM

CHECKED BY:

DR

SCALE:

1" = 50'

JOB NO.:

DRAWING NO.:

1

boender associates

engineers
surveyors
planners

B 1 0377		STATE OF MARYLAND WATER RESOURCES ADMINISTRATION TAWES STATE OFFICE BLDG., ANNAPOLIS, MARYLAND 21401 APPLICATION FOR PERMIT TO DRILL WELL			WRA PERMIT NUMBER 140-73-2170 FILL IN THIS FORM COMPLETELY										
1 2 3 (SEQ. NO.) 6 (THIS NUMBER IS TO BE PUNCHED IN COLUMNS 3-6 ON ALL CARDS)		DATE RECEIVED (WRA USE ONLY) OWNER <u>Robert Elliott</u> COL 15 LAST NAME <u>3620 Laurel Dr.</u> FIRST NAME <u>Elliott</u> COL. 34 STREET OR RFD <u>Ellicott City, Md.</u> COL. 55 POST OFFICE <u>Ellicott City, Md.</u> COL. 76													
B 1 CONTINUED		DRILLER INFORMATION 1 2 3 (SEQ. NO.) 6 DATE <u>6/17/77</u> LICENSE NUMBER <u>42</u> FIRST NAME <u>J. F. Esterday</u> DRILLER <u>J. F. Esterday</u> LAST NAME SIGNATURE <u>J. F. Esterday</u>			B 3 LOCATION OF WELL 1 2 3 (SEQ. NO.) 6 COUNTY <u>Howard</u> (DO NOT ABBREVIATE COUNTY NAME) 21 SUBDIVISION <u>Residential Property</u> 42 SECTION <u>44</u> LOT <u>2</u> 50 NEAREST TOWN <u>West Friendship</u> 71 MILES FROM TOWN (ENTER 0 IF IN TOWN) <u>0</u> 76 77 78										
B 2		WELL INFORMATION 1 2 3 (SEQ. NO.) 6 MAXIMUM PUMPING RATE (GALLONS PER MINUTE) <u>5</u> 8 12 AVERAGE DAILY QUANTITY NEEDED (GALLONS PER DAY) <u>600</u> 14 20 USE FOR WATER (CIRCLE APPROPRIATE BOX) ☒ D HOME (SINGLE OR DOUBLE HOUSEHOLD UNIT ONLY) ☐ F FARMING, AGRICULTURE, IRRIGATION ☐ I INDUSTRIAL, COMMERCIAL, STATE AND FEDERAL GOVERNMENT. ☐ M MUNICIPAL WATER SUPPLY ☐ P PRIVATE WATER COMPANY } MUST HAVE STATE HEALTH DEPT. APPROVAL ☐ T TEST			B 4 DIRECTION FROM TOWN 1 2 3 (SEQ. NO.) 6 <table border="1" style="width:100%; border-collapse: collapse;"><tr><td>☒ S SOUTH</td><td>☐ E EAST</td><td>☐ NE NORTHEAST</td><td>☐ SE SOUTHEAST</td></tr><tr><td>☐ N NORTH</td><td>☐ W WEST</td><td>☐ NW NORTHWEST</td><td>☐ SW SOUTHWEST</td></tr></table> NEAR WHAT ROAD <u>pt 144</u> ON WHICH SIDE OF ROAD (CIRCLE APPROPRIATE BOX) ☒ S ☐ N ☐ E ☐ W DISTANCE FROM ROAD (ENTER DISTANCE AND CIRCLE APPROPRIATE BOX) <u>34</u> 36 39			☒ S SOUTH	☐ E EAST	☐ NE NORTHEAST	☐ SE SOUTHEAST	☐ N NORTH	☐ W WEST	☐ NW NORTHWEST	☐ SW SOUTHWEST
☒ S SOUTH	☐ E EAST	☐ NE NORTHEAST	☐ SE SOUTHEAST												
☐ N NORTH	☐ W WEST	☐ NW NORTHWEST	☐ SW SOUTHWEST												
APPROXIMATE DEPTH OF WELL <u>150</u> 24 26 FEET APPROXIMATE DIAMETER OF WELL <u>6</u> (NEAREST INCH) METHOD OF DRILLING USED (CIRCLE APPROPRIATE METHOD) ☒ B ORED (OR AUGERED) ☐ J ETTED ☐ D IVEN ☒ AIR-ROTARY ☐ AIR-PERCUSSION ☐ ROTARY (HYDRAULIC ROTARY) ☐ CABLE ☐ REVERSE-ROTARY ☐ DRIVE-POINT OTHER (DESCRIBE)		N ↑ 73' casing 46' open hole (see back) inst 12 bags cement 8/8/77 pt 144 T.S.O. fund pt. 32													
REPLACEMENT OR DEEPEINED WELLS (CIRCLE APPROPRIATE BOX) ☐ N THIS WELL WILL NOT REPLACE AN EXISTING WELL ☐ Y THIS WELL WILL REPLACE A WELL THAT WILL BE ABANDONED AND SEALED ☐ S THIS WELL WILL REPLACE A WELL THAT WILL BE USED AS A STANDBY ☐ D THIS WELL WILL DEEPEIN AN EXISTING WELL PERMIT NUMBER OF WELL TO BE REPLACED OR DEEPEINED (IF AVAILABLE)															
NOT TO BE FILLED IN BY DRILLER (WRA USE ONLY) APPROPRIATION PERMIT NUMBER <u>54</u> ENGINEER REVIEW DISTRICT NO. <u>63</u> FORCE <u>67</u> WRITE INITIALS IN BOX <u>68</u> CONDITIONS <u>70</u> <u>71</u> <u>72</u> <u>73</u> <u>74</u> <u>75</u> <u>76</u> <u>77</u> <u>78</u> <u>79</u>		BOX NUMBER <table border="1" style="width:100%; border-collapse: collapse;"><tr><td>E</td><td>D</td><td>P</td><td>I</td><td>O</td></tr><tr><td>N</td><td>O</td><td>S</td><td>S</td><td>O</td></tr></table>			E	D	P	I	O	N	O	S	S	O	
E	D	P	I	O											
N	O	S	S	O											
B 4 CONTINUED		HEALTH-DEPARTMENT APPROVAL 1 2 3 (SEQ. NO.) 6 STATE HEALTH (CIRCLE BOX) <u>3</u> COUNTY NAME <u>Howard</u> COUNTY NO. <u>W26148</u> DATE <u>6 2 1 7 7</u> APPROVED BY <u>Donald W. Montagna, Sanitarian</u>			COORDINATES NORTH COORDINATE <u>50</u> <u>51</u> <u>52</u> <u>53</u> <u>54</u> <u>55</u> EAST COORDINATE <u>57</u> <u>58</u> <u>59</u> <u>60</u> <u>61</u> <u>62</u> <u>63</u> ELEVATION AT WELL HEAD (FEET) <u>65</u> <u>66</u> <u>67</u> <u>68</u> <u>69</u> <u>70</u>										
B 5		SPECIAL CONDITIONS 8-63 (WRA USE ONLY) 1 2 3 (SEQ. NO.) 6			HEALTH										

Measured 38' open hole, attempted to jet out, solid at 46'

RECEIVED
HOWARD COUNTY
HEALTH DEPT.
JUN 30 1 06 PM '77
DIVISION OF
ENVIRONMENTAL
HEALTH

1 2 3 (SEQ. NO.) 6
 (THIS NUMBER IS TO BE PUNCHED IN COLS. 13-6 ON ALL CARDS)

SEQUENCE NO. (WRA USE ONLY)
 0537

STATE OF MARYLAND
 WATER RESOURCES ADMINISTRATION
 TAWES STATE OFFICE BLDG., ANNAPOLIS, MD. 21401
 WELL COMPLETION REPORT

THIS REPORT MUST BE SUBMITTED WITHIN 30 DAYS AFTER WELL COMPLETION

FILL IN THIS FORM COMPLETELY

COUNTY NUMBER

DATE RECEIVED (WRA USE ONLY)

DATE WELL COMPLETED

DEPTH OF WELL

22 (TO NEAREST FOOT) 26

PERMIT NO. FROM "PERMIT TO DRILL WELL"

MC-13-2110

28 29 30 31 32 33 34 35 36 37

DRILLERS IDENTIFICATION NO.

42

OWNER SCHMELZ, HERRERT
 LAST NAME
 STREET OR RFD 3625 SCHMELZ DR.

FIRST NAME
 POST OFFICE ELLETT CITY, MD.

WELL LOG

WELL DESCRIPTION

STATE THE KIND OF FORMATIONS PENETRATED, THEIR COLOR, DEPTH, THICKNESS AND IF WATER BEARING

DESCRIPTION (USE ADDITIONAL SHEETS IF NECESSARY)	FEET		CHECK IF WATER BEARING
	FROM	TO	
TOP SOIL	0	2	
SHALE	2	10	
SANDSTONE	10	73	
MICA	73	90	
FLINT	90	110	
MICA	110	220	

GROUTING RECORD

WELL HAS BEEN GROUTED (CIRCLE APPROPRIATE BOX)

YES

NO

TYPE OF GROUTING MATERIAL (CIRCLE BOX)

CEMENT

BENTONITE CLAY

NO. OF BAGS 12 NO. OF POUNDS 1200

GALLONS OF WATER 60

DEPTH OF GROUT SEAL (TO NEAREST FOOT)

FROM 0 FT. TO 46 FT.
 (ENTER 0 IF FROM SURFACE)

CASING RECORD

CASING TYPES
 (INSERT APPROPRIATE CODE BELOW)

STEEL

CONCRETE

PLASTIC

OTHER

MAIN CASING TYPE

NOMINAL DIAMETER TOP (MAIN) CASING (NEAREST INCH)

TOTAL DEPTH OF MAIN CASING (NEAREST FOOT)

ST 6 73
 60 61 63 64 66 70

OTHER CASING (IF USED)

DIAMETER (INCH)

DEPTH (FEET) FROM TO

SCREEN RECORD

SCREEN TYPE OR OPEN HOLE

(INSERT APPROPRIATE CODE BELOW)

STEEL

BRASS OR BRONZE

OPEN HOLE

PLASTIC

OTHER

C 2

1 2 3 (SEQ. NO.) 6

DEPTH (NEAREST WHOLE FOOT)

HO 71 220
 8 9 11 15 17 21
 23 24 26 30 32 36
 38 39 41 45 47 51
 SLOT SIZE 1. 2. 3.

DIAMETER OF SCREEN 56 60 (NEAREST INCH)

GRAVEL PACK

IF WELL DRILLED WAS A FLOWING WELL (CIRCLE BOX) 68 F

WRA USE ONLY (NOT TO BE FILLED IN BY DRILLER)

TELESCOPE CASING 70 LOG INDICATOR 72 OTHER DATA AVAILABLE 74 75 76

PUMPING TEST

HOURS PUMPED (TO NEAREST HOUR) 2

PUMPING RATE (GALLONS PER MINUTE TO NEAREST GALLON) 4

METHOD USED TO MEASURE PUMPING RATE BUCKET

WATER LEVEL: (DISTANCE FROM LAND SURFACE)

BEFORE PUMPING 50 (NEAREST FOOT)

WHEN PUMPING 220 (NEAREST FOOT)

TYPE OF PUMP USED (CIRCLE APPROPRIATE BOX) (FOR PUMPING TEST)

AIR

PISTON

TURBINE

CENTRIFUGAL

ROTARY

OTHER (DESCRIBE BELOW)

JET

SUBMERSIBLE

PUMP INSTALLED

TYPE OF PUMP (WRITE APPROPRIATE LETTER IN BOX - SEE ABOVE: A, C, J, P, R, S, T, O)

DRILLER WILL INSTALL PUMP (CIRCLE APPROPRIATE BOX)

CAPACITY:

GALLONS PER MINUTE (TO NEAREST GALLON) 31 35

PUMP HORSE POWER 37 41

PUMP COLUMN LENGTH (NEAREST FOOT) 43 47

CASING HEIGHT (CIRCLE APPROPRIATE BOX AND ENTER CASING HEIGHT)

ABOVE

BELOW

LAND SURFACE 2 (NEAREST FOOT)

LOCATION OF WELL ON LOT

SHOW PERMANENT STRUCTURE SUCH AS BUILDINGS, SEPTIC TANKS, AND/OR OTHER LAND MARKS AND INDICATE NOT LESS THAN TWO DISTANCES (MEASUREMENTS TO WELL)

CIRCLE APPROPRIATE BOXES

- A A WELL WAS ABANDONED AND SEALED WHEN THIS WELL WAS COMPLETED
 E ELECTRIC LOG OBTAINED
 P TEST WELL CONVERTED TO PRODUCTION WELL

I HEREBY CERTIFY THAT I HAVE COMPLIED WITH ALL CONDITIONS STATED ON THE ABOVE-CAPTIONED "PERMIT TO DRILL WELL", AND THAT INFORMATION CONTAINED IN THIS REPORT IS TRUE, ACCURATE, AND COMPLETE TO THE BEST OF MY KNOWLEDGE, INFORMATION AND BELIEF.

DRILLERS NAME
 (PLEASE PRINT) L. F. EASTERDAY
 SIGNATURE L. F. Easterday

March 14, 1979

Mrs. Albert Scheel
3620 Scheel Drive
Ellicott City, Md. 21043

Dear Mrs. Scheel:

I am writing to remind you of my previous letter written on January 11, 1979. You have not contacted this office about that letter. Furthermore, the septic system on both lot 2, Sec. 1 of Friendship Manor and Lot 37, Sec. 2 of Friendship Manor have not yet been uncovered for inspection.

Please call this office to discuss this situation.

Very truly yours,

Raymond Hodges,
Sanitarian

RH:ds

January 11, 1979

Mrs. Albert Scheel
3620 Scheel Drive
Ellicott City, Maryland 21043

Dear Mrs. Scheel:

I was sorry to hear that your husband died last year.

I am writing to inquire about two properties which he owned. They are Friendship Manor, Lot 2, Section 1 on Route 1#4 and Friendship Manor, Lot 37, Section 2 on Wellworth Way. I inspected both of these properties on January 3, 1979 and found that the septic systems had been covered before being completely inspected.

Please call this office to discuss this situation. If you do not own these properties, call and let us know who owns them. If you do own these properties, you must uncover parts of the septic systems for inspection. I was unable to contact you by phone.

Very truly yours,

Raymond Hodges,
Sanitarian

RH:hs

3/1/79 - HOUSE VACANT SYSTEM STILL COVERED RH