

6/17/75
after 1 PM

PERMIT

SEWAGE DISPOSAL SYSTEM

1-2117

A 1796

MARYLAND STATE DEPARTMENT OF HEALTH

HOWARD COUNTY

ELLCOTT CITY

DISTRICT 5th

INDEXED

REINDEXED

DATE 3/5/75

Jack Pyock

IS PERMITTED TO INSTALL ☒ ALTER

ADDRESS Ten Oaks Road, Glenelg, Md.

PHONE 286-2939

A SEWAGE DISPOSAL SYSTEM LOCATED AT

SUBDIVISION Williams Contrivance Estates

ROAD 8239 Reservoir Road

LOT 8

PROPERTY OWNER Gregory R. Spierlar

Judy & Mike Sharbaugh

ADDRESS Whiteacre Road, Columbia, Md.

Phone: 730-3816

SPECIFICATIONS 3 bedrooms

DRAIN FIELD DEPTH FEET. BOTTOM AREA SQ. FT.

SEEPAGE PITS ABSORBENT SIDE WALL AREA SQ. FT.

SEPTIC TANK CAPACITY 1000 GALLONS

FOR GARBAGE GRINDER, INCREASE DISPOSAL AREA 22% & TANK CAPACITY 30%.

OTHER DRY WELL - 360 sq. ft. of absorbent sidewall area to begin no deeper than 3 ft. below original grade. Maximum depth permitted for dry well is 11 ft. Locate dry well 135 ft. from rear property line and 90 ft. from left side line as seen from road. & change to trench 25' long - 11" deep - 7 1/2" p. Stone & call for union under trench in dry well.

NOTE: ALL PIPE FROM HOUSE TO DISPOSAL AREA MUST BE CAST IRON.
PERMIT VOID AFTER THREE YEARS.

NOTE: INSTALL STAND PIPE ON SEPTIC TANK AND DRY WELL. STAND PIPES MUST BE 6 INCHES IN DIAMETER. CAST IRON, CONCRETE OR TERPA COTTA ACCEPTED.

PLANS APPROVED BY Robert V. Torre

DATE 12/5/73

FILL SEPTIC TANK AND DISTRIBUTION BOX WITH WATER BEFORE CALLING FOR AN INSPECTION. COVER NO WORK UNTIL INSPECTED AND APPROVED.

NEITHER THE HOWARD COUNTY COMMISSIONERS NOR THE HEALTH DEPARTMENT IS RESPONSIBLE FOR THE SUCCESSFUL OPERATION OF ANY SYSTEM.

BLOG. PERMIT SIGNED


AND RETURNED 11-18-98

Serial # B0115716
dick & sunderland

INDEXED

A 1796

511076-C

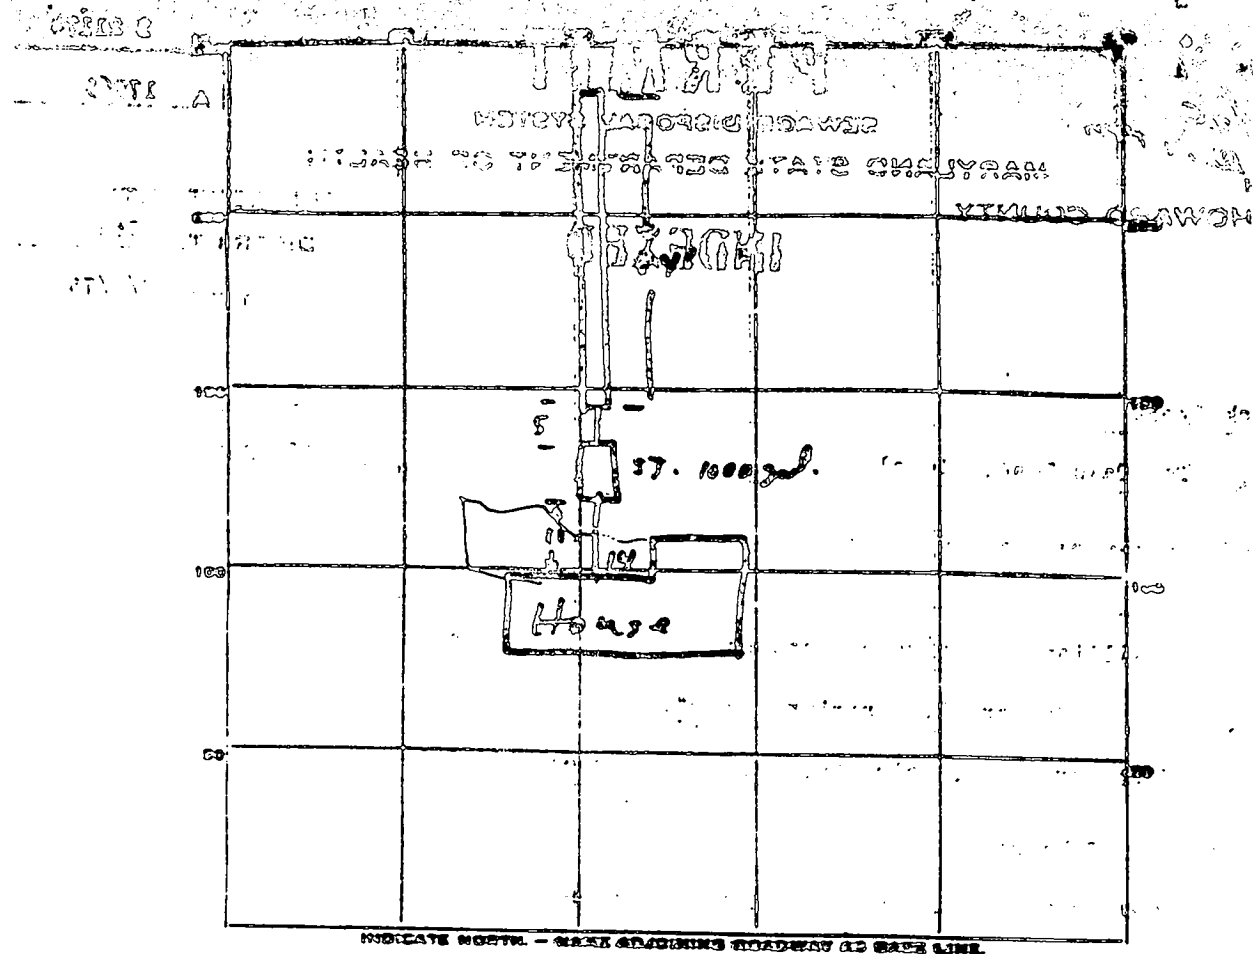

PERMIT CARD

SEPTIC TANK, LEVEL

CLEARANCE

TREY FIELD, DEPTH

11 FT. TRENCH WIDTH 2 FT.

74

GRAVEL DEPTH

7'-8"

TOTAL LENGTH

74

7.5

NUMBER OF TRENCHES

1

TOTAL SYSTEM AREA

555

350

518

ABSORBENT AREA


33 FT.

REMARKS

6-7-78

7-7-78

#8239
RESERVOIR R.

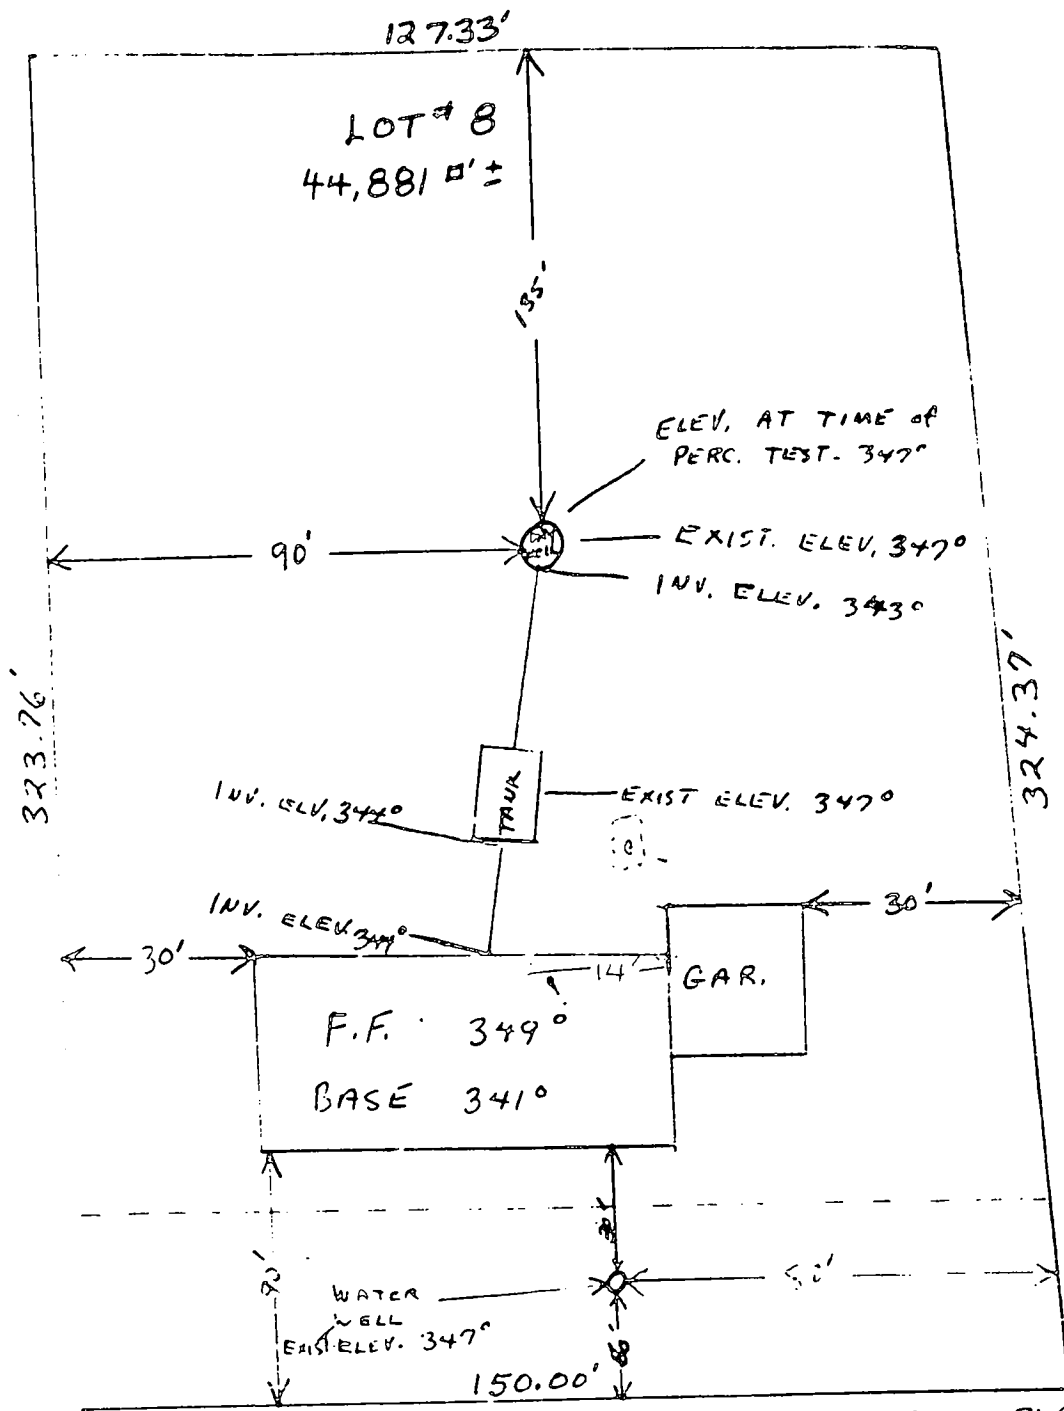

2/19/75
Plan approved
R. Torne

PLOT PLAN FOR:
GREGORY SPURRIER
LOT #8
RESERVOIR ROAD.

RESERVOIR ROAD

I CERTIFY THE ABOVE MEASUREMENTS AND ELEVATIONS

PL 1 1 1 1

HOWARD COUNTY
PERMIT APPLICATION

PERMIT NUMBER

000115116

Building Address 8239 RESERVOIR RD.

FULTON, MD 20020759

Suite/Apt. #: SDP/WP/Petition #:

Census Tract Subdivision

Section Area Lot

Tax Map Parcel Grid

Zoning Map Coordinates Lot size

Existing Use SFR/DECK

Proposed Use SFR/DECK

Estimated Construction Cost \$ 20,000-

Description of Work Repair and Rebuild

EXISTING deck and screened

in porch 18X18

Occupant or Tenant OWNER

Contact Name

Address

City State Zip Code

Phone Fax

Property Owner's Name Judy + Mike Sharbaugh

Address 8239 RESERVOIR ROAD

City FULTON State MD Zip Code 20759

Home Phone (301) 725-8518 Work Phone

Applicant's Name & Mailing Address, (if other than stated hereon):

Phone Fax

Contractor Company Fullerton Construction Services

Contact Person David Fullerton

Address 523 Wilson Place

City FREDERICK State MD Zip Code 21702

License No. MHIC67620

Phone (301) 620-9168 Fax (301) 620-9168

Engineer or Architect Company

Contact Person

Address

City State Zip Code

Phone Fax

BUILDING DESCRIPTION - COMMERCIAL

Building Characteristics

Utilities

Height: 16 ft.

No. of stories: 1

Gross area, sq. ft. per floor: 1800 ft²

Use group: R3

Construction type:

Reinforced Concrete

Structural Steel

Masonry

Wood Frame

State Certified Modular

Water Supply:

Public

Private

Sewage Disposal:

Public

Private

Electric Yes ☐ No ☐

Gas Yes ☐ No ☐

Heating System:

Electric ☐ Oil ☐

Natural Gas ☐

Propane Gas ☐

Sprinkler system: N/A

Full

Partial

Other Suppression

of Heads

BUILDING DESCRIPTION - RESIDENTIAL

Building Characteristics

Utilities

SF Dwelling ☒ SF Townhouse ☐

Depth 30 Width 60

1st floor: 30 60

2nd floor:

Basement: 30 60

Finished Basement ☒ Unfinished Basement ☐

Crawl space ☐ Slab on Grade ☒

No. of Bedrooms 4

Multi-family dwellings:

No. of efficiency units:

No. of 1 BR units:

No. of 2 BR units:

No. of 3 BR units:

Other Structure:

Dimensions:

Footings:

Roof:

State Certified Modular

Manufactured Home

Water Supply:

Public

Private

Sewage Disposal:

Public

Private

Electric Yes ☐ No ☐

Gas Yes ☐ No ☐

Heating System:

Electric ☐ Oil ☐

Natural Gas ☐

Propane Gas ☐

Sprinkler system: N/A

NFPA #13D

NFPA #13R

Other

THE UNDERSIGNED HEREBY CERTIFIES AND AGREES AS FOLLOWS: (1) THAT HE/SHE IS AUTHORIZED TO MAKE THIS APPLICATION; (2) THAT THE INFORMATION IS CORRECT; (3) THAT HE/SHE WILL COMPLY WITH ALL REGULATIONS OF HOWARD COUNTY WHICH ARE APPLICABLE THEREUNTO; (4) THAT HE/SHE WILL PERFORM NO WORK ON THE ABOVE REFERENCED PROPERTY NOT SPECIFICALLY DESCRIBED IN THIS APPLICATION; (5) THAT HE/SHE GRANTS COUNTY OFFICIALS THE RIGHT TO ENTER ONTO THIS PROPERTY FOR THE PURPOSE OF INSPECTING THE WORK PERMITTED AND POSTING NOTICES.

Applicant's Signature

Fullerton Construction Services

Title/Company

Print Name

David Fullerton

Date

11/18/98

Checks payable to: DIRECTOR OF FINANCE OF HOWARD COUNTY

PLEASE WRITE NEATLY AND LEGIBLY.

FOR OFFICE USE ONLY

AGENCY	DATE	SIGNATURE APPROVAL	DPZ SETBACK INFORMATION	PROPERTY ID#
Land Development DPZ			Front: <u> </u>	38627
State Highway			Rear: <u> </u>	Filing fee \$ <u> </u>
Planning Official			Side: <u> </u>	Permit fee \$ <u> </u>
Dev. Engineering DPZ			Side St: <u> </u>	Excise tax \$ <u> </u>
Health			All minimum setbacks met?	Sub-total paid \$ <u> </u>
Fire Protection			YES ☐ NO ☐	Add'l permit fee \$ <u> </u>
In Sediment Control approval required prior to issuance?			Is Entrance Permit required?	TOTAL FEES \$ <u> </u>
YES ☐ NO ☐			YES ☐ NO ☐	Balance due \$ <u> </u>
CONTINGENCY CONSTRUCTION START ☐			Historic District?	Check # <u> </u>
ONE STOP SHOP ☐			YES ☐ NO ☐	Validation # <u> </u>
			Lot Coverage for New/Town Zone <u> </u>	
			SDP/Red-line approval date <u> </u>	Accepted by <u> </u>

Distribution of Copies


White: Building Official

Green: LDD, DPZ

Yellow: DED, DPZ

Pink: Health

Gold: SHA

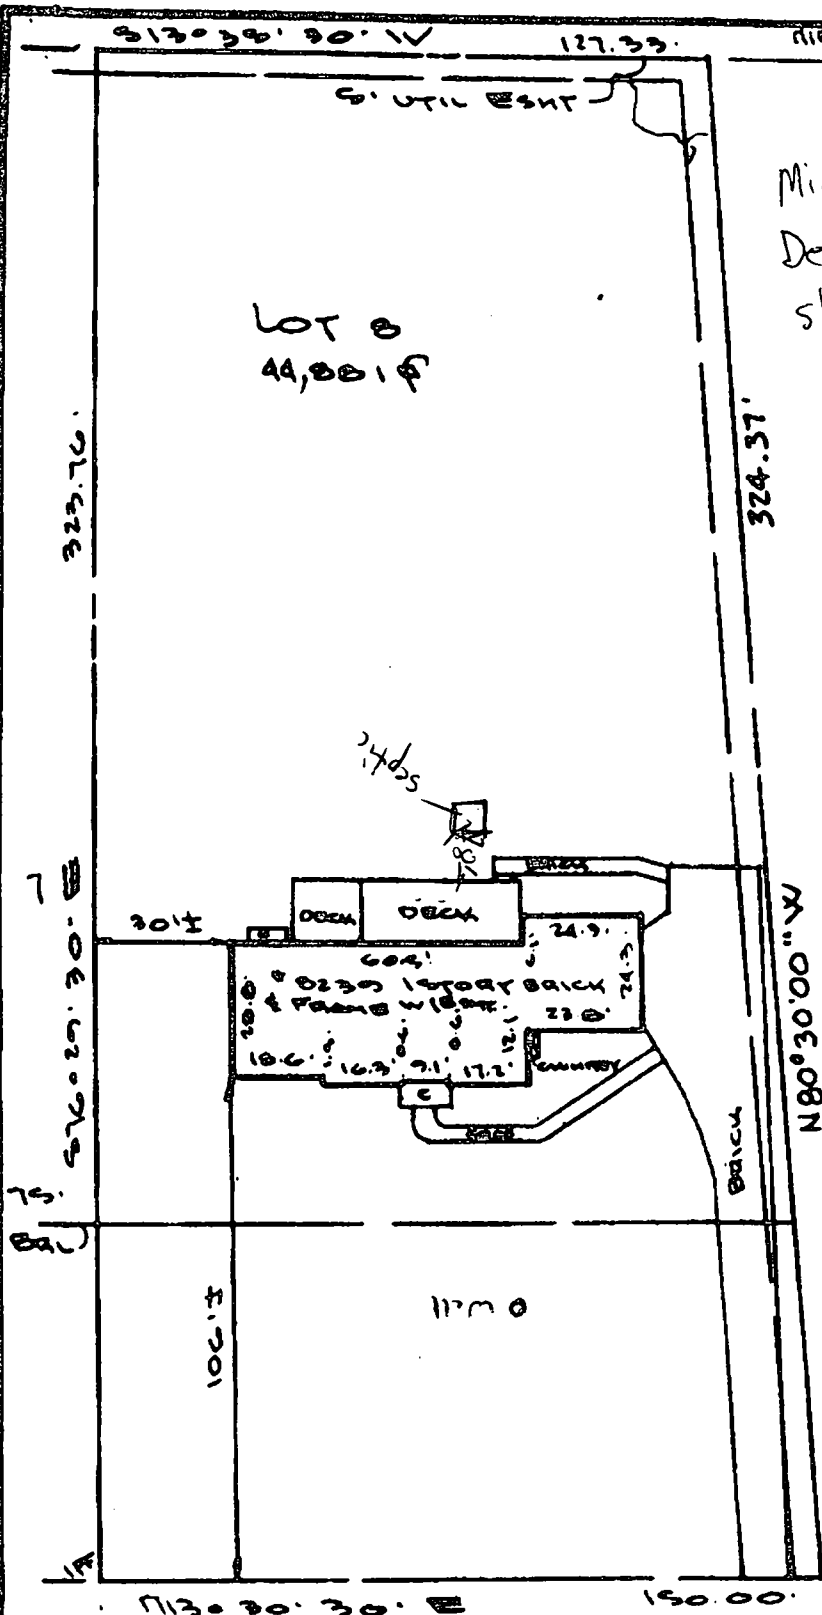

11F CB 100000 ETAL
1021220

NOTE: The lot shown hereon does not lie within the limits of the 100 year flood plain as shown on FIRM Panel No. 41

Date of Map: 12.4.86
Flood Zone: C.

Min distance from
Deck to septic tank
shall be 8'

Don J. Filler
Scale 1" = 20'

11F

D.V. PARKS & WIFE

9/2/94

Michael John Bais
Professional Land Surveyor



NOT TO
SCALE

RESERVOIR ROAD

IMPROVEMENT LOCATION SURVEY

SURVEYOR'S CERTIFICATE

LOT 8

WILLIAM'S CONTRIVANCE

ESTATES SECTION ONE

I hereby certify that the property delineated hereon is in accordance with the Plat of Subdivision and/or deed of record, that the improvements were located by accepted field practices and include permanent visible structures and encroachments, if any. This Plat is not for determining property lines or for construction of improvements, but prepared for exclusive use of present owners of property and also