

PERMIT

SEWAGE DISPOSAL SYSTEM

DEPARTMENT OF HEALTH AND MENTAL HYGIENE

HOWARD COUNTY HEALTH DEPARTMENT

BUREAU OF ENVIRONMENTAL HEALTH

410-313-2640

INDEXED

P 511094

A 50157

DISTRICT 3rd

DATE 11/9/98

DATE SYSTEM APPROVED 12/3/98

INSPECTOR *AK**Robert Bookholtz*IS PERMITTED TO INSTALL ☒ ALTER

ADDRESS 1026 Marton St Laurel, MD 20707 PHONE (301) 377-6706

SUBDIVISION Roger's Avenue Realty Prop. LOT 2 ROAD 2714 Route 32 Sykesville Rd

PROPERTY OWNER Charles & Stacy Bussing

BUILDING PERMIT SIGNED**AND RETURNED**SEPTIC TANK CAPACITY 1250 GALLONS 9-2-04 800 150 153-IL POOL
10-27-04 800 150 137-3 HED

NUMBER OF BEDROOMS 4

180 SQUARE FEET PER BEDROOM

LINEAR FEET OF TRENCH REQUIRED 180 240

TRENCHES - Trench to be 3 feet wide. Inlet 5 feet below original grade. Bottom maximum depth 4 feet below original grade. Effective area begins at 4 feet below original grade. 2 feet of stone below distribution pipe.

LOCATION - Place the distribution box 440 feet down the 568.40' (right) lot line and 125 feet off that same lot line as seen when facing the lot from the pipestem. Run trenches on contour towards the left rear corner of the lot.

NOTES - No trench to exceed 100 feet in length. Provide 6" - 8" diameter cleanout and cap to grade or above on septic tank.

OK ALM 7-6-98

11/10/98 specs changed to achieve gravity flow to highest portion of septic easement *AK*

PLANS APPROVED BY Kim Maiste/Ronald J. Pinkley

DATE 6/25/98

COVER NO WORK UNTIL INSPECTED AND APPROVED

NEITHER THE HOWARD COUNTY COUNCIL NOR THE HEALTH DEPARTMENT IS RESPONSIBLE FOR THE SUCCESSFUL OPERATION OF ANY SYSTEM

NOTE: CLEANOUT REQUIRED EVERY 70 FEET OF SEWER LINE AND/OR AT 90° SWEEPS IN LINES FROM HOUSE TO DRAIN FIELDS. 90° ELBOWS NOT ACCEPTABLE.

NOTE: ALL PARTS OF SEPTIC SYSTEMS (I.E. TANK, DISTRIBUTION BOX TRENCHES) TO BE 100 FEET FROM WELL (UNLESS OTHERWISE SPECIFICALLY AUTHORIZED)

NOTE: IF DEEP TRENCH(ES) ARE USED CALL FOR INSPECTION BEFORE AND AFTER PLACING GRAVEL IN TRENCH(ES)

NOTE: NO DRY WELL SHALL EXCEED 13 FOOT IN DIAMETER NO ABSORPTION TRENCH TO EXCEED 100 FEET IN LENGTH

NOTE: ALL PIPE FROM HOUSE TO SEPTIC TANK MUST BE CAST IRON OR SCHEDULE 35/40 PVC OR ABS

PERMIT VOID AFTER TWO YEARS

NOTE: INSTALL STAND PIPE ON SEPTIC TANK AND DRY WELL STAND PIPES MUST BE 6 INCHES IN DIAMETER CAST IRON, CONCRETE OR TERRA COTTA OR PVA OR ABS ACCEPTED. IF TOP OF SEPTIC TANK IS DEEPER THAN 3 FEET, MANHOLE TO GRADE REQUIRED.


NOTE: DISTRIBUTION BOXES MUST HAVE BAFFLES

*INSTALLER IS RESPONSIBLE FOR OBTAINING FINAL APPROVAL ON THIS PERMIT

SEWAGE PERMIT SIGNED
AND RETURNED 10/14/98

Propane tank

P511094

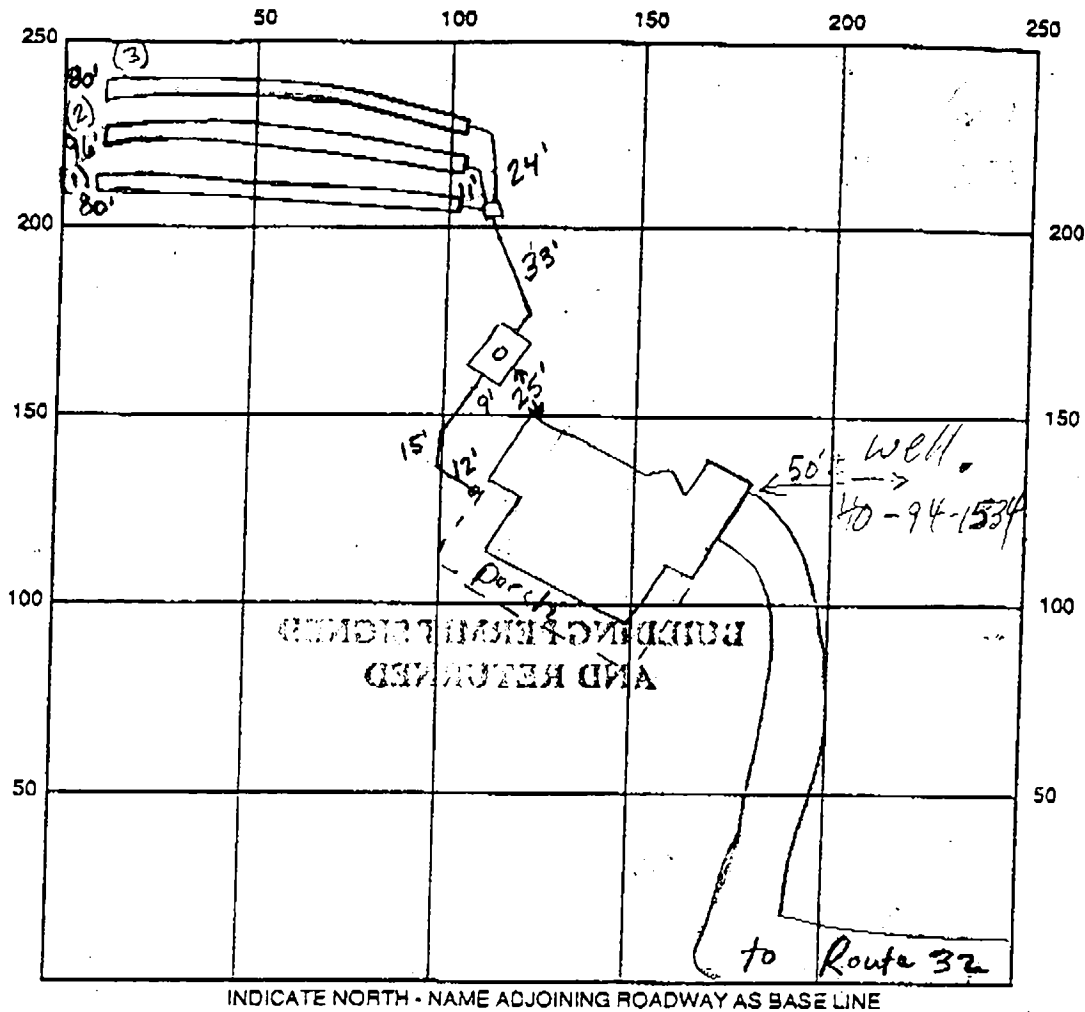SEPTIC TANK LEVEL OK, 1500 gallonsCLEANOUTS 1 on tank, 1 at houseDISTRIBUTION BOX LEVEL OKDRAIN FIELD/TITLE DEPTH

1	2	3
9	9	9

 FT.TRENCH WIDTH

1	2	3
3	3	3

 FT.INLET DEPTH

1	2	3
6	6	6

 FT.EFFECTIVE GRAVEL DEPTH


1	2	3
3	3	3

 FT.TOTAL LENGTH


1	2	3
80	96	80

 FT. → 256NUMBER OF TRENCHES 3ONE SIDEWALL/BOTTOM AREA 758 SQ. FT.DRYWALL INSIDE DIAMETER — FT.EFFECTIVE DEPTH BELOW INLET — FT.ABSORBENT AREA — SQ. FT.REMARKS: 11/30/98 inlet deeper than specified, ok due to suitable soils and to achieve gravity flow, ok to stone 1st trench and continue (KM)12-1-98 ok to stone 2nd trench and continue (KM)12-2-98(am) ok to cover 2nd trench and continue 3rd trench (KM)12-2-98(pm) ok to stone and cover 2nd and 3rd trench, leave end of 3rd trench open (KM) 12/3/98 OK to cover all workDATE SYSTEM APPROVED 12/3/98INSPECTOR A McMillan

Note: This is a building and improvement plat only and should not be used to establish property lines.

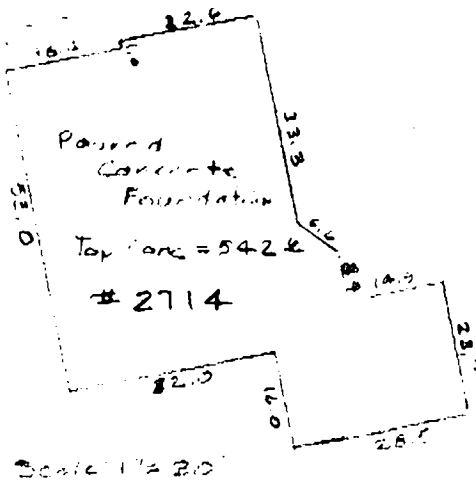

Private Use - Common
Easement to Md Hte 32
for Power 162 sq ft
1 & 2 (3697/190)

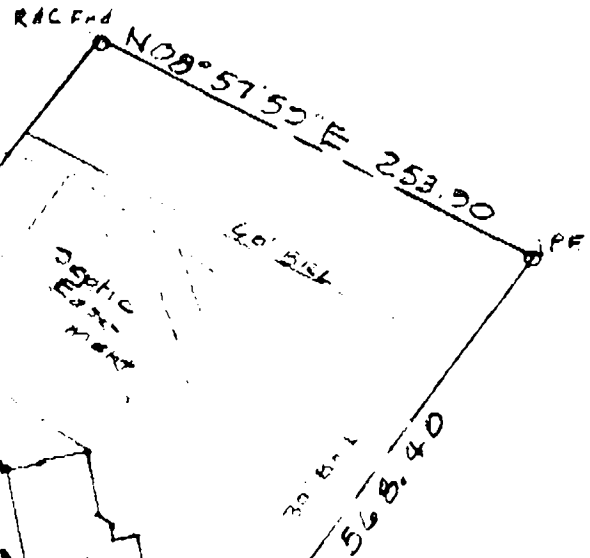

11/9/98

House moved back
377' from 229.42
lot line (closer to septic
easement). Owner stated
that house is still 20'
from septic easement.

11/10/98 Confirmed in field that
house corner is 20' from septic.

WALL CHECK

LOT 2

ROGERS AVE REALTY INC. PROPERTY
WEST FRIENDSHIP

Howard County, Md

Scale: 1" = 100'


Sept. 1998

Plat # 12174

SURVEYORS CERTIFICATE


I hereby certify that a careful transit tape survey has been made of the improvements on the property shown hereon and that they are as shown and that there are no encroachments except as shown.

[Signature]
Land Surveyor

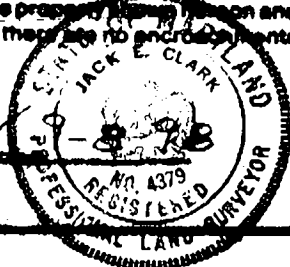

THE J. E. CLARK COMPANY
LAND SURVEYING ENGINEERING

P.O. BOX 167 • LAUREL, MARYLAND 20707

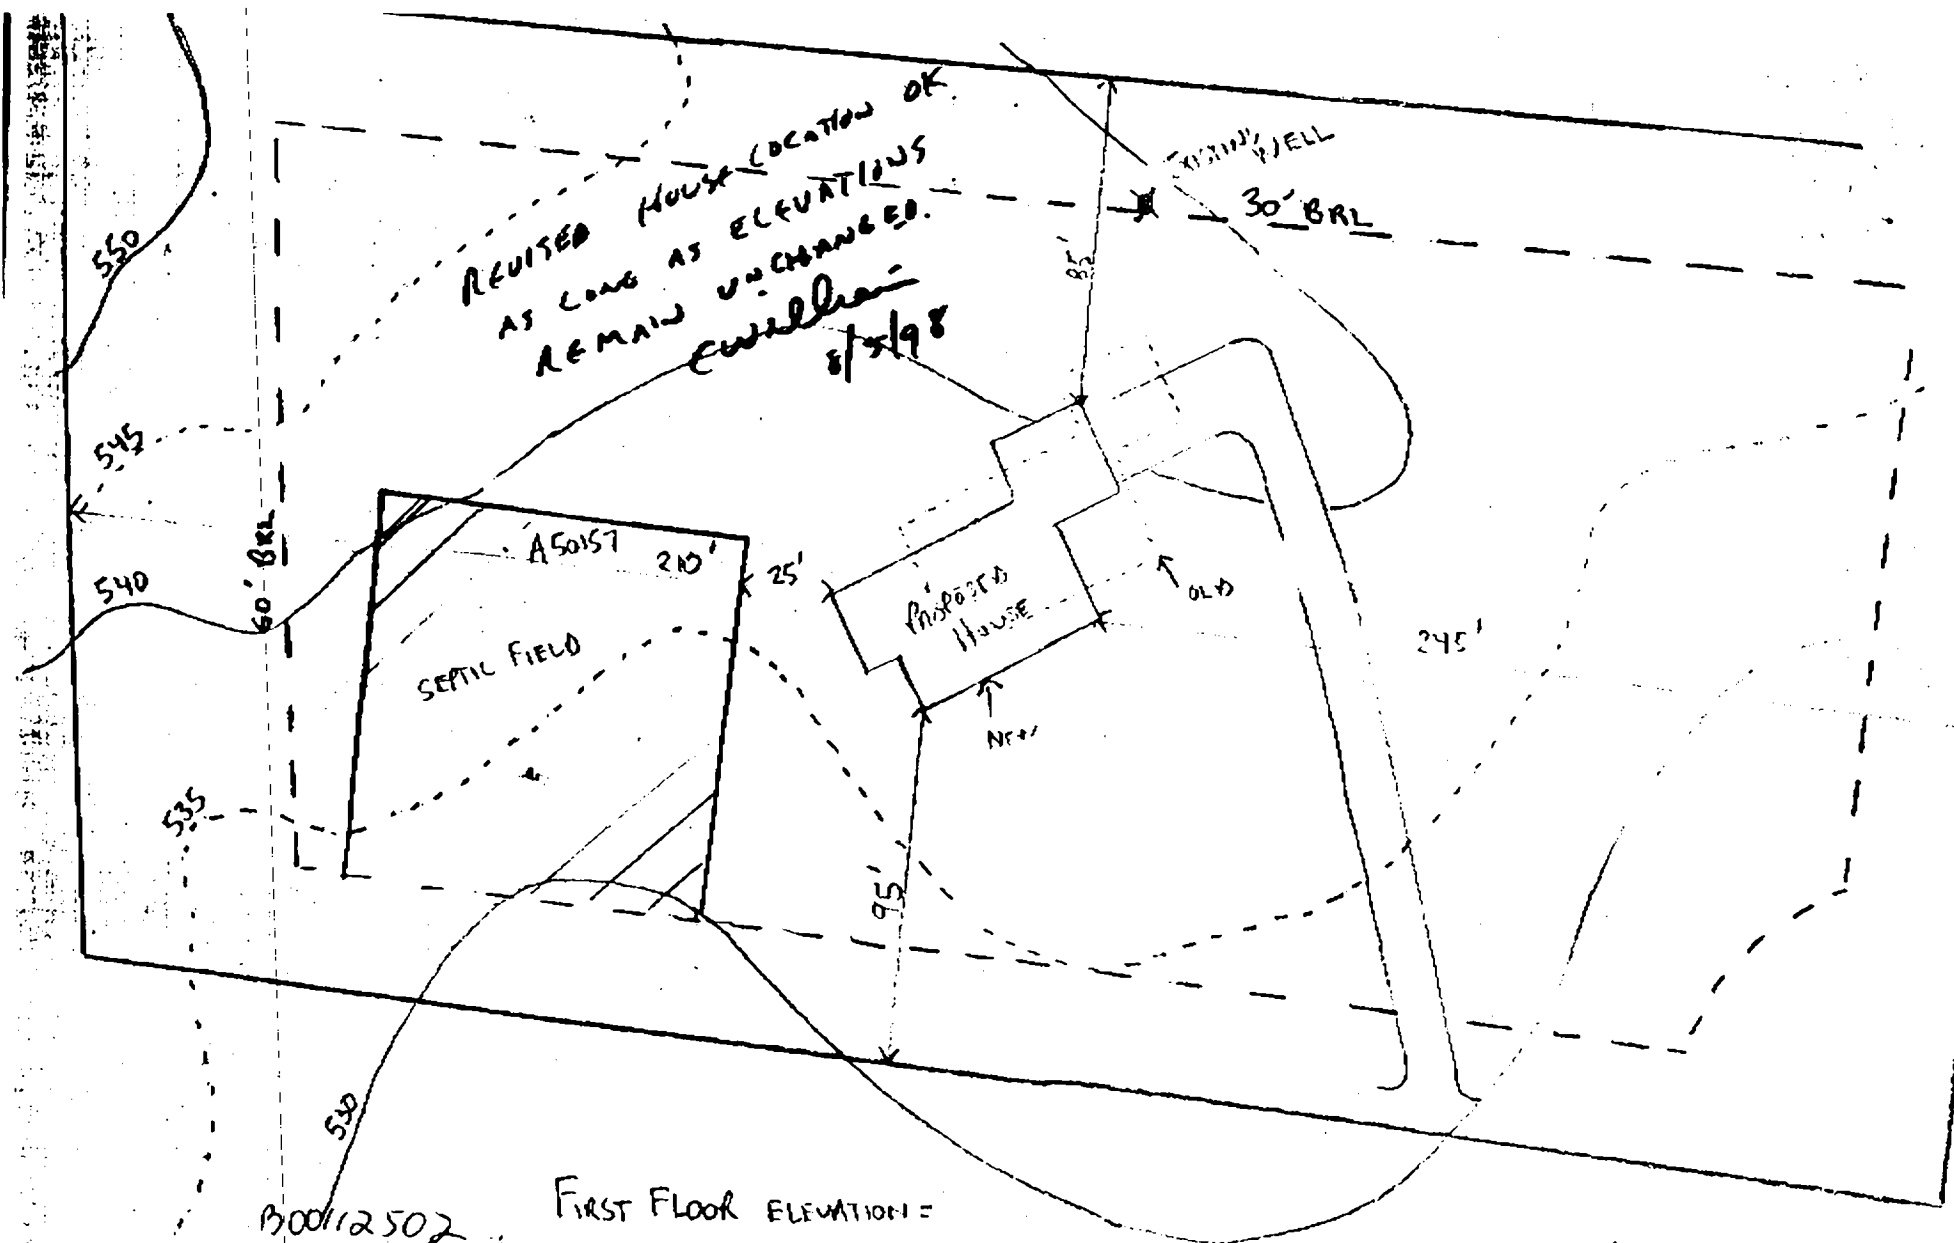

REVISED HOUSE LOCATION OK
AS LONG AS ELEVATIONS
REMAIN UNCHANGED.
C. Williams
8/5/98

100012502
REVISED
FIRST FLOOR ELEVATION =

Date: 8-5-98


Comments: relocated House

2" = 100'

SITE PLAN

NORTH

Note: This is a building improvement plat only and should not be used to establish property lines.

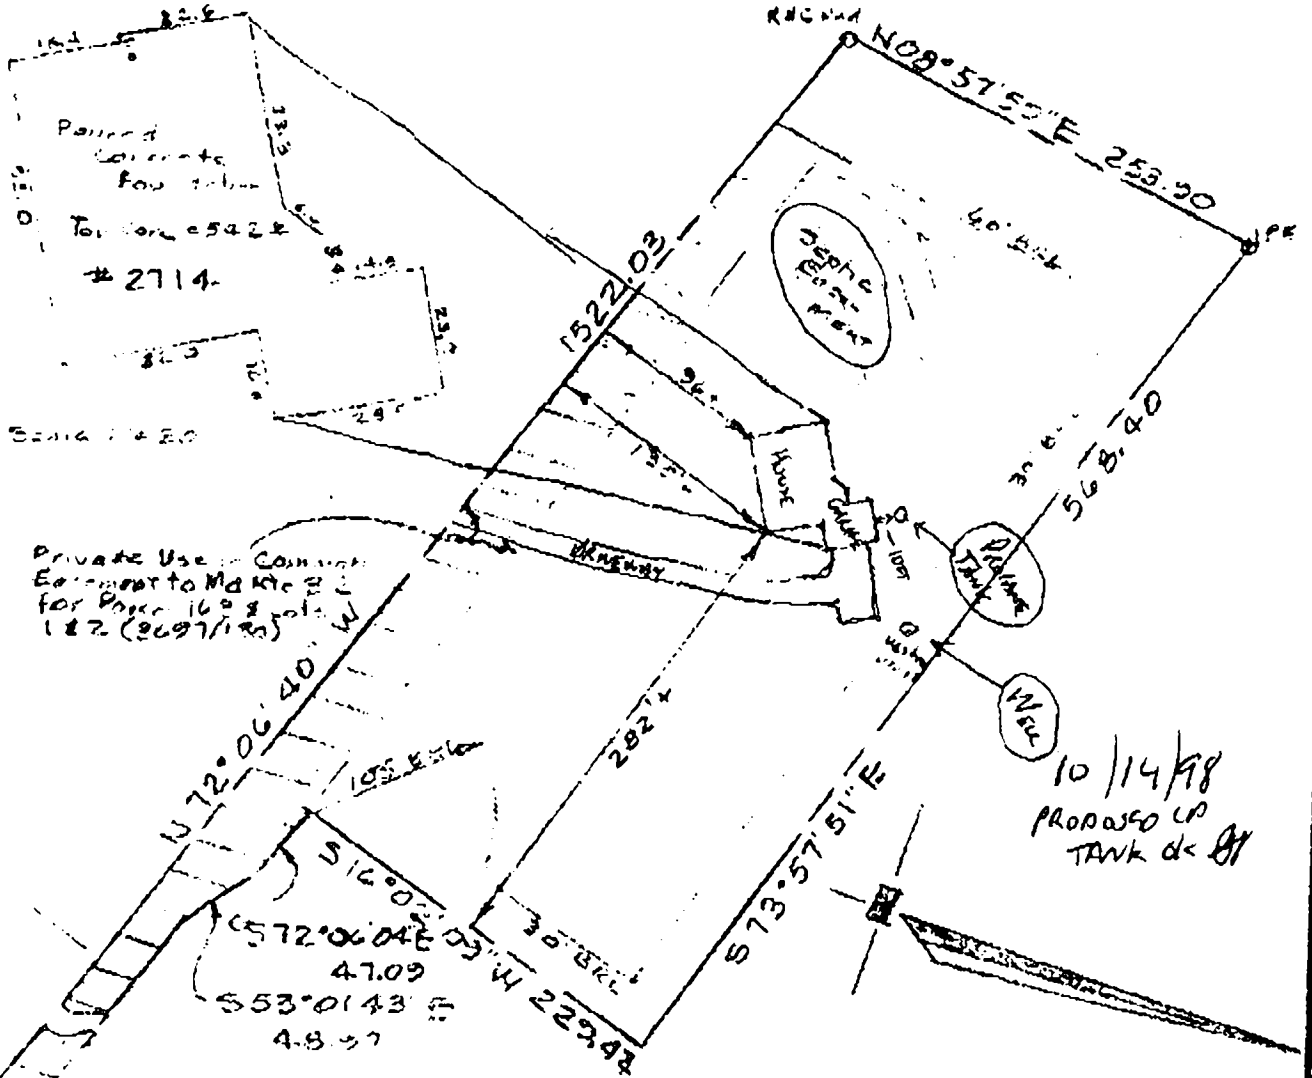

10/14/98
PROPOSED LP
TANK d= 81

WALL CHECK
LOT 2
ROGERS AVE REALTY INC. PROPERTY
WEST FRIENDSHIP
Howard County, Md
Scale: 1" = 100'
Plat # 12174

SURVEYORS CERTIFICATE


I hereby certify that a careful transit tape survey has been made of the improvements on the property shown hereon and that they are as shown and that there are no encroachments except as shown.

[Signature]
Land Surveyor




THE J. E. CLARK COMPANY
LAND SURVEYING ENGINEERING
P.O. BOX 147 • LAUREL, MARYLAND 20707

Note: This is a building and improvement plat only and should not be used to establish property lines.

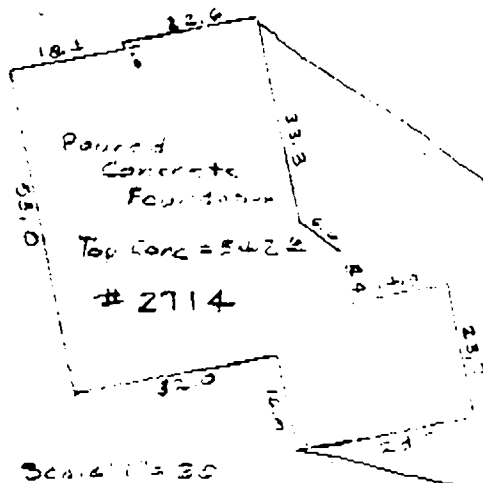

Private Use in Common
Basement to Md Hte 32
for Parcel 1633 lots W
1 & 2 (36971130)

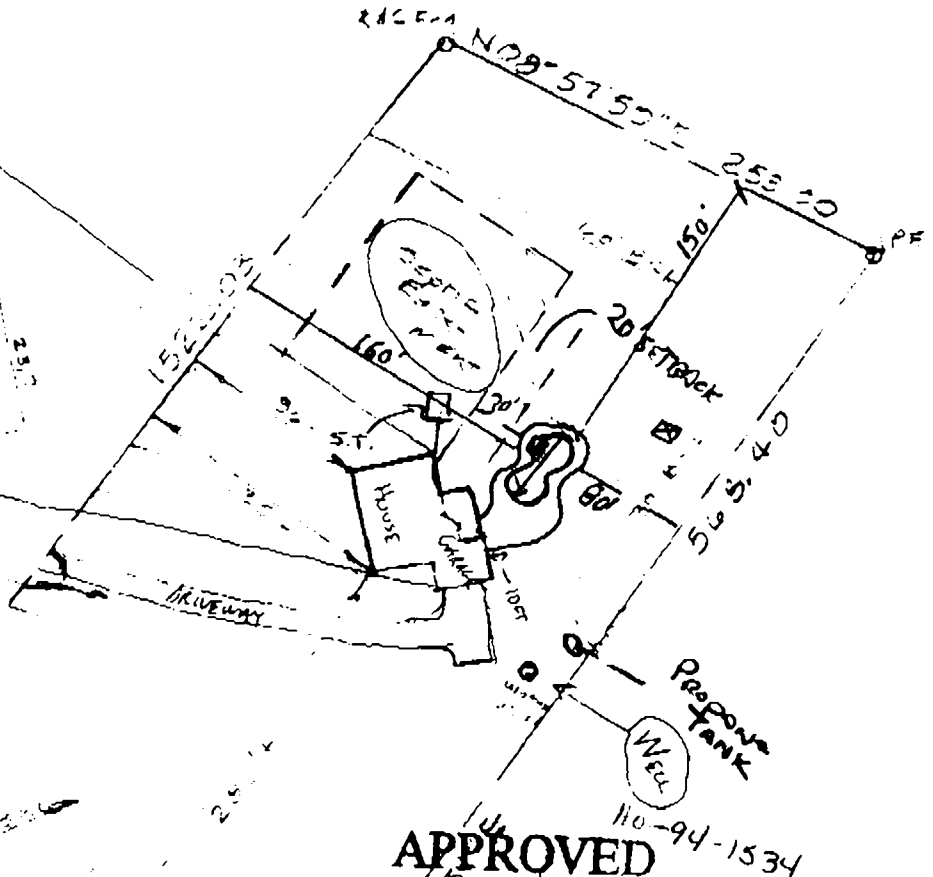

APPROVED

WALK-THRU BUILDING PERMIT

BP# 800150153 # 50157

APP. SAN KN

DATE: 9/2/04

DESC. OF WORK:

Inground pool

Need BP# Kathy

WALL CHECK Noonan

LOT 2

ROBERTS AND REALTY INC PROPERTY

WEST FRIENDSHIP

Howard County Md

Scale 1" = 100'


Sept 1998

Plot # 12,74

SURVEYORS CERTIFICATE

I hereby certify that a careful transit tape survey has been made of the improvements on the property as shown and that they are as shown and that there are no encroachments except as shown.

[Signature]
Land Surveyor

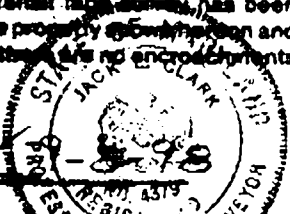

THE J. E. CLARK COMPANY

LAND SURVEYING ENGINEERING

P.O. BOX 147 • LAUREL, MARYLAND 20707

