

Ch out 9/31/65

approved 3/31/65

# PERMIT

SEWAGE DISPOSAL SYSTEM

MARYLAND STATE DEPARTMENT OF HEALTH

HOWARD COUNTY

ELLICOTT CITY

DISTRICT 4

DATE 6/22/64

RE-INDEXED  
RPS# 329015

P ~~08654~~  
P 511415-B

Herman Sirk

IS PERMITTED TO INSTALL X ALTER

ADDRESS Annapolis Rock Rd., Woodbine, Maryland

PHONE

A SEWAGE DISPOSAL SYSTEM LOCATED AT

SUBDIVISION

16944  
ROAD Rt. 144 across from LOT  
St. Michael's Church Rd.

PROPERTY OWNER Leroy Stull

ADDRESS

## SPECIFICATIONS

DRAIN FIELD DEPTH FEET, BOTTOM AREA SQ. FT.

SEEPAGE PITS ABSORBENT SIDE-WALL AREA SQ. FT.

SEPTIC TANK CAPACITY GALLONS

FOR GARBAGE GRINDER, INCREASE DISPOSAL AREA 22% & TANK CAPACITY 50%.

OTHER Repair - 9 x 12 dry well


PLANS APPROVED BY

DATE

FILL SEPTIC TANK AND DISTRIBUTION BOX WITH WATER BEFORE CALLING FOR AN INSPECTION. COVER NO WORK UNTIL INSPECTED AND APPROVED.

NEITHER THE HOWARD COUNTY COMMISSIONERS NOR THE HEALTH DEPARTMENT IS RESPONSIBLE FOR THE SUCCESSFUL OPERATION OF ANY SYSTEM.

P511415-B  
508654

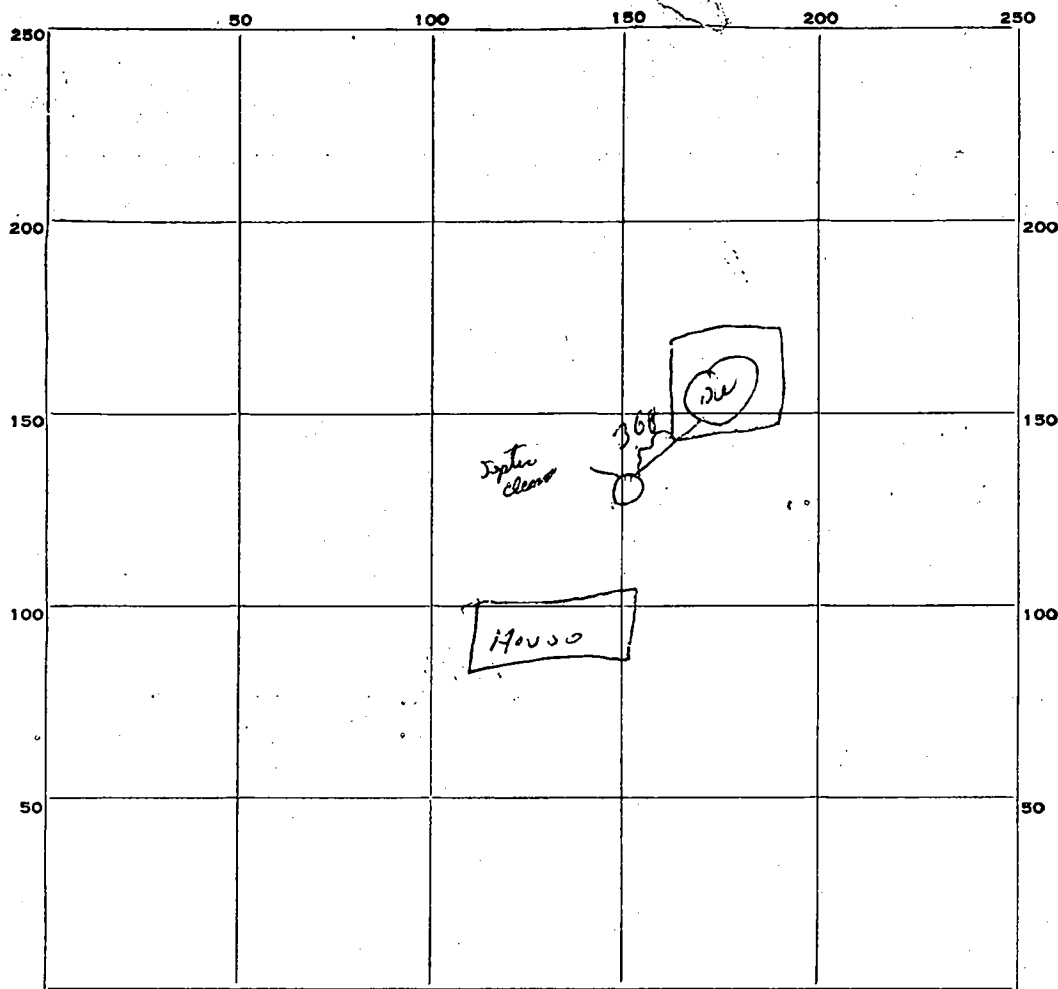

INDICATE NORTH. - NAME ADJOINING ROADWAY AS BASE LINE.

Q7 144

PERMIT CARD OK

SEPTIC TANK, LEVEL \_\_\_\_\_

CLEANOUTS OK

DISTRIBUTION BOX, LEVEL \_\_\_\_\_

TILE FIELD, DEPTH \_\_\_\_\_ FT. TRENCH WIDTH \_\_\_\_\_ FT.

GRAVEL DEPTH \_\_\_\_\_ IN. TOTAL LENGTH \_\_\_\_\_ FT.

NUMBER OF TRENCHES \_\_\_\_\_ TOTAL BOTTOM AREA \_\_\_\_\_

SEEPAGE PITS, INSIDE DIAMETER 12 FT. DEPTH BELOW INLET 10 FT.

ABSORBENT AREA 376+ SQ. FT.

REMARKS \_\_\_\_\_

DATE SYSTEM APPROVED 3/31/65

INSPECTOR [Signature]