

Chart 14173

PERMIT

SEWAGE DISPOSAL SYSTEM

DEPARTMENT OF HEALTH AND MENTAL HYGIENE

P 511570

A REPAIR

DISTRICT _____

DATE 5/10/99

DATE SYSTEM APPROVED *RP only*

INSPECTOR *5/13/99*

HOWARD COUNTY HEALTH DEPARTMENT

BUREAU OF ENVIRONMENTAL HEALTH

~~XXXXXX~~ 410-313-2640

RPS# 226448
INDEXED

Edward L. Linsenmeyer

IS PERMITTED TO INSTALL _____ ALTER ☒

ADDRESS 9304 Migan Road, Randallstown, Maryland 21133 PHONE 410-922-8172

SUBDIVISION _____ LOT _____ ROAD 3425 Rolling View Court

PROPERTY OWNER Longerbeam

ADDRESS 3425 Rolling View Court
Ellicott City, Maryland

SEPTIC TANK CAPACITY *5yr old concrete 1000 gal* GALLONS

NUMBER OF BEDROOMS *2 Bedroom*

EXCEPTION TO REPAIR IN
METROPOLITAN SERVICE DISTRICT *CW*

125 SQUARE FEET PER BEDROOM

LINEAR FEET OF TRENCH REQUIRED *40*

REPAIR - "INTERIM" REPLACEMENT FOR FAILING SYSTEM.

Call for inspection when ground is opened so sanitarian can recommend repair. 05/03/1999

Public Sewer Connection Available but expensive for indigent owner on fixed income. Controlled Blotting Three Rock necessary for Public Sewer connection. Limited

Ins fall one 40 ft long Trench, 3 ft wide, 3' deep (handlope side), 1 ft gravel under pipe, 2" gravel cover, then 1 1/2 ft earth cover. Stay 5 ft off hard bottom @ South end of Test Hole A. RPP 5/10/99

PLANS APPROVED BY *RPP* DATE 5/10/99

COVER NO WORK UNTIL INSPECTED AND APPROVED

NEITHER THE HOWARD COUNTY COUNCIL NOR THE HEALTH DEPARTMENT IS RESPONSIBLE FOR THE SUCCESSFUL OPERATION OF ANY SYSTEM

NOTE: CLEANOUT REQUIRED EVERY 70 FEET OF SEWER LINE AND/OR AT 90° SWEEPS IN LINES FROM HOUSE TO DRAIN FIELDS, 90° ELBOWS NOT ACCEPTABLE.

NOTE: ALL PARTS OF SEPTIC SYSTEMS (I.E. TANK, DISTRIBUTION BOX TRENCHES) TO BE 100 FEET FROM WELL (UNLESS OTHERWISE SPECIFICALLY AUTHORIZED)

NOTE: IF DEEP TRENCH(ES) ARE USED CALL FOR INSPECTION BEFORE AND AFTER PLACING GRAVEL IN TRENCH(ES)

NOTE: NO DRY WELL SHALL EXCEED 15 FOOT IN DIAMETER NO ABSORPTION TRENCH TO EXCEED 100 FEET IN LENGTH

NOTE: ALL PIPE FROM HOUSE TO SEPTIC TANK MUST BE CAST IRON OR SCHEDULE 25/40 PVC OR ABS

PERMIT VOID AFTER TWO YEARS

NOTE: INSTALL STAND PIPE ON SEPTIC TANK AND DRY WELL STAND PIPES MUST BE 6 INCHES IN DIAMETER CAST IRON, CONCRETE OR TERRA COTTA OR PVA OR ABS ACCEPTED. IF TOP OF SEPTIC TANK IS DEEPER THAN 3 FEET, MANHOLE TO GRADE REQUIRED.


NOTE: DISTRIBUTION BOXES MUST HAVE BAFFLES

*INSTALLER IS RESPONSIBLE FOR OBTAINING FINAL APPROVAL ON THIS PERMIT

*CALL 461-9933 FOR INSPECTION OF SEPTIC SYSTEM.

511570

North (A) South
 Strong Run Loam 1 1/2' - 2'
 Str Bra - 1/2' - 1'
 3 1/4' L-HL
 grey & white
 - 1/2' - 1'
 SL - 1/2' - 1'
 Hand
 Bottom
 South
 9 1/2'

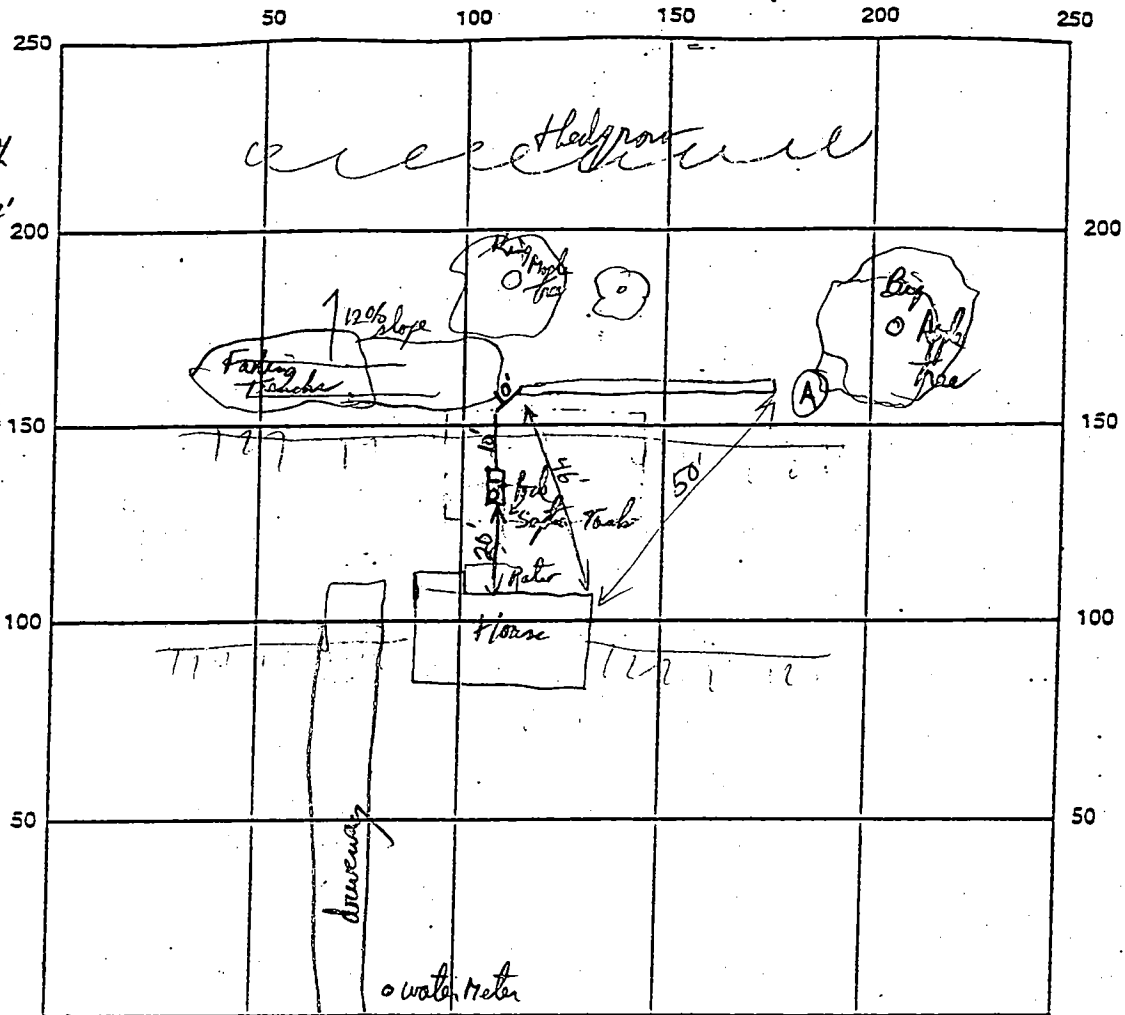

Indicate North - Name Adjoining Roadway as Base Line

SEPTIC TANK LEVEL _____ CLEANOUTS _____

DISTRIBUTION BOX LEVEL _____

DRAIN FIELD/TITLE DEPTH 3 FT. TRENCH WIDTH 3 FT. INLET DEPTH 2 FT.

EFFECTIVE GRAVEL DEPTH 1 FT. TOTAL LENGTH 46 FT.

NUMBER OF TRENCHES 1 ONE SIDEWALL/BOTTOM AREA 120 SQ. FT.

DRYWALL INSIDE DIAMETER _____ FT. EFFECTIVE DEPTH BELOW INLET _____ FT.

ABSORBENT AREA _____ SQ. FT.

REMARKS: only rock found was 5ft from end of New trench. Trench OK to cover 5/10/99

DATE SYSTEM APPROVED 5/10/99 INSPECTOR RPP

GREY ROCK
COMMUNITY, INC.
1220/554
50.00 A.
P. 1001

april 29, 1979

Edward L. Linsenmeyer

REGISTERED PLUMBING AND HEATING

9304 MIGAN ROAD, RANDALLSTOWN, MD 21133

TELEPHONE 922-8172

Pager # 351-6219

To: Mr. Craig Williams
Program Director
Howard County Health Dept. 21043

In reference to: 3425 Rolling View Ct
Ellicott City, Md

Dear Sir,

As existing septic system drainfield has failed and county sewer line fronts on said property, the property owner Bramville R. Longenecker hereby requests that he be allowed to repair said septic system in lieu of connecting to public sewerage as he is aware of extreme rock conditions being present in front yard and a connection depth exceeding 13' would be required. It would be very costly for him to connect to public sewerage. Costs of which could exceed \$10,000.00. It would be a financial hardship for him as he is 88 years old and on social security. I am writing this letter on his behalf.

Thank you,

OK FOR "INTERIM" REPAIR

- APPROX 1/2 USUAL SIZE DUE TO
MONETARY CONSIDERATION. PROPERTY
SHOULD BE CONNECTED TO PUBLIC SEWER
AT TIME OF FUTURE SALE. 5/3/79 (CQ)

Property owner:
Bramville R. Longenecker
Plumber: Edward L. Linsenmeyer

12:30
4/23
Left message

Page (40) 351-6219

9304 Migan Rd
Randallstown 21133
(410) 922-8172

Ed Linenmeyer

tent.
4/29 10:00

Repair - Septic failing

3425 Rolling View Court
Rolling Acres

tank repl. 5 years ago



5/3/99

JANE REQUEST FOR

REPAIR PERMIT

CHECK IS IN
THE MAIL.

(CW)

"INTERIM" REPLACEMENT

FOR FAILING SYSTEM.

FOR MAY 10 @ 10:00.

(HAVE A ^{RELATED} LETTER IN PROGRESS TO
ADD TO FILE LATER)

INSTALLER /

JOB

AD01635



HOWARD COUNTY HEALTH DEPARTMENT

Mary Sue Baker, MBA, Acting County Health Officer

May 3, 1999

Granville Longerbeam
3425 Rolling View Ct.
Ellicott City, Md. 21043

Re: Request for exception to issue septic system repair permit for
3425 Rollingview Ct due to monetary considerations.

Dear Mr. Longerbeam,

This is to advise that the above referenced exception to issue a septic system repair permit, submitted on your behalf by your plumbing contrator Edward Linsenmeyer, is hereby granted.

Evaluation of site and soil conditions for the repair has been tentatively scheduled for 10:00 a.m., Monday May 10, 1999. Assuming satisfactory conditions are confirmed, this office is prepared to authorize installation of an "interim" septic system of approximately 1/2 the usual size. It is reasonable to expect such a system to function effectively as long as the current occupancy level of 1 or 2 persons is maintained.

We would expect that connection to public sewer be accomplished as such future time as the property is offered for public sale and/or when the potential occupancy level of the property changes for some other unanticipated reason.

Please feel free to contact me if you have any additional questions about this matter.

Yours truly,

Craig Williams, Sanitarian

cc: Ed Linsenmeyer