

PERMIT

SEWAGE DISPOSAL SYSTEM

MARYLAND STATE DEPARTMENT OF HEALTH

HOWARD COUNTY

ELLICOTT CITY

DISTRICT 24

DATE 11/17/76

P 24762

~~A 23363~~

W 511387

RECEIVED

Herman Lick (?)

Gary W. Ridgely

IS PERMITTED TO INSTALL ☒ ALTER ☐

ADDRESS Rt. 97 Cooksville, Md.

PHONE 489-4864

A SEWAGE DISPOSAL SYSTEM LOCATED AT _____

SUBDIVISION William Ridgely Prop. ROAD Route 97 LOT 1

PROPERTY OWNER Gary W. Ridgely

ADDRESS Same as above

SPECIFICATIONS 3 bedrooms

DRAIN FIELD _____ DEPTH _____ FEET, BOTTOM AREA _____ SQ. FT.

SEEPAGE PITS _____ ABSORBENT SIDE-WALL AREA _____ SQ. FT.

SEPTIC TANK CAPACITY 1000 GALLONS

FOR GARBAGE GRINDER, INCREASE DISPOSAL AREA 22% & TANK CAPACITY 50%.

OTHER DRY WELL - To have 135 sq. ft. per bedroom below inlet for a total sidewall of
405 sq. ft. Inlet can come in at 4 ft. and maximum depth permitted for dry well is
12 ft. below original grade. Locate dry well 240 ft. from front of lot and 125 ft.
from fence next to old house.

NOTE: ALL PIPE FROM HOUSE TO DISPOSAL AREA MUST BE CAST IRON.

PERMIT VOID AFTER THREE YEARS.

NOTE: UNSTALL STAND PIPE ON SEPTIC TANK. STAND PIPES MUST BE 6 INCHES IN DIAMETER.


PLANS APPROVED BY David J. O'Neill DATE 9/10/76

CAST IRON, CONCRETE OR TERRA COTTA ACCEPTED.

FILL SEPTIC TANK AND DISTRIBUTION BOX WITH WATER BEFORE CALLING FOR AN INSPECTION. COVER NO WORK UNTIL INSPECTED AND APPROVED.

NEITHER THE HOWARD COUNTY COMMISSIONERS NOR THE HEALTH DEPARTMENT IS RESPONSIBLE FOR THE SUCCESSFUL OPERATION OF ANY SYSTEM.

W 511387
A 23363

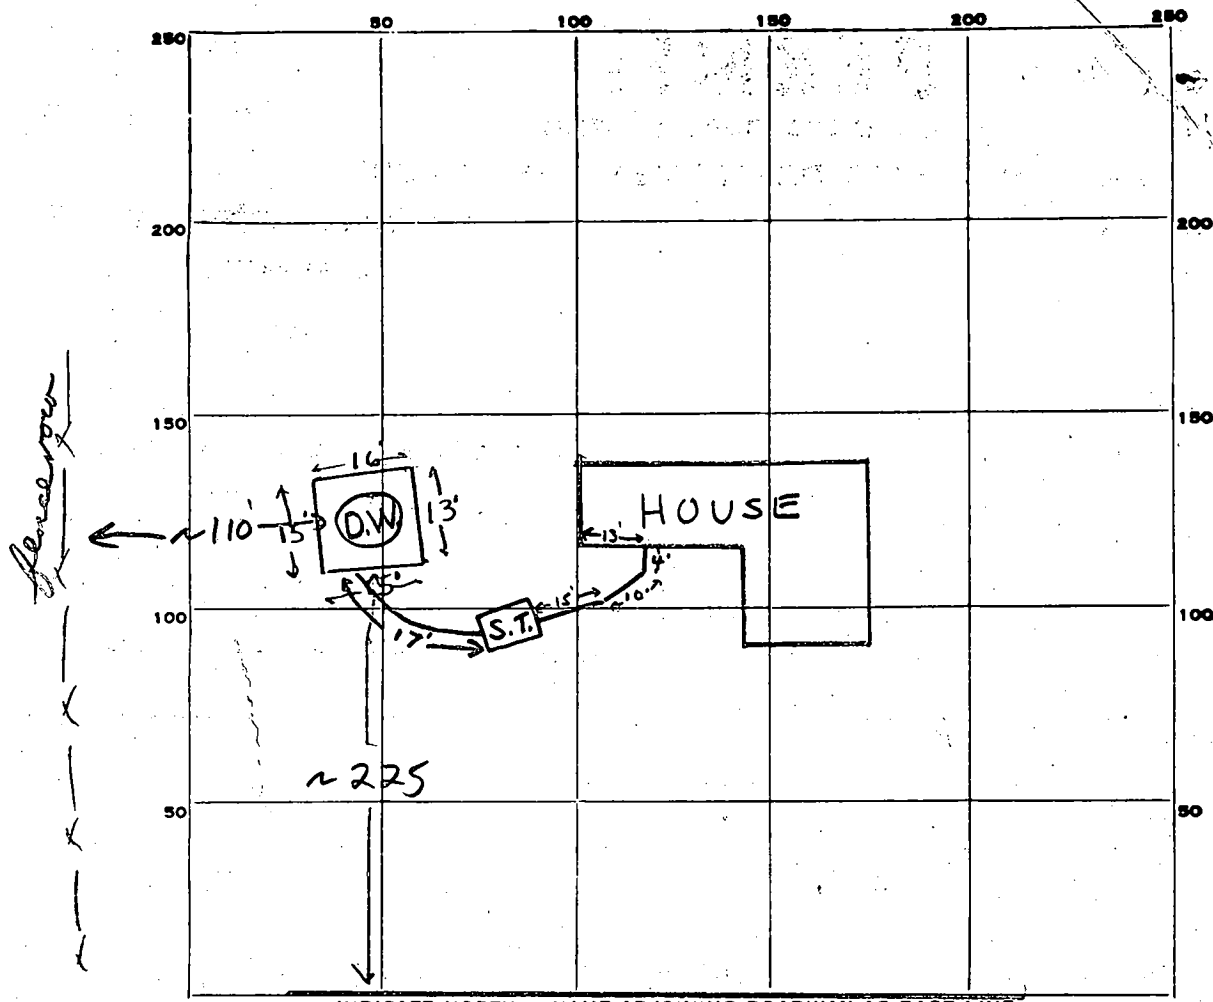

INDICATE NORTH. NAME ADJOINING ROADWAY AS BASE LINE.

Rte. #97

PERMIT CARD _____

SEPTIC TANK, LEVEL ✓ 1000 gal

CLEANOUTS

S.T.

D.W.

✓

✓

DISTRIBUTION BOX, LEVEL n.a.

TILE FIELD, DEPTH _____ FT. TRENCH WIDTH _____ FT.

GRAVEL DEPTH _____ IN. TOTAL LENGTH _____ FT.

NUMBER OF TRENCHES _____ TOTAL BOTTOM AREA _____

SEEPAGE PITS, OUTSIDE PERIMETER 59 FT. INSIDE DIAMETER 8 FT. DEPTH BELOW INLET _____ FT.

ABSORBENT AREA ±472 SQ. FT.

REMARKS _____

DATE SYSTEM APPROVED 12/3/76

INSPECTOR

Frank Skinner

APPLICATION

A 23363

P _____

SEWAGE DISPOSAL TESTING

STATE OF MARYLAND - DEPARTMENT OF HEALTH AND MENTAL HYGIENE

HOWARD COUNTY HEALTH DEPARTMENT
ENVIRONMENTAL HEALTH SERVICESP. O. BOX 476, ELLICOTT CITY, MARYLAND 21043
TELEPHONE: 465-5000, EXT. 356DISTRICT 4DATE 6/8/76TO: THE COUNTY HEALTH OFFICER
ELLICOTT CITY, MARYLAND

I, HEREBY, APPLY FOR THE NECESSARY TEST IN ORDER TO CONSTRUCT (OR RECONSTRUCT) A SEWAGE DISPOSAL SYSTEM.

PROPERTY OWNER Worthington RidgelyADDRESS Route 97, Cooksville, Maryland PHONE Any questions call:
John Schneider
465-7777

PROPERTY LOCATION:

SUBDIVISION _____ LOT NO. 1ROAD AND DESCRIPTION Route 97 - on left side going toward Glenwood - approx. 1 mile
past intersection of Route 97 & Route 144. (Sign says Spring Meadow Farm)SIZE OF LOT 300' x 150' TYPE BLDG. 3 or 4

NUMBER OF BEDROOMS

IF NOT SINGLE RESIDENCE DESCRIBE _____
(Single Fmly. Dwllg.)

THE SYSTEM INSTALLED UNDER THIS APPLICATION IS ACCEPTABLE ONLY UNTIL PUBLIC FACILITIES BECOME AVAILABLE.

SIGNATURE OF APPLICANT /s/ Carolyn P. RidgelyAPPROVED BY _____ FOR _____ DATE _____
(KIND OF SYSTEM)REJECTED BY _____ FOR _____ DATE _____
(KIND OF SYSTEM)

HOLD PENDING FURTHER TESTS _____ DATE _____

REASONS FOR REJECTION OR HOLDING _____

THIS IS NOT A PERMIT





Rt 97

10 X:

TESTED BY _____ ALSO PRESENT: _____

OK as Revised
 Df on
 9/6/94

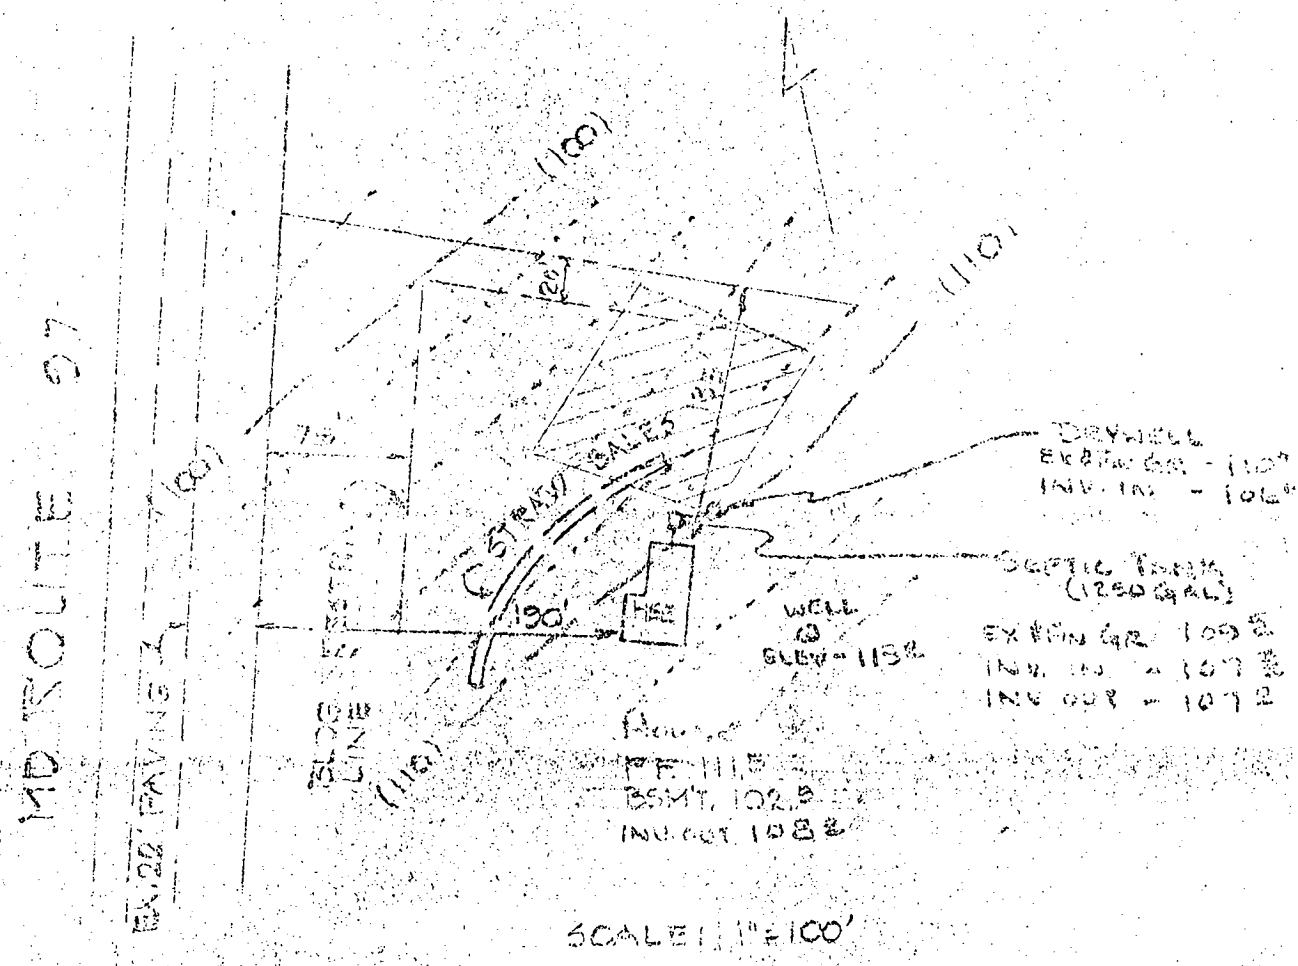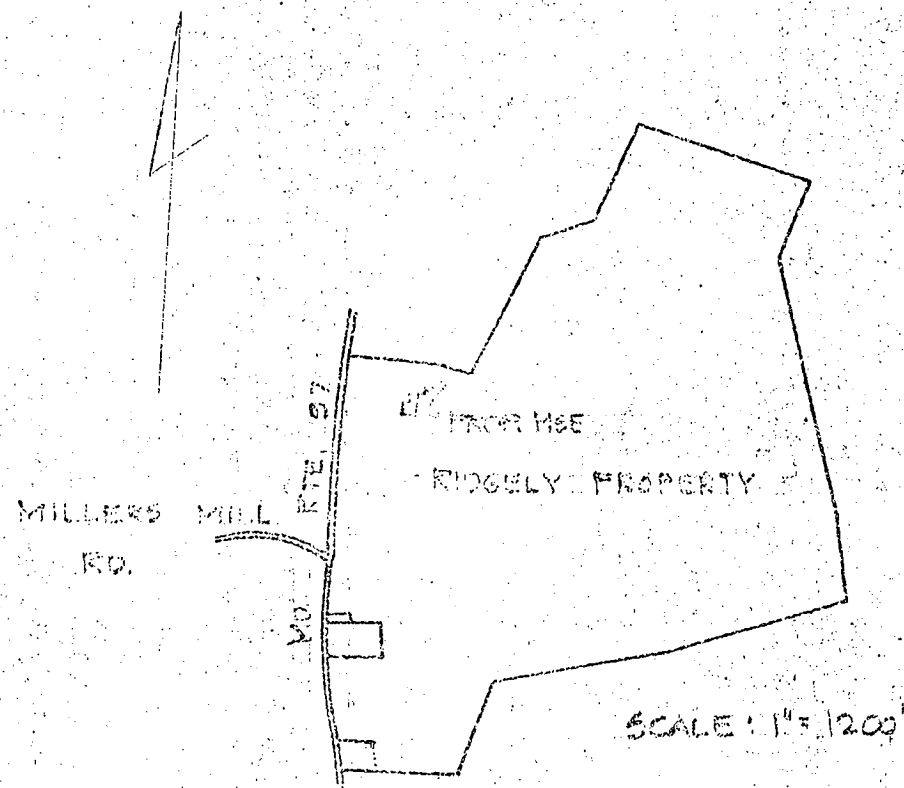


TITLE GRADING STUDY				ENGINEERING PLANNING SURVEYING	
PROJECT WILLIAM B. RIEGELY PROPERTY				BY BOENDER ASSOCIATES INC.	
LOCATION 4TH ELECTION DISTRICT HOWARD CO., MD.					
DATE 8/17/76	DES BY JLS	DRAWN BY JLS	CHKD BY JLS		
SCALE 1" = 100'	JOB NO. 7654	DRWG. NO. -	ELICOTT CITY, MD. 21043 SALISBURY, MD. 21801 301-465-7777		

294 SS
OK OP&Z
10/14/76 RDBlood

MD. ROUTE 97

(60' R/W)

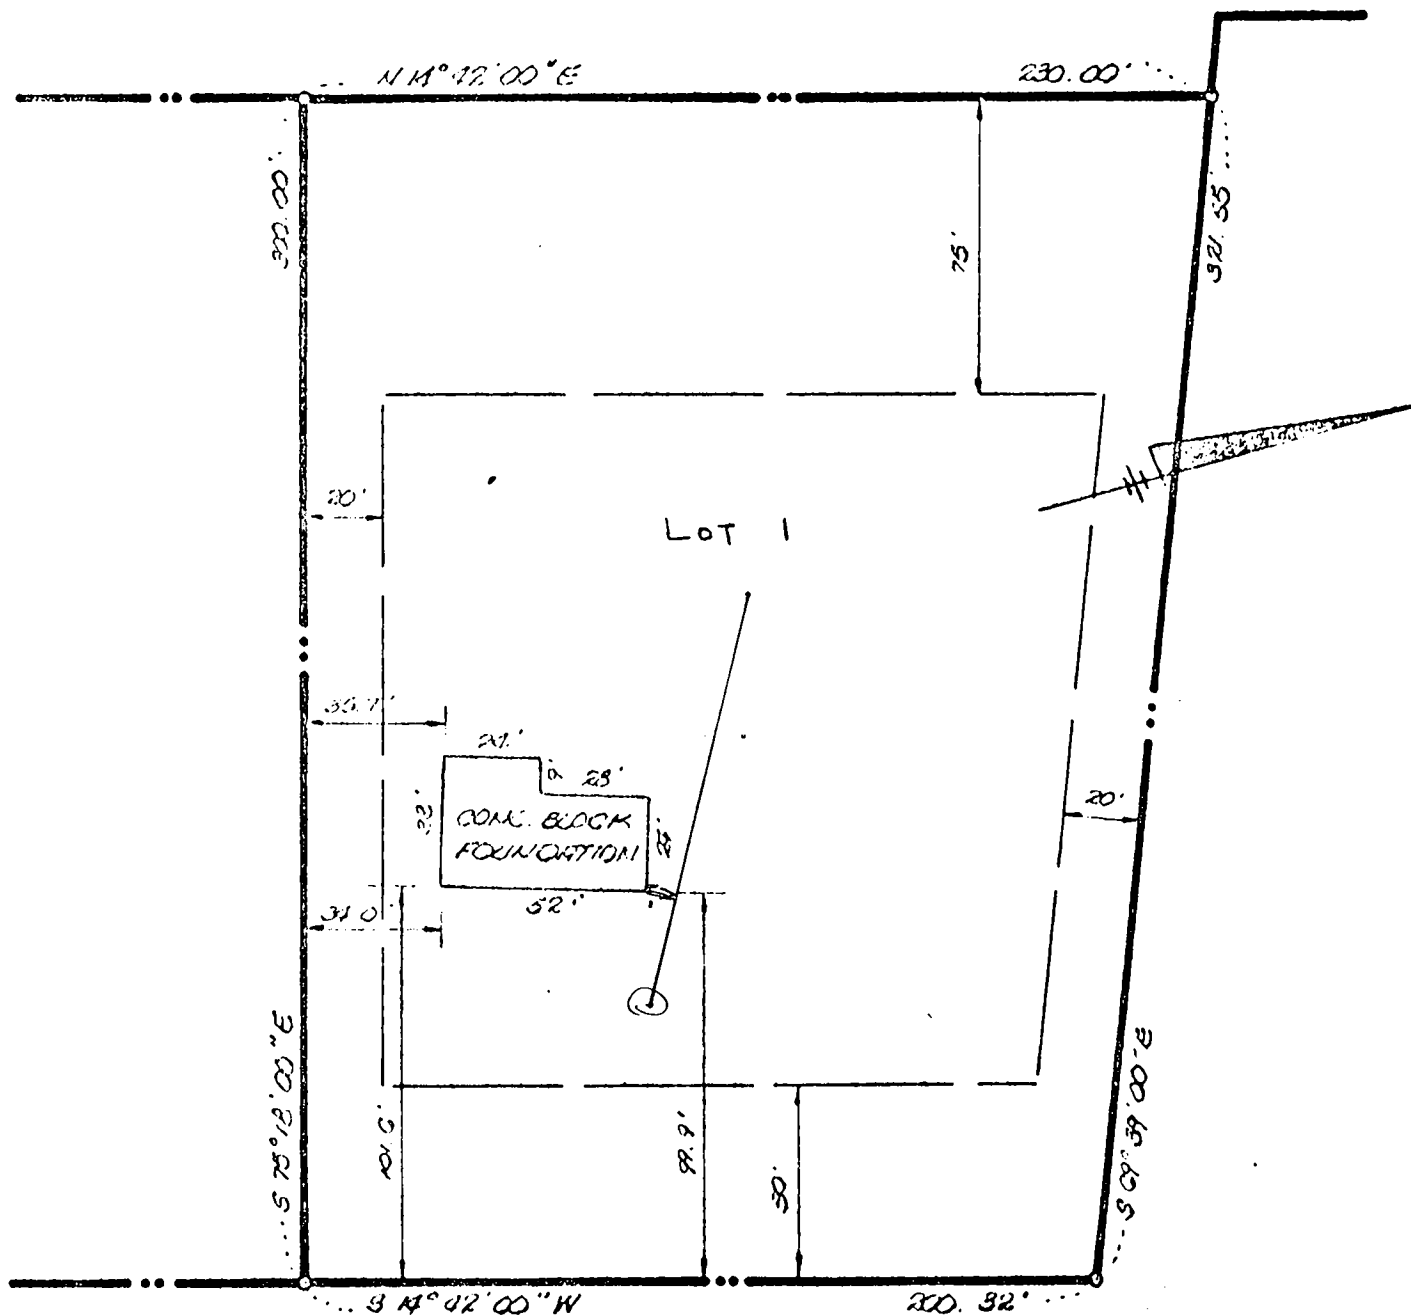

I HEREBY CERTIFY THAT I HAVE
READ AND APPROVED THE
PLAT HEREON, AND THAT THE
SAME IS A TRUE AND CORRECT
REPRESENTATION OF THE
FIELD DATA.

William B. Boender
Professional Engineer

W.B. Boender, Inc. Date: 11-18-76

TITLE FOUNDATION LOCATION PLAT				ENGINEERING PLANNING SURVEYING BY BOENDER ASSOCIATES INC. ELLCOTT CITY, MD. 21043 SALISBURY, MD. 21801 301-465-7777
PROJECT WILLIAM B. RIDGELY PROPERTY - LOT 1				
LOCATION 4TH ELECTION DISTRICT - HOWARD COUNTY, MD.				
DATE 10/12/76	DES BY -	DRAWN BY R	CHKD BY WGB	
SCALE 1" = 50'	JOB NO. 76-53	DRWG NO. 1		

C1		9897		SEQUENCE NO. (MDE USE ONLY)		STATE OF MARYLAND WELL COMPLETION REPORT FILL IN THIS FORM COMPLETELY PLEASE TYPE		THIS REPORT MUST BE SUBMITTED AFTER WELL IS COMPLETED	
1 2 3 6								COUNTY NUMBER W 511387	
ST/CO USE ONLY DATE Received MM DD YY		DATE WELL COMPLETED MM DD YY		Depth of Well 22 200 26 (TO NEAREST FOOT)		PERMIT NO. FROM "PERMIT TO DRILL WELL" HO-94-2076		28 29 30 31 32 33 34 35 36 37	
8 13		15 20							
OWNER Ridgely		STREET OR RFD 2153 ROUTE 971		TOWN Glenwood		SUBDIVISION William Ridgely PROCESSION		LOT 1	
WELL LOG Not required for driven wells		GRROUTING RECORD WELL HAS BEEN GROUTED (Circle Appropriate Box) TYPE OF GROUTING MATERIAL (Circle one) CEMENT CM BENTONITE CLAY BC NO. OF BAGS 17 NO. OF POUNDS 1700 GALLONS OF WATER 85 DEPTH OF GROUT SEAL (to nearest foot) from 0 ft. to 51 ft. (enter 0 if from surface)		C3 PUMPING TEST HOURS PUMPED (nearest hour) 3 PUMPING RATE (gal. per min.) 15 METHOD USED TO MEASURE PUMPING RATE Bucket WATER LEVEL (distance from land surface) BEFORE PUMPING 50 ft. WHEN PUMPING 200 ft. TYPE OF PUMP USED (for test) A air P piston T turbine C centrifugal R rotary O other (describe below) J jet S submersible					
STATE THE KIND OF FORMATIONS PENETRATED, THEIR COLOR, DEPTH, THICKNESS AND IF WATER BEARING		CASING RECORD casing types insert appropriate code below MAIN CASING TYPE ST CO PL OT Nominal diameter top (main) casing (nearest inch)! 6 Total depth of main casing (nearest foot) 80 OTHER CASING (if used) diameter inch depth (feet) from to							
DESCRIPTION (Use additional sheets if needed)		FEET FROM TO		check if water bearing					
Top Soil		0 2							
Brown shale		2 30							
Brown Mica		30 72		✓					
Sand stone		72 90							
Brown Mica		90 91		✓					
Sand stone		91 105							
Gray Mica		105 200							
NUMBER OF UNSUCCESSFUL WELLS		WELL HYDROFRACTURED		C2 DEPTH (nearest ft.) HO 78 200					
CIRCLE APPROPRIATE LETTER A A WELL WAS ABANDONED AND SEALED WHEN THIS WELL WAS COMPLETED E ELECTRIC LOG OBTAINED P TEST WELL CONVERTED TO PRODUCTION WELL		I HEREBY CERTIFY THAT THIS WELL HAS BEEN CONSTRUCTED IN ACCORDANCE WITH COMAR 26.04.04 "WELL CONSTRUCTION" AND IN CONFORMANCE WITH ALL CONDITIONS STATED IN THE ABOVE CAPTIONED PERMIT, AND THAT THE INFORMATION PRESENTED HEREIN IS ACCURATE AND COMPLETE TO THE BEST OF MY KNOWLEDGE		SCREEN RECORD screen type or open hole insert appropriate code below ST BR HO STEEL BRASS OPEN HOLE PL PLASTIC OT OTHER					
DRILLERS LIC. NO. 1 MWD 040 George F. Eastwiler DRILLERS SIGNATURE (MUST MATCH SIGNATURE ON APPLICATION)		LIC. NO. 1 MWD 038 Burt Thompson SITE SUPERVISOR (sign. of driller or journeyman responsible for sitework if different from permittee)		GRAVEL PACK IF WELL DRILLED WAS FLOWING WELL INSERT F IN BOX 68		MDE USE ONLY (NOT TO BE FILLED IN BY DRILLER) T (E.R.O.S.) W Q		PUMP INSTALLED DRILLER INSTALLED PUMP (CIRCLE) (YES or NO) YES NO IF DRILLER INSTALLS PUMP, THIS SECTION MUST BE COMPLETED FOR ALL WELLS. TYPE OF PUMP INSTALLED PLACE (A,C,J,P,R,S,T,O) IN BOX 29 CAPACITY: GALLONS PER MINUTE (to nearest gallon) 31 35 PUMP HORSE POWER 37 41 PUMP COLUMN LENGTH (nearest ft.) 43 47 CASING HEIGHT (circle appropriate box and enter casing height) + above LAND SURFACE - below 2 (nearest foot)	
				SLOT SIZE 1 2 3 DIAMETER OF SCREEN (NEAREST INCH) 56 60 from to		LOCATION OF WELL ON LOT SHOW PERMANENT STRUCTURES AND INDICATE NOT LESS THAN TWO DISTANCES (MEASUREMENTS TO WELL) back lot line 20' 20' right lot line			
				TELESCOPE CASING LOG INDICATOR OTHER DATA					

B 1	8677	SEQUENCE NO. (MDE USE ONLY)	STATE OF MARYLAND PERMIT TO DRILL WELL please print or type	STATE PERMIT NUMBER HO - 94 - 2076
Date Received (APA) 02/04/99		OWNER INFORMATION RN 7738		
15. Last Name Riddely		Owner First Name Gary		
36. Street or RFD P. O. Box 219		55. Street or RFD Glenwood, Md 21738		
57. Town Glenwood		70. State MD		72. Zip 21738
DRILLER INFORMATION				
Driller's Name George F. Easterday		M/W/V/D 040		
Firm Name L. Franklin Easterday, Inc.		76. License No. 81		
Address 9265 Brown Church Rd., MT. Airv. Md. 21771				
Signature George F. Easterday		Date 1/27/1999		
B 2 WELL INFORMATION				
1. APPROX. PUMPING RATE (GAL. PER MIN.)		5		
AVERAGE DAILY QUANTITY NEEDED (GAL. PER DAY)		500		
USE FOR WATER (CIRCLE APPROPRIATE BOX)				
☒ DOMESTIC POTABLE SUPPLY & RESIDENTIAL IRRIGATION				
☐ FARMING (LIVESTOCK WATERING & AGRICULTURAL IRRIGATION)				
22. ☐ INDUSTRIAL, COMMERCIAL, DEWATERING				
☐ PUBLIC WATER SUPPLY WELL				
☐ TEST, OBSERVATION, MONITORING				
☐ GEO-THERMAL				
APPROXIMATE DEPTH OF WELL 300 FEET				
APPROXIMATE DIAMETER OF WELL 6 INCH				
METHOD OF DRILLING (circle one)				
☒ BORED (or Augered) ☐ JETTED ☐ Jetted & DRIVEN				
☒ AIR-ROTARY ☐ AIR-PERCussion ☐ ROTARY (Hydraulic Rotary)				
☐ CABLE ☐ REVerse-ROTary ☐ Drive-POINT				
other				
REPLACEMENT OR DEEPEMED WELLS (CIRCLE APPROPRIATE BOX)				
☒ THIS WELL WILL NOT REPLACE AN EXISTING WELL				
☐ THIS WELL WILL REPLACE A WELL THAT WILL BE ABANDONED AND SEALED				
39. ☐ THIS WELL WILL REPLACE A WELL THAT WILL BE USED AS A STANDBY-CONTACT LOCAL APPROVING AUTHORITY FOR POLICY ON STANDBY WELLS				
☐ THIS WELL WILL DEEPEN AN EXISTING WELL				
PERMIT NUMBER OF WELL TO BE REPLACED OR DEEPEMED (IF AVAILABLE) 41				
Not to be filled in by driller (MDE OR COUNTY USE ONLY)				
APPROX. PERMIT NUMBER 54				
PERMIT No. HO - 94 - 2076				
SPECIAL CONDITIONS				
NOTE: APPROVING AUTHORITIES SHOULD USE SEPARATE SHEET IF NEEDED				


B 3	Howard	LOCATION OF WELL CCH
8. COUNTY		21. SUBDIVISION
23. SECTION		42. LOT
44. 46		48. 50
Glenwood		52. NEAREST TOWN
MILES FROM TOWN (enter 0 if in town)		71. 73 76 77 78
B 4		2153 Route 97
1. DIRECTION OF WELL FROM TOWN (CIRCLE BOX)		11. NEAR WHAT ROAD
		30. ON WHICH SIDE OF ROAD (CIRCLE APPROPRIATE BOX)
		34. 325 37. 38 39
		DISTANCE FROM ROAD ENTER FT OR MI
		TAX MAP: 14 BLK: 5 PARCEL: 25A
NOT TO BE FILLED IN BY DRILLER HEALTH DEPARTMENT APPROVAL		
Howard W511387		
COUNTY NAME COUNTY NO		
STATE SIGNATURE		
DATE ISSUED 02/05/99		
43. CO SIGNATURE 2/4/00		
NORTH GRID 538 000 EAST GRID 0714 000		
50. 55. 57. 63.		
SHOW MAJOR FEATURES OF BOX & LOCATE WELL WITH AN X		
SOURCES OF DRILLING WATER		
1. wells		
2.		
3.		
WRITE THE BOX NUMBER FROM THE MAP HERE		
E 790		
N 530		
DRAW A SKETCH BELOW SHOWING LOCATION OF WELL IN RELATION TO NEARBY TOWNS AND ROADS AND GIVE DISTANCE FROM WELL TO NEAREST ROAD JUNCTION		
MAP 9 C1		

2.2.99
11am

SITE INSPECTION SHEET

OWNER: Gary Ridgely DATE REQUESTED: 2.2.99
ADDRESS: 2153 Route 97 DRILLER/CONTRACTOR: Easterday
Ridgely Prop, Lot 1 WELL TAG NUMBER: _____
TAX & PARCEL: Map 14, Grid 5, Parcel 212 COUNTY: Howard
PROPOSAL: Replacement Well Site


LOCATION DIAGRAM

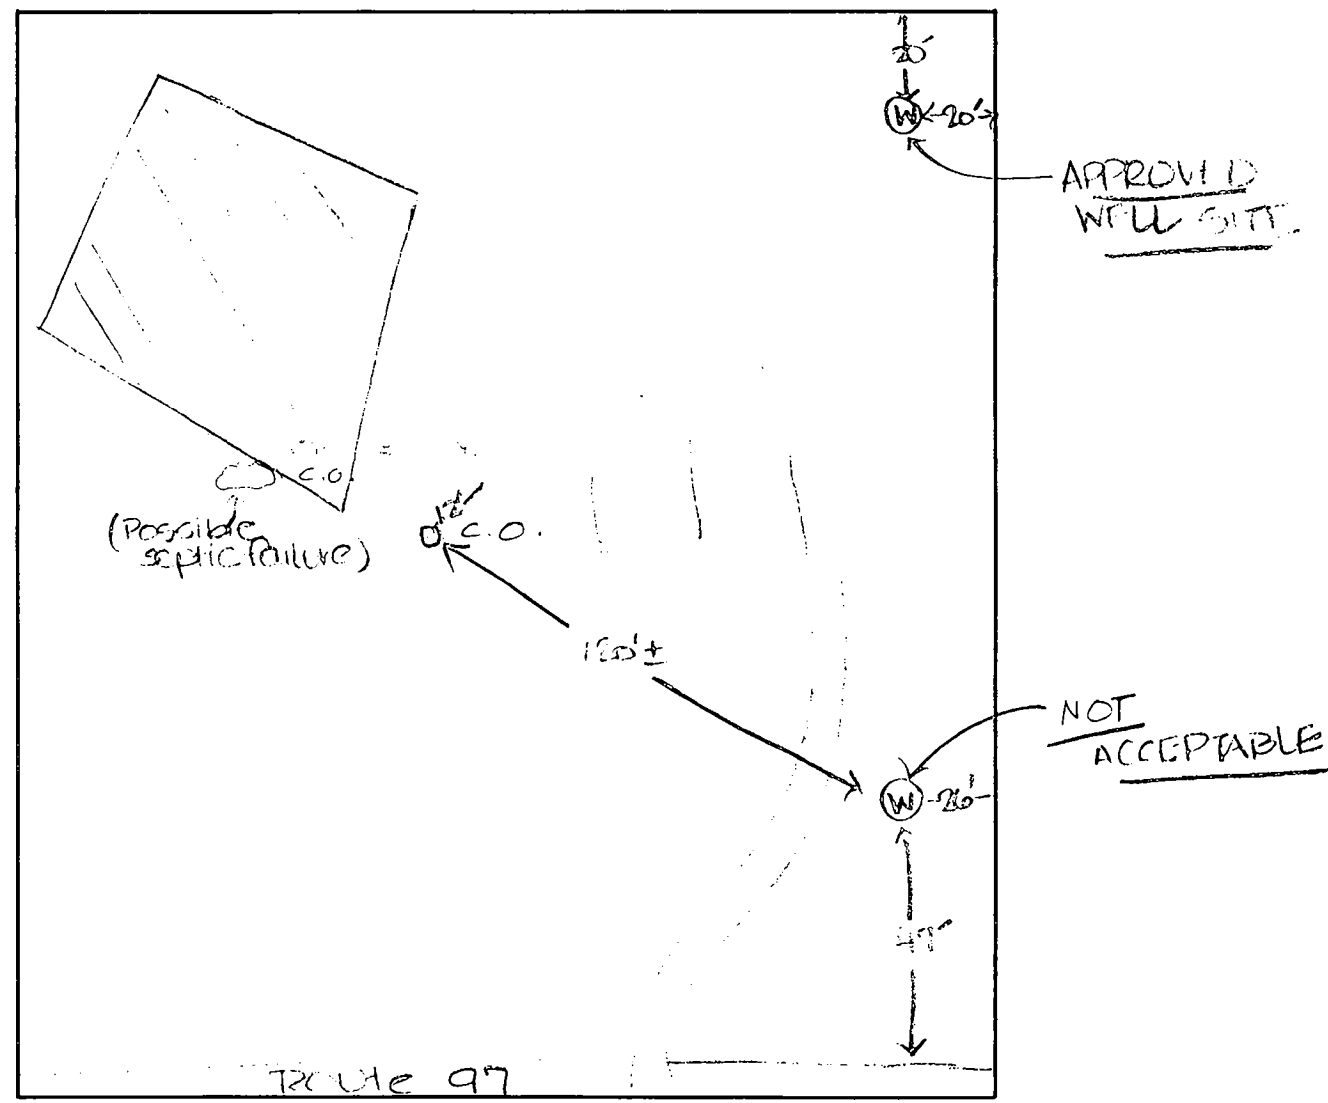

COMMENTS: Only the well site in the upper right - rear
property corner is acceptable (septic receive area shall be
modified as necessary). Well to be drilled as close to the
upper corner as reasonable, due to the trees.

DATE: 2/3/99 INSPECTOR: DKS

*I observed evidence of possible septic failure. - Need
to make follow-up inspection at the time of grant
to confirm.

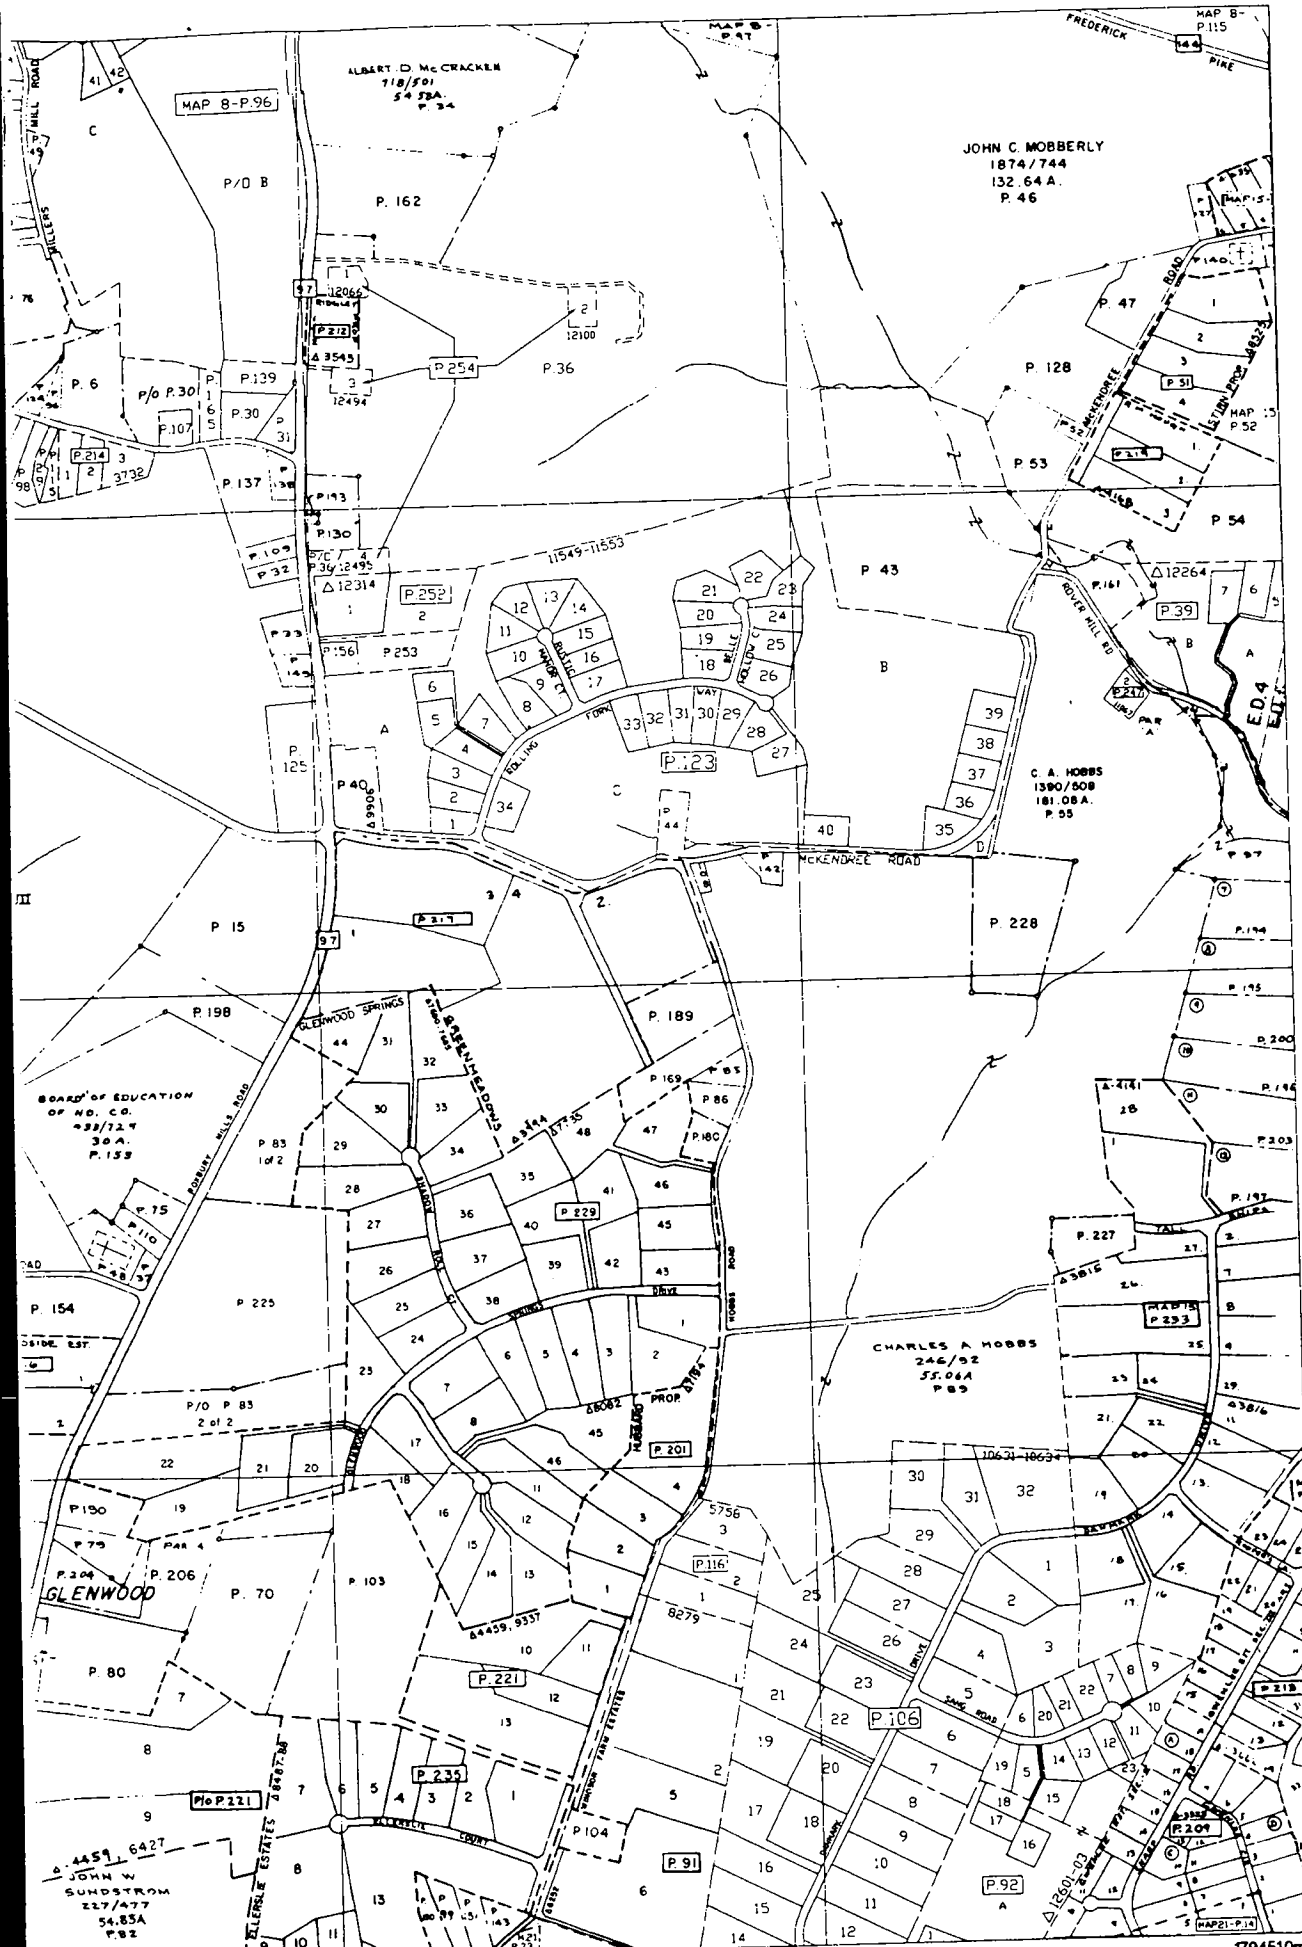

COMPILED BY
OFFICE OF PLANNING
CITY MAPPING SECTION

PRIORITY LINE
SUBDIVISION BOUNDARY
CONTINUING OWNERSHIP

Z - Z - Z - Z



HOWARD COUNTY

5/19/99

To: Kim

410-313-2648

HOWARD COUNTY HEALTH DEPARTMENT
Bureau of Environmental Health
3525-H Ellicott Mills Drive
Ellicott City, MD 21043
461-9933

APPLICATION FOR PITLESS ADAPTER, WELL PUMP AND PRESSURE TANK INSTALLATION

New Installation ☒
Replacement ☒

Receipt #

Date

5-18-99

Name of Installer

Daron Wilson

Telephone

301-831-7057

License Number

JSD065

Certified Well Pump Installer

Well Driller ☒

Registered Plumber

Name of Property Owner

Gary Ridgley

Telephone

Subdivision

Lot #

Well Tag # Ho -94 -2076

Site Address

2153 Rt 97

Pump

1. Type

- a. Deep well jet
b. Shallow well jet
c. Submersible ☒

2. Make

Goulds

3. Model #

7G505422

4. Capacity

7 GPM

5. Pump exceeds well capacity Yes ☐ No ☒6. If Yes, is low pressure cutoff switch installed? Yes ☐ No ☐7. What methods are used to protect the pump and electrical wiring from vibrations? Torque arrestors ☐ Cable guards ☒ Other ☐

Motor

1. Horsepower

2. RPM

3450

3. Voltage

a. 110

b. 220 ☒

Pitless Adapter

1. Make

Montison

2. Model #

B-10X

3. Depth

3 1/2

Tank

1. Capacity

32

2. Pressure relief valve? ☒

Piping

1. Type

PE

2. Size

1"

3. NSF and/or BOCA Code approved ☒

4. Depth of supply line

3 1/2

Well data

1. Depth

200 ft.

2. Yield

15 GPM

3. Static water level

ft.

4. Will water supply be disinfected by installer? ☒

I understand that it is my responsibility to notify the Howard County Health Department when the installation is ready for inspection (otherwise this permit is null and void).

All information given above is true to the best of my knowledge.

Signature of Applicant:



Daron Wilson

Date:

5-19-99

Note: A sticker indicating approval/status of the installation will be placed on the well casing at the time of the inspection.

N ^o .	NORTH	EAST
1	10042.828	5022.423
2	10042.839	5048.267
3	9928.003	5330.916
4	9526.603	5222.986
5	9602.731	4932.806
6	9607.805	4213.461

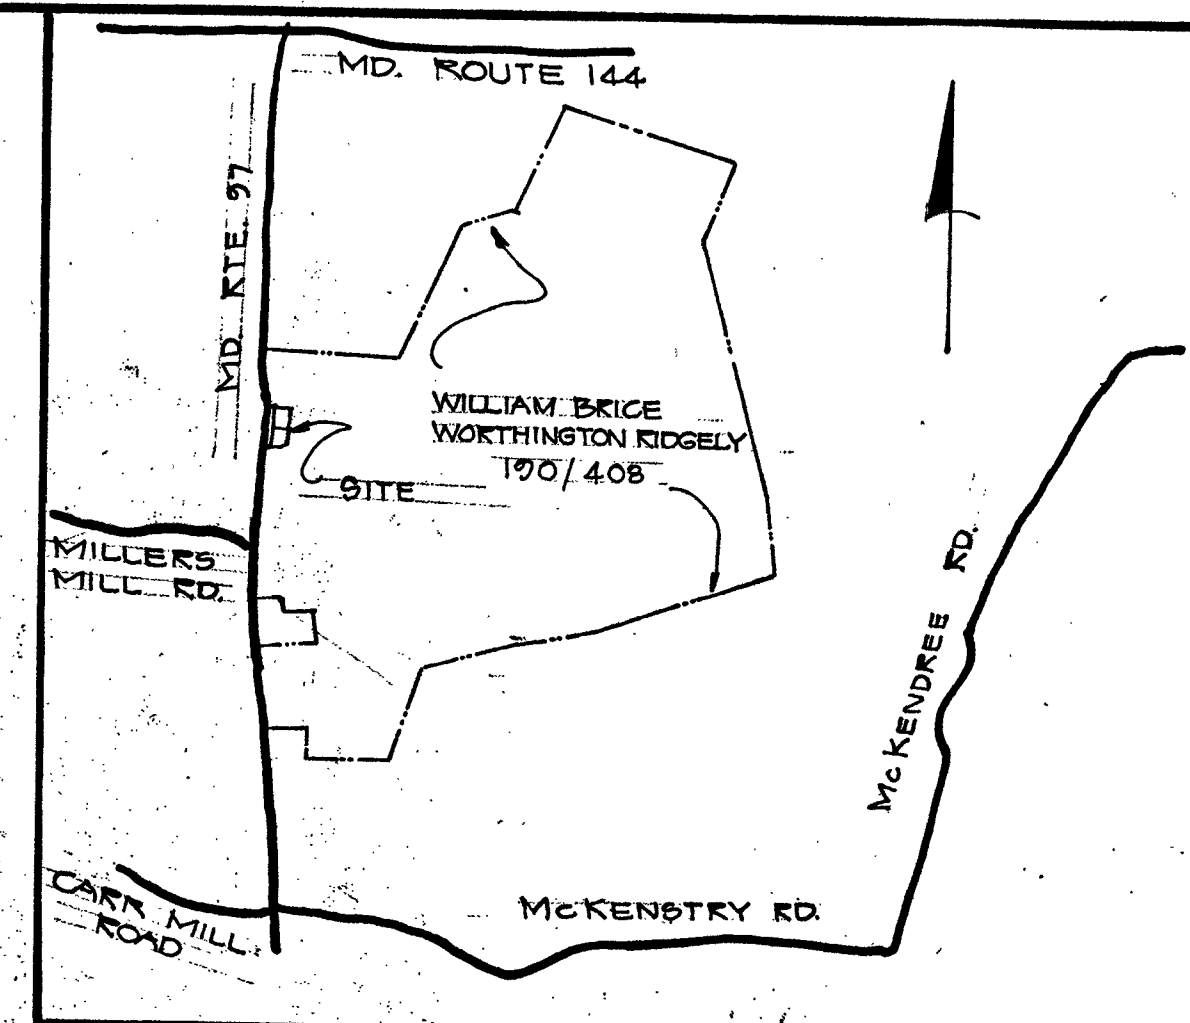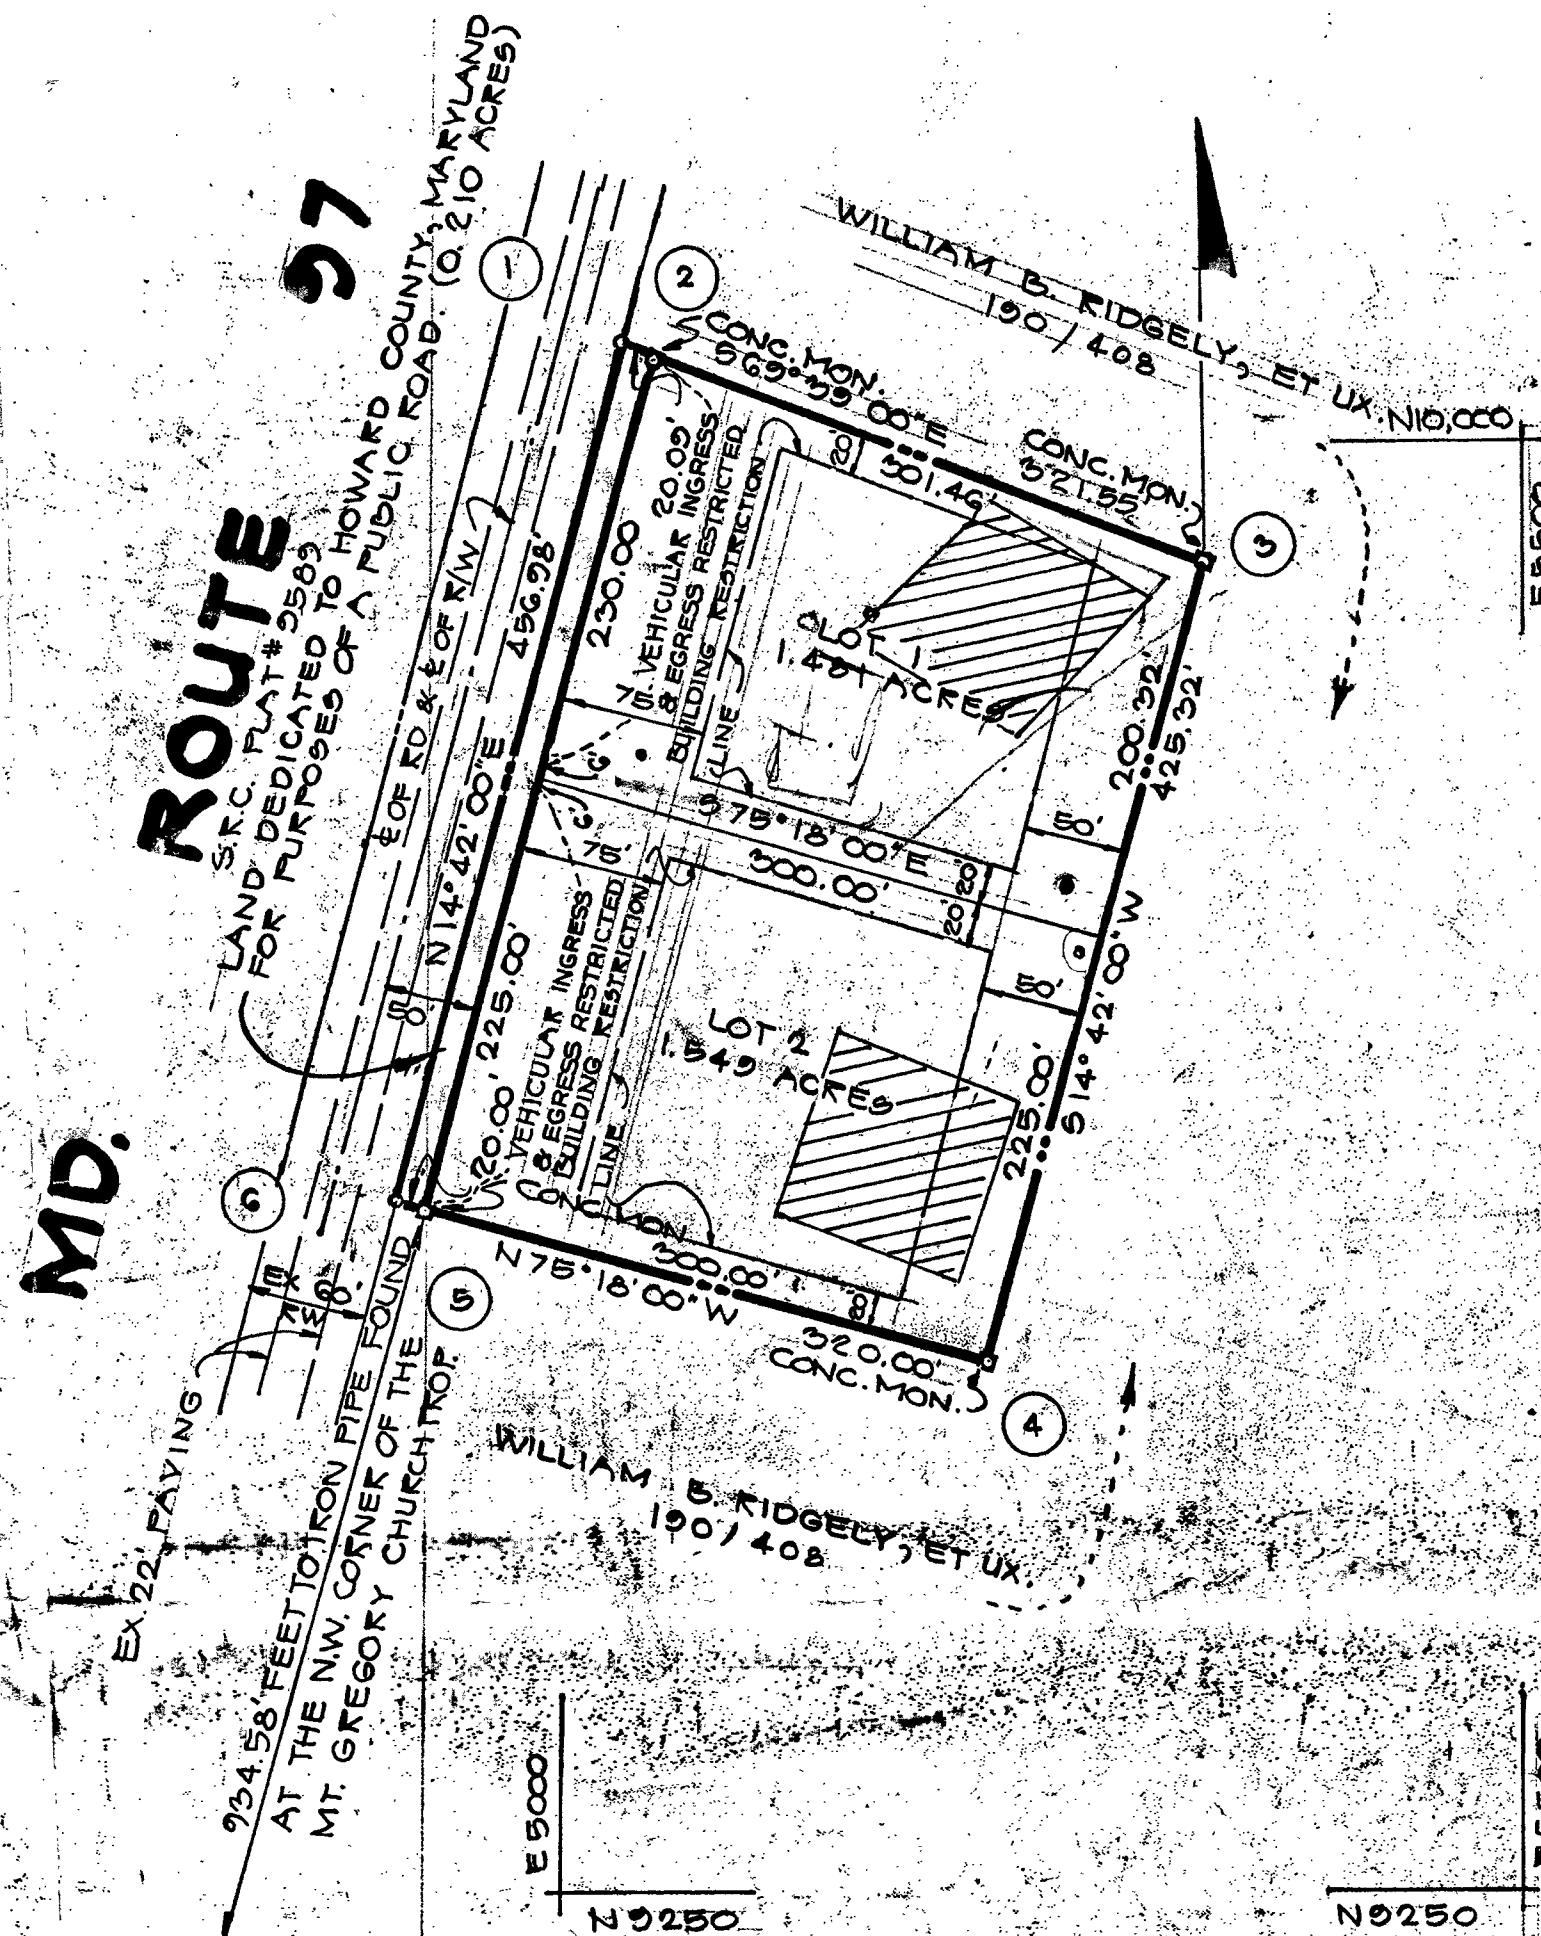

VICINITY MAP

SCALE: 1" = 2000

GENERAL NOTES

1. PROPERTY SHOWN HEREON IS LOCATED ON TAX MAP 14, PART OF PARCEL 36.
2. THE LOTS SHOWN HEREON COMPLY WITH THE MINIMUM OWNERSHIP WIDTH AND LOT AREA AS REQUIRED BY THE MD. STATE DEPT. OF HEALTH AND MENTAL HYGIENE.
3.  THIS AREA DESIGNATES A PRIVATE SEWAGE EASEMENT OF APPROXIMATELY 100 SQ. FT. AS REQUIRED BY THE MARYLAND STATE HEALTH DEPARTMENT FOR INDIVIDUAL SEWAGE DISPOSAL IMPROVEMENTS OF ANY NATURE IN THE AREA ARE RESTRICTED UNTIL PUBLIC SEWAGE IS AVAILABLE AND SERVICING ANY RESIDENTIAL STRUCTURES CONSTRUCTED ON THESE BUILDING SITES. THIS EASEMENT SHALL BE GOING NULL AND VOID UPON CONNECTION TO A PUBLIC SEWAGE SYSTEM.
4. DEED REFERENCE: 190/408.
5. COORDINATES SHOWN HEREON ARE ASSUMED.
6. SUBJECT TO VP: 76-89.

PERC TESTS SHOWN HEREIN ARE FIELD LOCATED

RECORDED AS PLAT # 3543

ON OCT 6, 1976 AMONG THE LAND RECORDS OF
HOWARD COUNTY, MD.

ENGINEER

BOENDER ASSOCIATES, INC.

SUITE 101-107
TOWN & COUNTRY PROFESSIONAL BUILDING
8726 TOWN & COUNTRY BLVD.
ELLICOTT CITY, MD. 21043

AREA TABULATIONS

1. TOTAL NO. OF LOTS: 2
2. TOTAL AREA OF LOTS: 3.030 AC.
3. TOTAL AREA OF R/W DEDICATION: 0.210 AC.
4. TOTAL AREA OF PLAT: 3.240 AC.

OWNERS CERTIFICATE

WE, WILLIAM BRICE WORTHINGTON RIDGELY & CAROLYN RIDGELY, OWNERS OF THE PROPERTY SHOWN AND DESCRIBED HEREON, ADOPT THIS PLAN OF SUBDIVISION AND IN CONSIDERATION OF THE ACCEPTANCE OF THIS FINAL MAP BY THE OFFICE OF PLANNING AND ZONING, ESTABLISH THE MINIMUM DRAINAGE RESTRICTION LINES AND GRANT UNTO HOWARD COUNTY, MD. DRAINAGE WATER LINES AND OTHER MINUTIAL UTILITIES AND SERVICES IN AND UNDER ALL ROADS AND STREET RIGHT-OF-WAYS AND THE SPECIFIC EASEMENT AREA SHOWN HEREON; 2.) DEDICATE TO PUBLIC USE THE BEDS OF THE STREETS AND/OR ROADS AND FLOOD PLAINS AND OPEN SPACE WHERE APPLICABLE AND FOR ONE DOLLAR CONSIDERATION, HEREBY GRANT THE RIGHT AND OPTION TO HOWARD COUNTY TO REACQUIRE THE FEE SIMPLE TITLE TO THE BEDS OF THE STREETS AND/OR ROADS AND FLOOD PLAINS AND OPEN SPACE WHERE APPLICABLE; 3.) THAT NO BUILDING OR SIMILAR STRUCTURE OF ANY KIND SHALL BE ERECTED ON OR OVER THE EASEMENTS AND RIGHT-OF-WAYS; AND 4.) TO FURTHER AGREE THAT MAINTENANCE OF ALL WATERWAYS, DRAINAGE EASEMENTS AND/OR FLOOD PLAINS SHOWN HEREON ARE THE RESPONSIBILITY OF THE PROPERTY OWNER, IT'S SUCCESSORS AND ASSIGNS.


WITNESS OUR HANDS THIS 11TH DAY OF August 1976.

Myself sign Bride as wedding Mr. Bridgely
Carolyn P. Bridgely
WITNESS

SURVEYORS CERTIFICATE OWNER & DEVELOPER

I HEREBY CERTIFY THAT THE FINAL PLAT SHOWN HEREON IS CORRECT, THAT IT IS A SUBVISOR OF PART OF THE LAND CONVEYED BY H. RICHES WATKINS & ANNA H. WATKINS TO WILLIAM BRICE WORTHINGTON RIDGELY & CAROLYN P. RIDGELY BY DEED DATED JUNE 21, 1946, AND RECORDED IN THE LAND RECORDS OF HOWARD COUNTY IN LIGER 100, FOLIO 408, AND THAT ALL MORTGAGES AND ENCUMBRANCES ARE IN PLACE AS SHOWN IN ACCORDANCE WITH THE ANNOTATED CODE OF MARYLAND.

William G. Hartel
WILLIAM G. HARTEL, P.L.S. N° 9430

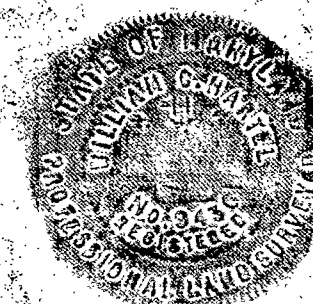

OWNER & DEVELOPER

WILLIAM B. RIDGLEY
2149 MARYLAND ROUTE 97
COOKSVILLE, MD. 21723

**SUBDIVISION PLAT
LOTS 1 & 2
WILLIAM B. RIDGELY
PROPERTY**

4th ELECTION DISTRICT HOWARD CO., MD
SCALE: 1" = 100' AUGUST 10, 1976

F-77-27ms