

PERMIT

SEWAGE DISPOSAL SYSTEM

DEPARTMENT OF HEALTH AND MENTAL HYGIENE

HOWARD COUNTY HEALTH DEPARTMENT

BUREAU OF ENVIRONMENTAL HEALTH

~~XXXXXX~~

410-313-2640

INDEXED

P 512775A

A REPAIR

DISTRICT

DATE 10/21/1999

DATE SYSTEM APPROVED 10/22/99

INSPECTOR DKS

Fogle's Septic Clean, Inc.

IS PERMITTED TO INSTALL ALTER X

ADDRESS 580 Obrecht Road, Sykesville, Maryland 21784 PHONE 410-795-5670

SUBDIVISION LOT ROAD 688 Ridge Road

PROPERTY OWNER Charles Riel

688 Ridge Road

ADDRESS Mt. Airy, Maryland 21771

SEPTIC TANK CAPACITY 1250 GALLONS

NUMBER OF BEDROOMS 4

N/A SQUARE FEET PER BEDROOM

LINEAR FEET OF TRENCH REQUIRED N/A

REPAIR - PURPOSE - TO REPLACE COLLAPSED METAL SEPTIC TANK (AND CONFIRMATION OF EXISTING SEPTIC SYSTEM).

Call for inspection when tank is in place so that a sanitarian can approve size and location and when ground is opened so that a sanitarian can observe the existing septic system.

PLANS APPROVED BY Donna K. Soe DATE 10-19-1999

COVER NO WORK UNTIL INSPECTED AND APPROVED

NEITHER THE HOWARD COUNTY COUNCIL NOR THE HEALTH DEPARTMENT IS RESPONSIBLE FOR THE SUCCESSFUL OPERATION OF ANY SYSTEM

NOTE: CLEANOUT REQUIRED EVERY 70 FEET OF SEWER LINE AND/OR AT 90° SWEEPS IN LINES FROM HOUSE TO DRAIN FIELDS. 90° ELBOWS NOT ACCEPTABLE.

NOTE: ALL PARTS OF SEPTIC SYSTEMS (I.E. TANK, DISTRIBUTION BOX TRENCHES) TO BE 100 FEET FROM WELL (UNLESS OTHERWISE SPECIFICALLY AUTHORIZED)

NOTE: IF DEEP TRENCH(ES) ARE USED CALL FOR INSPECTION BEFORE AND AFTER PLACING GRAVEL IN TRENCH(ES)

NOTE: NO DRY WELL SHALL EXCEED 15 FOOT IN DIAMETER NO ABSORPTION TRENCH TO EXCEED 100 FEET IN LENGTH

NOTE: ALL PIPE FROM HOUSE TO SEPTIC TANK MUST BE CAST IRON OR SCHEDULE 35/40 PVC OR ABS


PERMIT VOID AFTER TWO YEARS

NOTE: INSTALL STAND PIPE ON SEPTIC TANK AND DRY WELL STAND PIPES MUST BE 6 INCHES IN DIAMETER CAST IRON. CONCRETE OR TERRA COTTA OR PVA OR ABS ACCEPTED. IF TOP OF SEPTIC TANK IS DEEPER THAN 3 FEET, MANHOLE TO GRADE REQUIRED.

NOTE: DISTRIBUTION BOXES MUST HAVE Baffles

*INSTALLER IS RESPONSIBLE FOR OBTAINING FINAL APPROVAL ON THIS PERMIT

P 512775A

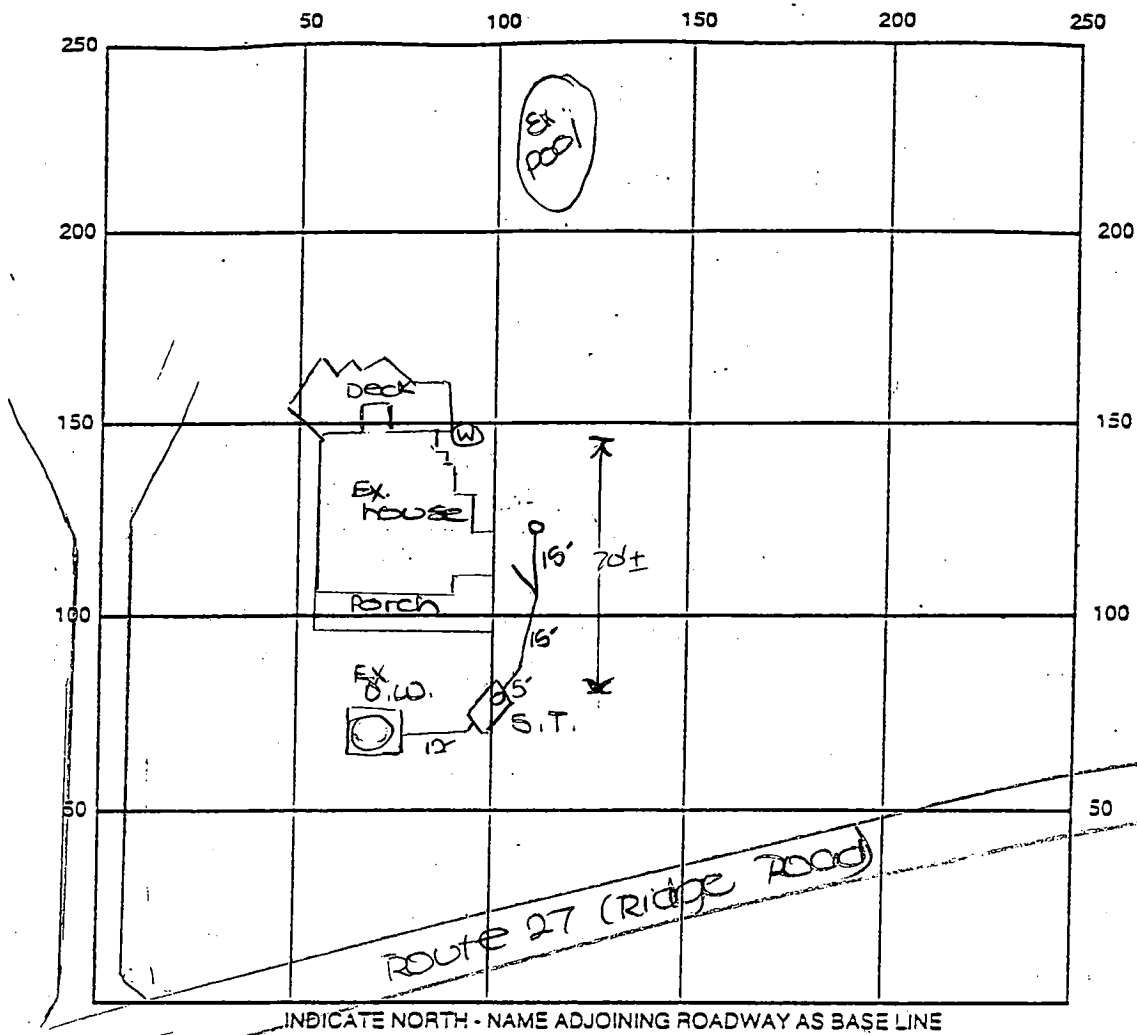

SEPTIC TANK LEVEL OK - 1250 gal CLEANOUTS one on s.t.

DISTRIBUTION BOX LEVEL N/A

DRAIN FIELD/TITLE DEPTH — FT. TRENCH WIDTH — FT. INLET DEPTH — FT.

EFFECTIVE GRAVEL DEPTH — FT. TOTAL LENGTH — FT.

NUMBER OF TRENCHES — ONE SIDEWALL/BOTTOM AREA — SQ. FT.

DRYWALL INSIDE DIAMETER — FT. EFFECTIVE DEPTH BELOW INLET — FT.

ABSORBENT AREA — SQ. FT.

REMARKS: 10/22/99 Ex metal septic tank has collapsed - installer
pumped out contents and filled hole w/clean fill.
New septic tank installation OK to cover.

DATE SYSTEM APPROVED 10/22/99 INSPECTOR [Signature]

No. 10/13/89
10/13/89
10/25/89
10/26/89
12/00 on LATON
AFTER NEW

File

10/13/89 P.C.O.
10/25/89 P.C.O. C.B.
P 44968

PERMIT

SEWAGE DISPOSAL SYSTEM

A REPAIR

MARYLAND STATE DEPARTMENT OF HEALTH DISTRICT

HOWARD COUNTY
BUREAU OF ENVIRONMENTAL HEALTH
461-9933

EXCEPT C.O. DATE 9/19/89
AT DRY WELL
DATE SYSTEM APPROVED 10/25/89
INSPECTOR C.B.

INDEXED

Leonard Moxley IS PERMITTED TO INSTALL ALTER X

ADDRESS PHONE 253-3241

SUBDIVISION ROAD 688 Ridge Road LOT

PROPERTY OWNER Charles T. Riel, Jr. PHONE: 831-5907

ADDRESS 688 Ridge Road Mt. Airy, Maryland 21771 NEXT TO FRUIT & VEGETABLE STAND

IF GARBAGE GRINDER IS USED INCREASE SEPTIC TANK CAPACITY BY 50% AND ABSORPTION AREA BY 22%.

GARBAGE GRINDER? YES NO X

SEPTIC TANK CAPACITY GALLONS NUMBER OF BEDROOMS

REPAIR - CALL FOR INSPECTION WHEN GROUND IS OPENED SO SANITARIAN CAN RECOMMEND REPAIR.

1 15'X15' DRY WELL (LIMITED REPAIR AREA)
3' INLET BELOW G. GRADE. (9'X60' = 540 sq ft)
12' MAX DEPTH "0" "
(LOCATION 20' OFF FRONT PORCH STEPS.)

PLANS APPROVED BY C. Williams DATE 9/19/89

COVER NO WORK UNTIL INSPECTED AND APPROVED

NEITHER THE HOWARD COUNTY COUNCIL NOR THE HEALTH DEPARTMENT IS RESPONSIBLE FOR THE SUCCESSFUL OPERATION OF ANY SYSTEM

NOTE: CLEANOUT REQUIRED EVERY 70 FEET OF SEWER LINE AND/OR AT 90° SWEEPS IN LINES FROM HOUSE TO DRAIN FIELDS

NOTE: ALL PARTS OF SEPTIC SYSTEMS (I.E. TANK, DISTRIBUTION BOX, TRENCHES) TO BE 100 FEET FROM WELL (UNLESS OTHERWISE SPECIFICALLY AUTHORIZED)

NOTE: IF DEEP TRENCHES ARE USED CALL FOR INSPECTION BEFORE AND AFTER PLACING GRAVEL IN TRENCHES

NOTE: NO DRY WELL SHALL EXCEED 15 FOOT IN DIAMETER NO ABSORPTION TRENCH TO EXCEED 100 FEET IN LENGTH

NOTE: ALL PIPE FROM HOUSE TO SEPTIC TANK MUST BE CAST IRON OR SCHEDULE 40 PVC OR ABS

PERMIT VOID AFTER TWO YEARS

NOTE: INSTALL STAND PIPE ON SEPTIC TANK AND DRY WELL. STAND PIPES MUST BE 6 INCHES IN DIAMETER. CAST IRON, CONCRETE OR TERRA COTTA OR PVC OR ABS ACCEPTED. IF TOP OF SEPTIC TANK IS DEEPER THAN 3 FEET, MANHOLE TO GRADE REQUIRED


NOTE: DISTRIBUTION BOXES MUST HAVE BAFFLES

BLDG. PERMIT SIGNED
AND RETURNED 9/25/91
Serial # 38635 - pool

*INSTALLER IS RESPONSIBLE FOR OBTAINING FINAL APROVAL ON THIS PERMIT

*CALL 461-9933 FOR INSPECTION OF SEPTIC SYSTEMS.

P 44968

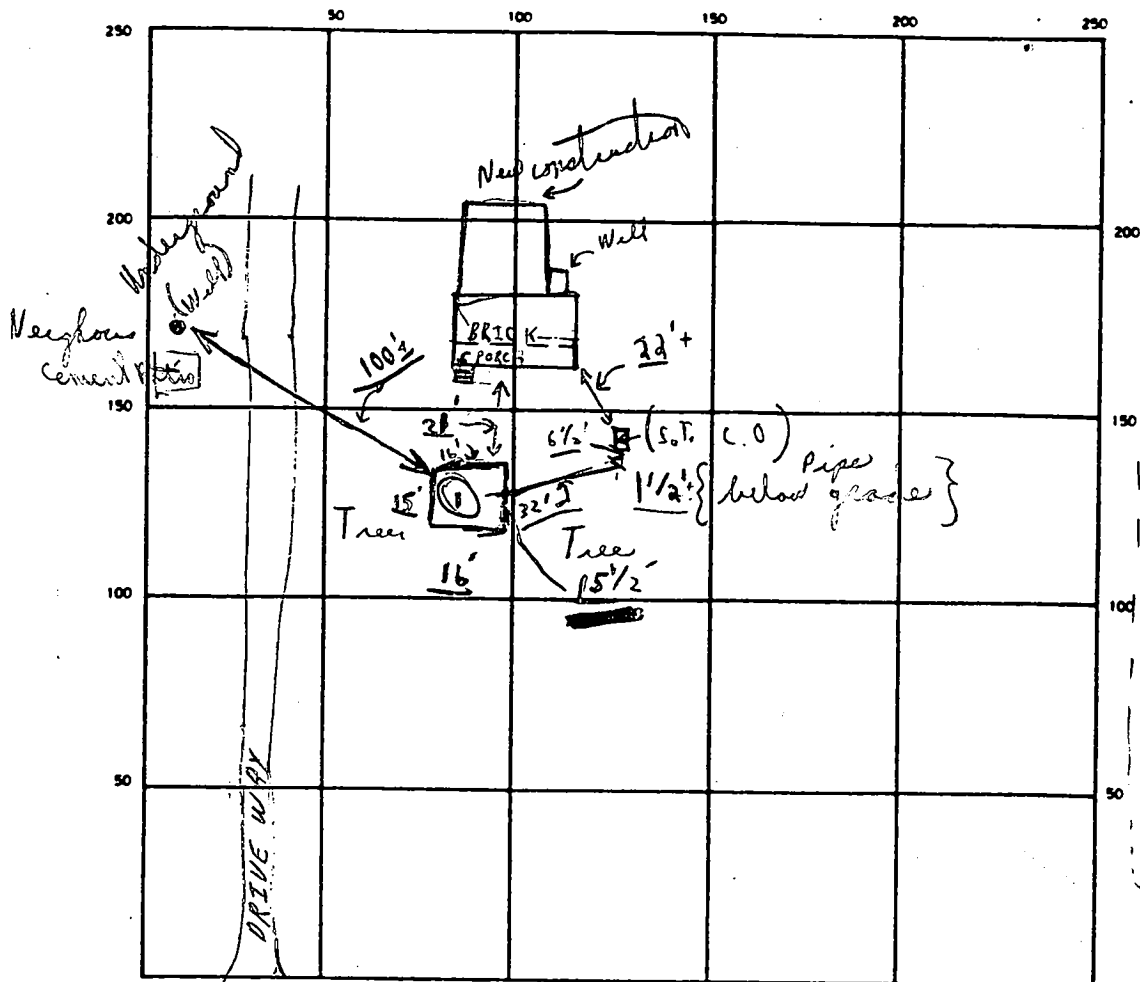

① Hole 10/13
1 1/2 3'±
Clayish
3 1/2' 10% Weather
Shale
80% LORRA
4/01
20%± clay

INDICATE NORTH — NAME ADJOINING ROADWAY AS BASE LINE

← DAMASCUS

← RT. 27 →

(MT. AIRY)

SEPTIC TANK LEVEL N/A

CLEANOUTS (S.T. EXISTING)

D.W.

OK 10/26/89

DISTRIBUTION BOX LEVEL N/A

DRAIN FIELD/TILE FIELD DEPTH — FT. TRENCH WIDTH — FT. INLET DEPTH — FT.

EFFECTIVE GRAVEL DEPTH — FT. TOTAL LENGTH — FT.

NUMBER OF TRENCHES — ONE SIDEWALL/BOTTOM AREA — SQ FT.



OUTSIDE DRYWELL INSIDE DIAMETER 62.5 FT. EFFECTIVE DEPTH BELOW INLET 9 FT.

ABSORBENT AREA 562.5 SQ FT.


REMARKS 10/11/89 - NO ONE SHOWED UP R.H. ; 10/13/89 OK TO CONTINUE.
LEFT STICKER WITH MR. MAXIEY, C.B. 10/25/89 OK TO C.B.
COVER ALL WORK - PARTIAL - FINAL - NEED TO SEE - CLEAN OUT
AT DRYWELL ONLY; 10/26/89 FINAL.

DATE SYSTEM APPROVED 10/25/89
10/26/89

INSPECTOR Charles, Bryan, Therk

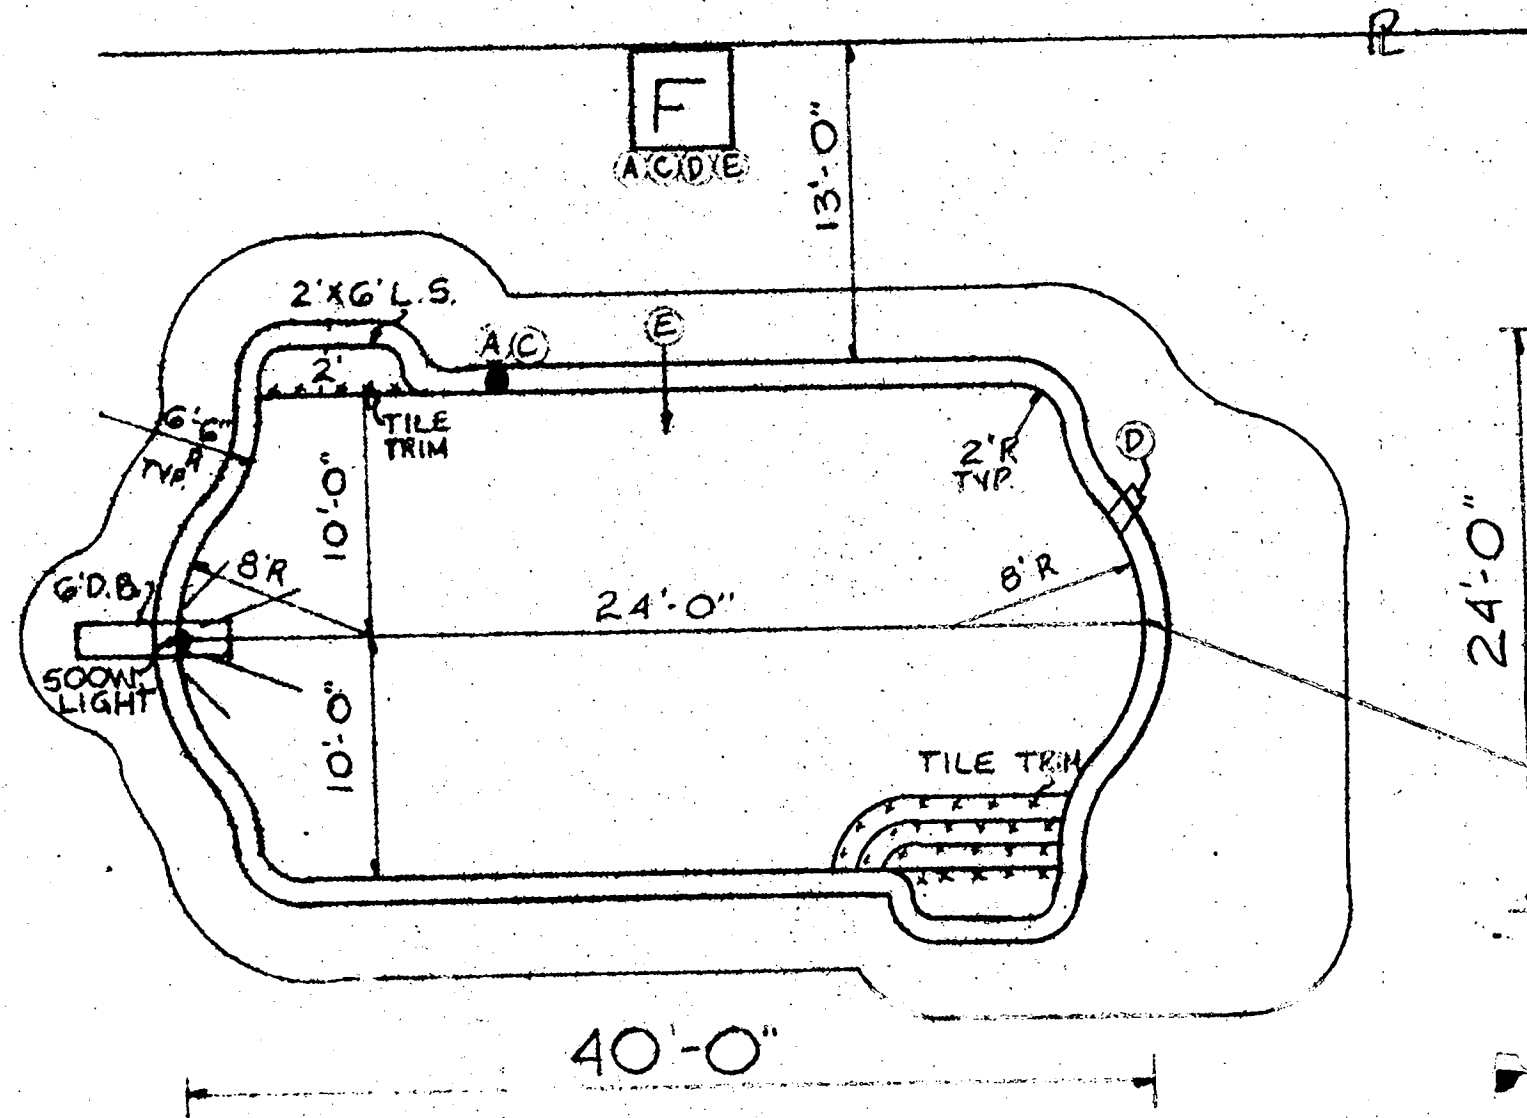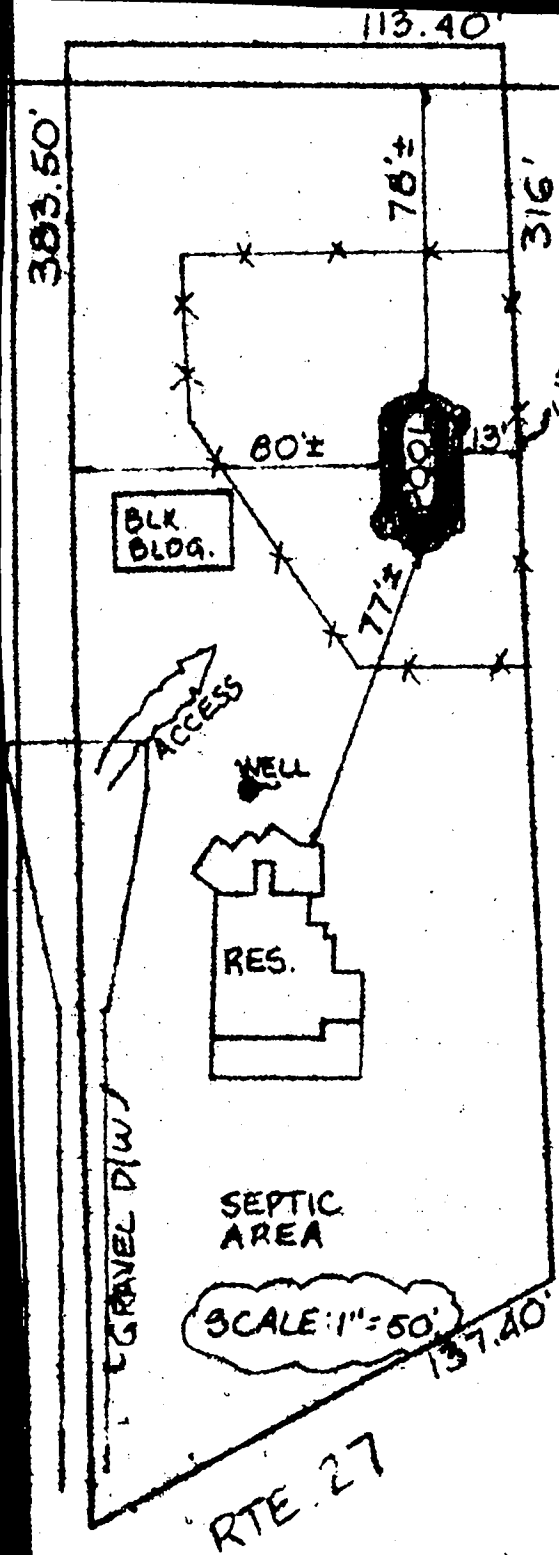

NOTE: This survey for title purposes only - is to be used for determining property lines. Property, and Machine Not guaranteed by this survey.

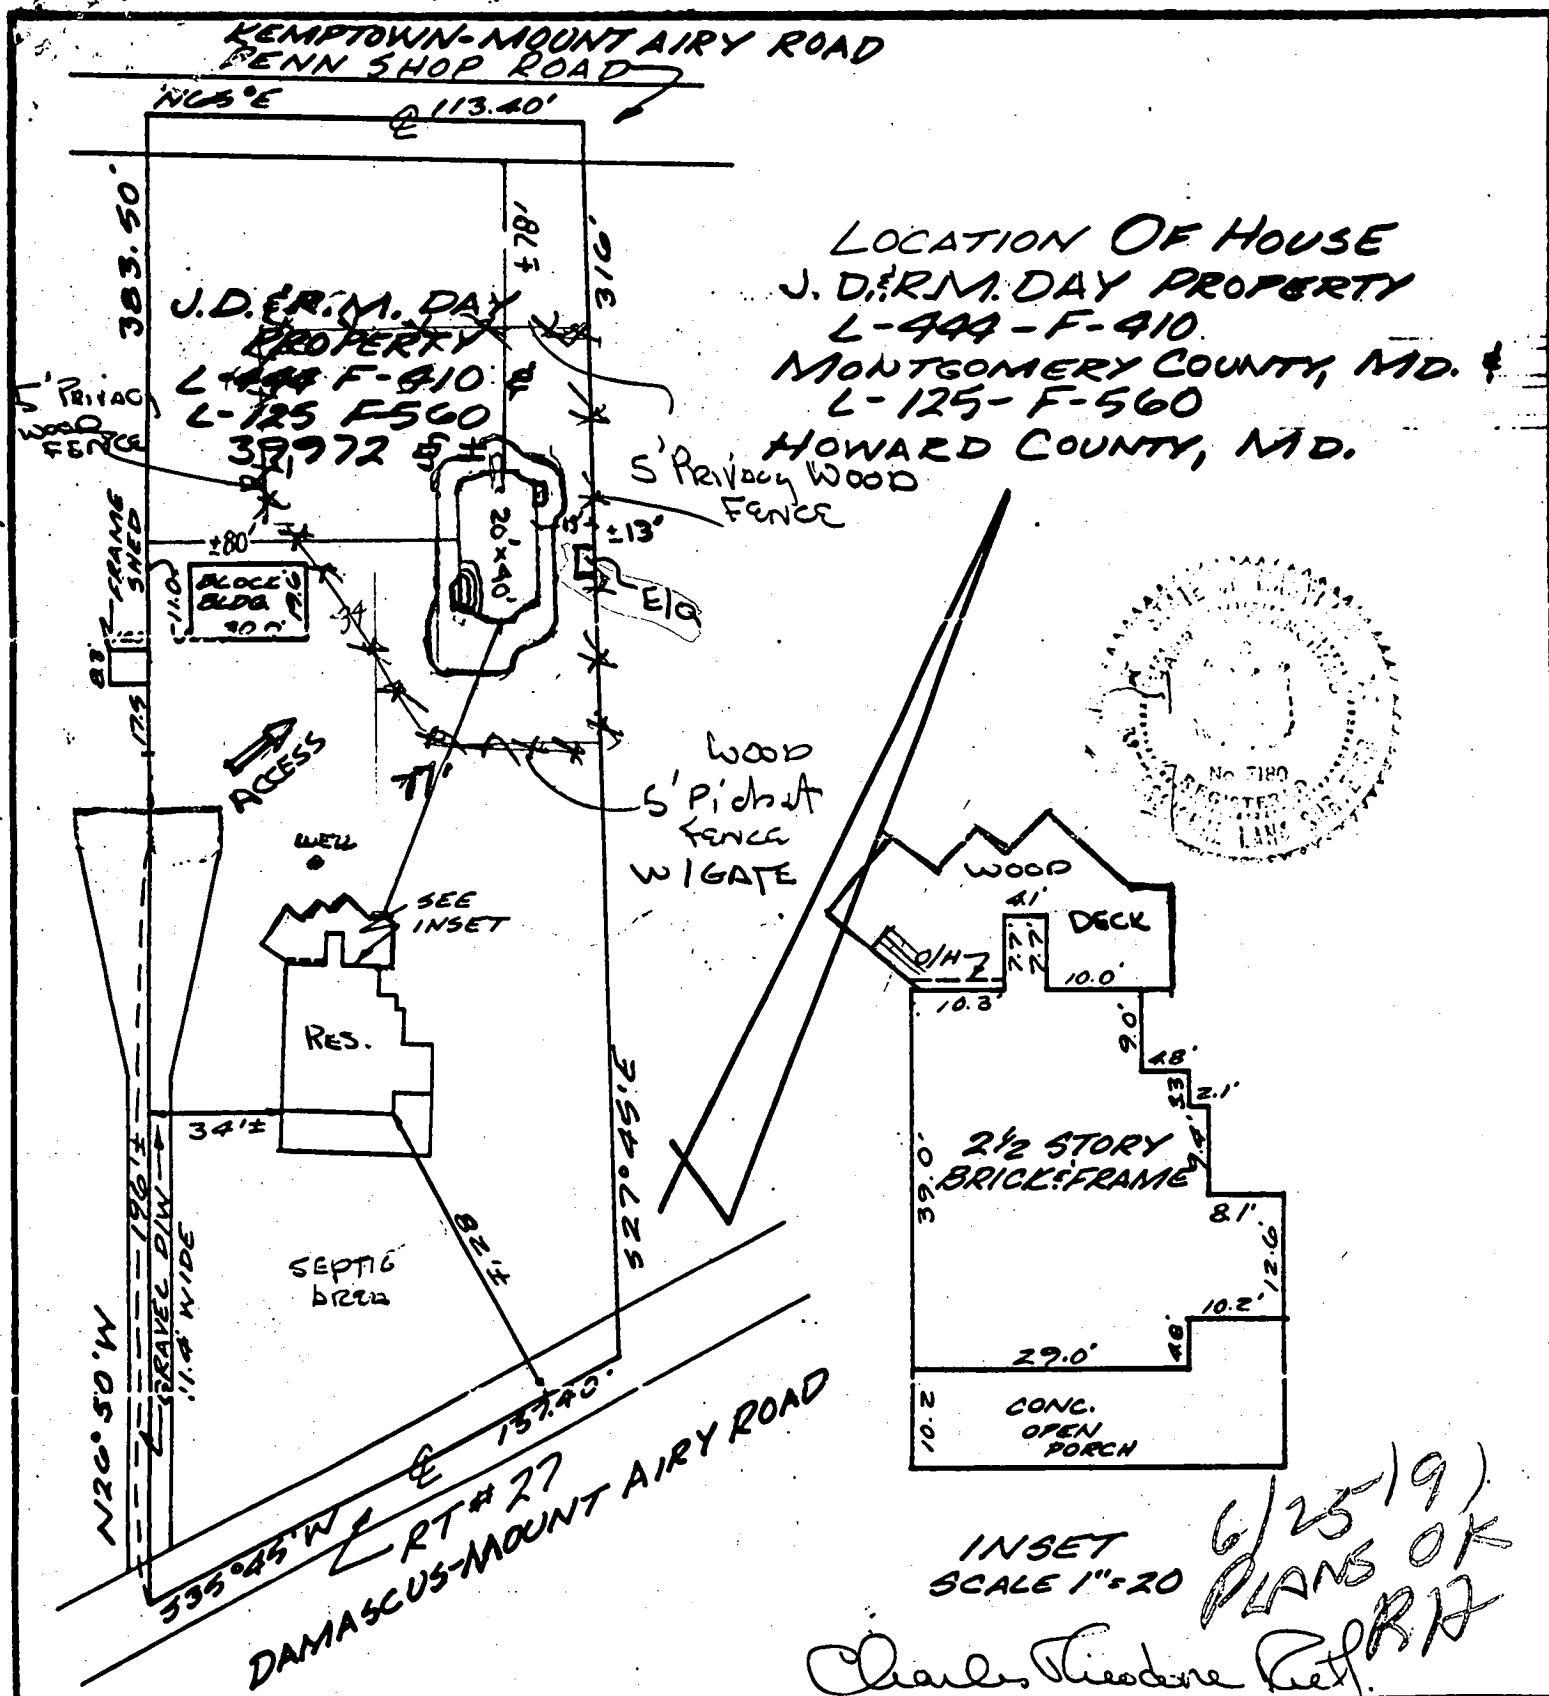

SURVEYOR'S CERTIFICATE

THE PLAN SHOWN HEREON IS PREPARED FROM FIELD MEASUREMENTS OF EXISTING STRUCTURES AND DIMENSIONS AS SHOWN OR DESCRIBED IN L-444, F-410 RECORDED IN HOWARD COUNTY LAND RECORDS & AS DESCRIBED IN L-125, F-560 AS RECORDED AMONG LAND RECORDS OF MONT. CO. MD.

Harry A. Blumh
REGISTERED LAND SURVEYOR MD. #7480

REFERENCES

PLAT BK.

PLAT NO.

LIBER 444 / 125

FOLIO 410 / 560

ELDON E. SNIDER & ASSOCIATES



LAND SURVEYORS
LAND PLANNING CONSULTANTS
& PROFESSIONAL ENGINEERS, SUITE 216
GAITHERSBURG, MD.
20878

DATE OF SURVEY

SCALE: 1"=50'

WALL CHECK:

DRAWN BY: A.W.

USE LOC.: 10-28-78


JOB NO.: 78-1739

BOUNDARY:

Privacy

Semi-Privacy

FENCE
STYLES
AROUND
POOL
AREA

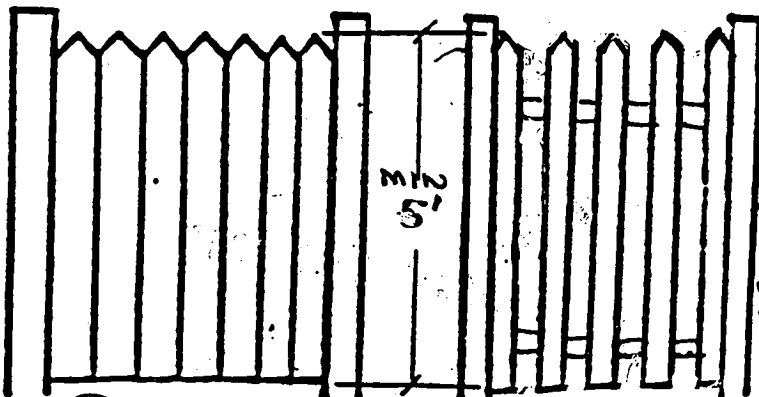

NOTE
MIN
SPACE
4"
WIDE
BETWEEN
PICKETS

PRIVACY

50% Coverage Picket
IN FRONT