

11/3/99
12:30
11/4/99
HST

PERMIT

SEWAGE DISPOSAL SYSTEM

DEPARTMENT OF HEALTH AND MENTAL HYGIENE

P 512790

A REPAIR

DISTRICT

DATE 10-29-99

HOWARD COUNTY HEALTH DEPARTMENT

BUREAU OF ENVIRONMENTAL HEALTH

~~XXXXXX~~

410-313-2640

DATE SYSTEM APPROVED 11/4/99

INSPECTOR CW

05-364094

INDEXED

Jack Fyock Septic Service

IS PERMITTED TO INSTALL ☐ ALTER ☒

ADDRESS P.O. Box 89, Triadelphia Road, Glenelg, Maryland 21737 PHONE 410-988-9270

SUBDIVISION Beaufort Park LOT 7 BIK.C ROAD 8330 Reservoir Road

PROPERTY OWNER Hermine
ADDRESS 8330 Reservoir Road
Fulton, Maryland 21059

SEPTIC TANK CAPACITY GALLONS

NUMBER OF BEDROOMS

SQUARE FEET PER BEDROOM

LINEAR FEET OF TRENCH REQUIRED

REPAIR - PURPOSE - SEPTIC SYSTEM HAS FAILED.

Call for inspection when ground is opened so sanitarian can recommend repair.

10/29/99

PLANS APPROVED BY DATE

COVER NO WORK UNTIL INSPECTED AND APPROVED

NEITHER THE HOWARD COUNTY COUNCIL NOR THE HEALTH DEPARTMENT IS RESPONSIBLE FOR THE SUCCESSFUL OPERATION OF ANY SYSTEM

NOTE: CLEANOUT REQUIRED EVERY 70 FEET OF SEWER LINE AND/OR AT 90° SWEEPS IN LINES FROM HOUSE TO DRAIN FIELDS. 90° ELBOWS NOT ACCEPTABLE.

NOTE: ALL PARTS OF SEPTIC SYSTEMS (I.E. TANK, DISTRIBUTION BOX TRENCHES) TO BE 100 FEET FROM WELL (UNLESS OTHERWISE SPECIFICALLY AUTHORIZED)

NOTE: IF DEEP TRENCH(ES) ARE USED CALL FOR INSPECTION BEFORE AND AFTER PLACING GRAVEL IN TRENCH(ES)

NOTE: NO DRY WELL SHALL EXCEED 15 FOOT IN DIAMETER NO ABSORPTION TRENCH TO EXCEED 100 FEET IN LENGTH

NOTE: ALL PIPE FROM HOUSE TO SEPTIC TANK MUST BE CAST IRON OR SCHEDULE 35/40 PVC OR ABS

PERMIT VOID AFTER TWO YEARS


NOTE: INSTALL STAND PIPE ON SEPTIC TANK AND DRY WELL STAND PIPES MUST BE 6 INCHES IN DIAMETER CAST IRON, CONCRETE OR TERRA COTTA OR PVA OR ABS ACCEPTED. IF TOP OF SEPTIC TANK IS DEEPER THAN 3 FEET, MANHOLE TO GRADE REQUIRED.

NOTE: DISTRIBUTION BOXES MUST HAVE BAFFLES

*INSTALLER IS RESPONSIBLE FOR OBTAINING FINAL APPROVAL ON THIS PERMIT

*CALL 461-9533 FOR INSPECTION OF SEPTIC SYSTEM.

512790

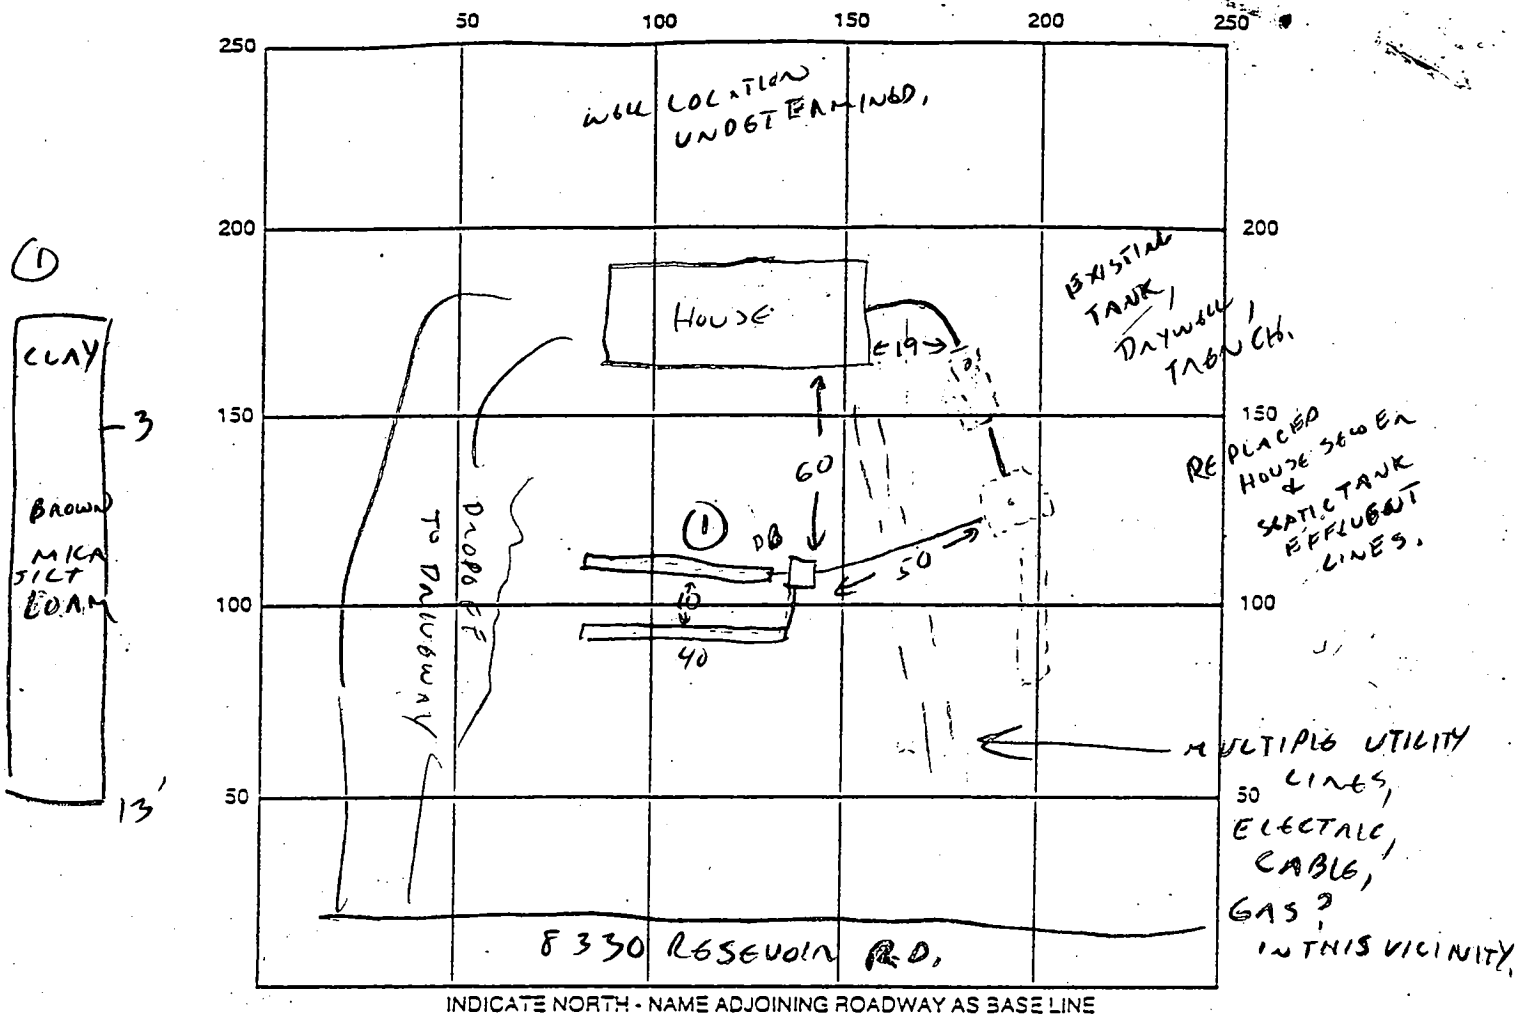

SEPTIC TANK LEVEL EXISTING CLEANOUTS DN + SEPTIC TANK - EXISTING

DISTRIBUTION BOX LEVEL ✓

DRAIN FIELD/TITLE DEPTH 8 FT. TRENCH WIDTH 2 FT. INLET DEPTH 3 FT.

EFFECTIVE GRAVEL DEPTH 5 FT. TOTAL LENGTH 80 FT.

NUMBER OF TRENCHES 2 @ 40 ONE SIDEWALL/BOTTOM AREA 400 SQ. FT. + EXISTING SYSTEM

DRYWALL INSIDE DIAMETER FT. EFFECTIVE DEPTH BELOW INLET FT.

ABSORBENT AREA SQ. FT.

REMARKS: 11/3/99 OVERFLOW LINE ADDED TO DAYWELL FEEDING DISTRIBUTION BOX
SEALING TWO NEW TRENCHES. AREA BETWEEN DRYWELL & DIST BOX UNAVAILABLE
FOR DISPOSAL FIELD INSTALLATION DUE TO MULTIPLE UTILITY LINES. (CW)

11/4 TRENCHES COMPLETE - OK TO COVER. (CW)

DATE SYSTEM APPROVED 11/4/99 INSPECTOR CW

filed

PERMIT

P 19857
A 19768

SEWAGE DISPOSAL SYSTEM

MARYLAND STATE DEPARTMENT OF HEALTH

HOWARD COUNTY

ELLICOTT CITY

4/26/74 *Wish to see house - sewer connection,
and cleanout on ST. see note below*
WU?

DISTRICT 5th

DATE 4/23/74

INDEXED

Jack Frost

IS PERMITTED TO INSTALL ☒ ALTER

ADDRESS Ten Oaks Road, Glenelg, Maryland

PHONE 206-2939

A SEWAGE DISPOSAL SYSTEM LOCATED AT

#8330

SUBDIVISION Beaufort Park

ROAD

Reservoir Road

LOT T, Bk.C, Sec. 3-1

PROPERTY OWNER Mr. W. B. Gidley

Paul Ammons

ADDRESS 6113 Chester Street, Takoma Park, Md. 20012 Phone: 434-0434

SPECIFICATIONS 4 bedrooms

DRAIN FIELD _____ DEPTH _____ FEET. BOTTOM AREA _____ SQ. FT.

SEEPAGE PITS _____ ABSORBENT SIDEWALL AREA _____ SQ. FT. BLDG. PERMIT SIGNED

SEPTIC TANK CAPACITY 1250 GALLONS

AND RETURNED 4/14/74

Final # 479PT

Permit

FOR GARBAGE GRINDER, INCREASE DISPOSAL AREA 22% & TANK CAPACITY 50%.

OTHER DRY WELL - To have 115 sq. ft. effective absorbent sidewall area per
bedroom below inlet. Inlet to be 4 ft. below original grade and minimum depth
11 ft. Locate dry well 100 ft. off right property line and 100 ft. from front
property line when facing lot from road.

NOTE: ALL PIPE FROM HOUSE TO DRY WELL MUST BE CAST IRON.

PERMIT VOID AFTER THREE YEARS.

NOTE: INSTALL STAND PIPE ON SEPTIC TANK AND DRY WELL.

PLANS APPROVED BY Howard Snyder & Chas. B. Stroscher DATE 8/23/72

FILL SEPTIC TANK AND DISTRIBUTION BOX WITH WATER BEFORE CALLING FOR AN INSPECTION. COVER NO WORK UNTIL INSPECTED AND APPROVED.


NEITHER THE HOWARD COUNTY COMMISSIONERS NOR THE HEALTH DEPARTMENT IS RESPONSIBLE FOR THE SUCCESSFUL OPERATION OF ANY SYSTEM.

*Cast iron sewer pipe was installed from house to septic tank
with proper fall and in harmony with county regulations.*

System first before body permit W.B. Gidley
owner

19768

A19768

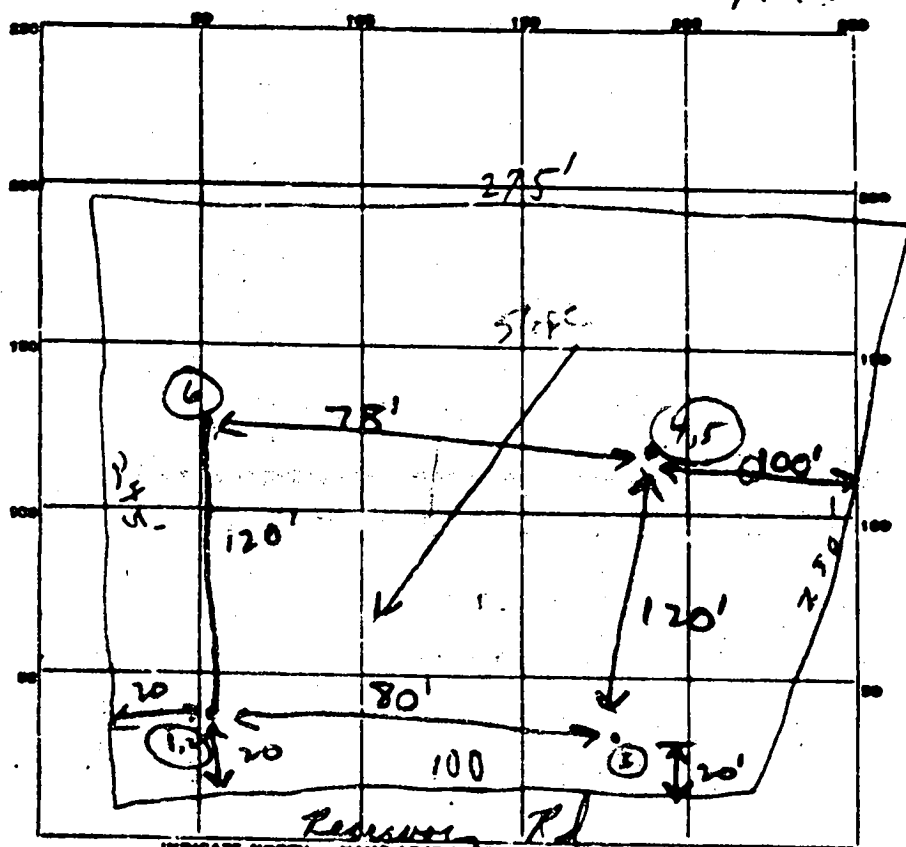

Lot 6 Blk C

DATE	TEST NO.	DEPTH	PRE-WET		TEST - 1" DROP		TIME
			START	STOP	START	STOP	
8/22/72	1	5'	2:51	2:52	2:52	2:54	(2)
	2	11'	2:51	2:53	2:53	2:55	(2)
	3	10 1/2'	Good Soil - Dry				
	4	4 1/2'	3:00	3:02	3:02	3:03	(2)
	5	11'	3:00	3:02	3:02	3:03	(1)
	6	10 1/2'	Good Soil - Dry				

2mm
or

A19768

new locations - observed D.W. being placed up about 35' to right of hole

SOIL AUGER FINDING _____ DW at 4.5
 TESTED BY H. Sauter _____ inlet at 4 1/2'
 REMARKS _____

C 1 3618 THIS REPORT MUST BE SUBMITTED WITHIN 30 DAYS AFTER WELL COMPLETION FILL IN THIS FORM COMPLETELY COUNTY NUMBER A 19768	STATE OF MARYLAND WATER RESOURCES ADMINISTRATION TAVES STATE OFFICE BLDG., ANNAPOLIS, MD. 21401 WELL COMPLETION REPORT	PERMIT NO. FROM "PERMIT TO DRILL WELL" 44-73-0705 25 26 27 28 29 30 31 32 33 34 35 36 37
---	--	---

DATE RECEIVED (WHA USE ONLY) DATE WELL COMPLETED July 27 74	DEPTH OF WELL 40.5 22 170 NEAREST FOOT 24	DRILLER'S IDENTIFICATION NO. 238
---	--	--

OWNER O. M. Miley LAST NAME W. B. STREET OR RFD 143 Cherry St	POST OFFICE Donkirk NY 13055 CITY Donkirk STATE NY
--	---

WELL LOG STATE THE KIND OF FORMATIONS PENETRATED, THEIR COLOR, DEPTH, THICKNESS AND IF WATER BEARING DESCRIPTION (USE ADDITIONAL SHEETS IF NECESSARY) FEET FROM TO	GROUTING RECORD WELL HAS BEEN GROUTED (CIRCLE APPROPRIATE BOX) YES ☒ NO ☐ TYPE OF GROUTING MATERIAL (CIRCLE BOX) CEMENT ☒ PORTLAND CEMENT ☒ NO. OF BAGS 1 NO. OF POUNDS 45 GALLONS OF WATER 45 DEPTH OF GROUT SEAL (TO NEAREST FOOT) FROM 40 TO 40.5 (ENTER 0 IF FROM SURFACE)
---	--

in a 30' case 32' open 9 bags of PM	CASING RECORD CASING TYPES (CIRCLE APPROPRIATE TYPE BELOW) STEEL ☒ CONCRETE ☐ PLASTIC ☐ OTHER ☐ MAIN CASING TYPE ST NOMINAL DIAMETER (TOP INSIDE DIAMETER) 6 TOTAL DEPTH OF MAIN CASING (NEAREST FOOT) 60 61 62 63 64 65 66 67 68 69 70
---	--

30' case 32' open 9 bags of PM	PUMPING TEST HOURS PUMPED TO NEAREST HOUR 2 PUMPING RATE GALLONS PER MINUTE TO NEAREST 100 LPM 1 METHOD USED TO MEASURE PUMPING RATE W WATER LEVEL (DISTANCE FROM LAND SURFACE) BEFORE PUMPING 60 FEET WHEN PUMPING 5 FEET TYPE OF PUMP USED (CIRCLE APPROPRIATE BOX) A AIR ☐ B PISTON ☐ C CENTRIFUGAL ☒ D ROTARY ☐ E OTHER (DESCRIBE BELOW) ☐ J JET ☐ K SUBMERSIBLE ☐
---	--

30' case 32' open 9 bags of PM	PUMP INSTALLED TYPE OF PUMP (CIRCLE APPROPRIATE LETTER) DRILLER WILL INSTALL PUMP (CIRCLE APPROPRIATE BOX) YES ☒ NO ☐ CAPACITY: GALLONS PER MINUTE (TO NEAREST GALLON) PUMP HORSE POWER 1 PUMP COLUMN LENGTH (NEAREST FOOT) 25 26 27 28 29 30 31 32 33 34 35 36 37
---	---

30' case 32' open 9 bags of PM	SCREEN RECORD SCREEN TYPE (CIRCLE APPROPRIATE CODE BELOW) STEEL ☒ BRASS ☐ OPEN HOLE ☐ PLASTIC ☐ OTHER ☐ C 2 DEPTH (NEAREST WHOLE FOOT) 40 41 42 43 44 45 46 47 48 49 50 51
---	---

30' case 32' open 9 bags of PM	CASING HISTORY (CIRCLE APPROPRIATE BOX AND ENTER CASING HEIGHT) ABOVE ☐ BELOW ☒ LAND SURFACE 2 (NEAREST FOOT) LOCATION OF WELL ON LOT SHOW PERMANENT STRUCTURES SUCH AS BUILDINGS, SEPTIC TANKS, AND/OR OTHER LAND MARKS AND INDICATE NOT LESS THAN TWO DISTANCES (MEASUREMENTS TO WELL).
---	--

CIRCLE APPROPRIATE BOXES A WELL WAS ABANDONED AND SEALED WHEN THIS WELL WAS COMPLETED E ELECTRIC LOG OBTAINED F TEST WELL CONVERTED TO PRODUCTION WELL I HEREBY CERTIFY THAT I HAVE COMPLIED WITH ALL CONDITIONS STATED ON THE ABOVE CAPTIONED "PERMIT TO DRILL WELL", AND THE INFORMATION CONTAINED IN THIS REPORT IS TRUE, ACCURATE, AND COMPLETE TO THE BEST OF MY KNOWLEDGE, INFORMATION AND BELIEF. DRILLER'S NAME John Miley LICENSE PRINT John Miley SIGNATURE John Miley	DRAINAGE RECORD IF WELL DRILLED WAS A FLOWING WELL (CIRCLE BOX) YES ☐ NO ☒ DRAINAGE RECORD (DO NOT BE FILLED IN BY DRILLER) YES ☐ NO ☒ TELESCOPE CASING ☐ LOG INDICATED ☐
---	--