

PERMIT

SEWAGE DISPOSAL SYSTEM

MARYLAND STATE DEPARTMENT OF HEALTH

ELLCOTT CITY

DISTRICT 1A

DATE 1/23/73

INDEXED

INDEXED

Barbey A. Watson, Inc.

IS PERMITTED TO INSTALL ☒ ALTER

ADDRESS 109 Elmore Road, Owings Mills, Md. 21117

PHONE 336-7438

A SEWAGE DISPOSAL SYSTEM LOCATED AT

SUBDIVISION

ROAD

Woodstock Road

LOT 1

PROPERTY OWNER William H. Brown, Jr.

ADDRESS Woodstock Road, Woodstock, Md.

SPECIFICATIONS

4 bedrooms

DRAIN FIELD DEPTH FEET, BOTTOM AREA SQ. FT.

SEEPAGE PITS ABSORBENT SIDE WALL AREA SQ. FT.

SEPTIC TANK CAPACITY 1250 GALLONS

FOR GARBAGE GRINDER, INCREASE DISPOSAL AREA 22% & TANK CAPACITY 50%

OTHER Tile Field - 400 sq. ft. bottom area with a maximum depth of 4 ft.
Place the tile field between 140 ft. and 155 ft. from the front lot line and
between 20 ft. and 90 ft. from the right side of the front lot as seen when
facing the lot from Woodstock Road.

NOTE: ALL PIPE FROM HOUSE TO SEPTIC TANK MUST BE CAST IRON.
PERMIT VOID AFTER THREE YEARS.

NOTE: INSTALL STAND PIPE ON SEPTIC TANK.
PIPE

PLANS APPROVED BY Raymond Hodges

DATE 1/23/73 7/12/71

FILL SEPTIC TANK AND DISTRIBUTION BOX WITH WATER BEFORE CALLING FOR AN INSPECTION. COVER NO WORK
UNTIL INSPECTED AND APPROVED.


NEITHER THE HOWARD COUNTY COMMISSIONERS NOR THE HEALTH DEPARTMENT IS RESPONSIBLE FOR THE
SUCCESSFUL OPERATION OF ANY SYSTEM.

WDOG PERMITS SIGNED
AND RETURNED 6-1-99
Serial # B70118279

15767

5128645

PERMIT

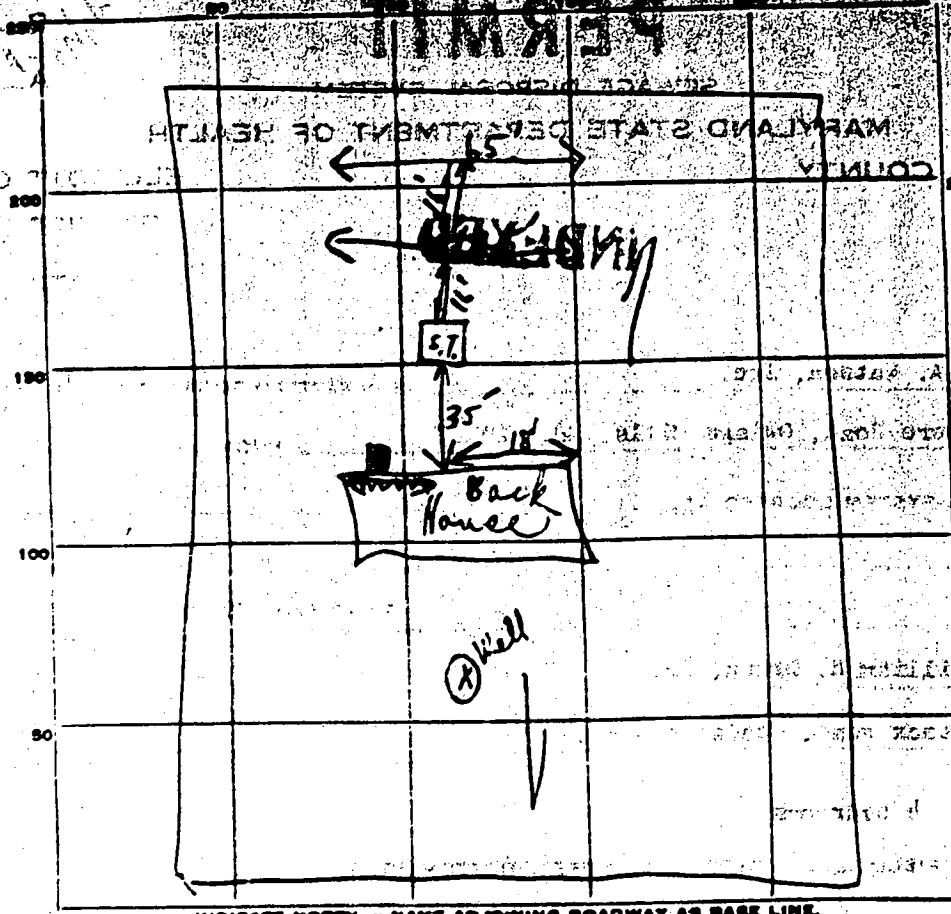

PERMIT CARD 3/2/73

SEPTIC TANK, LEVEL Yes

DISTRIBUTION BOX, LEVEL Yes

TILE FIELD, DEPTH FT. TRENCH WIDTH FT.


GRAVEL DEPTH IN. TOTAL LENGTH FT.

NUMBER OF TRENCHES 2 TOTAL BOTTOM AREA SQ. FT.

SEEPAGE PITS, INSIDE DIAMETER FT. DEPTH BELOW INLET FT.

65
13' wide
195
195
390
48
138 sq. ft.

REMARKS 3/2/73 Well located on this lot No good G.R.C. gravel
6" to 8" gravel under pipe (2" to 4" thick) OK to cover
Note - more lead caulking needed around dismountable
shroud in & sealed lower area - cross

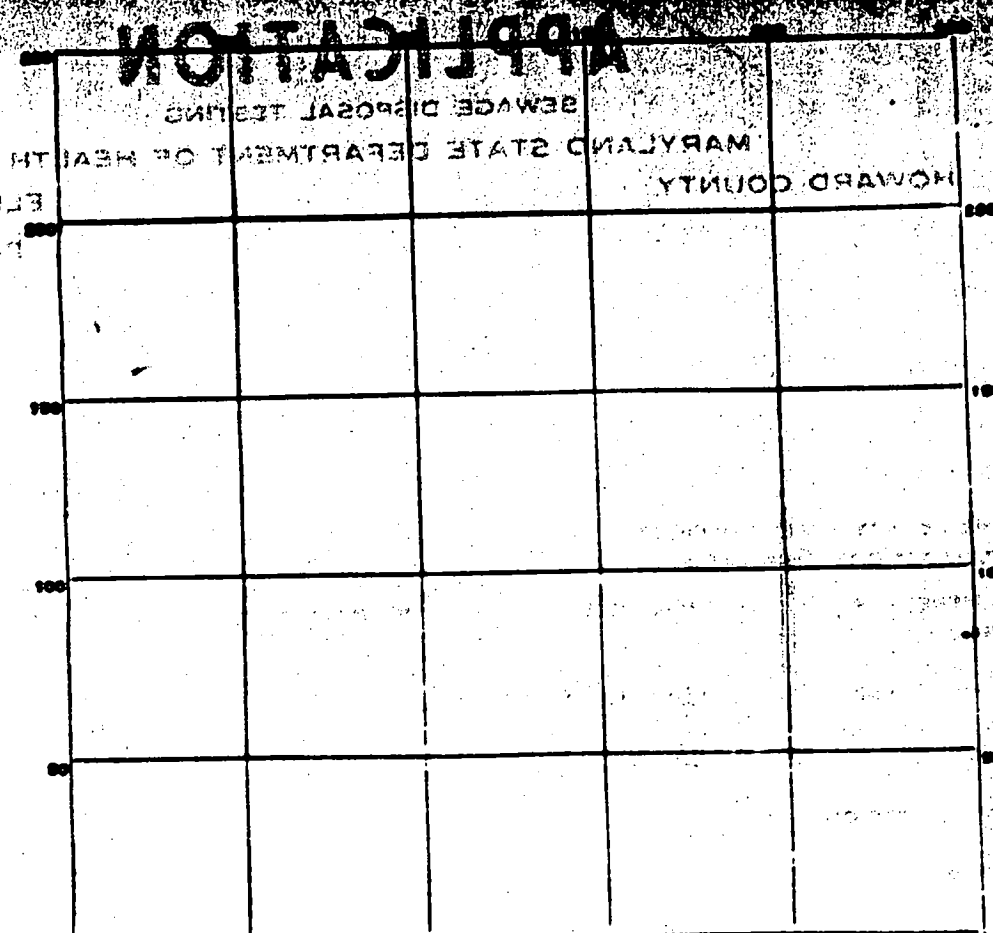

INDICATE NORTH - NAME ADJOINING ROADWAY AS CASE LINE.

DATE	TEST NO.	DEPTH	PRE-WET		TEST - 1" DROP		TIME
			START	STOP	START	STOP	
7/2/71	1	10 1/2	1019	1022	1022	30	8
3/2/71	2	6	1021	1022	1022	1045	3
	3	10 1/2	1027	1032	1032	1033	3
	4	6	1028	1033	1033	1033	3
	1A	12	UNDER GROUND WATER CAME IN TO 1 1/2 FT				
	5	12	ALL SAND NO WATER				

AV
in
An


SOIL AUGER FINDING

TESTED BY Lot 1

REMARKS Must Check Well location on Zapp list

WOODSTOCK ROAD

A15767

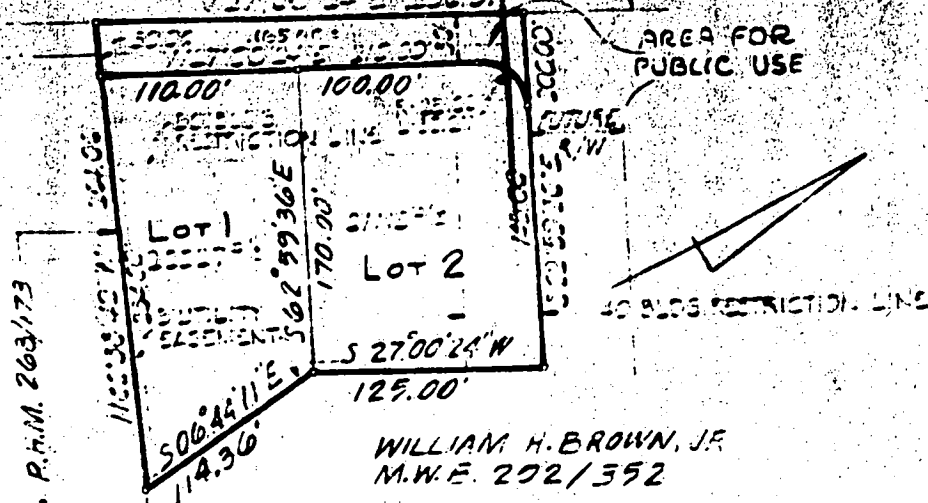

EDWARD R. POPEWIFE
R.H.M. 258/173

WILLIAM H. BROWN, JR.
M.W.E. 202/352

SCALE: 1" = 100'

OWNER:

W. HOWARD BROWN, JR.
1708 WOODSTOCK ROAD
BONN
WOODSTOCK, MARYLAND

NOTE:

1. PROPERTY SHOWN HEREON
LOCATED ON TAX MAP #10 PARCEL 42
2. TITLE REFERENCE M.W.E. 202/352

APPROVED: *[Signature]* DATE: July 8/1971
COUNTY HEALTH OFFICER

APPROVED: *[Signature]* DATE: 7-12-71
PLANNING DIRECTOR



[Signature]
WILLIAM G. ROSCH II REG. NO. 4579
PURDUM AND JESCHKE
ENGINEERS AND LAND SURVEYORS
3697 PARK AVENUE
ELLCOTT CITY, MARYLAND 21043


OWNERS CERTIFICATE:

I, THE UNDERSIGNED OWNER OF THE PROPERTY SHOWN HEREON, MY HEIRS OR ASSIGNS, ADOPT THIS PLAN OF SUBDIVISION AND DO HEREBY ESTABLISH THE BUILDING SETBACK RESTRICTION LINE SHOWN HEREON IN ORDER TO COMPLY WITH THE GENERAL PLAN OF HIGHWAYS OF HOWARD COUNTY.

[Signature]

D-462H

A15767

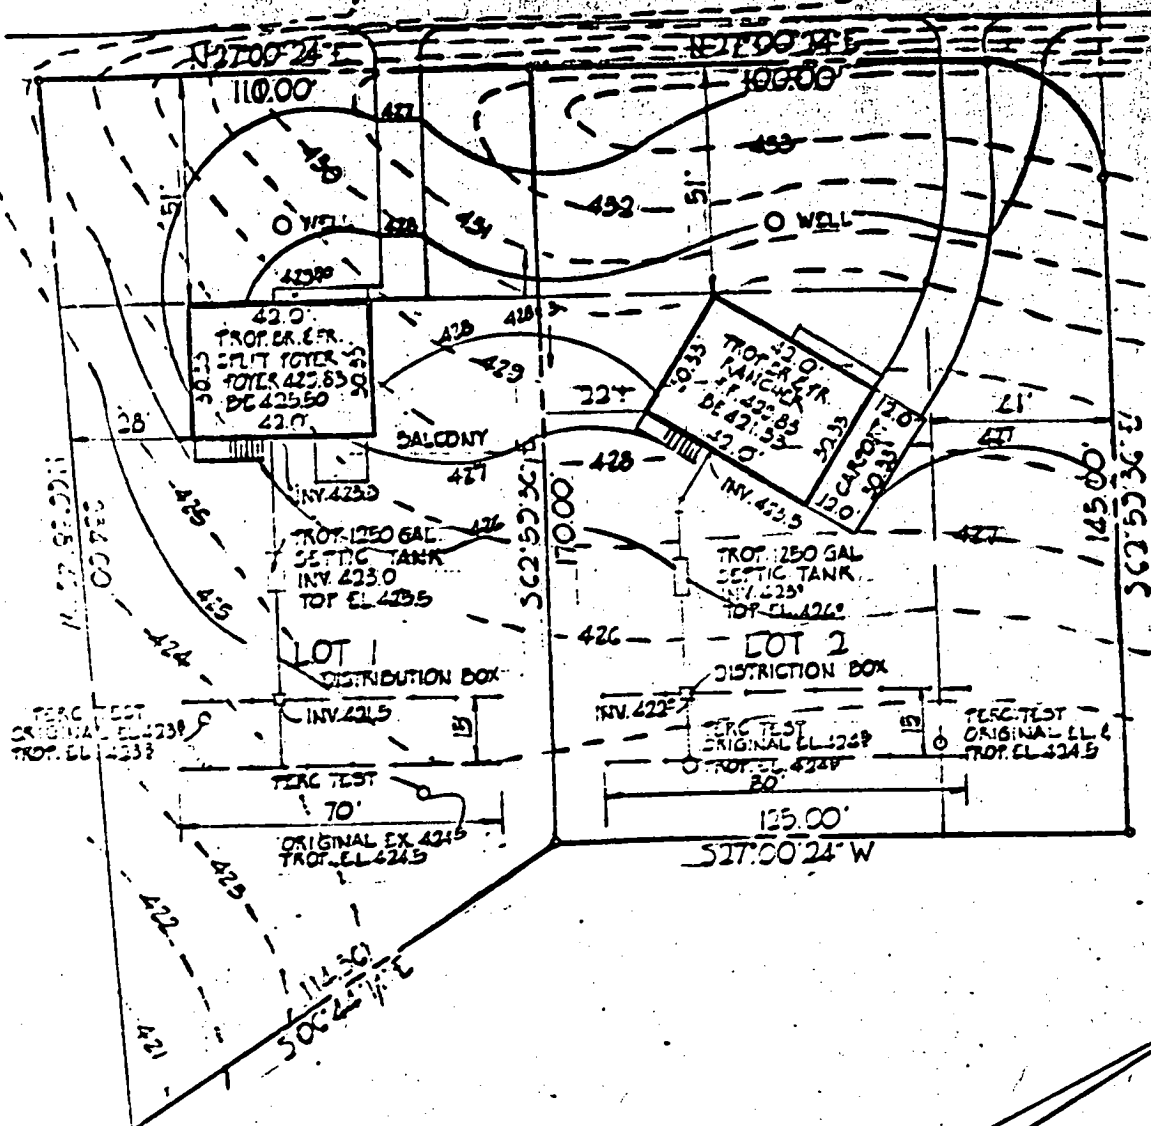

Approved.
1-1-1911
R. H. [unclear]

Purdum and Jeschke
Engineers
5697 Park Avenue
Ellicott City, Maryland 21043

PLOT PLAN TO ACCOMPANY
APPLICATION FOR BUILDING
PERMIT -
PROPERTY OF
W. HOWARD BROWN JR.
2ND. ELECTION DISTRICT
HOWARD COUNTY, MD.
SCALE 1"=40' NOV. 23, 1971

C 1 5312

THIS NUMBER IS TO BE PRINTED IN COLS. 3-6 ON ALL TAGS

DATE RECEIVED (DRIVER ONLY)

SEQUENCE NO. (OWNER USE ONLY)

STATE OF MARYLAND
DEPARTMENT OF WATER RESOURCES
STATE OFFICE BLDG. ANNAPOLIS, MARYLAND 21401
WELL COMPLETION REPORT

FILL IN THIS FORM COMPLETELY

1515161

March 16 73

83

40-23-1111

DRILLERS IDENTIFICATION NO.

270

OWNER Home Ted Cons CO.
LAST NAME 1304 Prince George Rd
STREET OR RFD Baltimore Md
CITY OR TOWNSHIP Baltimore Md

WELL LOG
STATE THE KIND OF FORMATIONS PENETRATED, THEIR COLOR, DEPTH, THICKNESS AND IF WATER BEARING

DESCRIPTION (USE ADDITIONAL SHEETS IF NECESSARY)	FEET		CHECK IF WATER BEARING
	FROM	TO	

ROUTING RECORD
WELL HAS BEEN GROUTED (CIRCLE APPROPRIATE BOX)
TYPE OF GROUTING MATERIAL (CIRCLE BOX)
CEMENT CM BENTONITE CLAY BC
NO. OF BAGS 13 NO. OF POUNDS 1200
BAGS OF WATER 70
DEPTH OF GROUT SEAL (TO NEAREST FOOT)
FROM 0 FT. TO 32 FT.
ENTER 0 IF FROM SURFACE

CASING RECORD
INSERT APPROPRIATE CODE BELOW
STEEL ST CONCRETE CO
PLASTIC PL OTHER OT

MAIN CASING TYPE ST NOMINAL DIAMETER TOP (MAIN) CASING (NEAREST INCH) 6 TOTAL DEPTH OF MAIN CASING (NEAREST FOOT) 44

OTHER CASING (IF USED)
DIA. (INCH) DEPTH (FEET)
FROM TO

SCREEN RECORD
INSERT APPROPRIATE CODE BELOW
STEEL ST BRASS OR BRONZE BR OPEN HOLE HO
PLASTIC PL OTHER OT

DEPTH (NEAREST WHOLE FOOT)
FROM TO

SLOT SIZE 1. 2. 3.

DIAMETER OF SCREEN (NEAREST INCH)
FROM TO

GRAVEL PACK IF WELL DRILLED WAS A FLOWING WELL (CIRCLE BOX) F

OUR USE ONLY (NOT TO BE FILLED IN BY DRILLER)
(E.P.O.S.)
TELESCOPE CASING 70 LOG INDICATOR 72 OTHER DATA AVAILABLE 74 75 76

PUMPING TEST

HOURS PUMPED (TO NEAREST HOUR) 4
PUMPING RATE GALLONS PER MINUTE TO NEAREST GALLON 11
METHOD USED TO MEASURE PUMPING RATE Pressure

WATER LEVEL (DISTANCE FROM LAND SURFACE)
BEFORE PUMPING 17 (NEAREST FOOT)
WHEN PUMPING 22 (NEAREST FOOT)

TYPE OF PUMP USED (CIRCLE APPROPRIATE BOX)
A AIR 27 D PISTON 27 T TURBINE 27
C CENTRIFUGAL 27 R ROTARY 27 O OTHER (DESCRIBE BELOW)
J JET 27 S SUBMERSIBLE 27
Acme pump

PUMP INSTALLED
TYPE OF PUMP (WRITE APPROPRIATE LETTER IN BOX - SEE ABOVE: A, C, J, P, R, S, T, O)

DRILLER WILL INSTALL PUMP (CIRCLE APPROPRIATE BOX) YES Y NO N
CAPACITY: GALLONS PER MINUTE (TO NEAREST GALLON) 31
PUMP HORSE POWER 37
PUMP COLUMN LENGTH (NEAREST FOOT) 43

CASING HEIGHT (CIRCLE APPROPRIATE BOX AND ENTER CASING HEIGHT)
+ ABOVE LAND SURFACE 2 (NEAREST FOOT)
- BELOW 40

LOCATION OF WELL ON LOT
SHOW PERMANENT STRUCTURE SUCH AS BUILDINGS, SEPTIC TANKS, AND/OR OTHER LAND MARKS AND INDICATE NOT LESS THAN TWO DISTANCES (MEASUREMENTS TO WELL).

CIRCLE APPROPRIATE BOXES
A WELL WAS ABANDONED AND SEALED WHEN THIS WELL WAS COMPLETED
E ELECTRIC LOG OBTAINED
C COPY OF ELECTRIC LOG ATTACHED

I HEREBY CERTIFY THAT I HAVE COMPLIED WITH ALL CONDITIONS STATED IN THE ABOVE-CAPTIONED "PERMIT TO DRILL WELL", AND THAT INFORMATION CONTAINED IN THIS REPORT IS TRUE, ACCURATE, AND COMPLETE TO THE BEST OF MY KNOWLEDGE, INFORMATION AND BELIEF.

DRILLERS NAME
PLEASE PRINT
SIGNATURE

BUILDING DESCRIPTION - <u>COMMERCIAL</u>		BUILDING DESCRIPTION - <u>RESIDENTIAL</u>	
<u>Building Characteristics</u> Height: _____ No. of stories: _____ Gross area, sq. ft. per floor: _____ Use group: _____ Construction type: _____ Reinforced Concrete _____ Structural Steel _____ Masonry _____ Wood Frame _____ State Certified Modular	<u>Utilities</u> Water Supply: _____ Public _____ Private Sewage Disposal: _____ Public _____ Private Electric Yes ☐ No ☐ Gas Yes ☐ No ☐ Heating System: Electric ☐ Oil ☐ Natural Gas ☐ Propane Gas ☐ Sprinkler system: N/A ☐ _____ Full _____ Partial _____ Other Suppression _____ # of Heads	<u>Building Characteristics</u> SF Dwelling ☐ SF Townhouse ☐ <u>Depth</u> _____ <u>Width</u> _____ 1st floor: _____ 2nd floor: _____ Basement: _____ Finished Basement ☐ Unfinished Basement ☐ Crawl space ☐ Slab on Grade ☐ No. of Bedrooms: _____ Multi-family dwellings: No. of efficiency units: _____ No. of 1 BR units: _____ No. of 2 BR units: _____ No. of 3 BR units: _____ Other Structure: _____ Dimensions: _____ Footings: _____ Roof: _____ _____ State Certified Modular Manufactured Home	<u>Utilities</u> Water Supply: <u>X</u> Public _____ Private Sewage Disposal: <u>X</u> Public _____ Private Electric Yes ☐ No ☐ Gas Yes ☐ No ☐ Heating System: Electric ☐ Oil ☐ Natural Gas ☐ Propane Gas ☐ Sprinkler system: N/A ☐ _____ NFPA #13D _____ NFPA #13R _____ Other:

THE UNDERSIGNED HEREBY CERTIFIES AND AGREES AS FOLLOWS: (1) THAT HE/SHE IS AUTHORIZED TO MAKE THIS APPLICATION; (2) THAT THE INFORMATION IS CORRECT; (3) THAT HE/SHE WILL COMPLY WITH ALL REGULATIONS OF HOWARD COUNTY, WHICH ARE APPLICABLE THEREAFTER; (4) THAT HE/SHE WILL PERFORM NO WORK ON THE ABOVE REFERENCED PROPERTY NOT SPECIFICALLY DESCRIBED IN THIS APPLICATION; (5) THAT HE/SHE OR ANY OTHER PERSONS OWING A TITLE RIGHT TO THE PROPERTY


THIS PROPERTY FOR THE PURPOSE OF INSPECTING THE WORK PERMITTED AND POSTING NOTICES.

[Signature]
Applicant's Signature

B. J. Spelling
Print Name

57.99

Title/Company		Date	
Checks payable to: DIRECTOR OF FINANCE OF HOWARD COUNTY ** PLEASE WRITE NEATLY AND LEGIBLY. ** FOR OFFICE USE ONLY-			
AGENCY	DATE	SIGNATURE APPROVAL	DPZ SETBACK INFORMATION
Land Development DPZ			Front: _____
State Highways			Rear: _____
Building Official			Side: _____
Dev. Engineering DPZ			Side St: _____
Health	6/11/99	A. M. M. P. O. O.	All minimum setbacks met?
Fire Protection			YES ☐ NO ☐
Is Sediment Control approval required prior to issuance?			Is Entrance Permit required?
YES ☐ NO ☐			YES ☐ NO ☐
CONTINGENCY CONSTRUCTION START ☐			Historic District?
ONE STOP SHOP ☐			YES ☐ NO ☐
			Lot Coverage for New Town Zone _____
			SEPP/Red-line approval date _____
			Accepted by _____
Distribution of Copies: _____		White: Building Official	Green: LDD, DPZ
		Yellow: DED, DPZ	Pink: Health
		Gold: SHA	

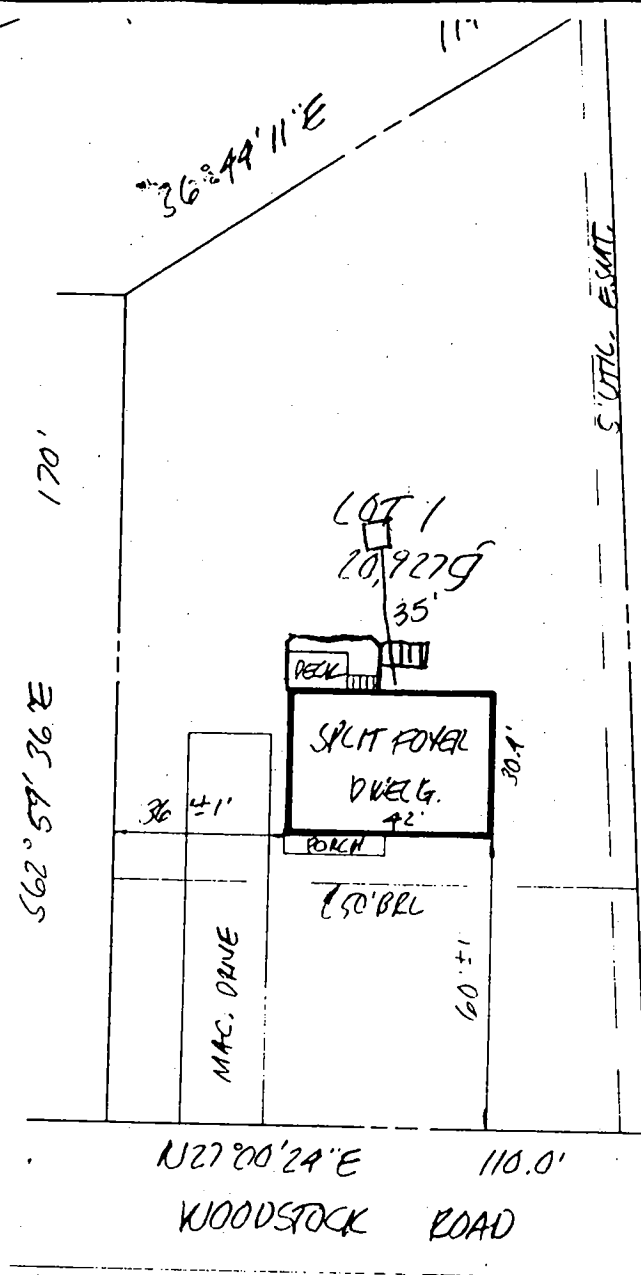

234.0'

N66°38'42\"W

5/1/99
shown deck will
have no impact to
the existing well/
septic
A. McNeil

NOTE: THIS PROPERTY LIES
IN FLOOD ZONE C. AN AREA
OF MINIMAL FLOODING, AS
DELINEATED ON THE MAPS
OF THE NATIONAL FLOOD
INSURANCE PROGRAM

Notes:

- 1) This plat is of benefit to a consumer only insofar as it is required by a lender or a title insurance company or its agent in connection with contemplated transfer financing or refinancing
- 2) This plat is not to be relied upon for the establishment or location of fences, garages, buildings or other existing or future improvements
- 3) This plat does not provide for the accurate identification of property boundary lines but such identification may not be required for the transfer of title or securing financing or refinancing
- 4) No title report furnished.

Certification: This is to certify that the improvements indicated hereon are located as shown.

Graden A. Rogers
GRADEN A. ROGERS - Prop. L.S. MD. Lic. No. 119

LIBER 634 FOLIO 37
LOT 1 BLOCK SECT PLAT
PLAT ENTITLED (MINOR SUB - BROWN PROPERTY)
RECORDED IN HOWARD CO.
PLAT BOOK LIBER 603 FOLIO 723

1845 WOODSTOCK RD.

MD. SCALE 1" = 40' CASE NO 96-07-0673K
DATE 7-9 1996 JOB NO MS496686

