

PERMIT

SEWAGE DISPOSAL SYSTEM

DEPARTMENT OF HEALTH AND MENTAL HYGIENE

P _____

A 513203-0

DISTRICT _____

DATE _____

HOWARD COUNTY HEALTH DEPARTMENT

BUREAU OF ENVIRONMENTAL HEALTH

~~XXXXXXX~~

410-313-2640

INDEXED

DATE SYSTEM APPROVED _____

INSPECTOR _____

RPS # 300293

IS PERMITTED TO INSTALL _____ ALTER _____

ADDRESS _____ PHONE _____

SUBDIVISION Wayside Estates LOT 2 ROAD 3584 Scheel Drive

PROPERTY OWNER _____

ADDRESS _____

PLANS APPROVED BY _____ DATE _____

COVER NO WORK UNTIL INSPECTED AND APPROVED

NEITHER THE HOWARD COUNTY COUNCIL NOR THE HEALTH DEPARTMENT IS RESPONSIBLE FOR THE SUCCESSFUL OPERATION OF ANY SYSTEM

NOTE: CLEANOUT REQUIRED EVERY 70 FEET OF SEWER LINE AND/OR AT 90° SWEEPS IN LINES FROM HOUSE TO DRAIN FIELDS, 90° ELBOWS NOT ACCEPTABLE.

NOTE: ALL PARTS OF SEPTIC SYSTEMS (I.E. TANK, DISTRIBUTION BOX TRENCHES) TO BE 100 FEET FROM WELL (UNLESS OTHERWISE SPECIFICALLY AUTHORIZED)

NOTE: IF DEEP TRENCH(ES) ARE USED CALL FOR INSPECTION BEFORE AND AFTER PLACING GRAVEL IN TRENCH(ES)

NOTE: NO DRY WELL SHALL EXCEED 15 FOOT IN DIAMETER NO ABSORPTION TRENCH TO EXCEED 100 FEET IN LENGTH

NOTE: ALL PIPE FROM HOUSE TO SEPTIC TANK MUST BE CAST IRON OR SCHEDULE 35/40 PVC OR ABS

PERMIT VOID AFTER TWO YEARS

NOTE: INSTALL STAND PIPE ON SEPTIC TANK AND DRY WELL STAND PIPES MUST BE 6 INCHES IN DIAMETER CAST IRON, CONCRETE OR TERRA COTTA OR PVA OR ABS ACCEPTED. IF TOP OF SEPTIC TANK IS DEEPER THAN 3 FEET, MANHOLE TO GRADE REQUIRED.

NOTE: DISTRIBUTION BOXES MUST HAVE BAFFLES

*INSTALLER IS RESPONSIBLE FOR OBTAINING FINAL APPROVAL ON THIS PERMIT

HD-260(6-90)

*CALL 461-9933 FOR INSPECTION OF SEPTIC SYSTEM.


PERMIT SIGNED
AND RETURNED 1/28/99
beck

513203-0

NOTES:

1. This plat is of benefit to a consumer only insofar as it is required by a lender or a title insurance company or its agent in connection with contemplated transfer, financing or re-financing.
2. This plat is not to be relied upon for the established or location of fences, garages, buildings, or other existing or future improvements.
3. This plat does not provide for accurate identification of property boundary lines, but such identification may not be required for the transfer of title or securing financing or refinancing.
4. This plat was prepared in accordance with the plat of subdivision and/or deed as recorded in the Land Records of the county in which the property is located.
5. The title report was not furnished; The property shown hereon is subject to easements and right-of-way(s) of record.
6. The location and size of improvements shown hereon are approximate and are for informational purposes only and details of the site not shown hereon are not considered significant by this office and thus are not shown.
7. Legend: OH.- building overhang; D.- deck; S.- stoop; W.- walkway; P.- patio; AW.- aerial wire(s); P.L.- property line; BW.- bay window; CHM.- chimney; HW.- window well; SW.- stairwell; G.- gas meter; OR.- oriel.
8. Accuracy of apparent setback distance = $\pm 1'$

Note: This property lies within Flood Zone C, an area of Minimal flooding, as established by the National Flood Insurance Program, (F.E.M.A.)

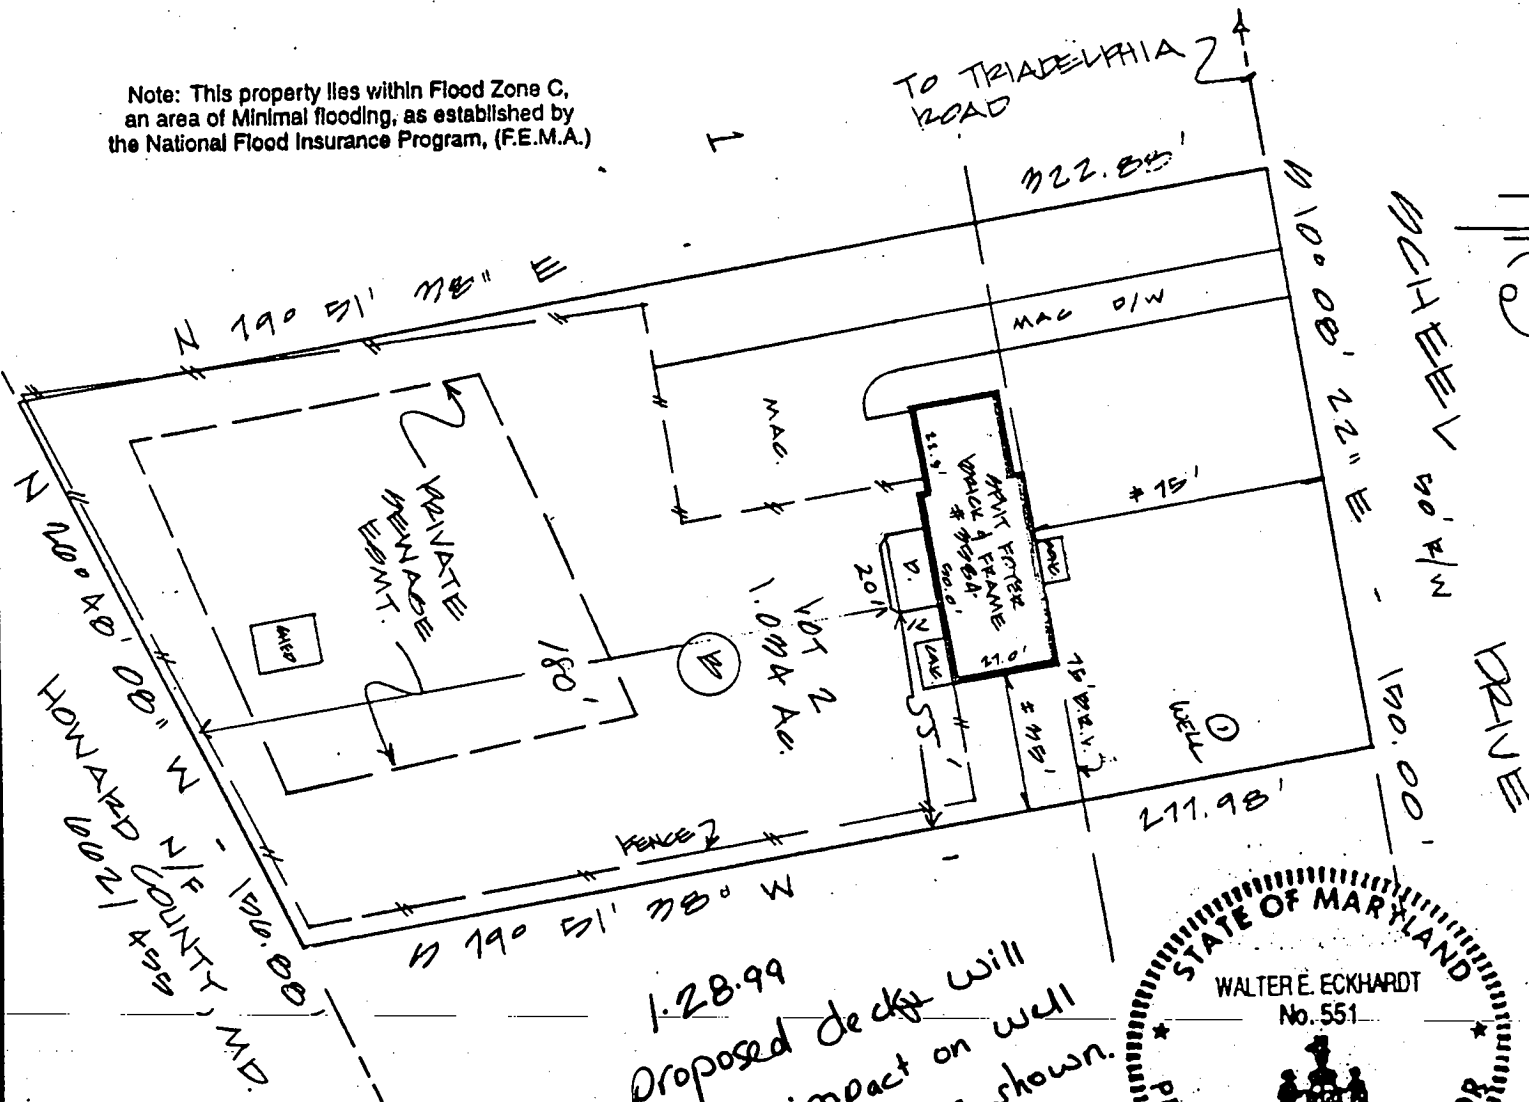

HOUSE LOCATION

#0004 SCHEEL DRIVE
LOT 2, BLOCK "B"
"WAYSIDE ESTATES"
SECTION 1, AREA 1
WAT CMP No. 0040

MD District
Howard County, Maryland


1-28-99
Proposed deck will
have no impact on well
and septic as shown.
KM

C.P. No. 240044 0021 B
MAP REV.: DEC 4, 1980

CERTIFICATION:

I certify, to the best of my knowledge and belief, that the existing visible improvements shown hereon have been established by accepted land surveying practices and that unless otherwise shown there are no visible encroachments.

Walter E. Eckhardt
Property Line Surveyor, Md. Reg. No. 551

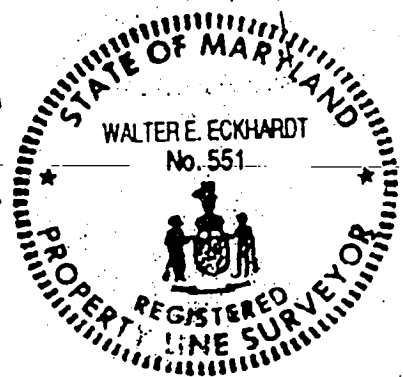

MSI METROPOLITAN SURVEYS, INC.

11262 Georgia Ave. • Suite 10:
Wheaton, MD 20902
(301) 929-8195
FAX: (301) 929-8197

Case: H90-04-025 File: 4-188-90 Ck: 115 Dm: W Scale: 1" = 50' Date: 7.2.90