## PERMI

## SEWAGE DISPOSAL SYSTEM

### DEPARTMENT OF HEALTH AND MENTAL HYGIENE

Α	513203-V	

	DISTRICT
•	

HOWARD COUNTY HEALTH DEPARTMENT BUREAU OF ENVIRONMENTAL HEALTH

XXXXXXXXX

WUEXED 410-313-2640

DATE SYSTEM APPROVED

DATE

	RPS# 282821			INSPECTOR			
				IS PEF	IMITTED TO INSTALL	ALTER	
ADDRESS		_ , <del> </del>			PHONE		
SUBDIVISION	· · · · · · · · · · · · · · · · · · ·	LOT	<u></u>	ROAD	2555 Sand H	ill Road	
PROPERTY OWNER	Chris & Wayı	nne Hayes		· · · · · · · · · · · · · · · · · · ·			
ANNRESS				· .			·
							•
				•			

COVER NO WORK UNTIL INSPECTED AND APPROVED

NEITHER THE HOWARD COUNTY COUNCIL NOR THE HEALTH DEPARTMENT IS RESPONSIBLE FOR THE SUCCESSFUL OPERATION OF ANY SYSTEM

NOTE: CLEANOUT REQUIRED EVERY 70 FEET OF SEWER LINE AND/OR AT 90° SWEEPS IN LINES FROM HOUSE TO DRAIN FIELDS, 90° ELBOWS NOT ACCEPTABLE.

NOTE: ALL PARTS OF SEPTIC SYSTEMS (I.E. TANK, DISTRIBUTION BOX TRENCHES) TO BE 100 FEET FROM WELL (UNLESS OTHERWISE SPECIFICALLY AUTHORIZED)

NOTE: IF DEEP TRENCH(ES) ARE USED CALL FOR INSPECTION BEFORE AND AFTER PLACING GRAVEL IN TRENCH(ES)

NOTE: NO DRY WELL SHALL EXCEED 15 FOOT IN DIAMETER NO ABSORPTION TRENCH TO EXCEED 100 FEET IN LENGTH

NOTE: ALL PIPE FROM HOUSE TO SEPTIC TANK MUST BE CAST IRON OR SCHEDULE 35/40 PVC OR ABS

PERMIT VOID AFTER TWO YEARS

NOTE: INSTALL STAND PIPE ON SEPTIC TANK AND DRY WELL STAND PIPES MUST BE 6 INCHES IN DIAMETER CAST IRON. CONCRETE OR TERRA COTTA OR PVA OR ABS ACCEPTED. IF TOP OF SEPTIC TANK IS DEEPER THAN 3 FEET. MANHOLE TO GRADE REQUIRED.

NOTE: DISTRIBUTION BOXES MUST HAVE BAFFLES


Kitchen remod deck

DATE

\*INSTALLER IS RESPONSIBLE FOR OBTAINING FINAL APPROVAL ON THIS PERMIT \*CALL 461-9933 FOR INSPECTION OF SEPTIC SYSTEM.

PLANS APROVED BY.

# LANDTECH ASSOCIATES, INC. 1410 CHAIN HIGHMAY M.H. SUITE TO GLEN SUMME, MARY LAKE EDGI (DI) 766-2121

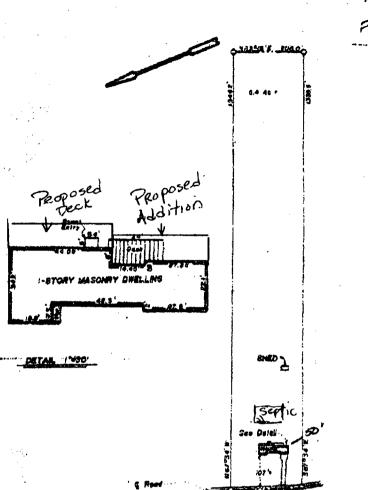

To Richard Canquel Fr. Wynne Hayes

a/23/98
proposed
addition or
as ishownphase not impact
existing septic
system (243)

## Sand Hill Road

LORD CO. D. CO. D. C.	2555 Sand Hill Rd. Ellicott City , Md.
distributed in This is to control that the improvements indicated increase are imported as drawn. This is not a presently this correction of function are any other improvement. It is used for the creation of function are any other improvement. It leaders	
MOTE No fills report furnished.	DELINEATED ON THE MADE
	NOTE: This property lies In Flood Zone C, an area Of Minimal Flooding, as Delineated on the Macr

#### SITE INSPECTION SHEET

OWNER:C	hn's Hayes	DATE REQUESTED: 4/2	3/98@3:00
ADDRESS:	2555 Sand Hill Rd	DRILLER: N/A	<u>,</u>
	Ellicott City	WELL TAG # N/A	
	us mapillo P.68	COUNTY #	
PROPOSAL:	application received for	building permit fo	or addition
to exist	ing dwelling - NO Hoalt	n Dept. records of	ofile.
	LOCATION DIA	AGRAM	
			• .
•			
	•		
		,	
•	Q D W-40		
	%€1± 10,8,7.00		·
	, 40/±		
		·	
•			`
	Sand Hill Road	<del>-</del>	. "
			· · · · · · · · · · · · · · · · · · ·
•			, , , , , , , , , , , , , , , , , , ,
COMMENTS:	met awner @ Site - con	firmed location of	existing '
SEPHIC	system. Location of se	phic system not	in confirct
wi prop	oosed addition. Property	is served by pu	blic water.
OK to	proceed w/ building	permit approval.	
DATE:	9/23/98	INSPECTOR:	ucmos