

Per #30

4/30/71
after 12 noon

INDEXED

PERMIT

SEWAGE DISPOSAL SYSTEM

MARYLAND STATE DEPARTMENT OF HEALTH

HOWARD COUNTY

ELLICOTT CITY

DISTRICT 1

DATE 4/28/71

01-160621

Thompson's Plumbing & Heating IS PERMITTED TO INSTALL ☒ ALTER

ADDRESS 4918 Orchard Drive, Ellicott City, Md. PHONE 465-0881

A SEWAGE DISPOSAL SYSTEM LOCATED AT

SUBDIVISION ROAD 6159 River Rd Bowdoin (see application for better directions) LOT

PROPERTY OWNER Daniel Bruno

ADDRESS

SPECIFICATIONS - 3 bedrooms

DRAIN FIELD DEPTH FEET. BOTTOM AREA SQ. FT.

SEEPAGE PITS ABSORBENT SIDE-WALL AREA SQ. FT.

SEPTIC TANK CAPACITY 1,000 GALLONS

FOR GARBAGE GRINDER, INCREASE DISPOSAL AREA 22% & TANK CAPACITY 50%.

OTHER Dry well 414 sq. ft. absorbent sidewall area to begin below the inlet pipe. Inlet pipe must be 3 to 4 ft. below original grade. Max. depth permitted for dry well below original grade is 13 ft. Place dry well 276 ft. from the point where the two 234.30 parts of rear lot line meet and 120 ft. to the left of the improved lane as seen when facing lot from Bowdoin Road.

NOTE: ALL PIPE FROM HOUSE TO SEPTIC TANK MUST BE CAST IRON.

PLANS APPROVED BY Palmer Wine DATE 6/28/67

NOTE: ALL PERMIT VOID AFTER THREE YEARS.


FILL SEPTIC TANK AND DISTRIBUTION BOX WITH WATER BEFORE CALLING FOR AN INSPECTION. COVER NO WORK UNTIL INSPECTED AND APPROVED.

NEITHER THE HOWARD COUNTY COMMISSIONERS NOR THE HEALTH DEPARTMENT IS RESPONSIBLE FOR THE SUCCESSFUL OPERATION OF ANY SYSTEM.

4518625-5
A 12432

(5) five feet deep
below basement steps,
wall sill

18
9.5
240
432
156.0

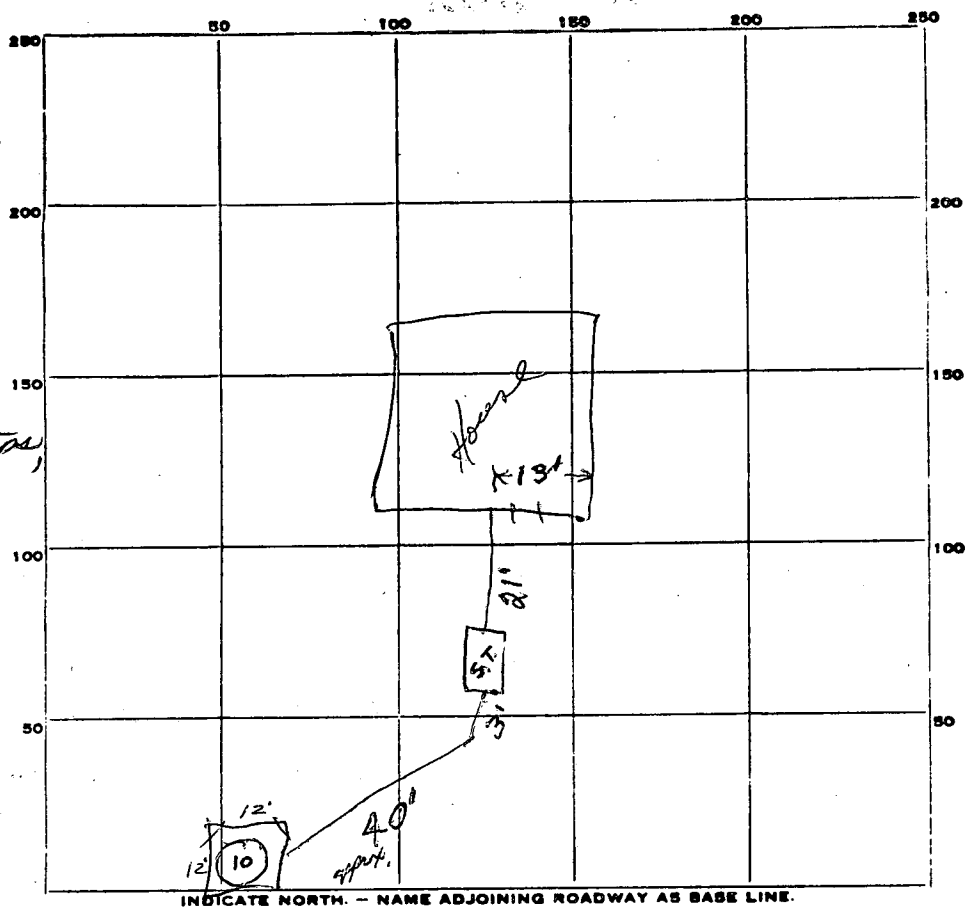

PERMIT CARD ☒

SEPTIC TANK, LEVEL ☒ CLEANOUTS no

DISTRIBUTION BOX, LEVEL ☒

PILE FIELD, DEPTH _____ FT. TRENCH WIDTH _____ FT.

GRAVEL DEPTH _____ IN. TOTAL LENGTH _____ FT.

NUMBER OF TRENCHES _____ TOTAL BOTTOM AREA _____

SEEPAGE PITS, INSIDE DIAMETER 12 ft. 8 in. FT. DEPTH BELOW INLET 9 FT.

ABSORBENT AREA 420 + SQ. FT.

REMARKS 4-30-71 clean out cap needed, clean out needed for septic tank
with plug, removable, ok to cover dry well & line from
house to septic tank & from septic tank to dry well & L.
9/24/71 Clean out cap & clean out on septic tank, c.c.s.

DATE SYSTEM APPROVED 9/24/71 INSPECTOR C. V. Meaker

APPLICATION

SEWAGE DISPOSAL TESTING

MARYLAND STATE DEPARTMENT OF HEALTH

HOWARD COUNTY

ELLICOTT CITY

Septic Tank - 3 bedrooms - 750 gal
1000
4 bedrooms - 1000 gal

DISTRICT 1

DATE 2/6/67

Dry Well - 3 bedrooms - 414 sq ft
4 bedrooms - 552 sq ft

absorbent sidewall area to begin below the inlet pipe. Inlet pipe must be 3 to 4 ft below original grade. Max depth permitted for dry well below original grade is 13 ft.

Place Dry Well 276 ft from the point where the two 234.30 parts of rear lot line meet and 120 ft to the left of the unpaved lane as seen when facing lot from Bowdoin Rd.

TO: THE COUNTY HEALTH OFFICER
ELLICOTT CITY, MARYLAND

I, HEREBY, APPLY FOR THE NECESSARY TESTS IN ORDER TO CONSTRUCT (OR RECONSTRUCT) A SEWAGE DISPOSAL SYSTEM.

PROPERTY OWNER James F. Geiger

ADDRESS Florida

PHONE

PROPERTY LOCATION:

SUBDIVISION

LOT NO.

ROAD AND DESCRIPTION Bowdoin Road - off River Road (at new bridge on Rt. I-95)

approx. 1/2 mile in off River Road - test on left

OCCUPANT

PHONE

PERSON TO CONSTRUCT SYSTEM

ADDRESS

PHONE

SIZE OF LOT 10.344 acres

TYPE BLDG.

(3) or 4
NUMBER OF BEDROOMS

IF NOT SINGLE-RESIDENCE DESCRIBE

(Single Fmly. Dwllg.)

SIGNATURE OF APPLICANT

Daniel T. Bruno

APPROVED BY

DW

FOR

dry-well
(KIND OF SYSTEM)

DATE

6-28-67

REJECTED BY

FOR

(KIND OF SYSTEM)


DATE

HOLD PENDING FURTHER TESTS

DATE

REASONS FOR REJECTION OR HOLDING

THIS IS NOT A PERMIT

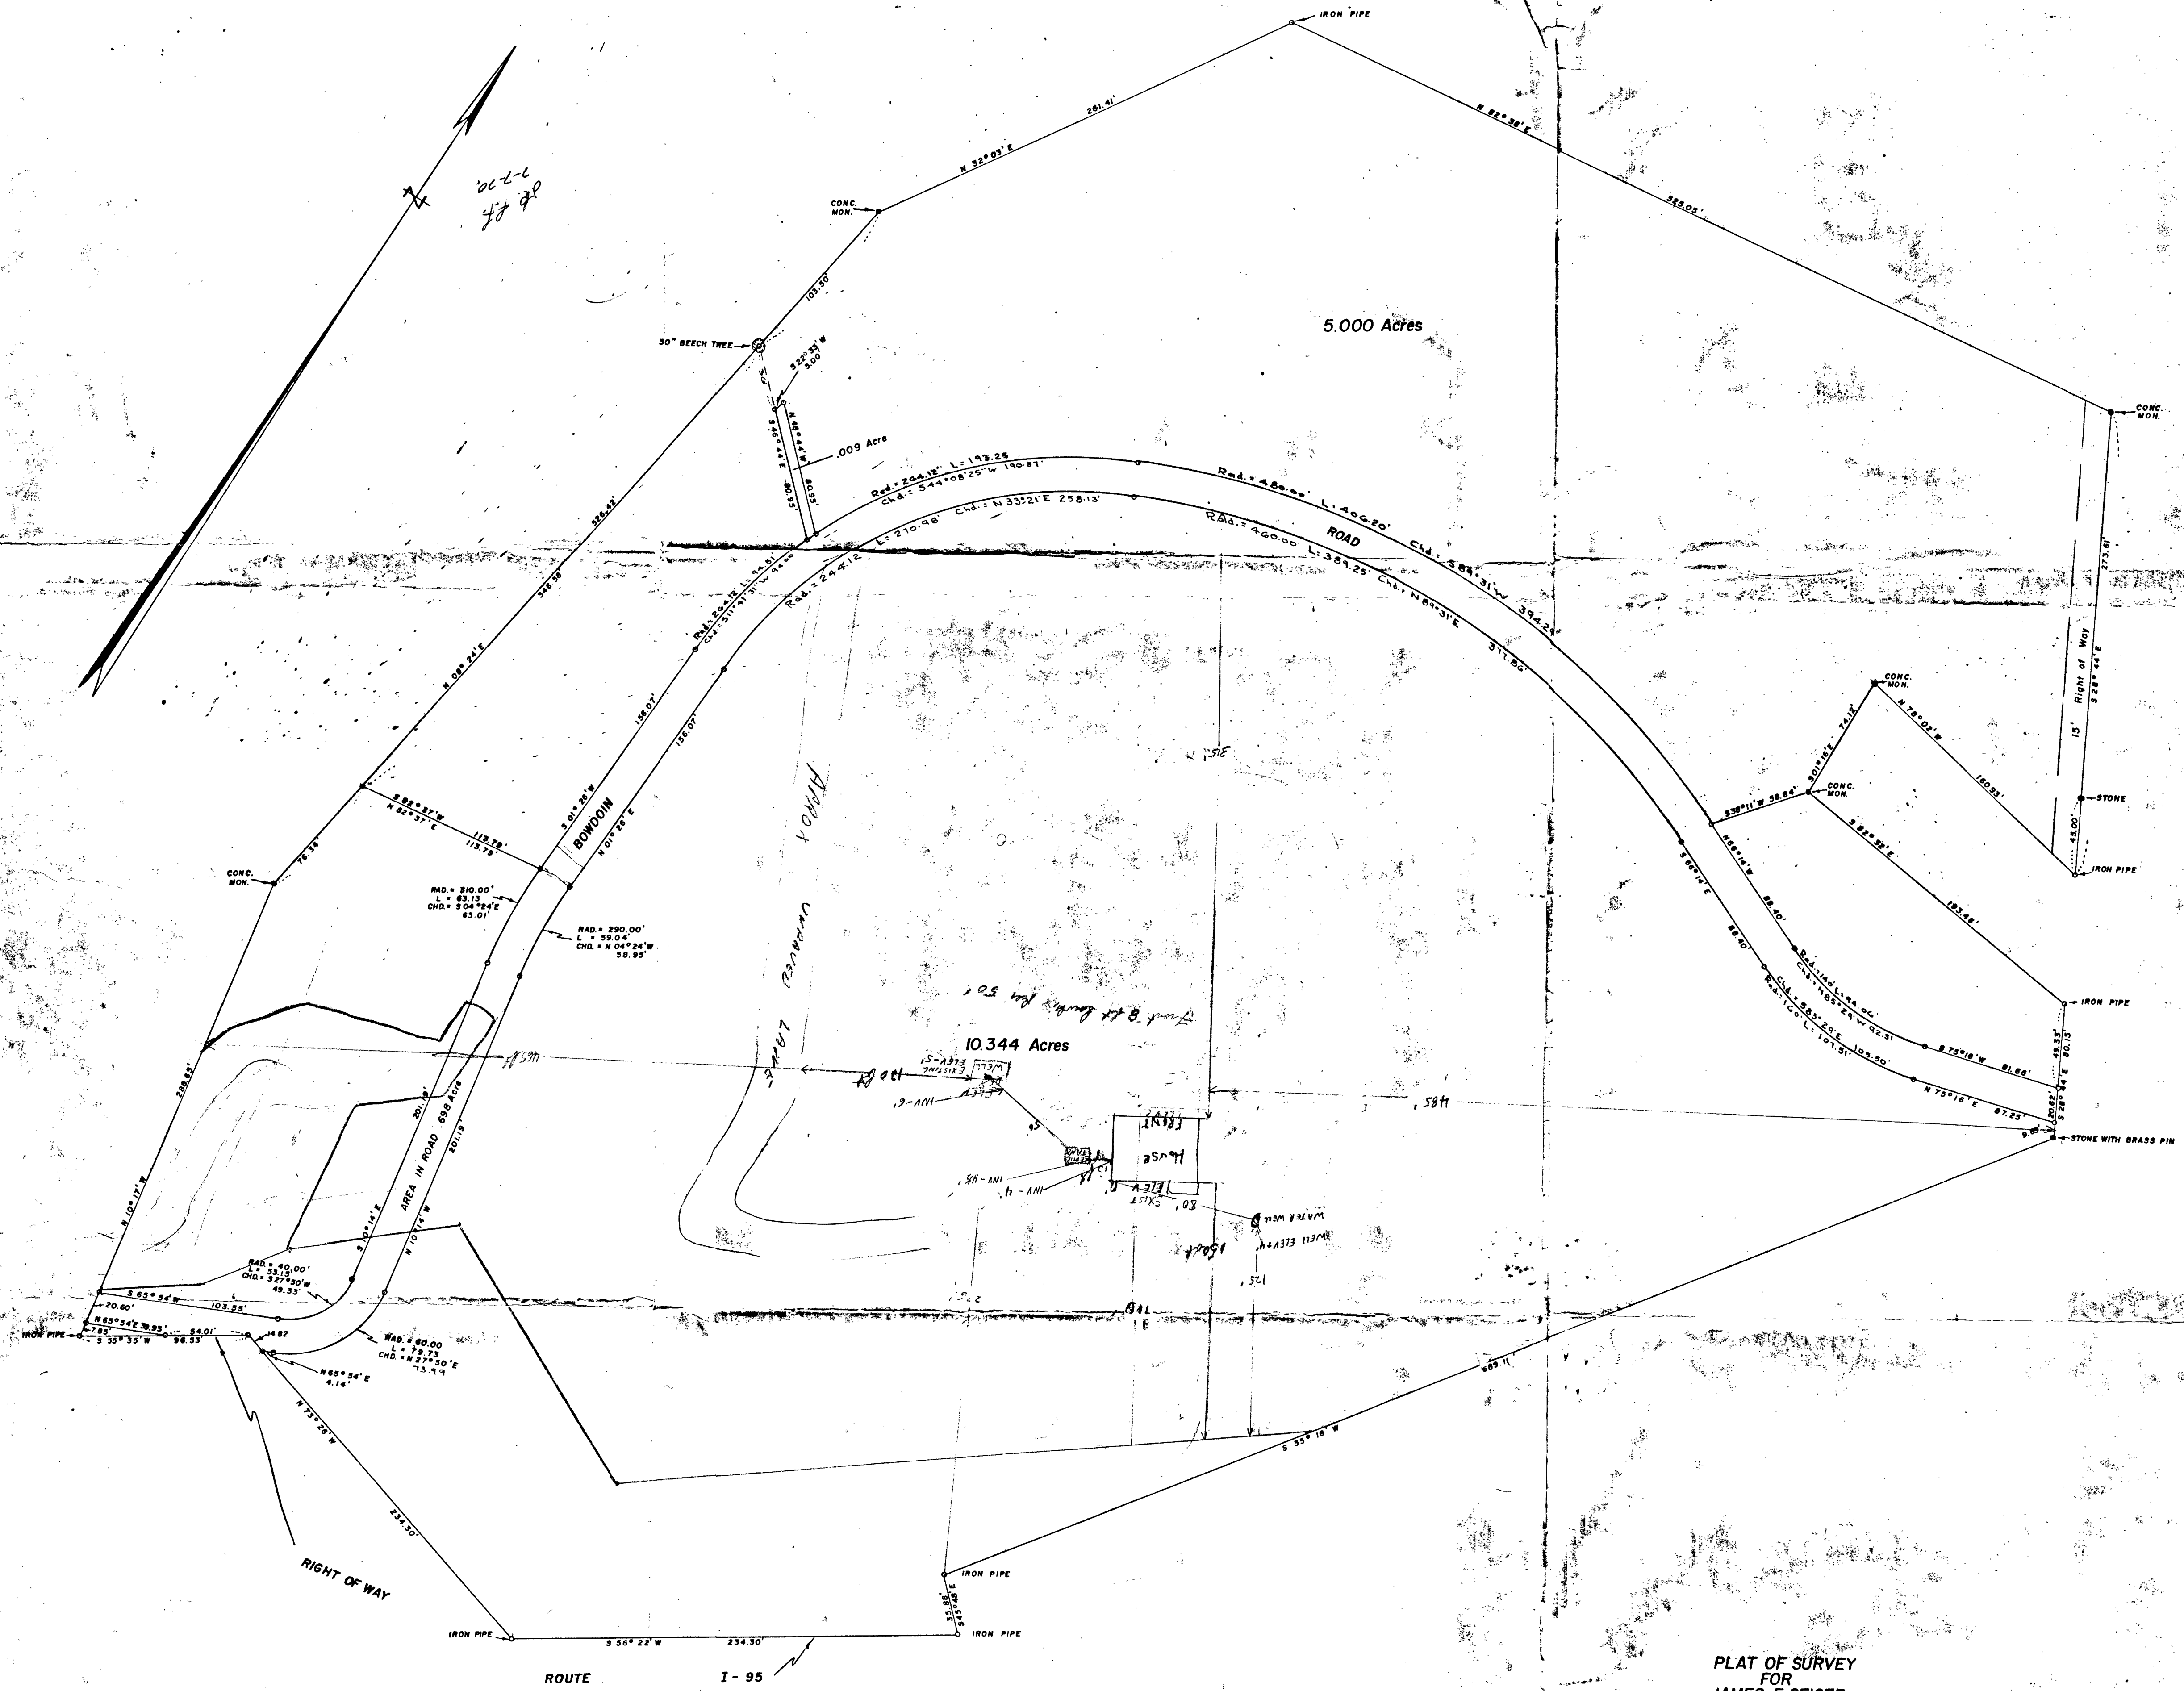

PLAT OF SURVEY
FOR
JAMES F. GEIGER
FIRST ELECTION DISTRICT OF HOWARD COUNTY
ELK RIDGE, MARYLAND
SCALE: 1 IN. = 50 FT. NOVEMBER 10, 1966

Claude M. Skinner
Claude M. Skinner Jr. Reg. Eng. & Land Surveyor No. 2257

