

PERMIT

SEWAGE DISPOSAL SYSTEM

DEPARTMENT OF HEALTH AND MENTAL HYGIENE

P _____

A 513633H

DISTRICT _____

DATE _____

HOWARD COUNTY HEALTH DEPARTMENT

BUREAU OF ENVIRONMENTAL HEALTH

461-9933

INDEXED

DATE SYSTEM APPROVED _____

INSPECTOR _____

02-230097

_____ IS PERMITTED TO INSTALL _____ ALTER _____

ADDRESS _____ PHONE _____

SUBDIVISION _____ LOT 1 ROAD 8452 Rolling Ridge Ct

PROPERTY OWNER Seabrook Charles Lin

ADDRESS _____

REPAIR P513220
COMPLETED 1/12/2000
NOT FOUND

PLANS APPROVED BY _____ DATE _____

COVER NO WORK UNTIL INSPECTED AND APPROVED

NEITHER THE HOWARD COUNTY COUNCIL NOR THE HEALTH DEPARTMENT IS RESPONSIBLE FOR THE SUCCESSFUL OPERATION OF ANY SYSTEM

NOTE: CLEANOUT REQUIRED EVERY 70 FEET OF SEWER LINE AND/OR AT 90° SWEEPS IN LINES FROM HOUSE TO DRAIN FIELDS, 90° ELBOWS NOT ACCEPTABLE.

NOTE: ALL PARTS OF SEPTIC SYSTEMS (I.E. TANK, DISTRIBUTION BOX TRENCHES) TO BE 100 FEET FROM WELL (UNLESS OTHERWISE SPECIFICALLY AUTHORIZED)

NOTE: IF DEEP TRENCH(ES) ARE USED CALL FOR INSPECTION BEFORE AND AFTER PLACING GRAVEL IN TRENCH(ES)

NOTE: NO DRY WELL SHALL EXCEED 15 FOOT IN DIAMETER NO ABSORPTION TRENCH TO EXCEED 100 FEET IN LENGTH

NOTE: ALL PIPE FROM HOUSE TO SEPTIC TANK MUST BE CAST IRON OR SCHEDULE 35/40 PVC OR ABS


PERMIT VOID AFTER TWO YEARS

NOTE: INSTALL STAND PIPE ON SEPTIC TANK AND DRY WELL STAND PIPES MUST BE 6 INCHES IN DIAMETER CAST IRON. CONCRETE OR TERRA COTTA OR PVA OR ABS ACCEPTED. IF TOP OF SEPTIC TANK IS DEEPER THAN 3 FEET. MANHOLE TO GRADE REQUIRED.

NOTE: DISTRIBUTION BOXES MUST HAVE BAFFLES

*INSTALLER IS RESPONSIBLE FOR OBTAINING FINAL APPROVAL ON THIS PERMIT

*CALL 461-9933 FOR INSPECTION OF SEPTIC SYSTEM.

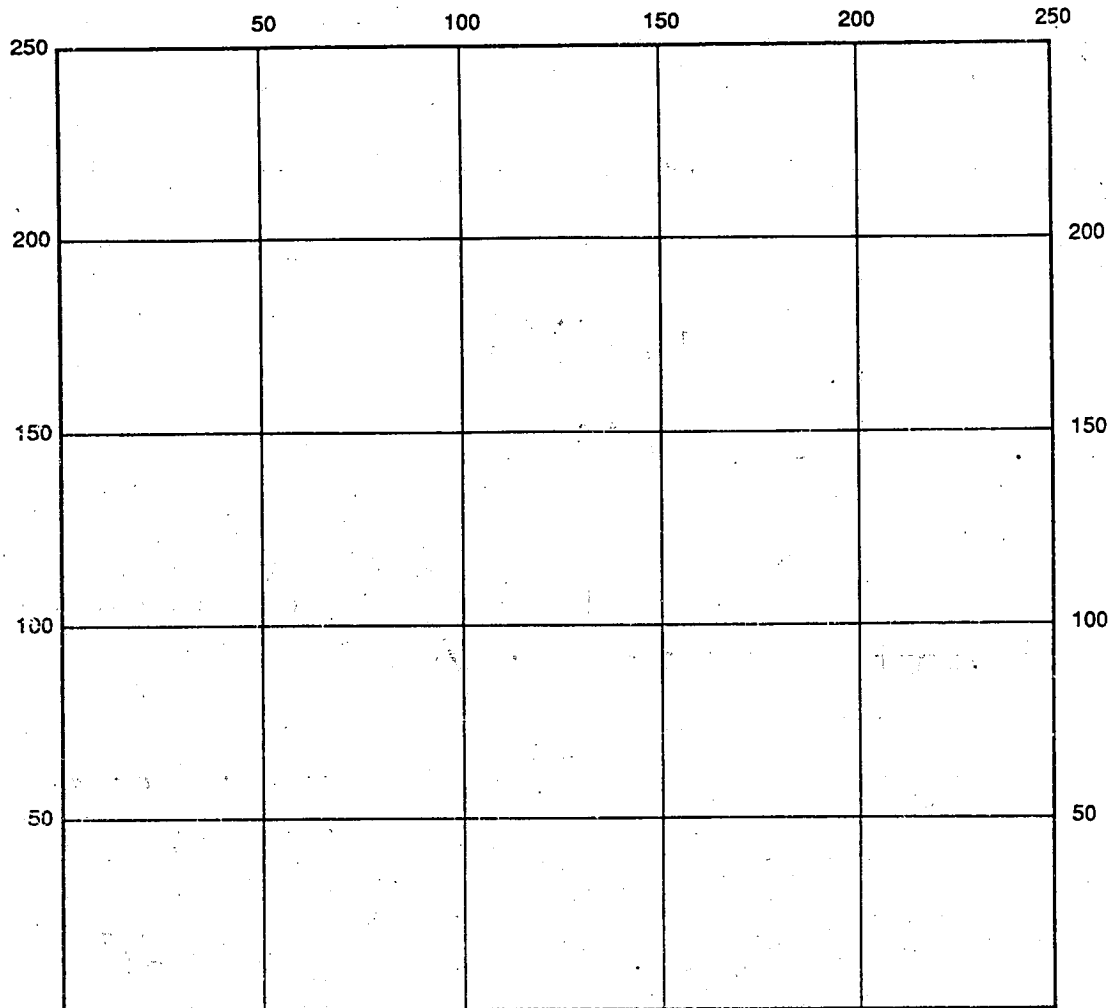

INDICATE NORTH - NAME ADJOINING ROADWAY AS BASE LINE

SEPTIC TANK LEVEL _____ CLEANOUTS _____

DISTRIBUTION BOX LEVEL _____

DRAIN FIELD/TITLE DEPTH _____ FT. TRENCH WIDTH _____ FT. INLET DEPTH _____ FT.

EFFECTIVE GRAVEL DEPTH _____ FT. TOTAL LENGTH _____ FT.

NUMBER OF TRENCHES _____ ONE SIDEWALL/BOTTOM AREA _____ SQ. FT.

DRYWALL INSIDE DIAMETER _____ FT. EFFECTIVE DEPTH BELOW INLET _____ FT.

ABSORBENT AREA _____ SQ. FT.

REMARKS: _____

DATE SYSTEM APPROVED _____ INSPECTOR _____

3/22/76 MV 3/23/76

12/24/75
after 11:50 AM

5/26/76

PERMIT

SEWAGE DISPOSAL SYSTEM

MARYLAND STATE DEPARTMENT OF HEALTH

HOWARD COUNTY

ELLICOTT CITY

DISTRICT 2

DATE 8/11/75

INDEXED

Caterino Monaghini IS PERMITTED TO INSTALL X ALTER

ADDRESS 721 N. Ballinord Ave., Baltimore, Md. PHONE 276-1889

A SEWAGE DISPOSAL SYSTEM LOCATED AT _____

SUBDIVISION Rolling Ridge ROAD 8452 Rolling Ridge LOT 1
Ct.

PROPERTY OWNER Mr. and Mrs. Caterino Monaghini

ADDRESS _____

SPECIFICATIONS - 3 bedrooms

DRAIN FIELD _____ DEPTH _____ FEET, BOTTOM AREA _____ SQ. FT.

SEEPAGE PITS _____ ABSORBENT SIDE-WALL AREA _____ SQ. FT.

SEPTIC TANK CAPACITY 1,000 GALLONS

FOR GARBAGE GRINDER, INCREASE DISPOSAL AREA 25% & TANK CAPACITY 50%

OTHER Dry well - 300 sq. ft. sidewall area below inlet. Dry well inlet to be 4 ft. below grade and dry well bottom to be no deeper than 11 ft. Place the dry well 160 ft. from the front lot line and 75 ft. from the right side of the lot as seen when facing the lot from Rolling Ridge Court.

PERMIT VOID AFTER THREE YEARS.

INSTALL STAND PIPES ON SEPTIC TANK AND DRY WELL - STAND PIPES MUST BE 6" IN DIA., CAST IRON, CONCRETE OR TERRA COTTA ACCEPTED.


PLANS APPROVED BY Hodges/Zepp DATE 6/29/73 & 2/24/75

NOTE: ALL PIPE FROM HOUSE TO DISPOSAL AREA MUST BE CAST IRON.

FILL SEPTIC TANK AND DISTRIBUTION BOX WITH WATER BEFORE CALLING FOR AN INSPECTION. COVER NO WORK UNTIL INSPECTED AND APPROVED.

NEITHER THE HOWARD COUNTY COMMISSIONERS NOR THE HEALTH DEPARTMENT IS RESPONSIBLE FOR THE SUCCESSFUL OPERATION OF ANY SYSTEM.

BLDG. PERMIT SIGNED
AND RETURNED 7/16/75
Steven Puck

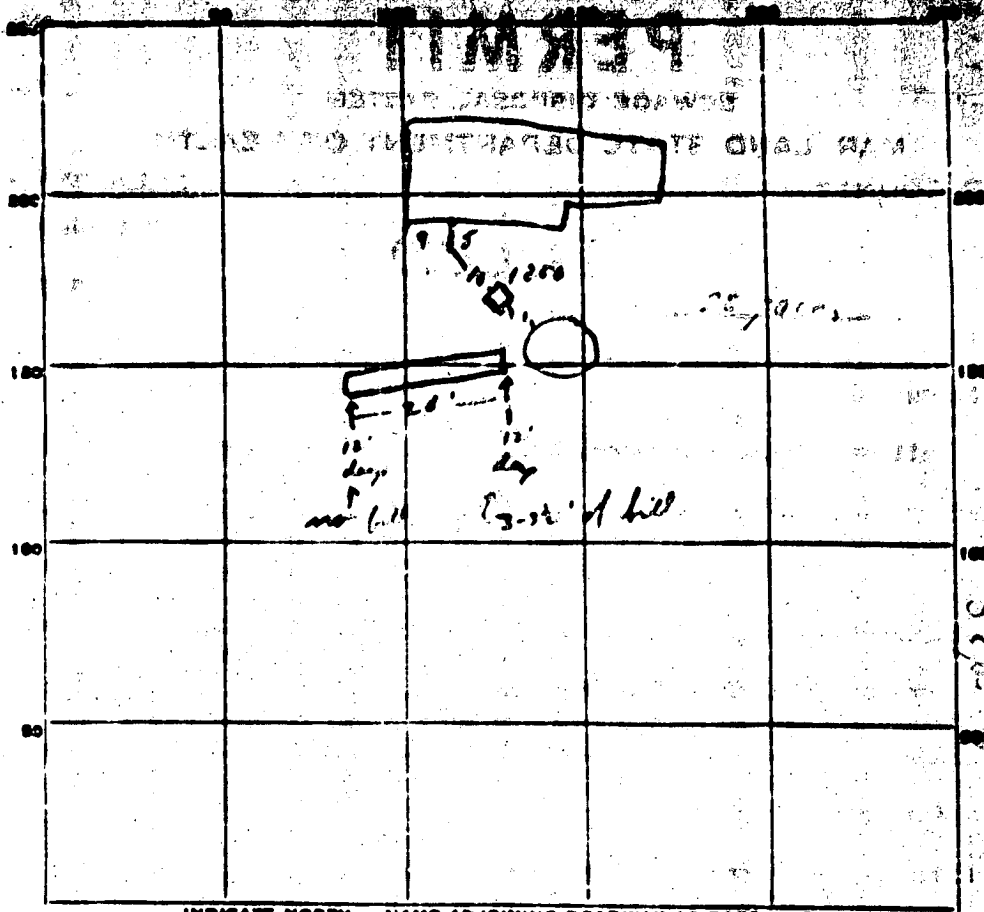

PERMIT CARD ☒ ST DW
 SEPTIC TANK, LEVEL ☒ CLEANOUTS ☒ / /
 DISTRIBUTION BOX, LEVEL NA
 TILE FIELD, DEPTH 12 FT. TRENCH WIDTH 2 FT.
 GRAVEL DEPTH 8 FT. TOTAL LENGTH 26 FT.
 NUMBER OF TRENCHES 1 TOTAL BOTTOM AREA 208
 SEEPAGE PITS, INSIDE DIAMETER _____ FT. DEPTH BELOW INLET _____ FT.
 ABSORBENT AREA _____ SQ. FT.

REMARKS 1. 20' trench, use 5' corr. bulge 20'
12'-13' deep - dug well, 2' of stone
at foot of dig well, some water
in left pipe - has D.O. 17/29 4
3/26 OK for stone??
3/26 OK on trench Rpt.
 DATE SYSTEM APPROVED 7/26/96 INSPECTOR DDO Muel

APPLICATION

SEWAGE DISPOSAL TESTING

MARYLAND STATE DEPARTMENT OF HEALTH

HOWARD COUNTY

ELLICOTT CITY

DISTRICT 2

DATE 11/11/71

Rec'd 10/15/71

TO: THE COUNTY HEALTH OFFICER
ELLICOTT CITY, MARYLAND

I, HEREBY, APPLY FOR THE NECESSARY TESTS IN ORDER TO CONSTRUCT (OR RECONSTRUCT) A SEWAGE DISPOSAL SYSTEM.

PROPERTY OWNER Eugene G. Naybold

ADDRESS 2402 Frederick Road, Baltimore, MD. 21228

PHONE 744-1111

PROPERTY LOCATION:

SUBDIVISION _____

LOT NO. _____

ROAD AND DESCRIPTION

Old Frederick Road - South side of Old Frederick Rd. -
nr. Daniels

OCCUPANT _____

PHONE _____

PERSON TO CONSTRUCT SYSTEM _____

ADDRESS _____

PHONE _____

SIZE OF LOT approx. 1 1/2 acres

TYPE BLDG. _____

NUMBER OF BEDROOMS

IF NOT SINGLE RESIDENCE DESCRIBE _____

(Single Fuly. Dellig.)

SIGNATURE OF APPLICANT /s/ Eugene G. Naybold

APPROVED BY _____

FOR _____

(KIND OF SYSTEM)

DATE _____

REJECTED BY _____

FOR _____

(KIND OF SYSTEM)

DATE _____

HOLD PENDING FURTHER TESTS _____

DATE _____

REASONS FOR REJECTION OR HOLDING

10/15/71, 12m OK for Fund RH

THIS IS NOT A PERMIT

APPLICATION

SEWAGE DISPOSAL TESTING

MARYLAND STATE DEPARTMENT OF HEALTH
HOWARD COUNTY

ELLICOTT CITY

DISTRICT 2

DATE 8/21/71

TO: THE COUNTY HEALTH OFFICER
ELLICOTT CITY, MARYLAND

I, HEREBY, APPLY FOR THE NECESSARY TESTS IN ORDER TO CONSTRUCT OR RECONSTRUCT A SEWAGE DISPOSAL SYSTEM.

PROPERTY OWNER Eugene G. Saybold

ADDRESS 2400 Frederick Road, Baltimore, Md. 21228 PHONE 744-4541

PROPERTY LOCATION:

SUBDIVISION _____ LOT NO. _____

ROAD AND DESCRIPTION Old Frederick Road - South side of Old Frederick Rd. -
nr. Daniels

OCCUPANT _____ PHONE _____

PERSON TO CONSTRUCT SYSTEM _____

ADDRESS _____ PHONE _____

SIZE OF LOT approx. 1 1/4 acres TYPE BLDG. 3 or 4

IF NOT SINGLE RESIDENCE DESCRIBE _____
(Single Fmly. Dvlg.)

SIGNATURE OF APPLICANT /s/ Eugene G. Saybold

APPROVED BY _____ FOR _____ DATE _____
(KIND OF SYSTEM)


REJECTED BY _____ FOR _____ DATE _____
(KIND OF SYSTEM)

HOLD PENDING FURTHER TESTS _____ DATE _____

REASONS FOR REJECTION OR HOLDING _____

THIS IS NOT A PERMIT

415-262

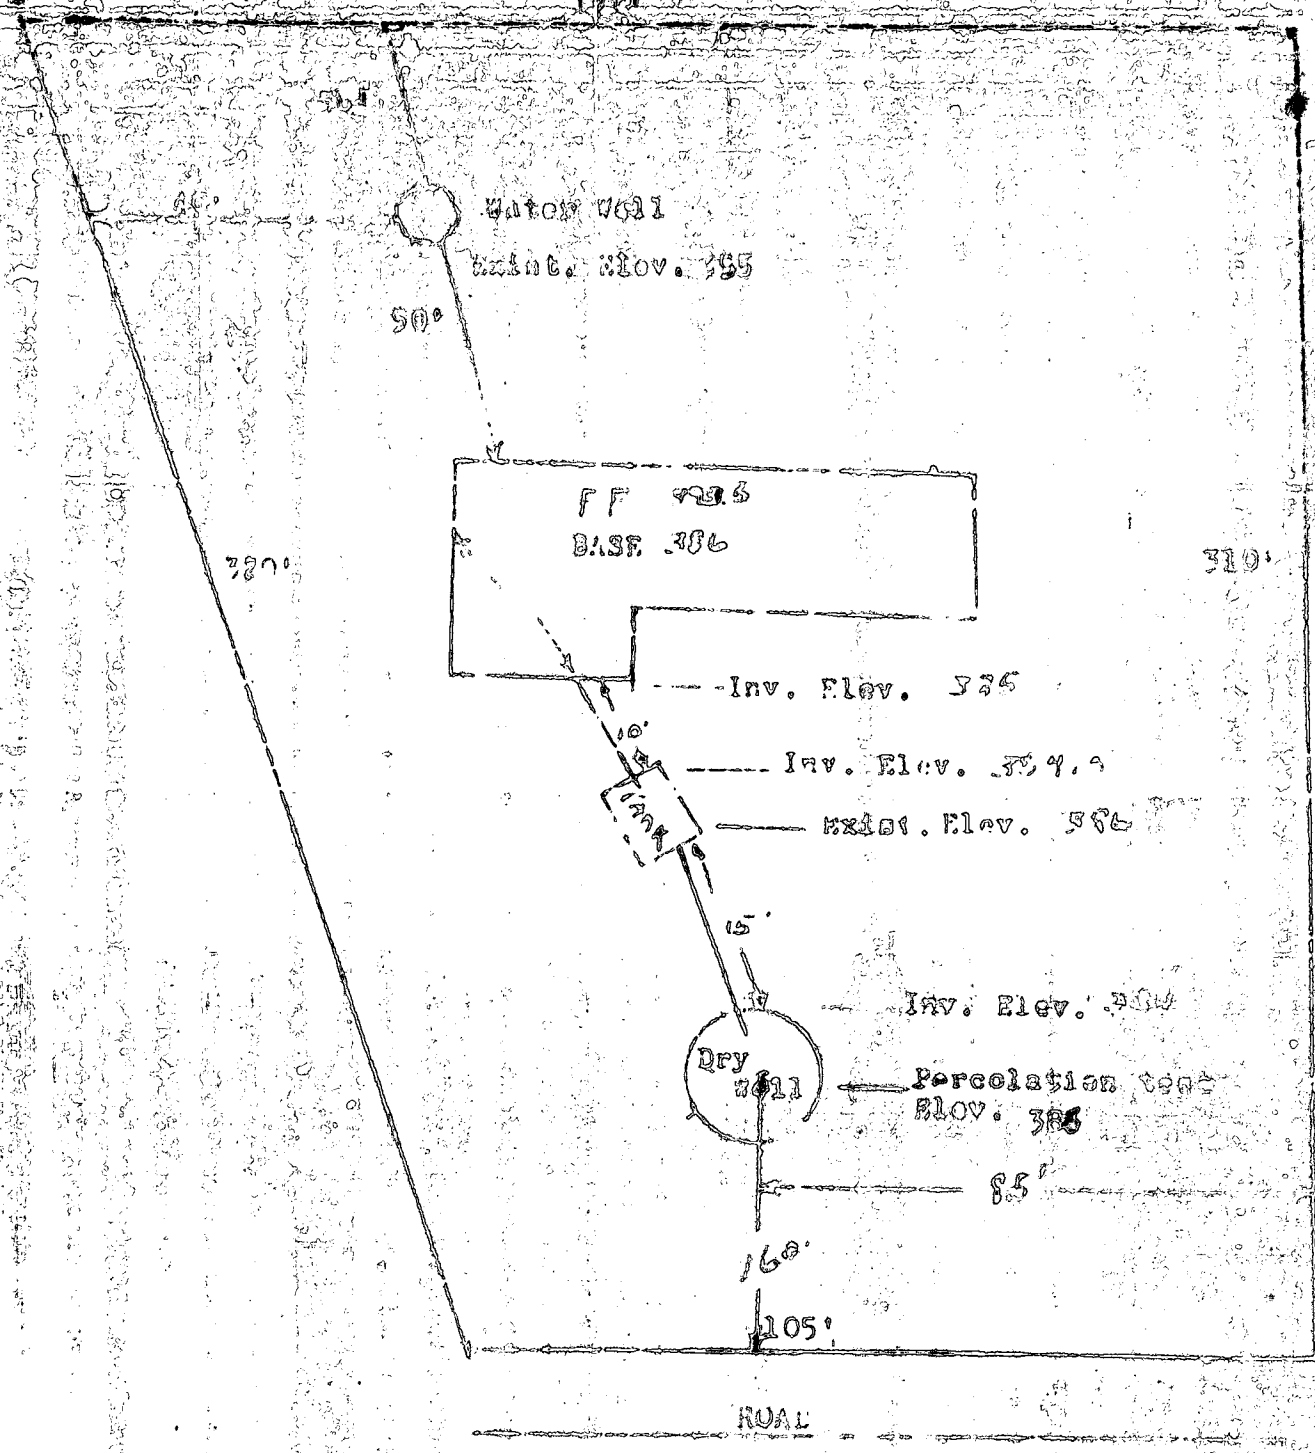

I CERTIFY THE ABOVE MEASUREMENTS AND ELEVATIONS ARE CORRECT FOR THIS PROPERTY.

OK RD
2/16/78

STATE OF MARYLAND
WATER RESOURCES ADMINISTRATION
PAVED STATE OFFICE BLDG., ANNAPOLIS, MD. 21401
WELL COMPLETION REPORT

THIS REPORT MUST BE SUBMITTED WITHIN 30 DAYS AFTER WELL COMPLETION

FILL IN THIS FORM COMPLETELY

WELL NO. 9756 COUNTY NO. A16282

DATE WELL COMPLETED 11/23/76 DEPTH OF WELL 200 (TO NEAREST FOOT)

OWNER HEVEGHINI STREET OR RFD 723 W. DELAWARE AVE CITY ANNAPOLIS POST OFFICE ANNAPOLIS

DRILLER IDENTIFICATION NO. 204

WELL LOG

STATE THE KIND OF FORMATIONS PENETRATED, THEIR CO., DEPTH, THICKNESS AND IF WATER BEARING

DEPTH	FORMATION	WATER BEARING
0-10		
10-20		
20-30		
30-40		
40-50		
50-60		
60-70		
70-80		
80-90		
90-100		

GRouting RECORD

WELL HAS BEEN GROUTED (CIRCLE APPROPRIATE BOX)

TYPE OF GROUTING MATERIAL (CIRCLE NO.) 1 2

CEMENT CM GENTLE CLAY GC

NO. OF BAGS 16 NO. OF POUNDS 512

GALLONS OF WATER 35

DEPTH OF GROUT SEAL (TO NEAREST FOOT)

FROM 0 FT. TO 35 FT.

ENTERED IF FROM SURFACE

Casing Record

CASING TYPES

INERT (CIRCLE APPROPRIATE CODE BELOW)

STEEL ST CONCRETE CO

PLASTIC PL OTHER OT

MAIN CASING TYPE ST

NOMINAL DIAMETER TOP IMBICASING (NEAREST INCH) 6

TOTAL DEPTH OF MAIN CASING (NEAREST FOOT) 70

OTHER CASING (IF USED)

DIAMETER (INCH) 4 DEPTH (FEET) FROM 0 TO 10

TYPE ST CO PL OT

SCREEN RECORD

SCREEN TYPE (CIRCLE APPROPRIATE CODE BELOW)

STEEL ST BRASS, OPEN HOLE BR

PL PL OT OT

DEPTH (NEAREST WHOLE FOOT) FROM 0 TO 10

PUMPING TEST

HOURS PUMPED (TO NEAREST HOUR) 1

PUMPING RATE (GALLONS PER MINUTE TO NEAREST GALLON) 11

METHOD USED TO MEASURE PUMPING RATE

WATER LEVEL (DISTANCE FROM LAND SURFACE)

BEFORE PUMPING 17 FEET

WHEN PUMPING 28 FEET

TYPE OF PUMPED USED (CIRCLE APPROPRIATE CODE FOR PUMPING TEST)

A AIR 27 D PISTON 27 T TURBINE 27

C CENTRIFUGAL 27 R ROTARY 27 O OTHER (DESC. B-10) 27

J JET 27 S SUBMERSIBLE 27

PUMP INSTALLED

TYPE OF PUMP (WRITE APPROPRIATE LETTER IN BOX - SEE ABOVE) A, C, J, P, R, S, T, O

DRILLER WILL INSTALL PUMP (CIRCLE APPROPRIATE CODE)

CAPACITY: 11 GALLONS PER MINUTE (TO NEAREST GALLON)

PUMP HORSE POWER 27

PUMP COLUMN LENGTH (NEAREST FOOT) 10

LOCATION OF WELL ON LOT

SHOW PERMANENT STRUCTURE SUCH AS BUILDINGS, SEPTIC TANKS, AND/OR OTHER LAND MARKS AND INDICATE NOT LESS THAN TWO DISTANCES (MEASUREMENTS TO WELL).

CIRCLE APPROPRIATE BOXES

☐ A WELL WAS ABANDONED AND SEALED WHEN THIS WELL WAS COMPLETED

☐ E ELECTRIC LOG OBTAINED

☐ P VERY WELL CONVERTED TO PRODUCTION WELL

I HEREBY CERTIFY THAT I HAVE COMPLIED WITH ALL CONDITIONS STATED ON THE ABOVE-CAPTIONED "PERMIT TO DRILL WELL", AND THAT INFORMATION CONTAINED IN THIS REPORT IS TRUE, ACCURATE, AND COMPLETE TO THE BEST OF MY KNOWLEDGE, INFORMATION AND BELIEF.

DRILLER'S NAME HEVEGHINI

PLEASE PRINT HEVEGHINI

SIGNATURE HEVEGHINI

SCREEN RECORD

SCREEN TYPE (CIRCLE APPROPRIATE CODE BELOW)

STEEL ST BRASS, OPEN HOLE BR

PL PL OT OT

DEPTH (NEAREST WHOLE FOOT) FROM 0 TO 10

DIAMETER OF SCREEN 4 (NEAREST INCH)

FROM 0 TO 10

GRAVEL PACK


IF WELL DRILLED WAS A FLOWING WELL CIRCLE BOX 00 P

WRA USE ONLY (NOT TO BE FILLED IN BY DRILLER)

TO 1 2 3 4 5 6 7 8 9 0

TELESCOPE CASING 1 LOG INDICATOR 1 OTHER DATA AVAILABLE 1

HEALTH

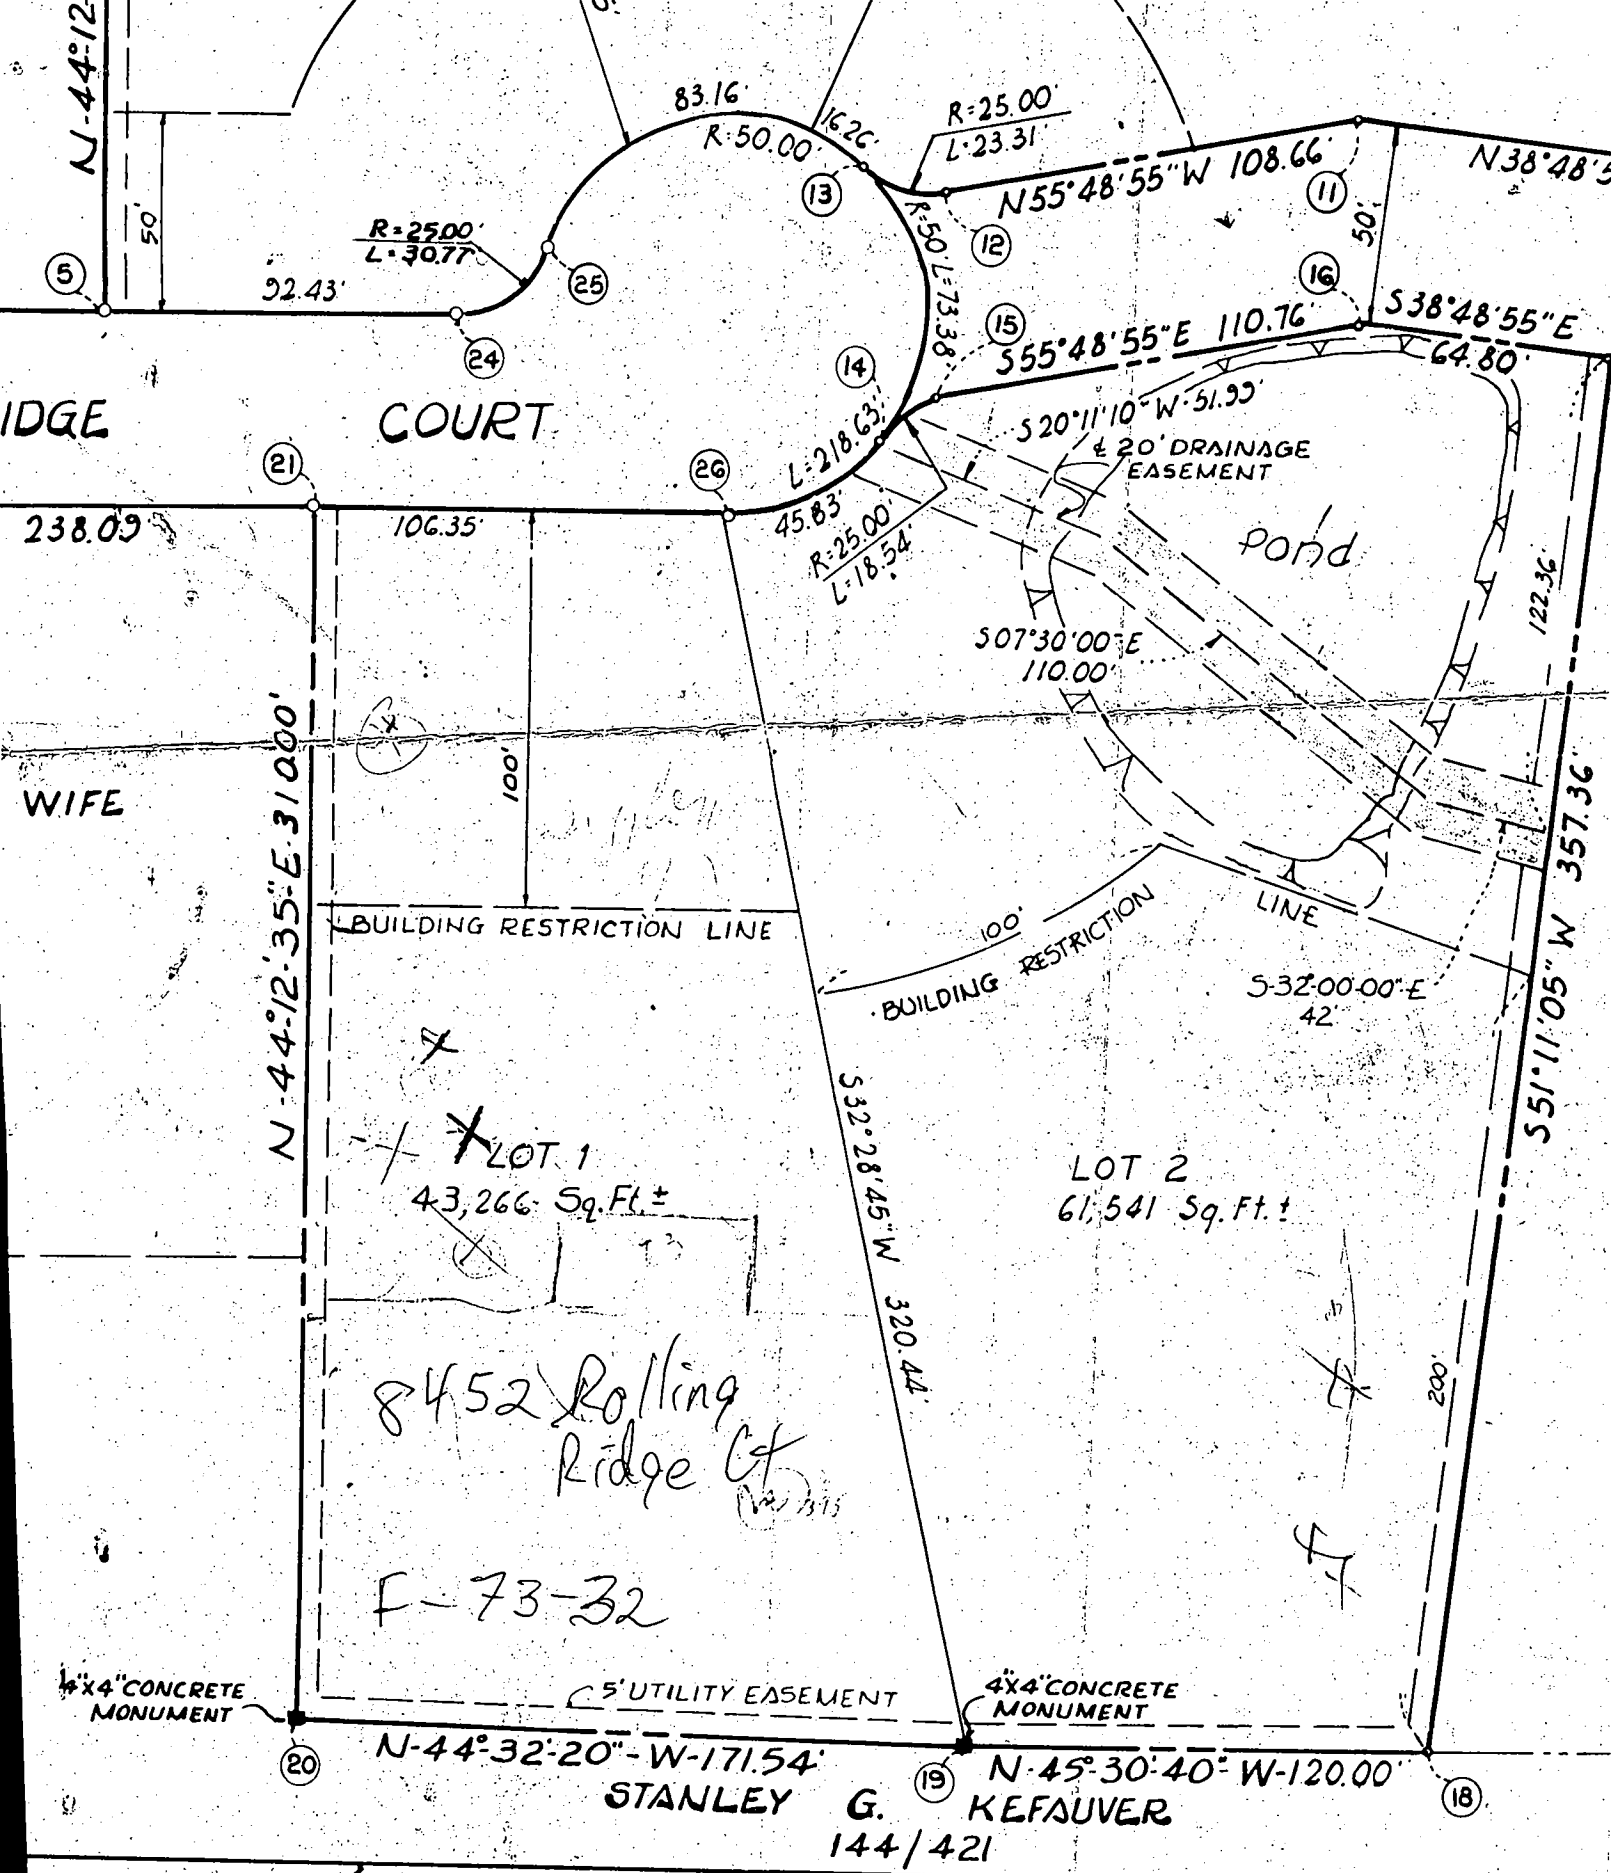

SURVEYOR'S & ENGINEER'S CERTIFICATE:

I, William G. Rasch II, hereby certify that it is a Subdivision of part of the land and recorded among the Land Records of Howard at Folio 352, was granted and conveyed by John Joan Collins, to Eugene G. and Myra L. Soyba


old his wife, owners of the property shown and of Subdivision and reserve the fee simple title roads shown hereon and in consideration of the ce of Planning and Zoning we for ourselves, our and grant unto Howard County, Maryland, the right sideration of One Dollar the f

AC 22

NOT TO
SCALE

1/15/04
PROP.
SUNROOM OK

MR

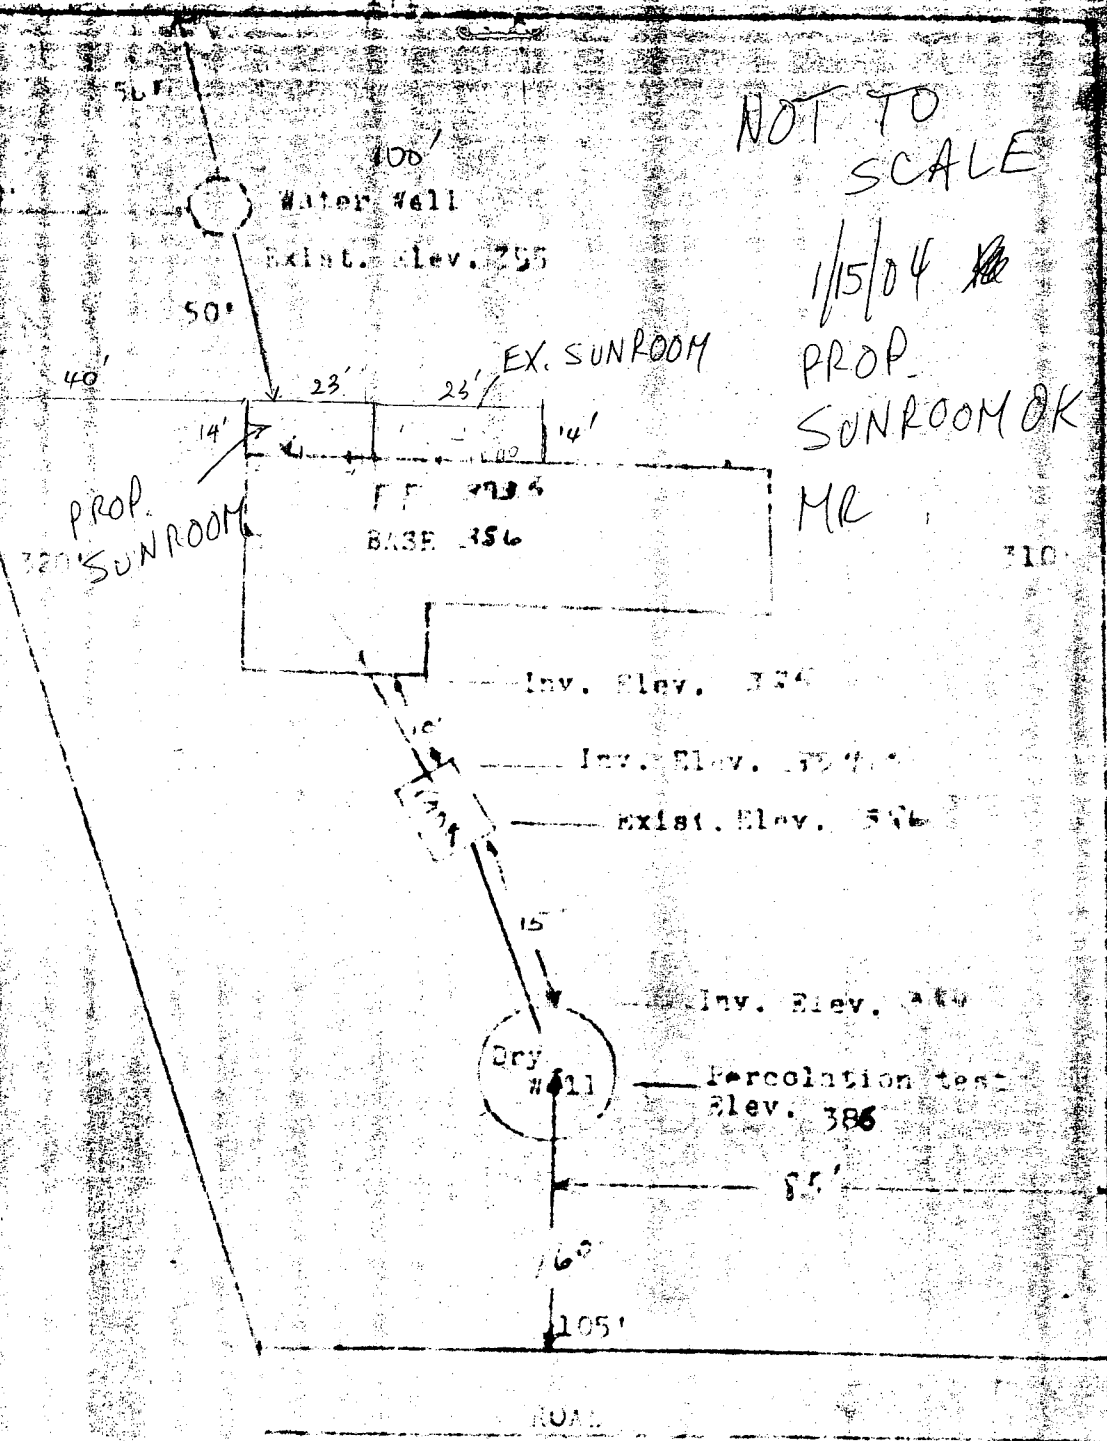

I CERTIFY THE ABOVE MEASUREMENTS AND ELEVATIONS ARE CORRECT FOR THIS PROPERTY.

OKRN
2/2/75

SIGNED *Colman* 1/15/04

HOWARD COUNTY
PERMIT APPLICATION

PERMIT NUMBER

800145828

Building Address 8452 Rolling Ridge Ct

Property Owner's Name CHARLES LIN

Address 8452 Rolling Ridge Ct

Suite/Apt. #: _____ SDB/WP/Petition #: _____

City ELLCITY State MD Zip Code 21043

Census Tract 6021 Subdivision Rolling Ridge

Home Phone (410) 313-1010 Work Phone _____

Section _____ Area _____ Lot 1

Applicant's Name & Mailing Address, (if other than stated hereon): _____

Tax Map _____ Parcel _____ Grid _____

Zoning BDU Map Coordinates BDU Lot size _____

Phone _____ Fax _____

Existing Use _____

Contractor Company _____

Proposed Use _____

Contact Person Mr

Estimated Construction Cost \$ 100,000

Address _____

Description of Work on slab

City _____ State _____ Zip Code _____

License No. _____

Phone _____ Fax _____

Occupant or Tenant CHARLES LIN

Engineer or Architect Company _____

Contact Name CHARLES LIN

Contact Person _____

Address 8452 Rolling Ridge Ct

Address _____

City ELLCITY State MD Zip Code 21043

City _____ State _____ Zip Code _____

Phone _____ Fax _____

Phone _____ Fax _____

BUILDING DESCRIPTION - COMMERCIAL

BUILDING DESCRIPTION - RESIDENTIAL

Building Characteristics

Utilities

Height: _____

No. of stories: _____

Gross area, sq. ft. per floor: _____

Use group: _____

Construction type:

☐ Reinforced Concrete

☐ Structural Steel

☐ Masonry

☐ Wood Frame

☐ State Certified Modular

Water Supply:

☐ Public

☐ Private

Sewage Disposal:

☐ Public

☐ Private

Electric Yes ☐ No ☐

Gas Yes ☐ No ☐

Heating System:

Electric ☐ Oil ☐

Natural Gas ☐

Propane Gas ☐

Sprinkler system: N/A ☐

☐ Full

☐ Partial

☐ Other Suppression

☐ # of Heads

Building Characteristics

Utilities

SF Dwelling ☐ SF Townhouse ☐

Depth _____ Width _____

1st floor: _____

2nd floor: _____

Basement: _____

Finished Basement ☐ Unfinished Basement ☐

Crawl space ☐ Slab on Grade ☐

No. of Bedrooms: _____

Multi-family dwellings:

No. of efficiency units: _____

No. of 1 BR units: _____

No. of 2 BR units: _____

No. of 3 BR units: _____

Other Structure: _____

Dimensions: _____

Footings: _____

Roof: _____

☐ State Certified Modular

☐ Manufactured Home

Water Supply:

☐ Public

☒ Private

Sewage Disposal:

☐ Public

☒ Private

Electric Yes ☒ No ☐

Gas Yes ☐ No ☐

Heating System:

Electric ☐ Oil ☐

Natural Gas ☐

Propane Gas ☐

Sprinkler system: N/A ☐

☐ NFPA #13D

☐ NFPA #13R

☐ Other:

THE UNDERSIGNED HEREBY CERTIFIES AND AGREES AS FOLLOWS: (1) THAT HE/SHE IS AUTHORIZED TO MAKE THIS APPLICATION; (2) THAT THE INFORMATION IS CORRECT; (3) THAT HE/SHE WILL COMPLY WITH ALL REGULATIONS OF HOWARD COUNTY WHICH ARE APPLICABLE THERE TO; (4) THAT HE/SHE WILL PERFORM NO WORK ON THE ABOVE REFERENCED PROPERTY NOT SPECIFICALLY DESCRIBED IN THIS APPLICATION; (5) THAT HE/SHE GRANTS COUNTY OFFICIALS THE RIGHT TO ENTER ONTO THIS PROPERTY FOR THE PURPOSE OF INSPECTING THE WORK PERMITTED AND POSTING NOTICES.

Applicant's Signature

Print Name

Date

Checks payable to: DIRECTOR OF FINANCE OF HOWARD COUNTY

** PLEASE WRITE NEATLY AND LEGIBLY. **

FOR OFFICE USE ONLY

AGENCY

DATE

SIGNATURE APPROVAL

DPZ SETBACK INFORMATION

PROPERTY ID#

Land Development, DPZ
State Highways

Front:

Filing fee \$