

1/8/65
after 12

PERMIT

SEWAGE DISPOSAL SYSTEM

MARYLAND STATE DEPARTMENT OF HEALTH

HOWARD COUNTY

INDEXED

02-204061

Approved 1/8/65 J.H.R.

P 09555

A 04152

513633 R

ELLICOTT CITY

DISTRICT 2

DATE 1/6/65

Excavating Contractors, Inc.

IS PERMITTED TO INSTALL ☒ ALTER

ADDRESS 8 Maude Drive, Ellicott City, Md.

PHONE HO 5-3849

A SEWAGE DISPOSAL-SYSTEM LOCATED AT

SUBDIVISION Southview

2826
ROAD St. John's Lane

LOT 1

PROPERTY OWNER Edward Hynes

ADDRESS

SPECIFICATIONS 3 bedrooms

DRAIN FIELD DEPTH FEET, BOTTOM AREA SQ. FT.

SEEPAGE PITS ABSORBENT SIDE-WALL AREA SQ. FT.

SEPTIC TANK CAPACITY 750 GALLONS

FOR GARBAGE GRINDER, INCREASE DISPOSAL AREA 22% & TANK CAPACITY 50%.

OTHER Leaching bed installed 4 ft. to 5 ft. deep with a bottom area of 453 sq. ft.

Place the leaching bed in the area 15 ft. to 60 ft. from Lot #2 and about 15 ft. to 35 ft. from the back lot line.

PLANS APPROVED BY Raymond Hodges


DATE 5/11/62

FILL SEPTIC TANK AND DISTRIBUTION BOX WITH WATER BEFORE CALLING FOR AN INSPECTION. COVER NO WORK UNTIL INSPECTED AND APPROVED.

NEITHER THE HOWARD COUNTY COMMISSIONERS NOR THE HEALTH DEPARTMENT IS RESPONSIBLE FOR THE SUCCESSFUL OPERATION OF ANY SYSTEM.

513633 R
A 04152

28
 71
 28
 56
 588

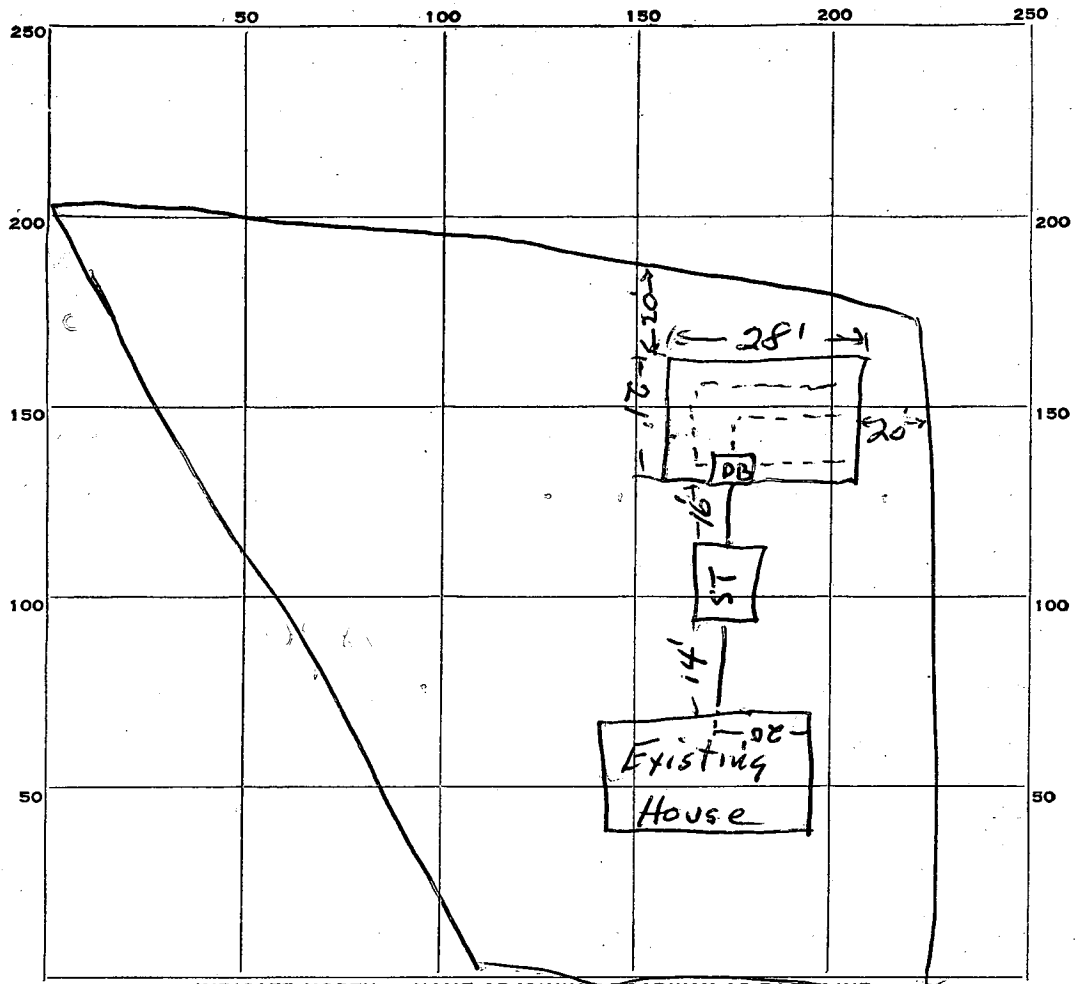

PERMIT CARD not posted ST. JOHN'S LANE

SEPTIC TANK, LEVEL OK CLEANOUTS OK

DISTRIBUTION BOX, LEVEL OK

L. Bed 6.67 L. Bed
 TILE FIELD, DEPTH 24 FT. TRENCH WIDTH 21 FT.

GRAVEL DEPTH 36 IN. TOTAL LENGTH 28 FT.

NUMBER OF TRENCHES _____ TOTAL BOTTOM AREA 588 sq ft

SEEPAGE PITS, INSIDE DIAMETER _____ FT. DEPTH BELOW INLET _____ FT.

ABSORBENT AREA _____ SQ. FT.

REMARKS _____

DATE SYSTEM APPROVED 1/8/65 INSPECTOR J. H. Kilmore

5/11/62
1:00

APPLICATION

SEWAGE DISPOSAL TESTING

A 05099

P

MARYLAND STATE DEPARTMENT OF HEALTH

HOWARD COUNTY

750 Gallon Tank

ELLICOTT CITY

DISTRICT 2

DATE 5/4/62

Leaching Bed installed 4 ft to 5 ft deep with bottom area of 45 sq ft. Place the Leaching Bed in the area 15 ft to 60 ft from Lot #2 and about 15 ft to 35 ft from the back lot line.

TO: THE COUNTY HEALTH OFFICER
ELLICOTT CITY, MARYLAND

I, HEREBY, APPLY FOR THE NECESSARY TESTS IN ORDER TO CONSTRUCT (OR RECONSTRUCT) A SEWAGE DISPOSAL SYSTEM.

PROPERTY OWNER Edward Hynes

ADDRESS

PHONE

PROPERTY LOCATION:

SUBDIVISION Southview

LOT NO. 1

ROAD AND DESCRIPTION

St. John's Lane

OCCUPANT

PHONE

PERSON TO CONSTRUCT SYSTEM

ADDRESS

PHONE

SIZE OF LOT

178' X 155'

TYPE BLDG.

NUMBER OF BEDROOMS 3

IF NOT SINGLE RESIDENCE DESCRIBE

SIGNATURE OF APPLICANT Edward Hynes/dna

APPROVED BY

Raymond A. Hodges

FOR

Leaching Bed

(KIND OF SYSTEM)

DATE

11 MAY 62

REJECTED BY

FOR

(KIND OF SYSTEM)


DATE

HOLD PENDING FURTHER TESTS

DATE

REASONS FOR REJECTION OR HOLDING

THIS IS NOT A PERMIT

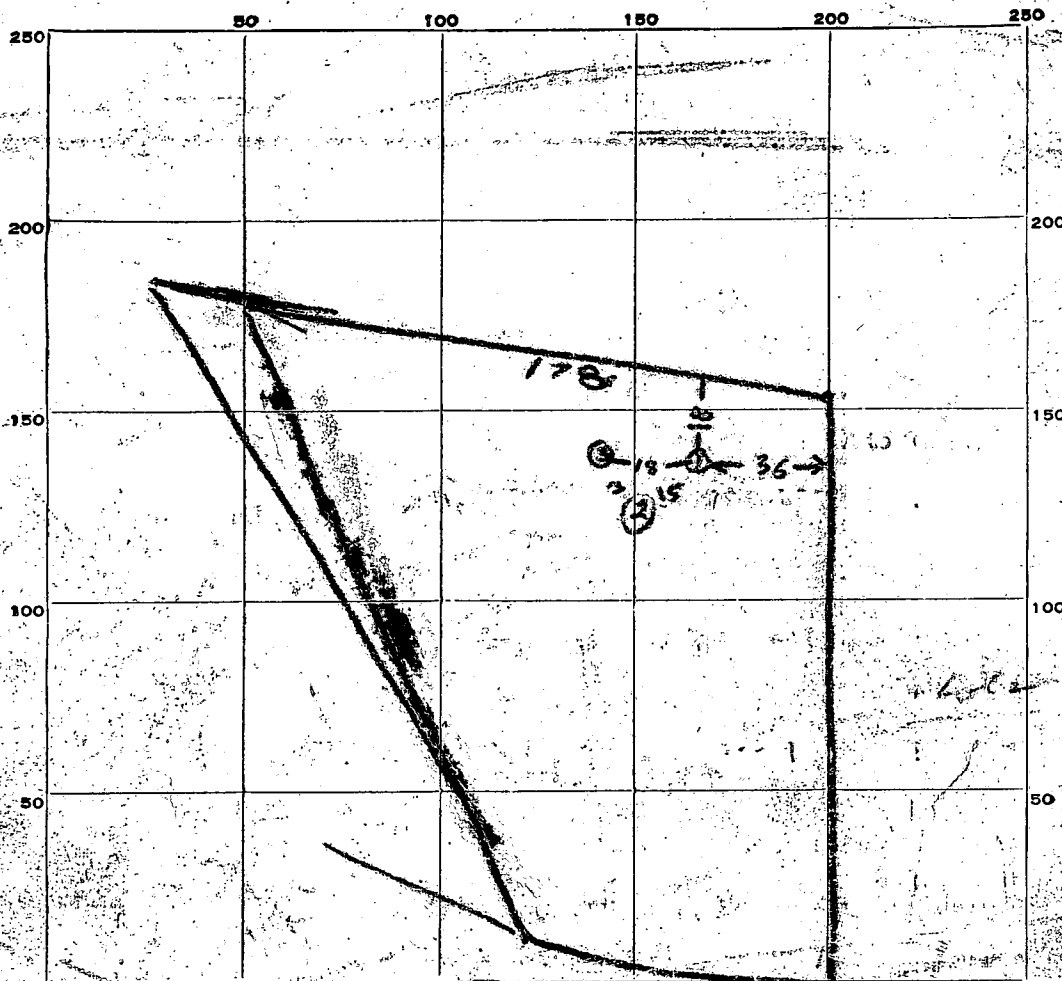

INDICATE NORTH. - NAMES ADJACENT ROADWAY AS BASE LINE.

JOHN S. LANE

DATE	TEST NO.	DEPTH	PRE-WET		TEST - 1" DROP		TIME
			START	STOP	START	STOP	
11 MAY 62	1	5	219	235	235	309	34
" "	2	5	220			234	8
" "	3	5	229	236	236	246	10
" "	4	8 1/2	all sand no underground water				

Same Location

17 min or

3 124
12

3 52
17

SOIL AUGER FINDING

TESTED BY

Raymond Hodges

REMARKS

ALSO PRESENT

C. Smith

LOT NO.

P



HOWARD COUNTY HEALTH DEPARTMENT

Joyce M. Boyd, M.D., County Health Officer

Reply to:

May 14, 1993

MEMORANDUM

TO: James Irvin, Director
Department of Public Works
Howard County Government

FROM: Craig D. Williams, Program Director (CW)
Water and Sewerage Program
Bureau of Environmental Health

SUBJECT: Contrino Property
2826 St. John's Lane

In response to Mrs. Contrino's request for health department assessment of a septic problem at the above referenced property, a site inspection was conducted by Mark Rifkin, Registered Sanitarian, on April 16, 1993.

Mr. Rifkin found Mrs. Contrino's property to have a failing septic system.

Development of an alternative method of waste water disposal is the recommended course of action. Although on-site septic repairs could be considered as an intermediate solution, connection to a public sewer extension would provide a more permanent solution.

CDW:hs

cc: Mrs. Mildred Contrino
Ms. Charlotte Drieden
Department of Public Works
File ✓

REGION _____

AREA _____ RATING _____

ACKNOWLEDGMENT AND CONTROLS	DATE

Howard County Department of Health
BUREAU OF ENVIRONMENTAL HEALTH

RECORD OF INVESTIGATION

DISPOSITION	DATE

LOCATION 2826 St. Johns La ZIP _____
OWNER ☒ Ms. Mildred Contrino ADDRESS same 21042 PHONE 465-8042
OCCUPANT ☐ _____

COMPLAINANT same ADDRESS _____ PHONE _____

REASON FOR INVESTIGATION wants verification of septic failure
so she can connect to pub. sewer

RECEIVED BY M. Ripkin DATE 4/16/93 ASSIGNED TO M. R DATE 4/16 CODES _____

DATE OF INVESTIGATION 4/16 TIME 12:00 WEATHER cool, raining

REPORT 4/16 NO SURFACE SEEPAGE FOUND; SEWAGE RESIDUE
FOUND IN BATHTUB IN BASEMENT; RECOMMEND LETTER
TO ENGINEERING RECOMMENDING CONNECTION M/R

DATE SUBMITTED _____ SANITARIAN _____

REGION AREA RATING

ACKNOWLEDGMENT AND CONTROLS	DATE

Howard County Department of Health
BUREAU OF ENVIRONMENTAL HEALTH

RECORD OF INVESTIGATION

DISPOSITION	DATE

LOCATION 2826 St. Johns - La ZIP OWNER Ms. Mildred Contrino ADDRESS same 21042 PHONE 465-8042COMPLAINANT same ADDRESS PHONE REASON FOR INVESTIGATION wants verification of septic failure
so she can connect to pub. sewerRECEIVED BY M. Riskin DATE 4/16/93 ASSIGNED TO M. R DATE 4/16DATE OF INVESTIGATION 4/16 TIME 12:00 WEATHER cool, rainingREPORT 4/16 NO SURFACE SEEPAGE FOUND; SEWAGE RESIDUE
FOUND IN BATHTUB IN BASEMENT; RECOMMEND LETTER
TO ENGINEERING RECOMMENDING CONNECTION MRDATE SUBMITTED SANITARIAN