

PERMIT
SEWAGE DISPOSAL SYSTEM
HOWARD COUNTY HEALTH DEPARTMENT
BUREAU OF ENVIRONMENTAL HEALTH
410-313-2640

P _____

A 513634-B

ISSUE DATE _____

APPROVAL DATE _____

INDEXED
04-321049

_____ IS PERMITTED TO INSTALL _____ ALTER _____

ADDRESS _____ PHONE _____

SUBDIVISION Dill LOT NUMBER 10 ADDRESS 3952 Sharp Road

PROPERTY OWNER Andrew Warren PROPERTY OWNER'S ADDRESS Same

SEPTIC TANK CAPACITY _____ GALLONS

PUMP CHAMBER CAPACITY _____ GALLONS

NUMBER OF BEDROOMS _____

SQUARE FEET PER BEDROOM _____

LINEAR FEET OF TRENCH REQUIRED _____

TRENCHES: Trenches to be _____ feet wide. Inlet _____ feet below original grade. Bottom maximum depth _____ feet below original grade. _____ feet of stone below distribution box.

LOCATION: _____

OLD PERMIT SIGNED

AND RETURNED 6/7/2000

800124352

GARAGE

PLANS APPROVED _____ DATE _____

PERMIT VOID AFTER 2 YEARS

NOTE: CONTRACTOR RESPONSIBLE FOR SCHEDULING A PRE-CONSTRUCTION INSPECTION FOR ALL INSTALLATIONS

NOTE: TOP OF SEPTIC TANKS ARE TO BE NO DEEPER THAN 3.0 FEET BELOW FINISH GRADE

NOTE: WATERTIGHT SEPTIC TANKS REQUIRED

NOTE: CLEANOUT REQUIRED EVERY 70 FEET OF SEWER LINE AND/OR AT 90° SWEEPS IN LINES FROM HOUSE TO DRAIN FIELDS, 90° ELBOWS ARE NOT ACCEPTABLE

NOTE: ALL PARTS OF SEPTIC SYSTEMS (I.E. TANK, DISTRIBUTION BOX, DRAINFIELDS) TO BE 100 FEET FROM ANY WATER WELL UNLESS OTHERWISE SPECIFICALLY AUTHORIZED

NOTE: NO ABSORPTION TRENCH TO EXCEED 100 FEET IN LENGTH UNLESS SPECIFICALLY AUTHORIZED

NOTE: ALL PIPE FROM HOUSE TO SEPTIC TANK MUST BE CAST IRON OR SCHEDULE 35/40 PVC OR ABS

NOTE: MANHOLE RISERS REQUIRED ON ALL SEPTIC TANKS AND PUMP CHAMBERS

NOTE: DISTRIBUTION BOXES MUST HAVE BAFFLES

NOTE: IF PUMPED SEPTIC SYSTEM REQUIRED, (1) SEPTIC PUMP DETAIL TO BE PROVIDED BY INSTALLER PRIOR TO ISSUANCE OF SEPTIC PERMIT (2) PUMP PERFORMANCE TEST IS NECESSARY PRIOR TO HEALTH DEPARTMENT APPROVAL OF SEPTIC PERMIT


NEITHER THE HOWARD COUNTY COUNCIL NOR THE HEALTH DEPARTMENT IS RESPONSIBLE FOR THE
SUCCESSFUL OPERATION OF ANY SYSTEM

PERMITTEE RESPONSIBLE FOR OBTAINING FINAL APPROVAL ON THIS PERMIT

CALL 410-313-2640 FOR INSPECTION OF SEPTIC SYSTEM

A 513634-B

NOT TO SCALE

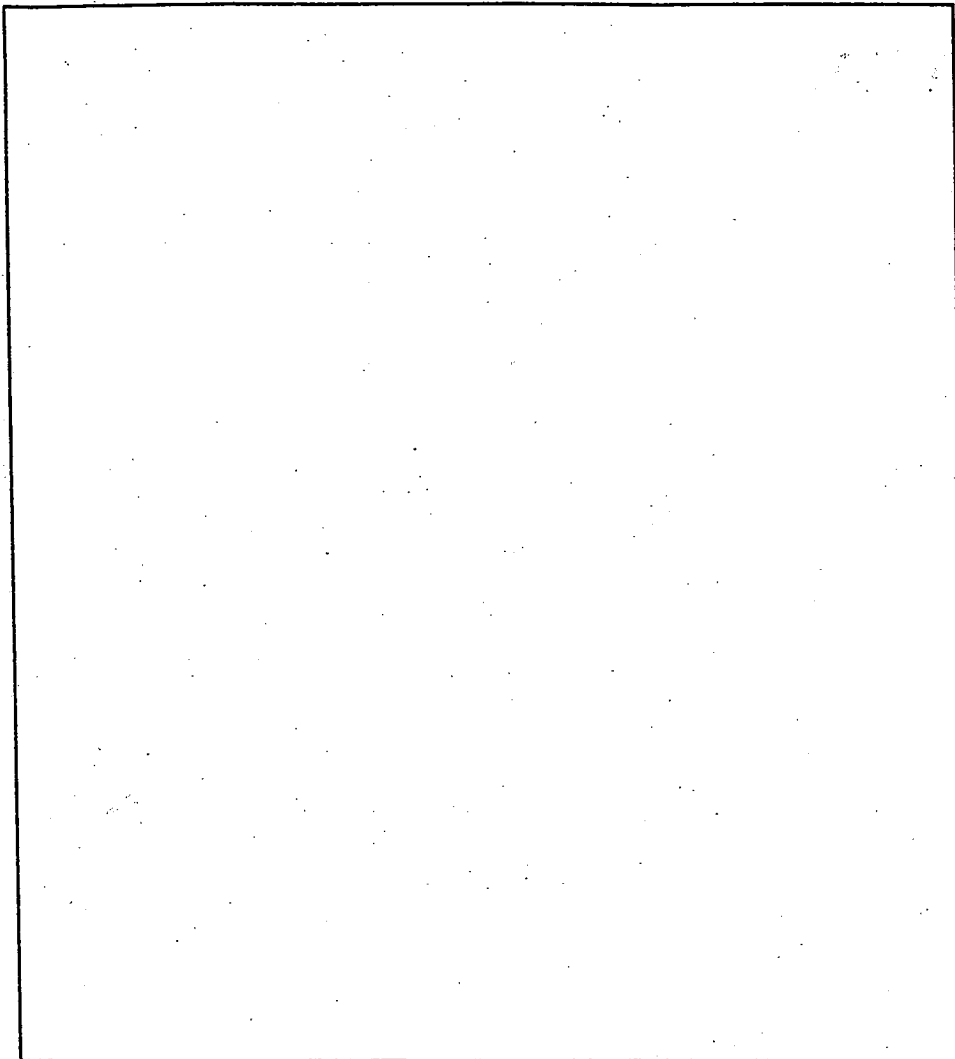

TRENCH DATA

TRENCH WIDTH _____
TRENCH INLET DEPTH _____
TRENCH BOTTOM DEPTH _____
DEPTH OF STONE _____
NUMBER OF TRENCHES _____
TOTAL TRENCH LENGTH _____
ABSORBENT AREA _____
DISTRIBUTION BOX LEVEL _____
BAFFLE IN DISTRIBUTION BOX _____

SEPTIC TANK DATA

SEPTIC TANK _____ GALLONS
MANHOLE RISER _____
6 INCH INSPECTION PORT _____

PUMP CHAMBER DATA

PUMP CHAMBER
GALLONS _____
MANHOLE RISER _____
ALARM _____
PUMP PERFORMANCE TEST _____

PRE-CONSTRUCTION INSPECTION: _____

INSPECTION COMMENTS: _____

INSPECTOR _____ DATE SYSTEM APPROVED _____

41116
Ready

PERMIT

SEWAGE DISPOSAL SYSTEM

MARYLAND STATE DEPARTMENT OF HEALTH

HOWARD COUNTY

P 12983

A 12141

ELLICOTT CITY

DISTRICT 4

DATE 8/26/67

INDEXED

Herman Aish IS PERMITTED TO INSTALL X ALTER

ADDRESS Annapolis Neck Road, Woodbine, Md. PHONE RV 9-4724

A SEWAGE DISPOSAL SYSTEM LOCATED AT _____

SUBDIVISION _____ ROAD Sharp Rd. & Dorsen Lot

PROPERTY OWNER Harry G. Dorsen Hill Rd.

ADDRESS Gary Wickman 3952 Sharp Road

SPECIFICATIONS - 3 bedrooms

Glenwood 27738

DRAIN FIELD _____ DEPTH _____ FEET. BOTTOM AREA _____ SQ. FT.

SEEPAGE PITS _____ ABSORBENT SIDE-WALL AREA _____ SQ. FT.

SEPTIC TANK CAPACITY 750 GALLONS for 3 bedrooms
1,000 " for 4 bedrooms

FOR GARBAGE GRINDER, INCREASE DISPOSAL AREA 22% & TANK CAPACITY 50%.

OTHER Dry well - 100 sq. ft. per bedroom absorbent sidewall area located

50 ft. from front lotline and 115 ft. from right side lot line as seen when

facing lot from Sharp Lane.

MAXIMUM DEPTH PERMITTED 12' below original grade.

PERMIT VOID AFTER THREE YEARS

PLANS APPROVED BY J. H. Kilmore DATE 12/12/66

FILL SEPTIC TANK AND DISTRIBUTION BOX WITH WATER BEFORE CALLING FOR AN INSPECTION. COVER NO WORK UNTIL INSPECTED AND APPROVED.

NEITHER THE HOWARD COUNTY COMMISSIONERS NOR THE HEALTH DEPARTMENT IS RESPONSIBLE FOR THE SUCCESSFUL OPERATION OF ANY SYSTEM.

NOTIFY THE HEALTH DEPARTMENT 48 HOURS
BEFORE EXCAVATIONS ARE TO BE BACK FILLED.

A 12141

5.00 check payable to:
County Health Dept. - Sanitation

APPLICATION

SEWAGE DISPOSAL TESTING

A 123/4

P _____

MARYLAND STATE DEPARTMENT OF HEALTH

HOWARD COUNTY

ELLICOTT CITY

DISTRICT 4

DATE 8/31/66

3 bedroom - Septic Tank - 750 gallons
4 bedroom - " - 1000 gallons

Dry well - 100 sq. ft per bedroom absorbent sandwell
area located 50 ft from front lot line and 115 ft
from right side lot line as seen when facing lot
from Sharp line.

TO: THE COUNTY HEALTH OFFICER
ELLICOTT CITY, MARYLAND

I, HEREBY, APPLY FOR THE NECESSARY TESTS IN ORDER TO CONSTRUCT (OR RECONSTRUCT) A SEWAGE
DISPOSAL SYSTEM.

PROPERTY OWNER Harry C. Dorsey

ADDRESS 3326 Frederick Ave., Baltimore, Md. (29) PHONE LO 6-1523

PROPERTY LOCATION:

SUBDIVISION _____ LOT NO. _____

ROAD AND DESCRIPTION Sharp Rd. ask at house of Mr. BERRY corner of

Sharp Rd. & Dorsey Mill Rd. close to Dill Development

OCCUPANT _____ PHONE _____

PERSON TO CONSTRUCT SYSTEM _____

ADDRESS _____ PHONE _____

SIZE OF LOT 1 acre TYPE BLDG. 3 or 4

NUMBER OF BEDROOMS

IF NOT SINGLE RESIDENCE DESCRIBE _____

SIGNATURE OF APPLICANT Harry C. Dorsey

APPROVED BY J. H. Kilmore FOR Dry well (KIND OF SYSTEM) DATE 12/1/66

REJECTED BY _____ FOR _____ (KIND OF SYSTEM) DATE _____

HOLD PENDING FURTHER TESTS _____ DATE _____

REASONS FOR REJECTION OR HOLDING _____

THIS IS NOT A PERMIT

N 11° 00' 00" E
110.000

SHADY

LANE

N 10° 06' 16" E
10.334.31

71° E - 4000'

R. 333.33
L. 69.92'

R. 1000.92
L. 1000.92

R. 333.33
L. 69.92'

R. 333.33
L. 69.92'

AREA OF

WIDENING

S 18° 45' 00" E
392.41'

S 18° 45' 00" E
392.41'

(FOR PUBLIC USE)

0.412

75' BUILDING RESTRICTION

35'

1000 AC. ±

LOT 10

LINE

20'

Utility

N 51° 05' 00" W

N 97° 25' 00" E
175.68'

Easement

N 51° 05' 00" W

N 38° 57' 00" E - 14.20'

N 97° 25' 00" E
175.68'


ROBERT
240/3

LC VANNER
412/313

19770


N 38° 17' E
106.73.89

not line of

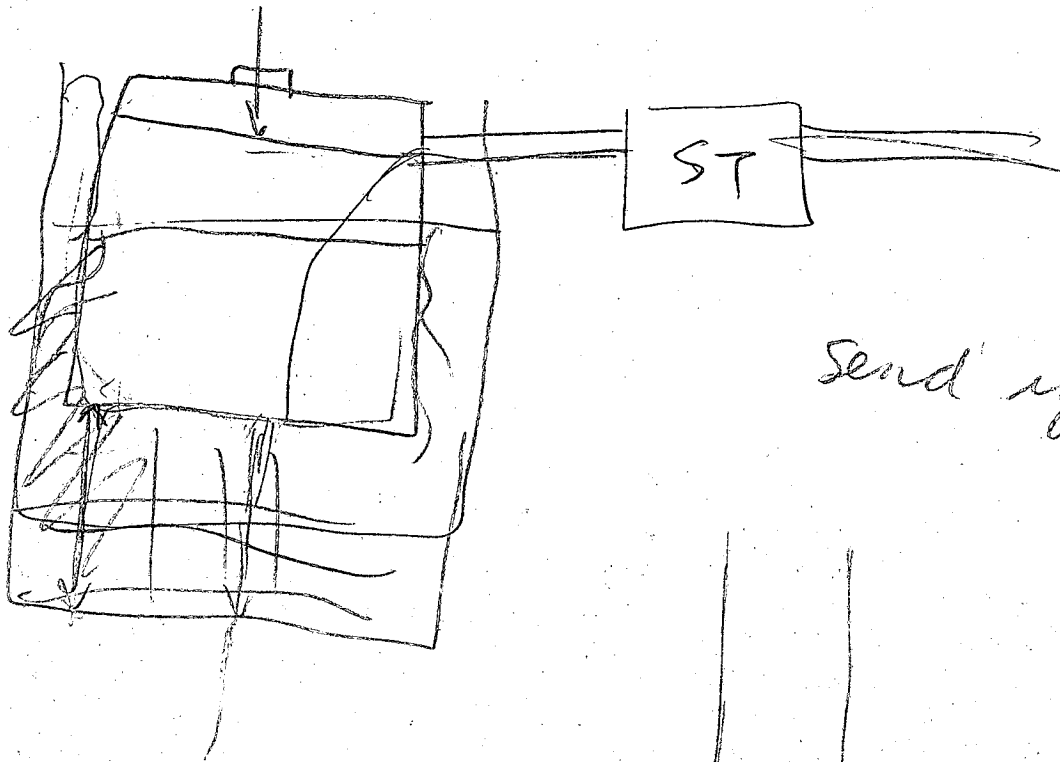

send up



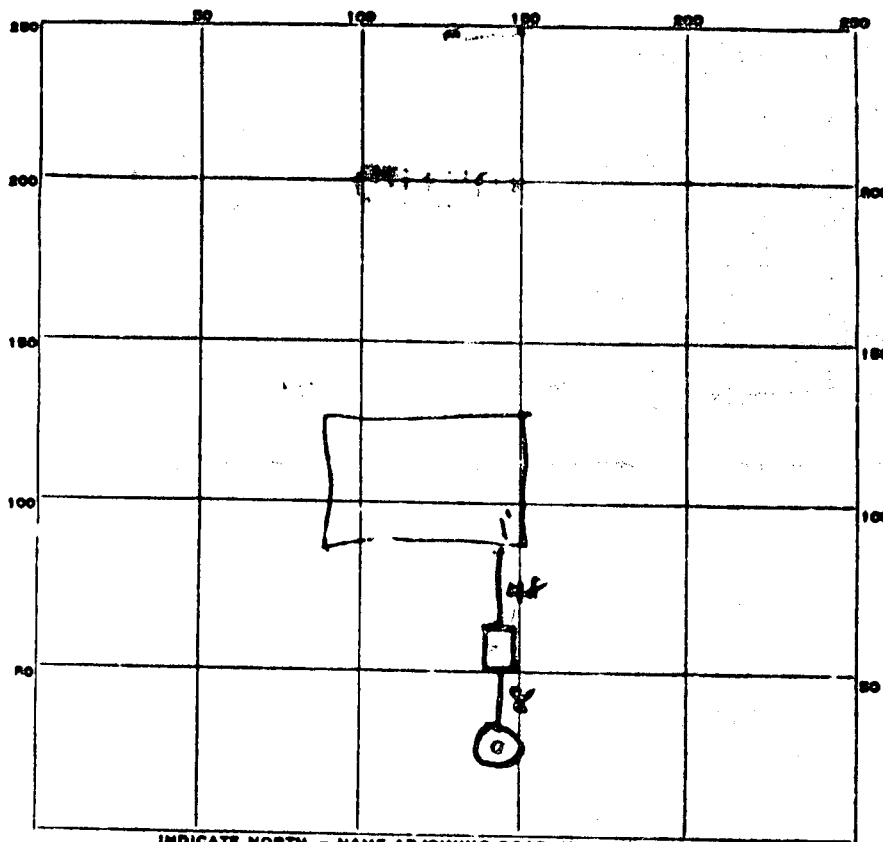


INDICATE NORTH. - NAME ADJOINING ROADWAY AS BASE LINE.

PERMIT CARD OK Sharp Rd.
 SEPTIC TANK, LEVEL OK 1000 gal. CLEANOUTS OK
 DISTRIBUTION BOX, LEVEL _____
 INLET FIELD, DEPTH _____ FT. TRENCH WIDTH _____ FT.
 GRAVEL DEPTH _____ IN. TOTAL LENGTH _____ FT.
 NUMBER OF TRENCHES _____ TOTAL BOTTOM AREA _____
 REPAIR PITS, INSIDE DIAMETER 12 FT. DEPTH BELOW INLET 10 FT.
 ABSORBENT AREA 406 SQ. FT.

REMARKS _____

SYSTEM APPROVED 9/1/67 INSPECTOR J. H. Kilmore

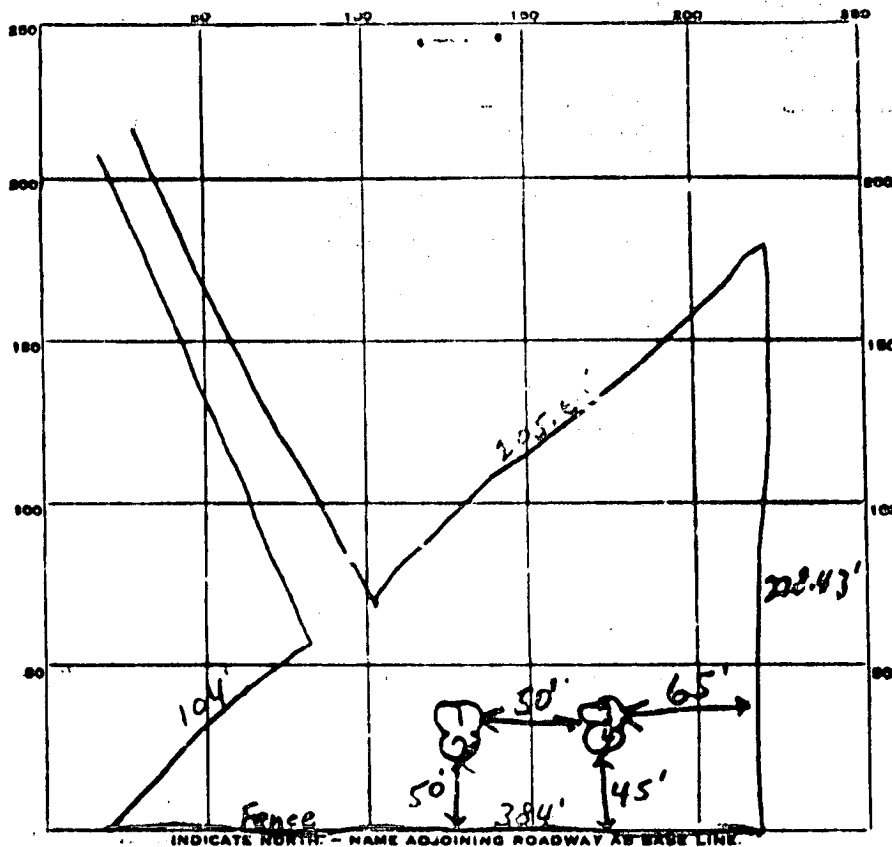

Sharp La.

DATE	TEST NO.	DEPTH	PRE-WET		TEST - 1" DROP		TIME
			START	STOP	START	STOP	
9/2/66	1	5'	10:10	10:14	10:14	10:18	4 min
	2	5'	10:08	10:12	10:12	10:21	9 min
	3	5'	10:03	10:07	10:07	10:11	4 min
	4	9'	10:02	10:07	10:07	10:18	11 min

As. Time

7 min

No greater than 3 ft below grade

SOIL AUGER FINDING

TESTED BY JHK

REMARKS

6/7/00 - Garage location

OK - No

impact to

Well or

Septic (SRH)

SEE ACCURATE

ATTACHED


PLAN

FOR WELL

LOCATION

3957
SHARPP
452'±

ROAD

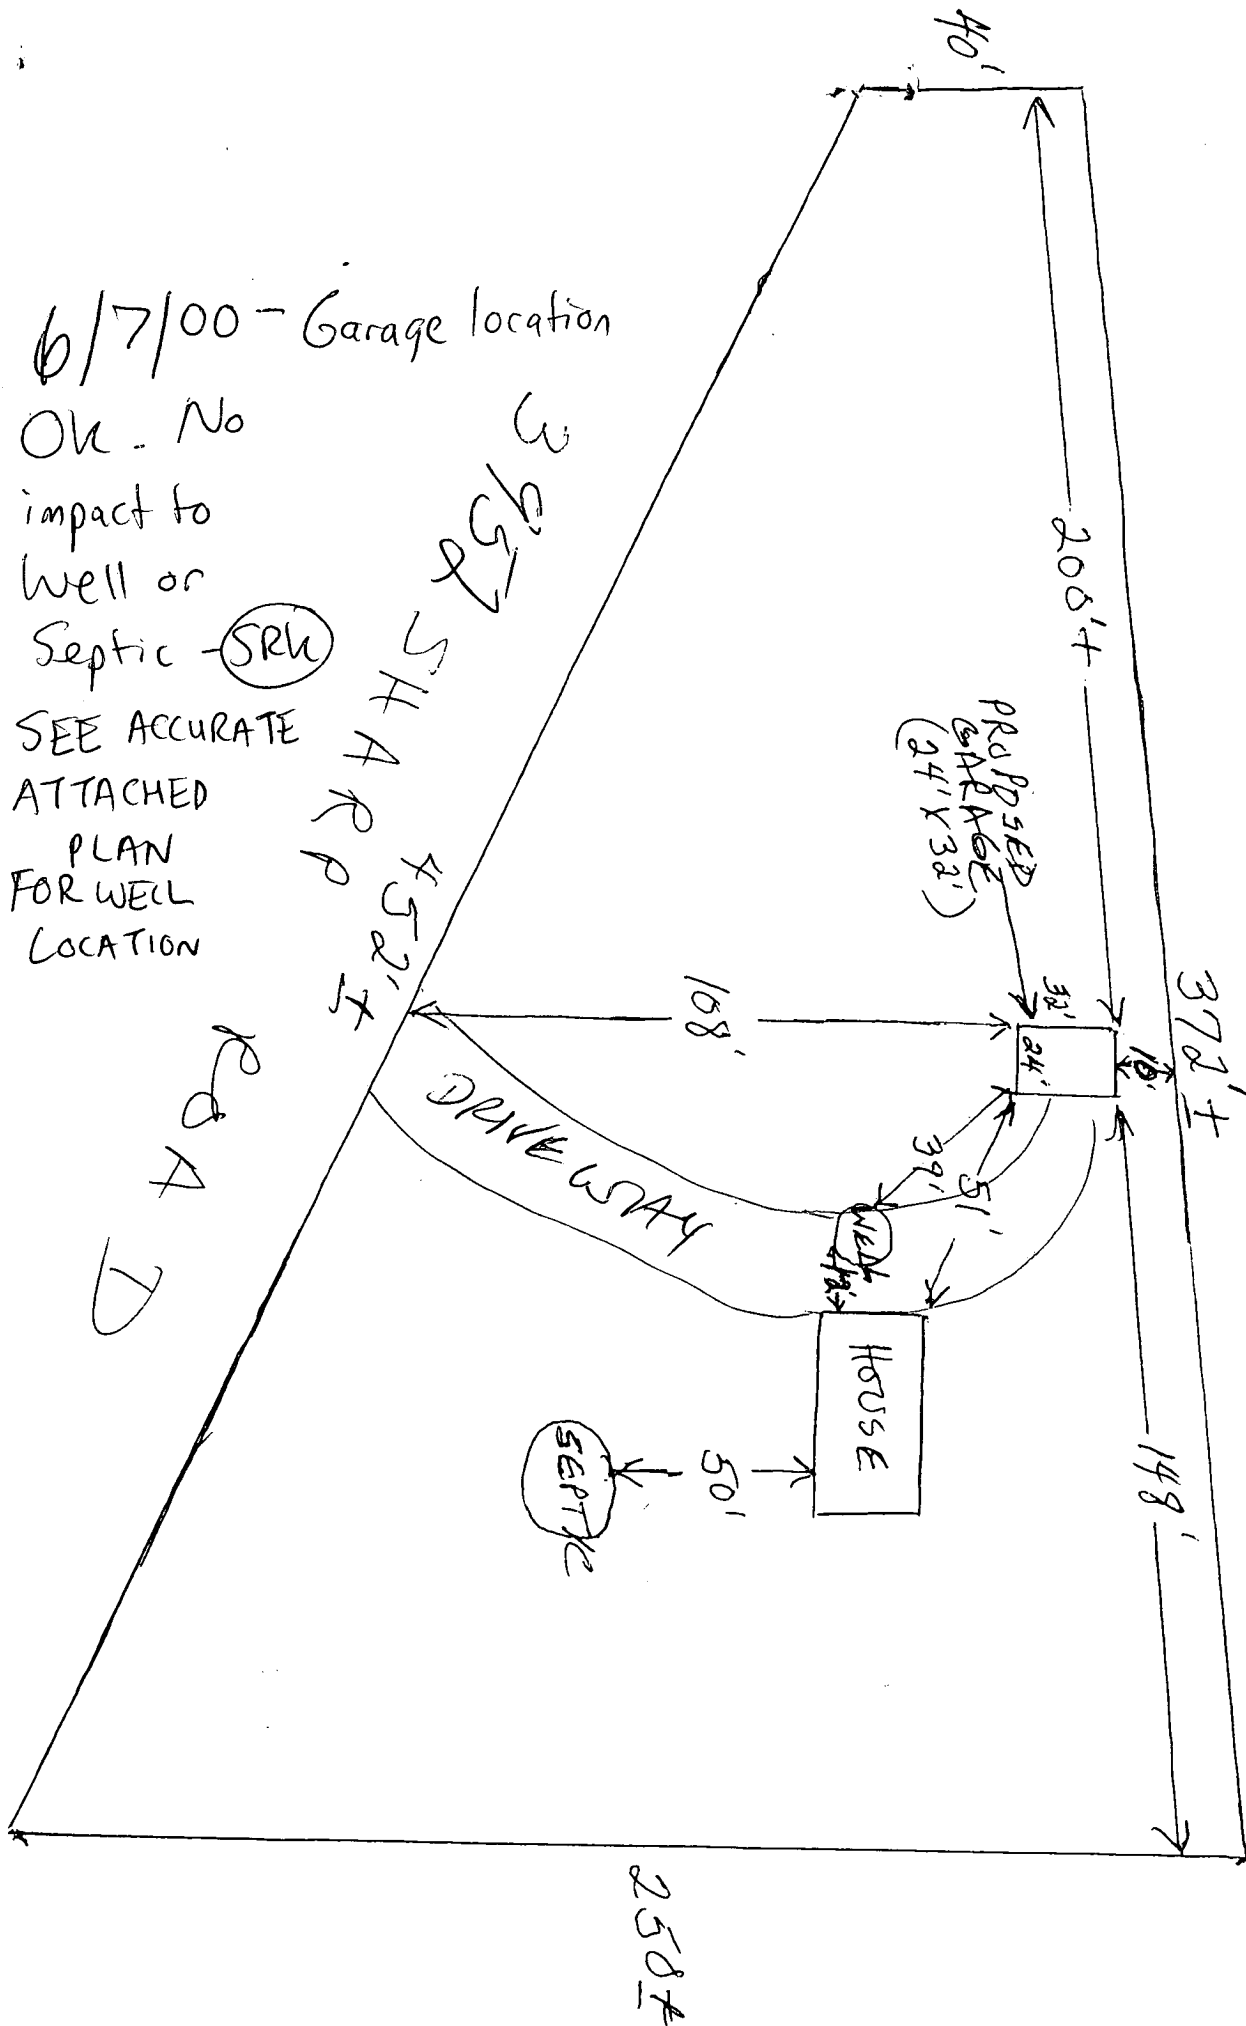

SCALE 1/4" = 10' LESS THAN 3) ACRES

BP 000124352

SITE INSPECTION SHEET

OWNER: Andrew WarrenADDRESS: 3952 Sharp Road
Glenwood, MD 21738TAX & PARCEL: 21, 118

PROPOSAL: _____

DATE REQUESTED: _____


DRILLER/CONTRACTOR: _____

WELL TAG NUMBER: _____

COUNTY: Howard

LOCATION DIAGRAM

NOT TO SCALE

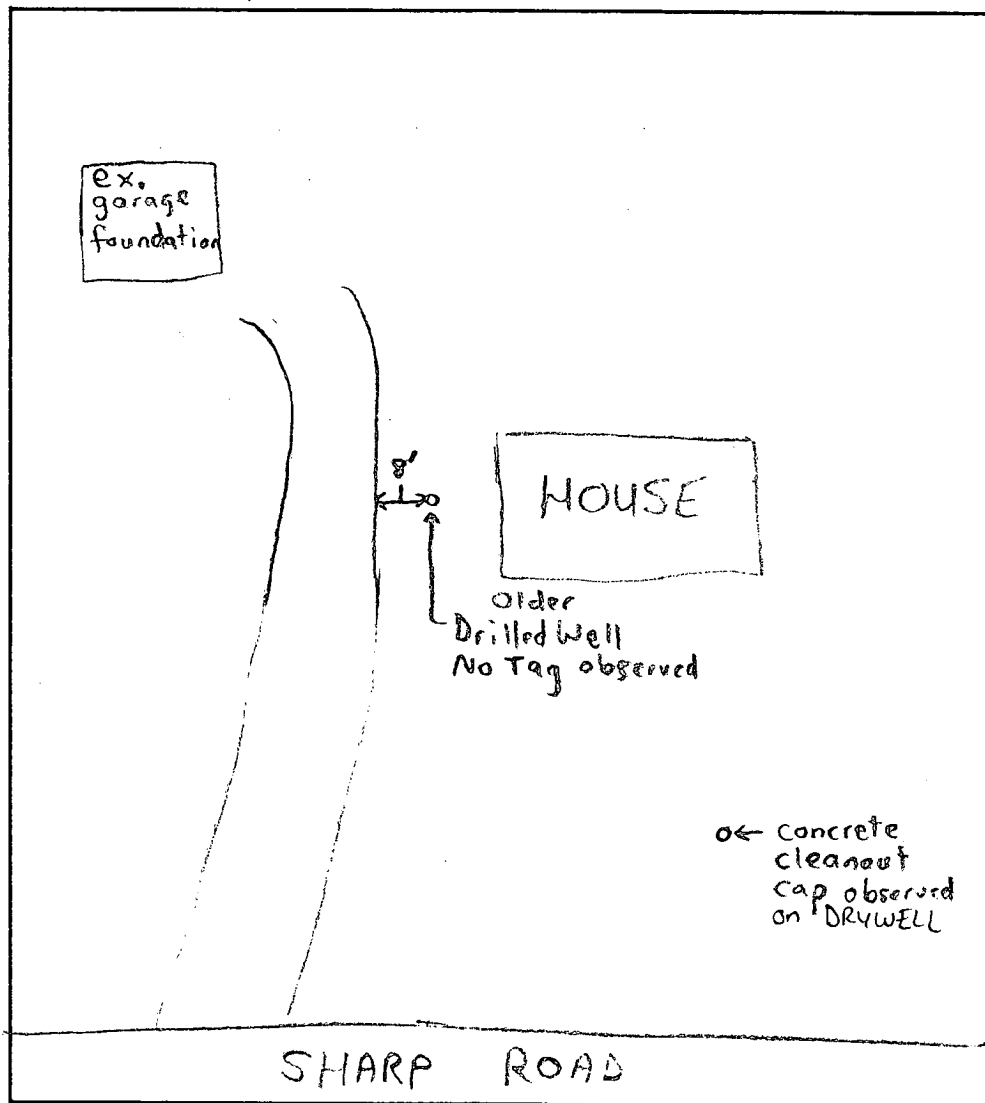COMMENTS: Proposed Garage location has no impact to well or
septic. Met owner and discussed information.DATE: 6/7/00INSPECTOR: Steven R. King