

PERMIT

SEWAGE DISPOSAL SYSTEM

DEPARTMENT OF HEALTH AND MENTAL HYGIENE

P 513157

A 20435

DISTRICT _____

DATE 12/3/1999

DATE SYSTEM APPROVED 1/18/00

INSPECTOR DKS

HOWARD COUNTY HEALTH DEPARTMENT

BUREAU OF ENVIRONMENTAL HEALTH

XXXXXX 410-313-2640

INDEXED

03-294390

Global Equipment IS PERMITTED TO INSTALL ☒ ALTER ☐

ADDRESS P.O. Box 3595 Frederick, Maryland 21705 PHONE 301-261-4885

SUBDIVISION Roman Ridge Estates LOT 6 ROAD 14140 Rover Mill Road

PROPERTY OWNER Glen & Nancy Balick

ADDRESS _____

SEPTIC TANK CAPACITY 1250 GALLONS TOP SEAMED TANK

NUMBER OF BEDROOMS 4

60 SQUARE FEET PER BEDROOM

LINEAR FEET OF TRENCH REQUIRED 240

TRENCHES - Trench to be 3 feet wide. Inlet 4.0 feet below original grade. Bottom maximum depth 6.0 feet below original grade. Effective area begins at 4.0 feet below original grade. 2.0 feet of stone below distribution pipe.

LOCATION - Beginning from the intersection of the 360.00' and 572.00' lot lines, begin trenches 225 feet up the 572.00' lot line and 95 feet off that same lot line. Run trenches on contour in both directions.

NOTES - No trench to exceed 100 feet in length. Provide 6" - 8" diameter cleanout and cap to grade or above on septic tank.

OK 6/21/99

PLANS APPROVED BY Amy McMillen DATE 6-11-1999

COVER NO WORK UNTIL INSPECTED AND APPROVED

NEITHER THE HOWARD COUNTY COUNCIL NOR THE HEALTH DEPARTMENT IS RESPONSIBLE FOR THE SUCCESSFUL OPERATION OF ANY SYSTEM

NOTE: CLEANOUT REQUIRED EVERY 70 FEET OF SEWER LINE AND/OR AT 90° SWEEPS IN LINES FROM HOUSE TO DRAIN FIELDS. 90° ELBOWS NOT ACCEPTABLE.

NOTE: ALL PARTS OF SEPTIC SYSTEMS (I.E. TANK, DISTRIBUTION BOX TRENCHES) TO BE 100 FEET FROM WELL (UNLESS OTHERWISE SPECIFICALLY AUTHORIZED)

NOTE: IF DEEP TRENCH(ES) ARE USED CALL FOR INSPECTION BEFORE AND AFTER PLACING GRAVEL IN TRENCH(ES)

NOTE: NO DRY WELL SHALL EXCEED 15 FOOT IN DIAMETER NO ABSORPTION TRENCH TO EXCEED 100 FEET IN LENGTH

NOTE: ALL PIPE FROM HOUSE TO SEPTIC TANK MUST BE CAST IRON OR SCHEDULE 35/40 PVC OR ABS

PERMIT VOID AFTER TWO YEARS


NOTE: INSTALL STAND PIPE ON SEPTIC TANK AND DRY WELL STAND PIPES MUST BE 6 INCHES IN DIAMETER CAST IRON. CONCRETE OR TERRA COTTA OR PVA OR ABS ACCEPTED. IF TOP OF SEPTIC TANK IS DEEPER THAN 3 FEET. MANHOLE TO GRADE REQUIRED.

NOTE: DISTRIBUTION BOXES MUST HAVE BAFFLES

*INSTALLER IS RESPONSIBLE FOR OBTAINING FINAL APPROVAL ON THIS PERMIT

*CALL 461-9933 FOR INSPECTION OF SEPTIC SYSTEM.

1204135
P 513157

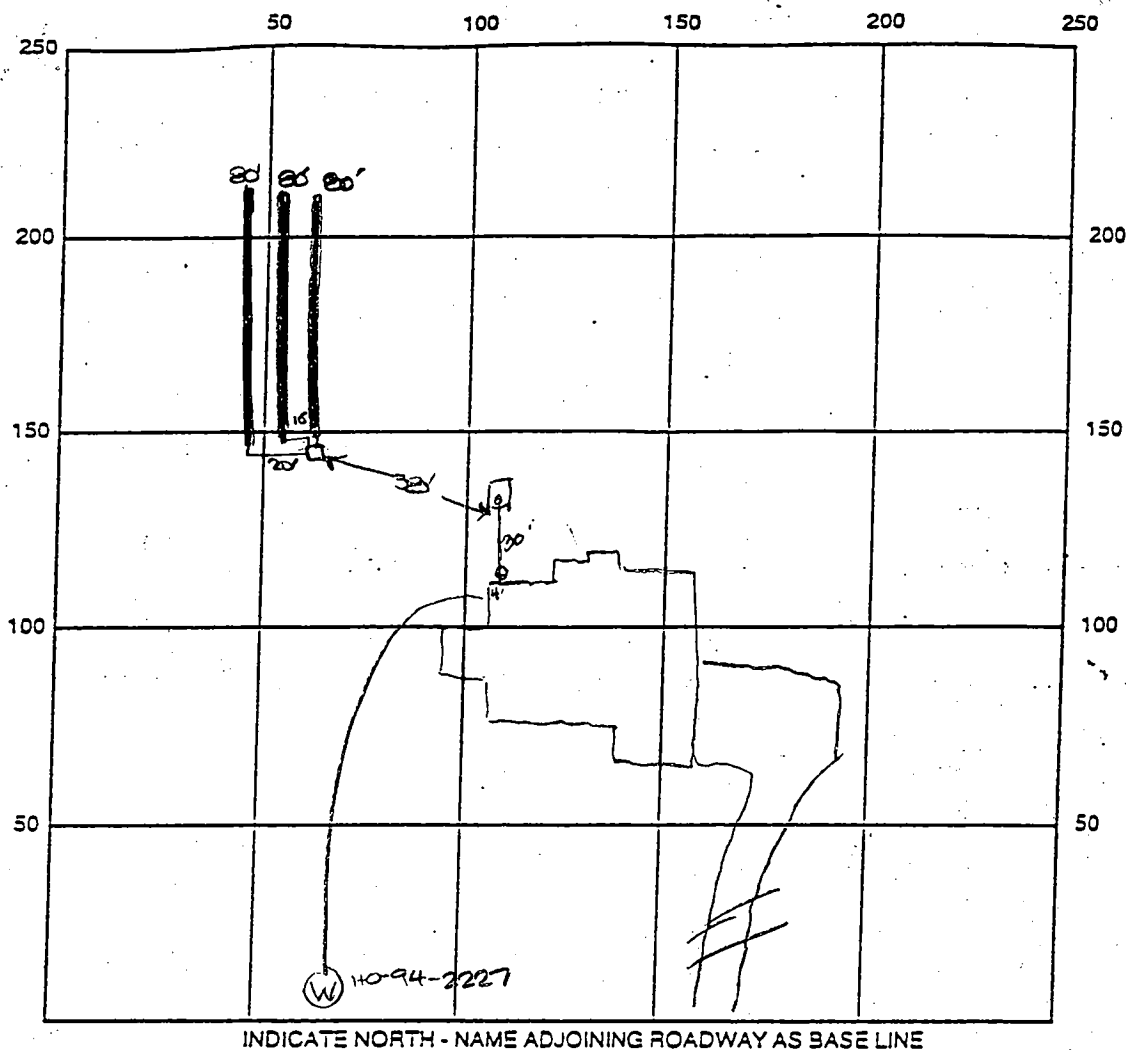

SEPTIC TANK LEVEL OK

DISTRIBUTION BOX LEVEL or - baffle in

DRAIN FIELD/TITLE DEPTH 6 FT.

TRENCH WIDTH 3 FT.

INLET DEPTH 4 FT.

EFFECTIVE GRAVEL DEPTH 2 FT.

TOTAL LENGTH 240 FT.

NUMBER OF TRENCHES

ONE SIDEWALL/BOTTOM AREA 720 SQ. FT.

DRYWALL INSIDE DIAMETER _____ FT.

EFFECTIVE DEPTH BELOW INLET FT.

ABSORBENT AREA _____ SQ. FT.

REMARKS: 1/14/00 Distribution box moved slightly downhill due to "hump" & topo different than on plan - new box placement will allow end of 1st trench to run into test hole "P" du

1/18/00 FINAL INSP-OK to cover all septic work. DCS

DATE SYSTEM APPROVED

1	18	00
---	----	----

INSPECTOR

Found 700

APPLICATION

PERCOLATION TESTING

A _____

P _____

HOWARD COUNTY HEALTH DEPARTMENT
BUREAU OF ENVIRONMENTAL HEALTH
3525-H ELLICOTT MILLS DRIVE/ELLICOTT CITY, MARYLAND 21043
TELEPHONE: 313-2640

2/12/99
Purpose: Confirm
septic area on
existing lot of record
Au

DISTRICT _____

DATE _____

TO: THE COUNTY HEALTH OFFICER
ELLICOTT CITY, MARYLAND

I HEREBY APPLY FOR THE NECESSARY TEST PRIOR TO APPLICATION FOR PERMIT TO CONSTRUCT (OR RECONSTRUCT) A SEWAGE DISPOSAL SYSTEM.

PROPERTY OWNER DAVID AHLGROIST / CO PAT WEYMOUTH

ADDRESS OXWELL WAVE LAUREL PHONE GLEN & NANCY BALICK

AGENT OR PROSPECTIVE BUYER PAT WEYMOUTH

ADDRESS 10805 HICKORY RIDGE RD PHONE 410 730 4343 x203
SUITE 215 COLUMBIA 21014

PROPERTY LOCATION:

SUBDIVISION ROMAN ESTATE LOT NO. LOT #6

ROAD AND DESCRIPTION 14140 ROVER MULL

TAX MAP 15 PARCEL # 203

SIZE OF LOT 5 ACRES TYPE BLDG. SFD - 4 BR
(SINGLE FAMILY DWELLING OR COMMERCIAL)

THE SYSTEM INSTALLED UNDER THIS APPLICATION IS ACCEPTABLE ONLY UNTIL PUBLIC FACILITIES BECOME AVAILABLE. I FULLY UNDERSTAND THE

FEE CONNECTED WITH THE FILING OF THIS PERC TEST APPLICATION IS NON-REFUNDABLE UNDER ANY CIRCUMSTANCES. I ALSO AGREE TO

COMPLY WITH ALL M.O.S.H.A. REQUIREMENTS IN TESTING THIS LOT.

(SIGNATURE OF APPLICANT)

APPROVED BY _____ FOR _____ DATE _____

DISAPPROVED BY _____ FOR _____ DATE _____

HOLD PENDING FURTHER TESTS _____

REASONS FOR REJECTION OR HOLDING _____

PERCOLATION TEST PLAT/PRELIMINARY PLAT - TITLE OR I.D. # _____ DATE _____

SITE DEVELOPMENT PLAN/FINAL PLAT - TITLE OR I.D. # _____ DATE _____

THIS IS NOT A PERMIT


COUNTY #

SOIL PROFILE

A, G

dark
red
Siclmpink to
dark
red
Sisalm
100%
Rx

SOIL PROFILE

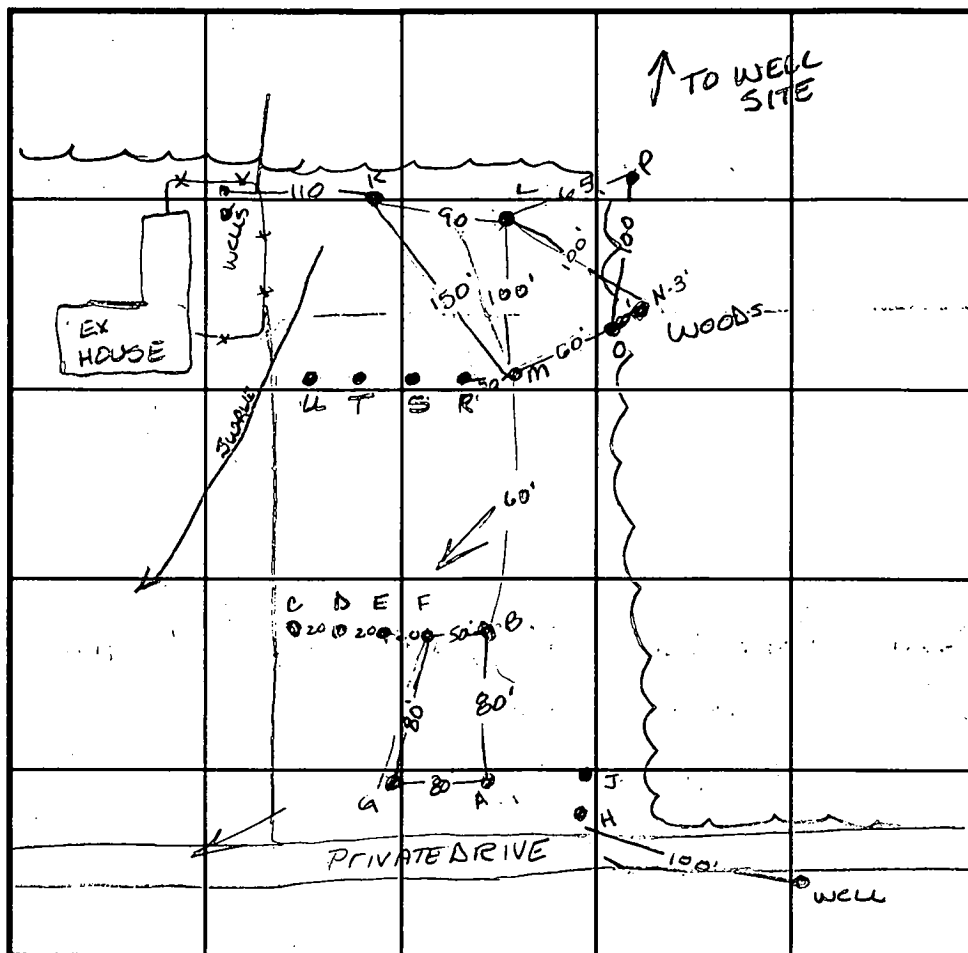

INDICATE NORTH - NAME ADJOINING ROADWAY AS BASE LINE.

DATE	TEST NO.	DEPTH	PRE-WET		TEST - 1" DROP		TIME
			START	STOP	START	STOP	
3-2-99	A	4.5' / 12.0'	2:17	no mvt	2:35	—	slow
	J	Refusal	@ 2.0' - insufficient depth to		bedrock	—	F
	B	4.5' / 12.0'	2:21 ³⁰	2:25	2:25	2:31	6min
	C	Refusal	@ 8.0' - clay to s.s. insufficient		depth to bedrock		F
	H, D	Refusal	@ 6.0' - insufficient depth to		bedrock		F
	E	Refusal	@ 7.0' - insufficient depth to		bedrock		F
	F	4.5' / 12.0'	2:54 ³⁰	3:05	No perc	@ 3:45	slow
	L	5.5' / 11.5'	3:52	3:53	3:53	3:56	3min
	K	6.0' / 12.0'	3:45	3:52	3:52	4:05	13min
	M	5.5' / 12.0'	3:57 ³⁰	3:59	3:59	4:02	3min

REMARKS Use holes K, L, P, O, M

TYPE OF SOIL

TESTED BY Amy McMillen ALSO PRESENT buyers

TRENCH DESIGN DATA: AVERAGE PERCOLATION TIME 6min TRENCH WIDTH 3.0

INLET DEPTH 4.0 MAXIMUM BOTTOM DEPTH 6.0 SQ. FT./BEDROOM 180

orange
brn
Siclm

30% Rx

lgt tan
to
pink
Sisalm
100% Rx

Roman Estates - Lot 6

COUNTY #

SOIL PROFILE

0'

SOIL PROFILE

0'

		See attached for diagram		

INDICATE NORTH - NAME ADJOINING ROADWAY AS BASE LINE.

DATE	TEST NO.	DEPTH	PRE-WET		TEST - 1" DROP		TIME
			START	STOP	START	STOP	
3-2-99	N	Refusal @ 3.0'		Insufficient depth to bedrock			F
	O	Visual		to 12.0' - see profile			OK
	P	5.0' / 12.0'	4:25	4:29	4:29	4:35	6min
	R	Refusal at 1.0'		Insufficient depth to bedrock			F
	S	Refusal at 3.0'		Insufficient depth to bedrock			F
	T	Refusal at 5.0'		Insufficient depth to bedrock			F
	U	Refusal at 6.0'		Insufficient depth to bedrock			F

REMARKS _____

TYPE OF SOIL _____

TESTED BY Amy McMillen ALSO PRESENT buyers

TRENCH DESIGN DATA: AVERAGE PERCOLATION TIME _____ TRENCH WIDTH _____

INLET DEPTH _____ MAXIMUM BOTTOM DEPTH _____ SQ. FT/BEDROOM _____

RECORDED

APPLICATION

A 20435

SEWAGE DISPOSAL TESTING

P _____

STATE OF MARYLAND - DEPARTMENT OF HEALTH AND MENTAL HYGIENE

HOWARD COUNTY HEALTH DEPARTMENT
ENVIRONMENTAL HEALTH SERVICES

DISTRICT 3rd & 4th

P. O. BOX 476, ELLICOTT CITY, MARYLAND 21043
TELEPHONE: 465-5000, EXT. 356

DATE 7/30/74

1 → 3 B.R.

4 B.R.

1000 gal. septic tank

1250 gal. septic tank

Drywell to have 150 sq. ft. effective sidewall absorption area per bedroom below the first 5 ft. of non-absorbant soil. Maximum length permitted for drywell is 12 1/2 ft. below original grade. Place the drywell 175 ft. from the rear lot line and 30 ft. from the right lot line as seen when facing the lot from the right-of-way.

TO: THE COUNTY HEALTH OFFICER
ELLICOTT CITY, MARYLAND

I, HEREBY, APPLY FOR THE NECESSARY TEST IN ORDER TO CONSTRUCT (OR RECONSTRUCT) A SEWAGE DISPOSAL SYSTEM.

PROPERTY OWNER Ruth Thompson

Any questions call Mr. Bernard

ADDRESS _____ PHONE Rome, 465-7700

PROPERTY LOCATION:

SUBDIVISION _____ LOT NO. 6

ROAD AND DESCRIPTION Rover Mill Road

SIZE OF LOT 5.003 acres TYPE BLDG 3 or 4 bedrooms
NUMBER OF BEDROOMS

IF NOT SINGLE RESIDENCE DESCRIBE _____

THE SYSTEM INSTALLED UNDER THIS APPLICATION IS ACCEPTABLE ONLY UNTIL PUBLIC FACILITIES BECOME AVAILABLE.

SIGNATURE OF APPLICANT /s/ Bernard Rome


APPROVED BY Frank Skinner FOR DRYWELL DATE 8/9/74
(KIND OF SYSTEM)

REJECTED BY _____ FOR _____ DATE _____
(KIND OF SYSTEM)

HOLD PENDING FURTHER TESTS _____ DATE _____

REASONS FOR REJECTION OR HOLDING _____

THIS IS NOT A PERMIT

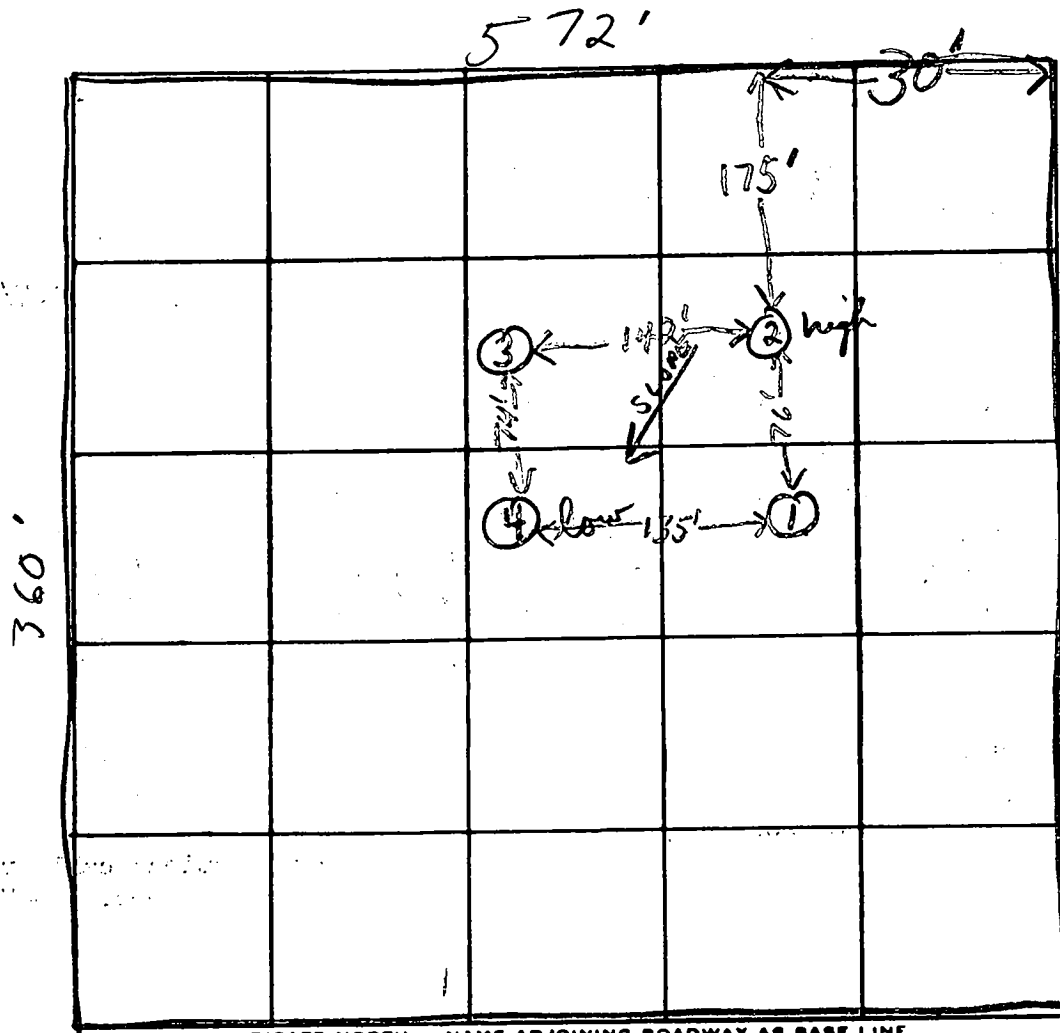

INDICATE NORTH. - NAME ADJOINING ROADWAY AS BASE LINE.

R/W

DATE	TEST NO.	DEPTH	PRE-WET		TEST - 1" DROP		TIME
			START	STOP	START	STOP	
8/6/74	1	5'	3:22	1/2" drop in 25 min			30 min
	1A	11 1/2'	3:08	3:12	3:12	3:20	8 min
	2 high	5'	3:30	3:40	3:40	3:50	10 min
	2A	12 1/2'	3:30	3:35	3:35	3:40	5 min
	3	11 1/2'	Visual	clay to 5' soil			below
	4 low	4'	3:55	4:01	4:01		30 min
8/7/74	4A	12 1/2'	10:30	10:34	10:34	10:42	8 min
8/7/74	4B	5'	10:22	10:30	10:30	10:33	3 min
	1B	5'	10:37	10:39	10:39	10:43	4 min

30
8
10
5
30
8
3
4
89 8

(12 min
AVG.)

REMARKS

TYPE OF SOIL

sandy loam & some shale; clay loam 3-5'

TESTED BY

F.S.

ALSO PRESENT:

J. Brittingham
C.B.S. 8/6 / R.H. 8/7

B 1	7822	SEQUENCE NO. (MDE USE ONLY)	STATE OF MARYLAND PERMIT TO DRILL WELL please print or type	STATE PERMIT NUMBER <u>HO-94-2227</u> fill in this form completely
Date Received (APA) <u>04-26-99</u> 8 MM DD YY 13		OWNER INFORMATION		
15 Last Name <u>10090</u>		Owner First Name <u>Land LLC</u>		
36 Street or RFD <u>8000 Main Street</u>		55		
57 Town <u>Emicott City, Md.</u>		70 State 72 Zip 76 <u>21043</u>		
DRILLER INFORMATION				
Driller's Name <u>Michael Barlow</u>		MWD355 License No. 81		
Firm Name <u>Michael Barlow Well Drilling Service</u>				
Address <u>912 Fawn G. Forest 21085</u>				
Signature <u>[Signature]</u> Date <u>4/21/99</u>				
B 2		WELL INFORMATION		
1 2		APPROX. PUMPING RATE (GAL. PER MIN.) <u>5</u>		
AVERAGE DAILY QUANTITY NEEDED (GAL. PER DAY) <u>500</u>		14 20		
USE FOR WATER (CIRCLE APPROPRIATE BOX)				
☒ DOMESTIC POTABLE SUPPLY & RESIDENTIAL IRRIGATION ☐ FARMING (LIVESTOCK WATERING & AGRICULTURAL IRRIGATION) ☐ INDUSTRIAL, COMMERCIAL, DEWATERING ☐ PUBLIC WATER SUPPLY WELL ☐ TEST, OBSERVATION, MONITORING ☐ GEO-THERMAL				
NOT TO BE FILLED IN BY DRILLER HEALTH DEPARTMENT APPROVAL				
COUNTY NAME <u>Howard County</u> COUNTY NO. <u>A20435</u> STATE SIGNATURE _____ INSERT S → _____ DATE ISSUED <u>042799</u> <u>A. McMillen</u> 04/27/00 43 MM DD YY 48 CO SIGNATURE _____ EXP. DATE _____ NORTH GRID <u>530 000</u> EAST GRID <u>800 000</u> 50 55 57 63				
APPROXIMATE DEPTH OF WELL <u>300</u> FEET 24 28		NEAREST INCH		
APPROXIMATE DIAMETER OF WELL <u>6</u>				
METHOD OF DRILLING (circle one)				
BORED (or Augered) ☐ JETTED ☐ Jetted & DRIVEN ☐ 30 AIR-ROTARY ☐ AIR-PERCussion ☒ ROTARY (Hydraulic Rotary) ☐ 37 CABLE ☐ REverse-ROTARY ☐ Drive-POINT ☐ other _____				
REPLACEMENT OR DEEPENEED WELLS (CIRCLE APPROPRIATE BOX)				
☒ THIS WELL WILL NOT REPLACE AN EXISTING WELL ☐ THIS WELL WILL REPLACE A WELL THAT WILL BE ABANDONED AND SEALED 39 ☐ THIS WELL WILL REPLACE A WELL THAT WILL BE USED AS A STANDBY-CONTACT LOCAL APPROVING AUTHORITY FOR POLICY ON STANDBY WELLS ☐ THIS WELL WILL DEEPEN AN EXISTING WELL PERMIT NUMBER OF WELL TO BE REPLACED OR DEEPENEED (IF AVAILABLE) 41 _____ 52 _____				
Not to be filled in by driller (MDE OR COUNTY USE ONLY)				
APPROP. PERMIT NUMBER <u>54</u> G A P <u>63</u> PERMIT No. <u>HO-94-2227</u> 70 71 72 73 74 75 76 77 78 79				
SPECIAL CONDITIONS NOTE - APPROVING AUTHORITIES SHOULD USE SEPARATE SHEET IF NEEDED -				

LOCATION OF WELL
 8 COUNTY Howard 21
 23 SUBDIVISION Roman Estates 42
 SECTION 44 46 LOT 6 48 50
Greenwood
 52 NEAREST TOWN _____ 71
 MILES FROM TOWN (enter 0 if in town) 1 M I
73 76-77 78

11 NEAR WHAT ROAD Rover Min Rd. 30
 ON WHICH SIDE OF ROAD (CIRCLE APPROPRIATE BOX)
 NORTH ☒ NORTH ☐
 WEST ☐ EAST ☐
 SOUTH ☐
 34 2000 37
 DISTANCE FROM ROAD FT
 ENTER FT OR MI 38 39
 TAX MAP: _____ BLK: _____ PARCEL: _____

DIRECTION OF WELL FROM TOWN (CIRCLE BOX)

SHOW MAJOR FEATURES OF BOX & LOCATE WELL WITH AN X
 SOURCES OF DRILLING WATER
 1.
 2.
 3.
 WRITE THE BOX NUMBER FROM THE MAP HERE
 E 800
 N 530
 000
 000

DRAW A SKETCH BELOW SHOWING LOCATION OF WELL IN RELATION TO NEARBY TOWNS AND ROADS AND GIVE DISTANCE FROM WELL TO NEAREST ROAD JUNCTION

C 1 08600		SEQUENCE NO. (MDE USE ONLY)		STATE OF MARYLAND WELL COMPLETION REPORT FILL IN THIS FORM COMPLETELY PLEASE PRINT OR TYPE		THIS REPORT MUST BE SUBMITTED WITHIN 45 DAYS AFTER WELL IS COMPLETED.	
THIS NUMBER IS TO BE PUNCHED IN COLS. 3-6 ON ALL CARDS)						COUNTY NUMBER A 20435	
ST/CO USE ONLY DATE Received MM DD YY 8 13		DATE WELL COMPLETED MM DD YY 5 13 99		Depth of Well 22 225 26 (TO NEAREST FOOT)		PERMIT NO. FROM "PERMIT TO DRILL WELL" HO-94-2227 28 29 30 31 32 33 34 35 36 37	
OWNER 100% Land		STREET OR RFD Rover Mill Road		TOWN Glenwood			
SUBDIVISION Roman Estates		SECTION		LOT 6			
WELL LOG Not required for driven wells		GROUTING RECORD WELL HAS BEEN GROUTED (Circle Appropriate Box) yes Y no N 44 44 TYPE OF GROUTING MATERIAL (Circle one) CEMENT CM BENTONITE CLAY BC NO. OF BAGS 43 NO. OF POUNDS 122 GALLONS OF WATER 78 DEPTH OF GROUT SEAL (to nearest foot) from 0 ft. to 50 ft. 48 TOP 52 54 BOTTOM 58 (enter 0 if from surface)		C 3 PUMPING TEST HOURS PUMPED (nearest hour) 3 8 9 PUMPING RATE (gal. per min.) 12 PUMPING METHOD USED TO MEASURE PUMPING RATE Watch & Bucket 15 WATER LEVEL (distance from land surface) BEFORE PUMPING 37 ft. 17 20 WHEN PUMPING 135 ft. 22 25 TYPE OF PUMP USED (for test) A air P piston T turbine 27 27 27 C centrifugal R rotary O other (describe below) 27 27 27 J jet S submersible 27 27			
STATE THE KIND OF FORMATIONS PENETRATED, THEIR COLOR, DEPTH, THICKNESS AND IF WATER BEARING		CASING RECORD casing types insert appropriate code below ST STEEL CO CONCRETE PL PLASTIC OT OTHER MAIN CASING TYPE PL Nominal diameter top (main) casing (nearest inch) 06 Total depth of main casing (nearest foot) 50 60 61 63 64 66 70 OTHER CASING (if used) diameter depth (feet) inch from to E A C H C A S I N G		PUMP INSTALLED DRILLER WILL INSTALL PUMP (CIRCLE) (YES or NO) YES NO IF DRILLER INSTALLS PUMP, THIS SECTION MUST BE COMPLETED FOR ALL WELLS. TYPE OF PUMP INSTALLED PLACE (A,C,J,P,R,S,T,O) IN BOX 29 CAPACITY: GALLONS PER MINUTE (to nearest gallon) 31 35 PUMP HORSE POWER 37 41 PUMP COLUMN LENGTH (nearest ft.) 43 47 CASING HEIGHT (circle appropriate box and enter casing height) + above 2 (nearest foot) LAND SURFACE - below 50 51			
DESCRIPTION (Use additional sheets if needed)		FEET FROM TO Brown Soil 0 45 HARD GRAY GRANITE 45 225 60 ✓ 105 ✓ 185 ✓		SCREEN RECORD screen type or open hole (insert appropriate code below) ST STEEL BR BRASS HO OPEN HOLE PL PLASTIC OT OTHER C 2 DEPTH (nearest ft.) HO 50 225 1 2 E 8 9 11 15 17 21 A 23 24 26 30 32 36 H 38 39 41 45 47 51 S C 3 R E E N SLOT SIZE 1 2 3 DIAMETER OF SCREEN (NEAREST INCH) 55 60 from to GRAVEL PACK IF WELL DRILLED WAS FLOWING WELL INSERT F IN BOX 68 68		LOCATION OF WELL ON LOT SHOW PERMANENT STRUCTURE SUCH AS BUILDING, SEPTIC TANKS, AND /OR LANDMARKS AND INDICATE NOT LESS THAN TWO DISTANCES (MEASUREMENTS TO WELL) See Attached	
NUMBER OF UNSUCCESSFUL WELLS: 0		WELL HYDROFRACTURED yes Y no N		CIRCLE APPROPRIATE LETTER A A WELL WAS ABANDONED AND SEALED WHEN THIS WELL WAS COMPLETED E ELECTRIC LOG OBTAINED P TEST WELL CONVERTED TO PRODUCTION WELL		MDE USE ONLY (NOT TO BE FILLED IN BY DRILLER) T (E.R.O.S.) W.Q 70 72 74 75 76 TELESCOPE CASING LOG INDICATOR OTHER DATA	
I HEREBY CERTIFY THAT THIS WELL HAS BEEN CONSTRUCTED IN ACCORDANCE WITH COMAR 26.04.04 "WELL CONSTRUCTION" AND IN CONFORMANCE WITH ALL CONDITIONS STATED IN THE ABOVE CAPTIONED PERMIT, AND THAT THE INFORMATION PRESENTED HEREIN IS ACCURATE AND COMPLETE TO THE BEST OF MY KNOWLEDGE.		DRILLERS LIC. NO. M D 355 DRILLERS SIGNATURE (MUST MATCH SIGNATURE ON APPLICATION) Max S. Jones LIC. NO. M D 341		SITE SUPERVISOR (sign. of driller or journeyman responsible for sitework if different from permittee)		COUNTY	

Well Permit No. HO - 94 2227
Location of property (road) Rover Mill Road
Subdivision Roman Ridge Lot 6 Block _____ Plat _____ Sec. _____
Well Driller Michael Barlow Owner 100% Land

Depth of well 225
Distance of measuring point (M.P.) above ground
Static water level (S.W.L.) below M.P. 57

Time pump started 10:15 Pumping rate 12
Total time _____ to reach pumping water level _____ ft. below M.P.

[illegible]

HOWARD COUNTY HEALTH DEPARTMENT
Bureau of Environmental Health
3520-H Ellicott Mills Drive
Ellicott City, MD 21043
461-9933

APPLICATION FOR PITLESS ADAPTER WELL PUMP AND PRESSURE TANK INSTALLATION

New Installation ☒
Replacement ☐

Receipt # _____

Date _____

Name of Installer Ar. Howard Plumbing, Inc.

Telephone 301-771-7745

License Number 18121

Certified Well Pump Installer ☐ Well Driller ☐ Registered Plumber ☒

Name of Property Owner Alan H. Haverly, Babek

Telephone 410-990-1191

Subdivision Neenan Ridge Estate Lot # 6 Well Tag # 410-990-2000

Site Address 1740 Rockwell Rd

Pump

- Type
 - Deep well jet _____
 - Shallow well jet _____
 - Submersible ☒
- Make Goulds
- Model # 10A5-6-10A
- Capacity 10 GPM
- Pump exceeds well capacity Yes _____ No _____
- If Yes, is low pressure cutoff switch installed? Yes _____ No _____
- What methods are used to protect the pump and electrical wiring from vibrations? Torque arrestors ☒ Cable guards ☒ Other _____

Motor

- Horsepower 1
- PHM 175
- Voltage
 - 110 _____
 - 230 ☒

Pitless Adapter

- Make _____
- Model # 10A5-6-10A
- Depth 10

Tank

- Capacity 40
- Pressure relief valve? Yes

Piping

- Type P.E.
- Size 1 1/2"
- NSF and/or SOCA _____
- Approved ☒
- Depth of supply line 4'

Well data

- Depth 20 ft.
- Yield _____ GPM
- Static water level _____ ft.
- Will water supply be disinfected by installer? Yes

well line, P.A. 3.5' belgrade
well casing 2' above grade
PVC conduit OL
2pc cap OL. (DS)


I warrant that it is my responsibility to notify the Howard County Health Department when the installation is ready for inspection. Otherwise this permit is null and void.

All information given above is true to the best of my knowledge.

Signature of Applicant Alan H. Haverly

Date 1-16-88

Note: A sticker indicating approval/status of the installation will be placed on the well casing at the time of the inspection.

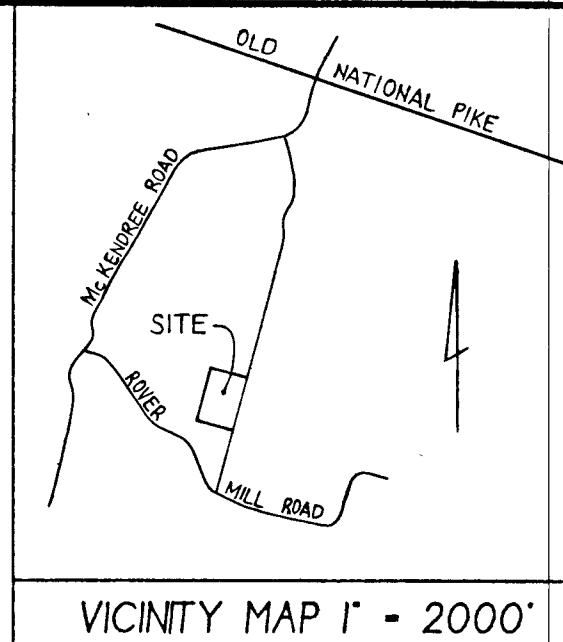

ROVER MILL ROAD

N 65°15'00" W 10.00'

N 25°12'00" E 629.47'

N 64°48'00" W 360.00'

N 25°12'00" E 572.00'

S 64°48'00" E 370.00'

S 25°12'00" W 1,201.39'

Exist Stone Drive

SEWAGE DISPOSAL EASEMENT (SEPTIC AREA)

PATIO
POOL
SUN ROOM
PROP. HOUSE
DECK
PORCH

LOT - 6
5.003 Ac.±

WOODED

LOT - 7

Ex. Wells

Ex. Well

NORTH

NOTES:

1. The parcel shown hereon complies with the minimum ownership width and lot area as required by the Maryland State Department of the Environment.
2. this area designates a private sewerage easement of +10,000 square feet as required by the Maryland State Department of the Environment for individual sewerage disposal. Improvements of any nature in this area are restricted until public sewer is available. This easement shall become null and void upon connection to a public sewerage system. The County Health Officer shall have the authority to grant variances for encroachment into the private sewerage easement. Recordation of a modified sewerage plat shall not be necessary.
3. Unless otherwise shown, no wells or sewerage easements are located within 100 feet of this property.
4. Topography shown hereon is based on assumed datum
5. Percolation test holes shown hereon have been field located and shown as thus

LOT - 6
ROMAN RIDGE ESTATES
PERCOLATION TEST PLAN
DAVID AHLQUIST PROPERTY
NORTH OF ROVER MILL ROAD
3RD ELECT. DIST. HOWARD Co., MD
TAX MAP: 15, PARCEL: 203

NOTE: FOR PERC TEST RESULTS SEE HOWARD COUNTY LETTER
DATED MARCH 3, 1999, FROM AMY McMILLEN,
HOWARD COUNTY, SANITARIAN

APPROVED: For private water and private sewerage systems.
Howard County Health Department.

Howard County Health Officer Date 6/9/99

GEORGE A. STROUD III
PROPERTY LINE SURVEYOR No. 256

A. L. S. Inc.
SURVEYORS & LAND PLANNERS
194 EAST MAIN STREET
WESTMINSTER, MARYLAND 21157
410-857-0822
SCALE: 1" = 50' DATE: JUNE 3, 1999
JOB No. 35-99-22

Approved Septic System Plan
Howard County Health Department

Sam McMill 6/11/99
Signature Date

LOT - 6
5.003 Ac.±

total linear feet of trench required 240 feet

width of trench(es) 3.0 feet

Depth of trench(es) 6.0 feet

Depth of stone required below
distribution pipe 2.0 feet

572.00'

N 25° 12' 00" E

S 64° 48' 00" E

370.00'

1,201.39'

S 25° 12' 00" W

Exist Stone Drive

