

4/15/99
ASAP

PERMIT

SEWAGE DISPOSAL SYSTEM

DEPARTMENT OF HEALTH AND MENTAL HYGIENE

P 513211-B

A REPAIR

DISTRICT

HOWARD COUNTY HEALTH DEPARTMENT

BUREAU OF ENVIRONMENTAL HEALTH

~~XXXXXX~~ 410-313-2640

RPS# 341531

DATE 11/5/2000

DATE SYSTEM APPROVED 4/15/99

INSPECTOR M. R. F. B.

INDEXED

Jack Fyock Septic Service

IS PERMITTED TO INSTALL ALTER X

ADDRESS P.O. Box 89 Triadelphia Road Glenelg, MD 21737 PHONE (410) 988-9270

SUBDIVISION Spring Valley Farms LOT 2 ROAD 6372 Route 32

PROPERTY OWNER Robert Amburn

ADDRESS BUILDING PERMIT SIGNED

SEPTIC TANK CAPACITY EX. 1070 GALLONS

AND RETURNED

11-2603 800145269-DETACHED GARAGE

NUMBER OF BEDROOMS 3

125 SQUARE FEET PER BEDROOM

LINEAR FEET OF TRENCH REQUIRED 65

REPAIR - PURPOSE - Existing septic system has failed.

Call for inspection when ground is opened so sanitarian can recommend repair. 04/15/99

INV 4' BOT 10' 65' TRENCH 6" STONE

PLANS APPROVED BY DATE

COVER NO WORK UNTIL INSPECTED AND APPROVED

NEITHER THE HOWARD COUNTY COUNCIL NOR THE HEALTH DEPARTMENT IS RESPONSIBLE FOR THE SUCCESSFUL OPERATION OF ANY SYSTEM

NOTE: CLEANOUT REQUIRED EVERY 70 FEET OF SEWER LINE AND/OR AT 90° SWEEPS IN LINES FROM HOUSE TO DRAIN FIELDS. 90° ELBOWS NOT ACCEPTABLE.

NOTE: ALL PARTS OF SEPTIC SYSTEMS (I.E. TANK, DISTRIBUTION BOX TRENCHES) TO BE 100 FEET FROM WELL (UNLESS OTHERWISE SPECIFICALLY AUTHORIZED)

NOTE: IF DEEP TRENCH(ES) ARE USED CALL FOR INSPECTION BEFORE AND AFTER PLACING GRAVEL IN TRENCH(ES)

NOTE: NO DRY WELL SHALL EXCEED 15 FOOT IN DIAMETER NO ABSORPTION TRENCH TO EXCEED 100 FEET IN LENGTH

NOTE: ALL PIPE FROM HOUSE TO SEPTIC TANK MUST BE CAST IRON OR SCHEDULE 35/40 PVC OR ABS

PERMIT VOID AFTER TWO YEARS

NOTE: INSTALL STAND PIPE ON SEPTIC TANK AND DRY WELL STAND PIPES MUST BE 6 INCHES IN DIAMETER CAST IRON. CONCRETE OR TERRA COTTA OR PVA OR ABS ACCEPTED. IF TOP OF SEPTIC TANK IS DEEPER THAN 3 FEET, MANHOLE TO GRADE REQUIRED.


NOTE: DISTRIBUTION BOXES MUST HAVE BAFFLES

*INSTALLER IS RESPONSIBLE FOR OBTAINING FINAL APPROVAL ON THIS PERMIT

HD-260(5-90)

*CALL 461-9933 FOR INSPECTION OF SEPTIC SYSTEM.

P 513211-B

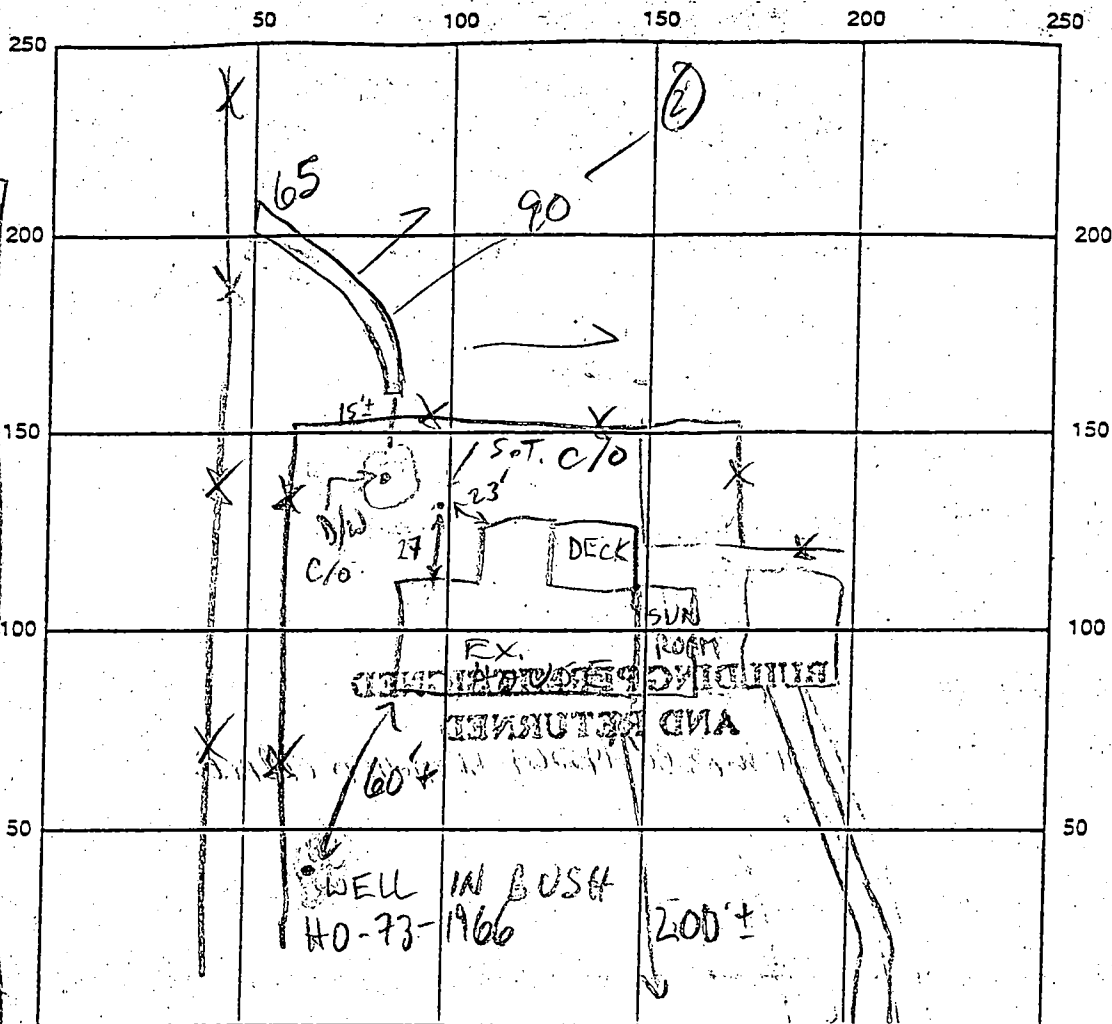

GUILFORD RD

SEPTIC TANK LEVEL EX. 1000 GAL

CLEANOUTS EX. @ S.T. & D/W

DISTRIBUTION BOX LEVEL

DRAIN FIELD/TITLE DEPTH 10 FT.

TRENCH WIDTH 2 FT.

INLET DEPTH 4 FT.

EFFECTIVE GRAVEL DEPTH 6 FT.

TOTAL LENGTH 65 FT.

NUMBER OF TRENCHES 1

ONE SIDEWALL/BOTTOM AREA 390 SQ. FT.

DRYWALL INSIDE DIAMETER FT.

EFFECTIVE DEPTH BELOW INLET FT.

ABSORBENT AREA 390 + EX. D/W SQ. FT.

REMARKS: 4/15/99 #1 OK TO START (MR)

4/15/99 #2 OK TO FINISH & COVER (MR)

DATE SYSTEM APPROVED 4/15/99

INSPECTOR M. Ripkin

6/20/77 Rain
6/21/77 ypd F.S.

PERMIT

SEWAGE DISPOSAL SYSTEM

P 26190

19901

MARYLAND STATE DEPARTMENT OF HEALTH

HOWARD COUNTY

ELLCOTT CITY

DISTRICT 12A

INDEXED

DATE 5/16/77

Jack Fyock, Jr.

IS PERMITTED TO INSTALL ☒ ALTER ☐

ADDRESS 13775 Triadelphia Rd.

PHONE 842-2270

A SEWAGE DISPOSAL SYSTEM LOCATED AT

SUBDIVISION (Spring Valley Farms)

6872 ROAD Route 32

out of Charlotte LOT 2

PROPERTY OWNER R. Auburn - (Contract Purchaser)

ADDRESS

SPECIFICATIONS 3 bedrooms

NOTICE: THIS PERMIT IS VOID
IF THE SEWAGE DISPOSAL SYSTEM
IS NOT INSTALLED WITHIN
60 DAYS OF THE DATE OF
ISSUANCE OF THIS PERMIT.
Serial # 62858

DRAIN FIELD DEPTH FEET. BOTTOM AREA SQ. FT.

SEEPAGE PITS ABSORBENT SIDEWALL AREA SQ. FT.

SEPTIC TANK CAPACITY 1000 GALLONS

FOR GARBAGE GRINDER, INCREASE DISPOSAL AREA 25% & TANK CAPACITY 50%.
OTHER DRY WELL to have 125 Sq. feet of effective absorbent sidewall area per
50000 below inlet. Inlet to be 4 feet below original ground surface
11 feet. Location 30 feet off left property line and 250 feet from road when
facing lot from Route 32.

NOTE: ALL PIPE FROM HOUSE TO DISPOSAL AREA MUST BE CAST IRON. PIPING MUST BE
THREE YEARS.

NOTE: INSTALL STAND PIPE ON SEPTIC TANK AND DRY WELL. STAND PIPES MUST BE 6 INCHES
IN DIAMETER. CAST IRON, CONCRETE OR TERRA COTTA ACCEPTED.

PLANS APPROVED BY C. Stresker


DATE 5/29/76

FILL SEPTIC TANK AND DISTRIBUTION BOX WITH WATER BEFORE CALLING FOR AN INSPECTION. COVER NG WORK
UNTIL INSPECTED AND APPROVED.

NEITHER THE HOWARD COUNTY COMMISSIONERS NOR THE HEALTH DEPARTMENT IS RESPONSIBLE FOR THE
SUCCESSFUL OPERATION OF ANY SYSTEM.

BIDD. PERMIT SIGNED
AND RETURNED 5/2/92
Serial # 41419- paid

19901

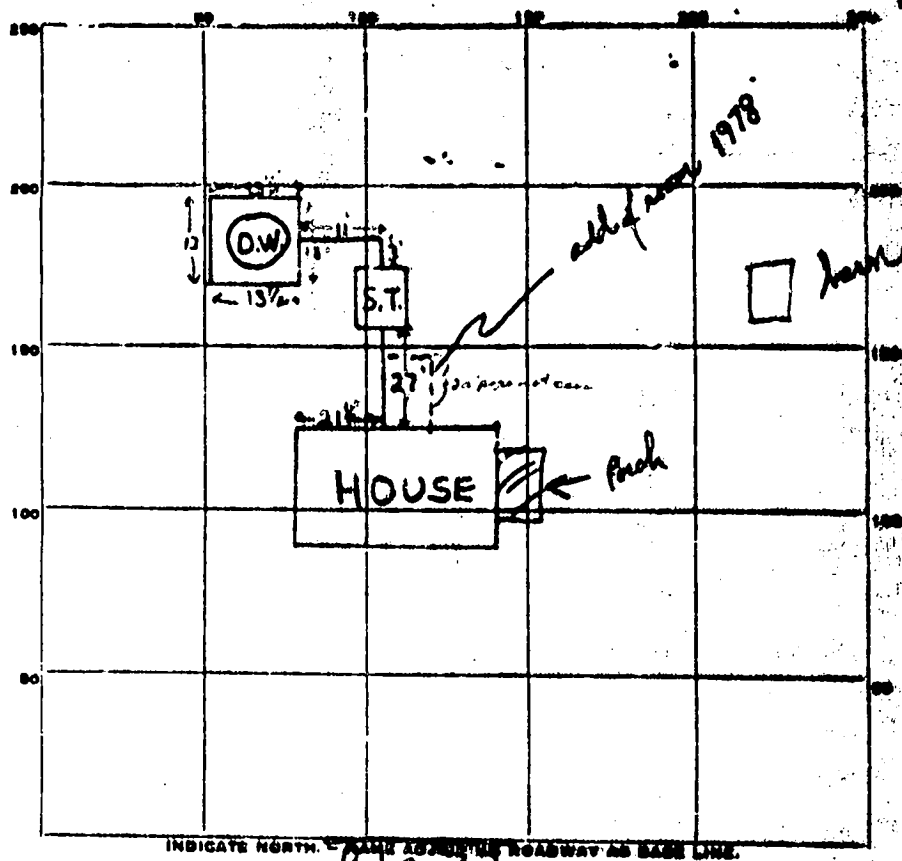

INDICATE NORTH. ROAD ADJACENT TO ROADWAY AS BASE LINE.

Rte. 32

PERMIT CARD signed final correct number 75

S.T. | D.W.

SEPTIC TANK, LEVEL

CLEANOUTS

✓ | ✓

DISTRIBUTION BOX, LEVEL

TILE FIELD, DEPTH FT. TRENCH WIDTH FT.

GRAVEL DEPTH IN. TOTAL LENGTH FT.

NUMBER OF TRENCHES TOTAL BOTTOM AREA

SEEPAGE PITS, INSIDE DIAMETER 53 FT. DEPTH BELOW INLET 7 FT.

ABSORBENT AREA ± 371 SQ. FT.

REMARKS 6/21/77 Owner at site ~20' of pipe between house & septic tank had been covered - R. Amburn verified that cast iron pipe was installed O.K. ES.

DATE SYSTEM APPROVED 6/21/77

INSPECTOR Frank Skinner

PRELIMINARY

APPLICATION

19901
228

SEWAGE DISPOSAL TESTING

STATE OF MARYLAND - DEPARTMENT OF HEALTH AND MENTAL HYGIENE

HOWARD COUNTY HEALTH DEPARTMENT
ENVIRONMENTAL HEALTH SERVICES

P. O. BOX 476, ELLICOTT CITY, MARYLAND 21043
TELEPHONE: 486-8000, EXT. 366

DISTRICT 5th

DATE 5/6/74

TO: THE COUNTY HEALTH OFFICER
ELLICOTT CITY, MARYLAND

I, HEREBY, APPLY FOR THE NECESSARY TEST IN ORDER TO CONSTRUCT (OR RECONSTRUCT) A SEWAGE DISPOSAL SYSTEM.

PROPERTY OWNER Claude D. Kohn property (R. Amburn - Contract Purchaser)

ADDRESS _____

PHONE 285-0545

PROPERTY LOCATION:

SUBDIVISION (Spring Valley Farms)

LOT NO. Parcel 2

ROAD AND DESCRIPTION Route 32

SIZE OF LOT 5.139 acres

TYPE BLDG. 3 of 4 bedrooms

NUMBER OF BEDROOMS

IF NOT SINGLE RESIDENCE DESCRIBE _____

THE SYSTEM INSTALLED UNDER THIS APPLICATION IS ACCEPTABLE ONLY UNTIL PUBLIC FACILITIES BECOME AVAILABLE.

SIGNATURE OF APPLICANT /s/ Patricia A. Svann


APPROVED BY _____ FOR _____ DATE _____

REJECTED BY _____ FOR _____ DATE _____

HOLD PENDING FURTHER TESTS _____ DATE _____

REASONS FOR REJECTION OR HOLDING _____

THIS IS NOT A PERMIT

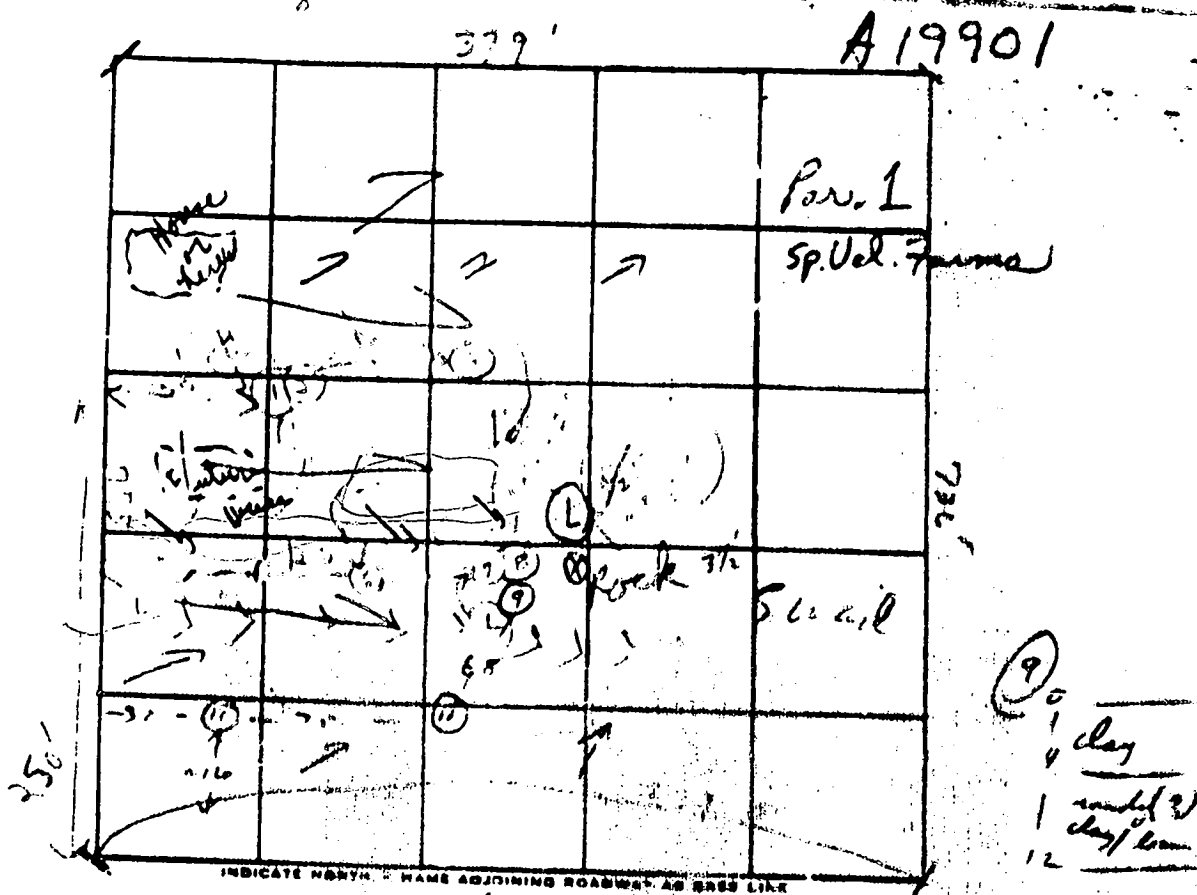

A 132

DATE	TEST NO.	DEPT.	PRE-WET		TEST - 1" DROP		TIME
			START	STOP	START	STOP	
	1	4'	11:04	11:05	11:06	11:07	4 min
	2	4'	11:05	11:06	11:07	11:08	3 min
	3	4'	11:06	11:07	11:08	11:09	3 min
	4	4'	11:07	11:08	11:09	11:10	3 min
	5	4'	11:08	11:09	11:10	11:11	3 min
	6	4'	11:09	11:10	11:11	11:12	3 min
	7	4'	11:10	11:11	11:12	11:13	3 min
	8	4'	11:11	11:12	11:13	11:14	3 min
	9	4'	11:12	11:13	11:14	11:15	3 min
	10	4'	11:13	11:14	11:15	11:16	3 min
	11	4'	11:14	11:15	11:16	11:17	3 min
	12	4'	11:15	11:16	11:17	11:18	3 min


REMARKS

TYPE OF SOIL

TESTED BY

ALSO PRESENT

Curve data:
 Radius=625', Length=229.12'
 Chord=S27°58'59"E 227.83'

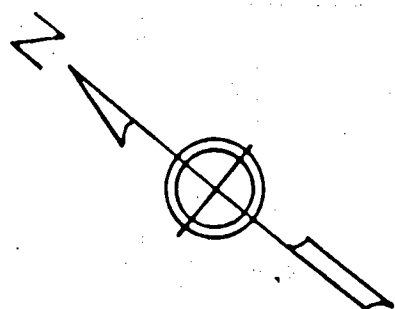

GUILFORD ROAD (MD. RTE. 32) 30' R/W

RECEIVED

NOV 26 2003


HOWARD COUNTY HEALTH DEPT.
 BUREAU OF ENVIRONMENTAL HEALTH

CLAUDE D. KRUMH
 192/90

N62°-42'-47"E 736.83'

LOT 2, BLOCK 18,
 Liber 0684, Folio 654
 5.159 Acres ±


CONSTRUCTION

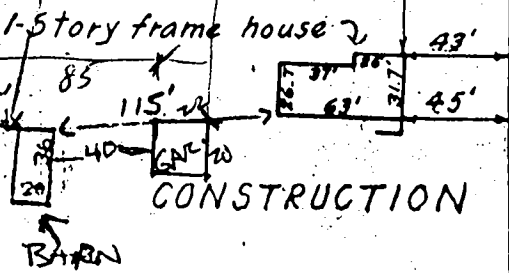

11/26/03
 ROAD OK-6M
 GARAGE

CLAUDE D. KRUMH
 192/90

S51°-30'-47"W 775.75'

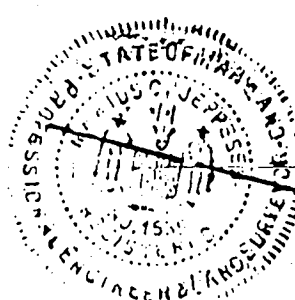

N 24°-03'-18"W

379.09'

LOT 5

LOT 6

ROBERT W. AMBURN, JR.
 6372 GUILFORD ROAD, (MD. RTE. 32)
 LOT 2, BLOCK ■, "SPRING VALLEY FARMS,"
 CLARKSVILLE, FIFTH ELECTION DISTRICT,
 HOWARD COUNTY, MARYLAND.
 SCALE: 1"=100'

This is to certify that I have surveyed the property shown hereon for the purpose of locating improvements and that they are located as shown hereon.
 Townsend & Jeppesen, 904 Park Ave., Laurel, Md., 20810.

MAY 28, 1977.
 DATE

Marius C. Jeppesen
 MARIUS C. JEPPESEN-REG. SURVEYOR, MD. #1535.