

*Scheduled Test for Nov 7, 2000*  
*3/9/00*  
*Open Dry well Hole*  
*Ready any time*  
*3/29/00 AM*  
*Final Co. AM*

RPS# 297632

PERMIT

SEWAGE DISPOSAL SYSTEM

HOWARD COUNTY HEALTH DEPARTMENT

BUREAU OF ENVIRONMENTAL HEALTH

410-313-2640

P 513230

A REPAIR

ISSUE DATE 01-14-2000

APPROVAL DATE 3/29/00

INDEXED

Richard Myrtue IS PERMITTED TO INSTALL ALTER X

ADDRESS 1691 Woodstock Road, Woodstock, MD 21163 PHONE 410-465-6058

SUBDIVISION LOT NUMBER ADDRESS 1691 Woodstock Road

PROPERTY OWNER Stephen Dunn PROPERTY OWNER'S ADDRESS 1691 Woodstock Road

SEPTIC TANK CAPACITY existing 1500 GALLONS

PUMP CHAMBER CAPACITY NA GALLONS

NUMBER OF BEDROOMS 3 + 1 bdrm converted to 1 rec Beauty Salon

SQUARE FEET PER BEDROOM 180 = 360 sqft minimum for Salon

LINEAR FEET OF TRENCH REQUIRED Dry well 15' x 15' wide, 12 ft deep, 6 ft effective depth, OK to use 9" rings + 9 ft of gravel + 3 ft down over lid, OK to use 6" diam. cleanout pipe

TRENCHES: All Trenches to be feet wide. Inlet feet below original grade. Bottom maximum depth feet of stone below distribution box.

LOCATION: Connect DW via same Dist. Box as existing Trenches. Owners - says they'll use concrete blocks - can't get touch to deliver preformed rings

REPAIR - PURPOSE - Commercial building addition for beauty salon.

Call for inspection when ground is opened so sanitarian can recommend repair. 1-14-2000

PLANS APPROVED *[Signature]* DATE 3/29/00

PERMIT VOID AFTER 2 YEARS

NOTE: CONTRACTOR RESPONSIBLE FOR SCHEDULING A PRE-CONSTRUCTION INSPECTION FOR ALL INSTALLATIONS

NOTE: TOP OF SEPTIC TANKS ARE TO BE NO DEEPER THAN 3.0 FEET BELOW FINISH GRADE

NOTE: WATERTIGHT SEPTIC TANKS REQUIRED

NOTE: CLEANOUT REQUIRED EVERY 70 FEET OF SEWER LINE AND/OR AT 90° SWEEPS IN LINES FROM HOUSE TO DRAIN FIELDS, 90° ELBOWS ARE NOT ACCEPTABLE

NOTE: ALL PARTS OF SEPTIC SYSTEMS (I.E. TANK, DISTRIBUTION BOX, DRAINFIELDS) TO BE 100 FEET FROM ANY WATER WELL UNLESS OTHERWISE SPECIFICALLY AUTHORIZED

NOTE: NO ABSORPTION TRENCH TO EXCEED 100 FEET IN LENGTH UNLESS SPECIFICALLY AUTHORIZED

NOTE: ALL PIPE FROM HOUSE TO SEPTIC TANK MUST BE CAST IRON OR SCHEDULE 35/40 PVC OR ABS

NOTE: MANHOLE RISERS REQUIRED ON ALL SEPTIC TANKS AND PUMP CHAMBERS

NOTE: DISTRIBUTION BOXES MUST HAVE BAFFLES


NOTE: IF PUMPED SEPTIC SYSTEM REQUIRED, (1) SEPTIC PUMP DETAIL TO BE PROVIDED BY INSTALLER PRIOR TO ISSUANCE OF SEPTIC PERMIT (2) PUMP PERFORMANCE TEST IS NECESSARY PRIOR TO HEALTH DEPARTMENT APPROVAL OF SEPTIC PERMIT

SLUG. PERMITS SIGNED AND RETURNED 3/8/00  
B00121873 Beauty Shop

NEITHER THE HOWARD COUNTY COUNCIL NOR THE HEALTH DEPARTMENT IS RESPONSIBLE FOR THE SUCCESSFUL OPERATION OF ANY SYSTEM  
PERMITTEE RESPONSIBLE FOR OBTAINING FINAL APPROVAL ON THIS PERMIT  
CALL 410-313-2640 FOR INSPECTION OF SEPTIC SYSTEM

4513230

NOT TO SCALE

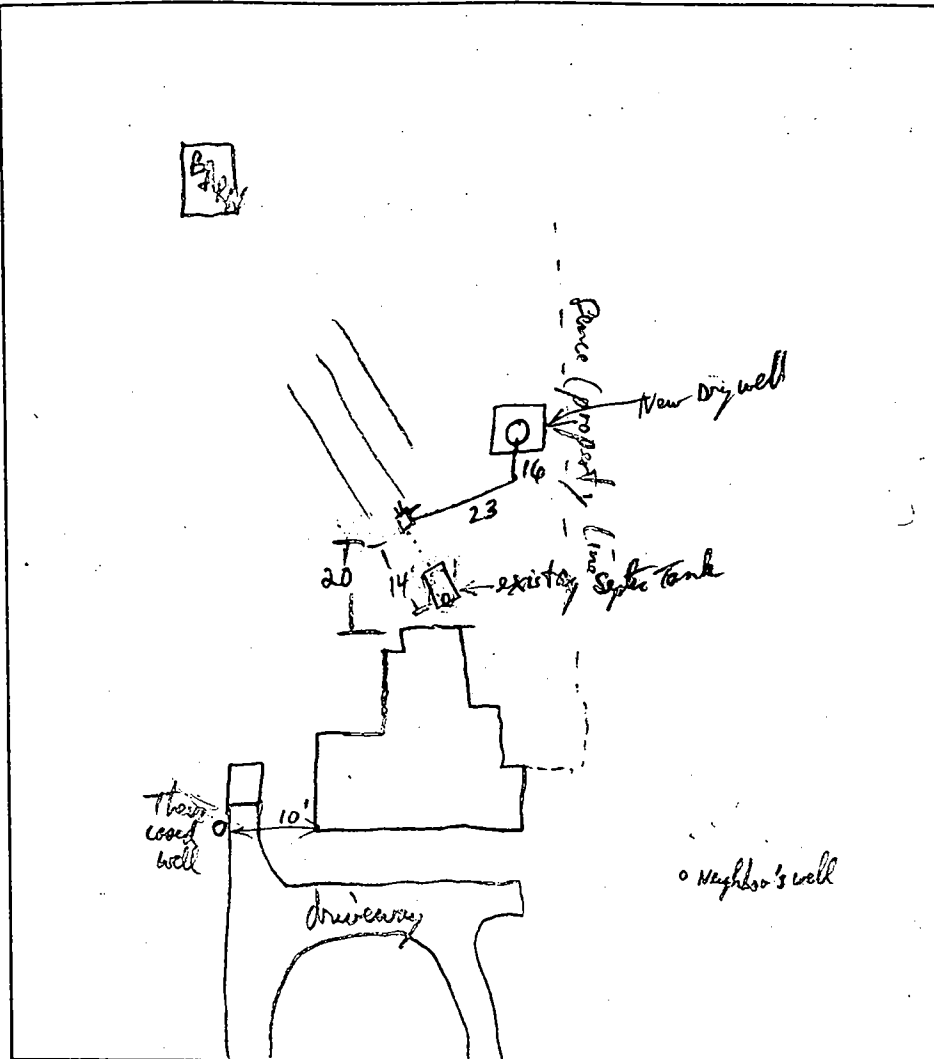

### TRENCH DATA

~~Dry well~~  
TRENCH WIDTH 15' x 15'  
~~DL~~  
TRENCH INLET DEPTH 3 @ 10 side  
~~DL~~  
TRENCH BOTTOM DEPTH 12'  
DEPTH OF STONE 9' ±  
NUMBER OF TRENCHES one  
TOTAL TRENCH LENGTH NA  
(Assumes 6' length depth)  
ABSORBENT AREA 360 sq ft  
DISTRIBUTION BOX LEVEL EX-OK  
BAFFLE IN DISTRIBUTION BOX OK

### SEPTIC TANK DATA

SEPTIC TANK existing 1500 GALLONS  
MANHOLE RISER \_\_\_\_\_  
6 INCH INSPECTION PORT terra cotta existing

### PUMP CHAMBER DATA

PUMP CHAMBER  
GALLONS \_\_\_\_\_  
MANHOLE RISER \_\_\_\_\_  
ALARM \_\_\_\_\_  
PUMP PERFORMANCE TEST \_\_\_\_\_

### PRE-CONSTRUCTION INSPECTION:

Open dry well hole is deep enough, good mix soil as per per hole A.

INSPECTION COMMENTS: OK to proceed with laying block, call when dry well hole is to be set,  
OK to gravel fill or building up layers of block. RPT 3/9/00 Using 12" wide concrete block  
"cylinder" ring wall has been built 9 ft deep and #1 clean stone fill placed between block wall and  
sides of 15' x 15' wide excavating pit. Needs to place inlet piping & lid and paper cover before covering.  
Call when ready, RPT/ 3/17/00  
3/29/00 OK TO FINISH & COVER (MR)

INSPECTOR

M. Ritkin

DATE SYSTEM APPROVED

3/29/00

8/24/84  
9:30 A.M.

9/5/84  
P.M.

9/6/84  
E.A.T.G.  
P.M.

# PERMIT

SEWAGE DISPOSAL SYSTEM

MARYLAND STATE DEPARTMENT OF HEALTH

HOWARD COUNTY  
BUREAU OF ENVIRONMENTAL HEALTH  
992-2330

P 34119

A Repair

COMPLETE, NOT APPROVED

9/6/84 RH/CO

ELLICOTT CITY

DISTRICT 3rd

DATE 7/18/84

INDEXED

Richard E. Myrtue

IS PERMITTED TO INSTALL ☐ ALTER ☒

ADDRESS 1795 Woodstock Road, Woodstock, Md. 21163 PHONE 465-8551

SUBDIVISION \_\_\_\_\_ ROAD 1691 Woodstock Road LOT \_\_\_\_\_

PROPERTY OWNER Stephen Dunn W358-4343

ADDRESS 1691 Woodstock Road, Woodstock, Md. 21163 Phone: 465-6058

IF GARBAGE GRINDER IS USED INCREASE SEPTIC TANK CAPACITY BY 50% AND ABSORPTION AREA BY 22%.

GARBAGE GRINDER? YES ☐ NO ☐

SEPTIC TANK CAPACITY \_\_\_\_\_ GALLONS NUMBER OF BEDROOMS \_\_\_\_\_

REPAIR - Call for an appointment when ground is opened up and Sanitarian will recommend the repair system.

GROUND OK. RESERVE REPAIR AREA DOWN IN BACK LOWER PART OF LOT. 1 MORE

INSTALL 1000g TANK. TRENCHES - 150 SQFT/BEDROOM

VISUAL HOLE REQUIRED IN THAT VICINITY.

INLET 3', BOTTOM 8' w/5 FT STONE.

RUN TRENCH ALONG LEVEL GROUND BETWEEN EXISTING DRYWELL AND

THE FIRST PERC HOLE DUG ALONG LEFT LOT LINE. TRENCH TO BE

PARALLEL TO HOUSE AND AT LEAST 40 FROM REAR OF HOUSE. CW

PLANS APPROVED BY Frank A. Skinner

DATE 7/18/84

COVER NO WORK UNTIL INSPECTED AND APPROVED.

NEITHER THE HOWARD COUNTY COUNCIL NOR THE HEALTH DEPARTMENT IS RESPONSIBLE FOR THE SUCCESSFUL OPERATION OF ANY SYSTEM.

NOTE: IF TRENCH IS USED CALL FOR INSPECTION BEFORE AND AFTER PLACING GRAVEL IN TRENCH.

NOTE: NO DRY WELL SHALL EXCEED 15 FOOT IN DIAMETER. NO ABSORPTION TRENCH TO EXCEED 100 FEET IN LENGTH.

NOTE: ALL PIPE FROM HOUSE TO SEPTIC TANK MUST BE CAST IRON OR SCHEDULE 40 PVC OR ABS.

PERMIT VOID AFTER THREE YEARS.

NOTE: INSTALL STAND PIPE ON SEPTIC TANK AND DRY WELL. STAND PIPES MUST BE 6 INCHES IN DIAMETER CAST IRON, CONCRETE OR TERRA COTTA. OR PVC OR ABS ACCEPTED. IF TOP OF SEPTIC TANK IS DEEPER THAN 3 FEET MANHOLE TO GRADE REQUIRED.

\*INSTALLER IS RESPONSIBLE FOR OBTAINING FINAL APROVAL ON THIS PERMIT

\*CALL 992-2330 FOR INSPECTION OF SEPTIC SYSTEMS.

EH - 2-1082

BLUE PERMIT SIGNED AND RETURNED 9-19-84

House addition

by R. Dwyer, R. S. R., G. R.

34119



ST
NO

## CLEANOUTS

X, LEVEL	#1	#2	#3

2 9 8 FT TRENCH  
#1 #2 #3

TOTAL LENGTH 42 / 52 / 29 FT

TOTAL 123

**TOTAL BOTTOM AREA**

INSTALL ABSORBENT AREA \_\_\_\_\_ SQ. FT.

REMARKS: INLET 3' BOTTOM 150 SQ FT BED ROOM S' STONE.

9-5-84 TRENCHES DUG 8-9 FT DEEP. OK TO ADD GRAVEL. (well)

NO RECORD OF FINAL INSPECTION REQUEST AS OF 7/17/95 INDEX AS NOT APPROVED (CW)

INSPECTOR



---

## HOWARD COUNTY HEALTH DEPARTMENT

---

*Diane L. Matuszak, M.D., M.P.H., County Health Officer*

March 8, 2000

Stephen & Julianne Dunn  
1691 Woodstock Road  
Woodstock, Maryland 21163

RE: Percolation test results  
Purpose: Building Addition  
Property ID: 1691 Woodstock Road  
Tax Map 10, Parcel 106

Dear Mr. & Mrs. Dunn:

Percolation testing conducted Tuesday, March 7, 2000 on the above referenced property indicated satisfactory soil conditions..

Copies of the percolation test results are enclosed.

A revised Percolation Certification Plan or Building Permit Plan should be submitted to this office for review and approval to document this additional sewage disposal area. This revised plan should show the following information:

- actual locations of all recently excavated test holes
- all existing buildings and well site on this lot
- locations of existing wells and septs within 100 feet of property boundaries
- streams/swales/springs and any other relevant landscape features
- field-matched contour lines in new septic area(optional)

If you have any questions regarding this matter, you may contact me at the address below or by calling (410) 313-2640.

Very truly yours,

Ronald J. Pinkley, R.S.  
Water and Sewerage Program

Enclosures  
cc:File

B00121873 1691 Woodstock Rd  
① Type a Septic Repair Permit  
for Bldg A ~~House~~ <sup>time</sup> repair  
assumes 200 gpd increase  
size of Septic system. Use 5th language  
(i.e. call when ground is open for Sanitation  
to recommend size of repair)  
Plus several perc tests to be performed  
at same time to allow expansion of  
Existing SDA to handle future repairs  
(estimate 4000 sq ft extra or minimum).  
(over)

# APPLICATION

## PERCOLATION TESTING

A Amia  
P 513230

HOWARD COUNTY HEALTH DEPARTMENT

BUREAU OF ENVIRONMENTAL HEALTH

3525-H ELLICOTT MILLS DRIVE/ELLICOTT CITY, MARYLAND 21043  
TELEPHONE: 313-2640

*for some commercial  
Addition of a 1 chair  
Beauty Salon in back  
of one existing bedroom.*

DISTRICT \_\_\_\_\_

DATE 1/14/2000

*Test Date*

TO: THE COUNTY HEALTH OFFICER  
ELLICOTT CITY, MARYLAND

I HEREBY APPLY FOR THE NECESSARY TEST PRIOR TO APPLICATION FOR PERMIT TO CONSTRUCT (OR RECONSTRUCT) A SEWAGE DISPOSAL SYSTEM.

PROPERTY OWNER Steven Dunn

ADDRESS 1691 Woodstock Road PHONE \_\_\_\_\_

AGENT OR PROSPECTIVE BUYER Richard Myrtue

ADDRESS \_\_\_\_\_ PHONE \_\_\_\_\_

PROPERTY LOCATION:

SUBDIVISION \_\_\_\_\_ LOT NO. \_\_\_\_\_

ROAD AND DESCRIPTION 1691 Woodstock Rd

TAX MAP \_\_\_\_\_ PARCEL # \_\_\_\_\_

SIZE OF LOT \_\_\_\_\_ TYPE BLDG. \_\_\_\_\_  
(SINGLE FAMILY DWELLING OR COMMERCIAL)

THE SYSTEM INSTALLED UNDER THIS APPLICATION IS ACCEPTABLE ONLY UNTIL PUBLIC FACILITIES BECOME AVAILABLE. I FULLY UNDERSTAND THE

FEE CONNECTED WITH THE FILING OF THIS PERC TEST APPLICATION IS NON-REFUNDABLE UNDER ANY CIRCUMSTANCES. I ALSO AGREE TO

COMPLY WITH ALL M.O.S.H.A. REQUIREMENTS IN TESTING THIS LOT. \_\_\_\_\_  
(SIGNATURE OF APPLICANT)

APPROVED BY *R. Myrtue* FOR \_\_\_\_\_ DATE \_\_\_\_\_

DISAPPROVED BY *OK to make BP -* FOR \_\_\_\_\_ DATE \_\_\_\_\_

HOLD PENDING FURTHER TESTS \_\_\_\_\_


REASONS FOR REJECTION OR HOLDING \_\_\_\_\_

PERCOLATION TEST PLAT/PRELIMINARY PLAT - TITLE OR I.D. # \_\_\_\_\_ DATE \_\_\_\_\_

SITE DEVELOPMENT PLAN/FINAL PLAT - TITLE OR I.D. # \_\_\_\_\_ DATE \_\_\_\_\_

# THIS IS NOT A PERMIT

34' D, C, B  
 5' Br.  
 1' Br. h. Br. h. Br.  
 Mit Br.  
 o Greeny (Follicles)  
 streaks  
 Mit. Sandy Br.  
 - Loom

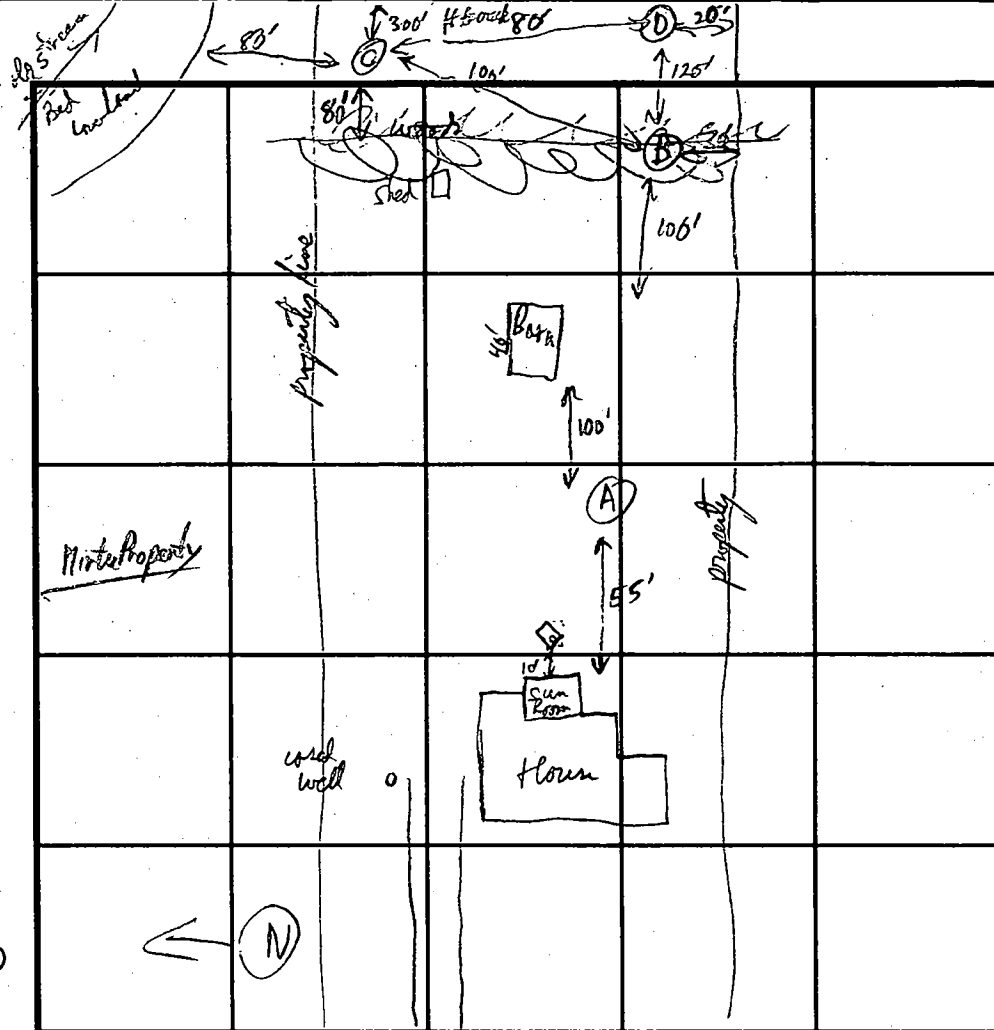

INDICATE NORTH - NAME ADJOINING ROADWAY AS BASE LINE

[illegible]

REMARKS Rock is a bit like heavy granite schist (area tested is >10,000 sq ft extra Septic area)

TYPE OF SOIL Chalky / loam OK for 2 Percolation sets if want - OK to place

TESTED BY R.P. [Signature] Repair Dry cell in area of Test Hole to measure time

TRENCH DESIGN DATA: AVERAGE PERCOLATION TIME 3 min TRENCH WIDTH 2


INLET DEPTH 3-3 1/2 MAXIMUM BOTTOM DEPTH 7 1/2 SQ. FT./BEDROOM 180

ALSO PRESENT In MIRA & over

\* Regia Area behind Barr



**Site Plan 1" = 50'**  
**1691 Woodstock Rd., Woodstock, MD**

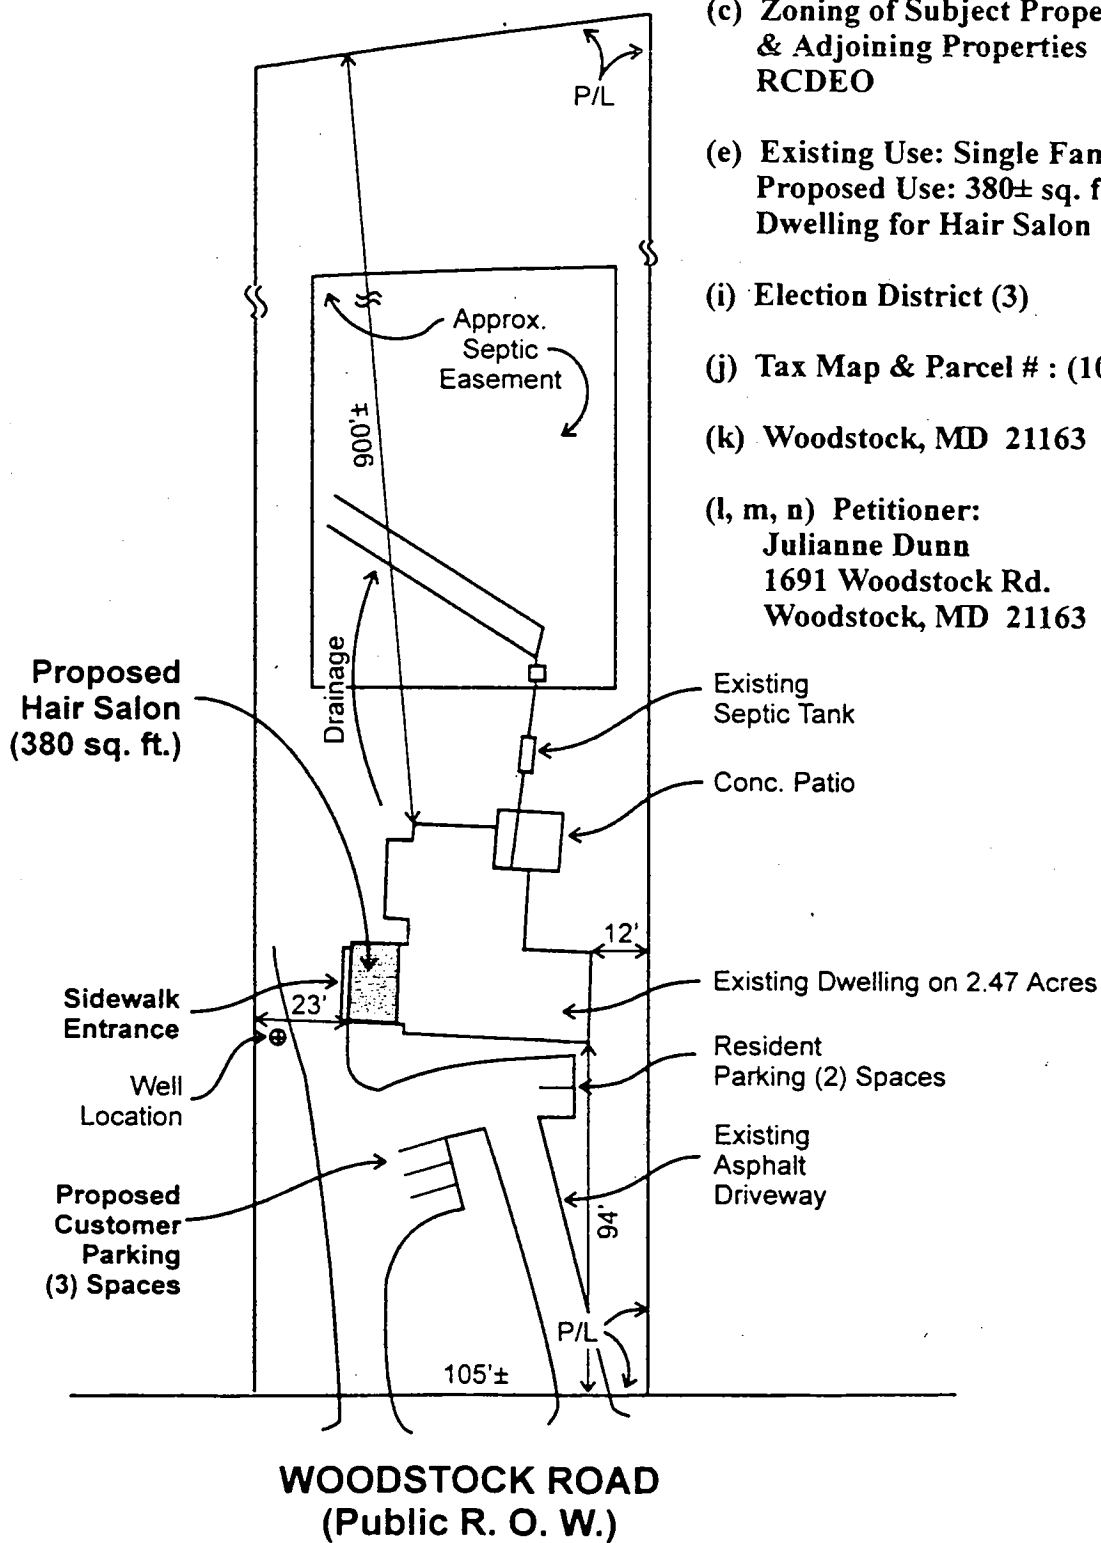

(c) Zoning of Subject Property  
 & Adjoining Properties  
 RCDEO


(e) Existing Use: Single Family  
 Proposed Use: 380± sq. ft. of  
 Dwelling for Hair Salon

(i) Election District (3)

(j) Tax Map & Parcel # : (10), (106)

(k) Woodstock, MD 21163

(l, m, n) Petitioner:  
 Julianne Dunn  
 1691 Woodstock Rd.  
 Woodstock, MD 21163

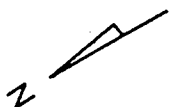

**CRAIG L STEWART**  
**ARCHITECT P.A.**

6399 MAIN STREET SECOND FLOOR  
 BLUCOTT CITY, MARYLAND 21043 (301) 444-3444



1-12-2000

From : Stephen E. Dunn  
1691 Woodstock Road  
Woodstock, MD. 21163

To : Howard County Bureau of Environmental Health  
Ronald J. Pinkley

Re: Letter of Intent concerning Board of Appeals  
Case # 99-47E&V

Dear Mr. Pinkley,

A Decision an Order was granted for a 1 Chair beauty parlor to operate no more than 30 hr. per week. We have turned an existing bedroom / bathroom area into the beauty parlor. In order to accommodate the possibility of increased sewage, we intend to increase the size of our septic system according to the specifications of your agency. We have 3 children and this was the only way we could see that their mother was home before and after school. It was very difficult with both of us working out of the home to arrange for daycare and to be there for the kids. Our intent is to schedule an existing client base during the hours the children are in school.

We have no intent of expanding the salon for a number of reasons.


1) We physically don't have any more room, we are using and are limited to only 380 sq. ft.

2) We are spending more and more time seeing that the needs of our children are met. We expect with more sports and school activities that the hours available to work the beauty shop will actually decline over time.

3) This project was conceived as a part time solution to a daycare problem. My wife does not intend, nor is interested in working any more hours than are necessary.

Even though we are undertaking a commercial venture in the county's eyes. Some consideration should be given to the scope and goal of this project. This is our home and we are not interested in creating problems with sewage etc. We have the tank pumped every year and intend to keep doing so. We are trying to make this idea work without an enormous capital outlay. Your help and consideration would be appreciated.

Sincerely,

  
Stephen Dunn