

PERMIT

SEWAGE DISPOSAL SYSTEM

DEPARTMENT OF HEALTH AND MENTAL HYGIENE

HOWARD COUNTY HEALTH DEPARTMENT

BUREAU OF ENVIRONMENTAL HEALTH

~~XXXXXX~~ 410-313-2640

INDEXED

05-414725

P 513583

A 43083

DISTRICT _____

DATE 5/8/00

DATE SYSTEM APPROVED 5/10/00

INSPECTOR TKS

C & C Utility Service

IS PERMITTED TO INSTALL ☒ ALTER _____

ADDRESS 7398 Gaither Road Sykesville, MD 21784 PHONE (410) 549-4987

SUBDIVISION Brierly LOT 12 ROAD 13856 Russell Zepp Drive

PROPERTY OWNER Audrey Benford

ADDRESS _____

SEPTIC TANK CAPACITY 1250 GALLONS

NUMBER OF BEDROOMS 4

3-19-03 800140754-SUN ROOM

2400 SQUARE FEET PER BEDROOM

LINEAR FEET OF TRENCH REQUIRED 320

TRENCHES - Trench to be 2 feet wide. Inlet 3½ feet below original grade. Bottom maximum depth 6½ feet below original grade. Effective area begins at 3½ feet below original grade. 3 feet of stone below distribution pipe.

LOCATION - Place distribution box 125 feet down the 297.00' lot line and 50 feet off the same lot line when facing the lot from Russell Zepp Drive. Run trenches along contour from both sides of the box.

NOTES - No trench to exceed 100 feet in length. Provide 6" - 8" diameter cleanout and cap to grade or above on septic tank.

CONFIRMATION TEST HOLES REQUIRED AT TIME OF INITIAL EXCAVATION.

5/10/00 confirmation per hole OK (TKS)

PLANS APPROVED BY Donna K. Soe/Amy McMillen DATE 12/27/99

COVER NO WORK UNTIL INSPECTED AND APPROVED

NEITHER THE HOWARD COUNTY COUNCIL NOR THE HEALTH DEPARTMENT IS RESPONSIBLE FOR THE SUCCESSFUL OPERATION OF ANY SYSTEM

NOTE: CLEANOUT REQUIRED EVERY 70 FEET OF SEWER LINE AND/OR AT 90° SWEEPS IN LINES FROM HOUSE TO DRAIN FIELDS. 90° ELBOWS NOT ACCEPTABLE.

NOTE: ALL PARTS OF SEPTIC SYSTEMS (I.E. TANK, DISTRIBUTION BOX TRENCHES) TO BE 100 FEET FROM WELL (UNLESS OTHERWISE SPECIFICALLY AUTHORIZED)

NOTE: IF DEEP TRENCH(ES) ARE USED CALL FOR INSPECTION BEFORE AND AFTER PLACING GRAVEL IN TRENCH(ES)

NOTE: NO DRY WELL SHALL EXCEED 15 FOOT IN DIAMETER NO ABSORPTION TRENCH TO EXCEED 100 FEET IN LENGTH

NOTE: ALL PIPE FROM HOUSE TO SEPTIC TANK MUST BE CAST IRON OR SCHEDULE 35/40 PVC OR ABS


PERMIT VOID AFTER TWO YEARS

NOTE: INSTALL STAND PIPE ON SEPTIC TANK AND DRY WELL STAND PIPES MUST BE 6 INCHES IN DIAMETER CAST IRON, CONCRETE OR TERRA COTTA OR PVA OR ABS ACCEPTED. IF TOP OF SEPTIC TANK IS DEEPER THAN 3 FEET, MANHOLE TO GRADE REQUIRED.

NOTE: DISTRIBUTION BOXES MUST HAVE BAFFLES

*INSTALLER IS RESPONSIBLE FOR OBTAINING FINAL APPROVAL ON THIS PERMIT

P513583

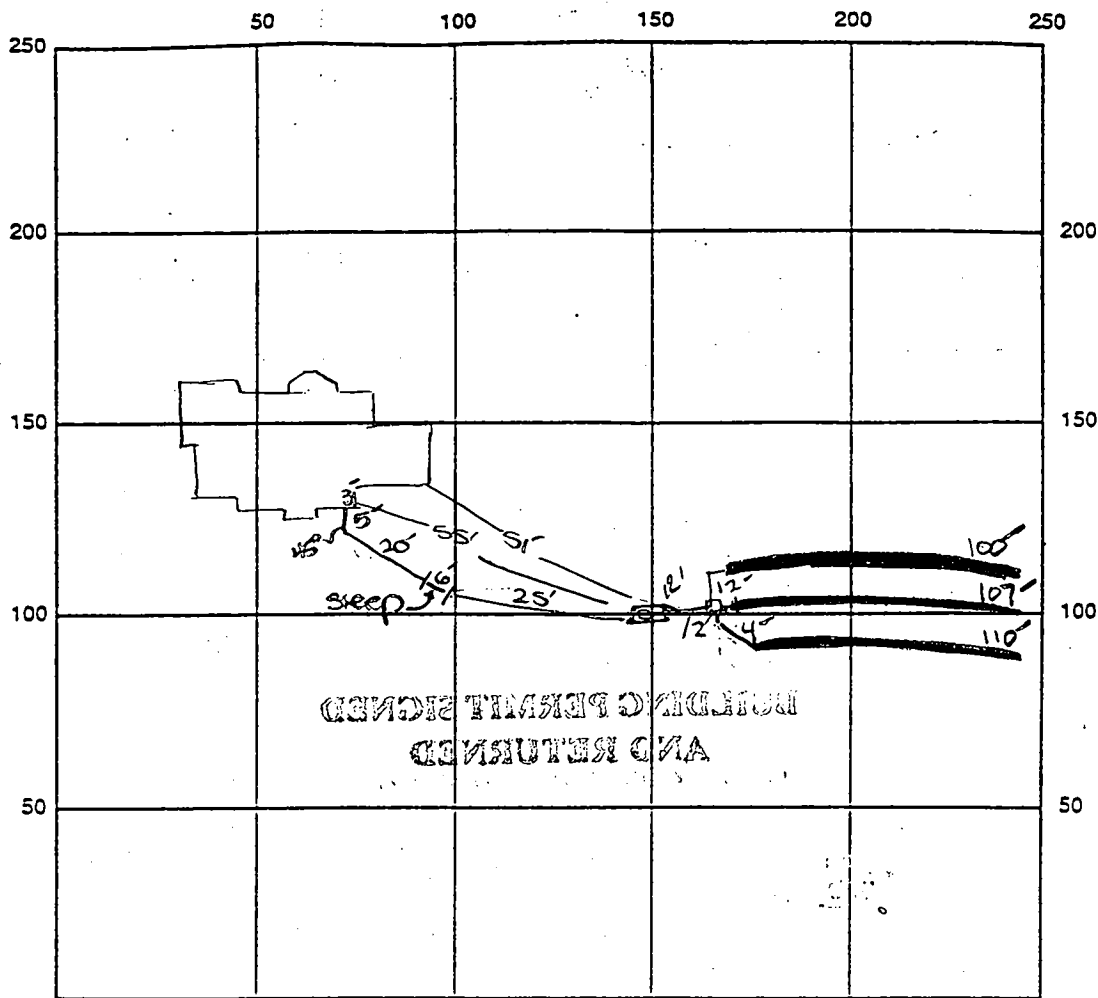

INDICATE NORTH - NAME ADJOINING ROADWAY AS BASE LINE

SEPTIC TANK LEVEL OK - 1250 gal CLEANOUTS one on st.

DISTRIBUTION BOX LEVEL OK

DRAIN FIELD/TITLE DEPTH 6.5 FT. TRENCH WIDTH 2 FT. INLET DEPTH 3.5 FT.

EFFECTIVE GRAVEL DEPTH 3 FT. TOTAL LENGTH 317 FT.

NUMBER OF TRENCHES 3 ONE SIDEWALL BOTTOM AREA 951 SQ. FT.

DRYWALL INSIDE DIAMETER — FT. EFFECTIVE DEPTH BELOW INLET — FT.

ABSORBENT AREA — SQ. FT.

REMARKS: 5/10/00 FINAL INSP - OK to cover all septic work. DJS

5/11/00 WPI - OK to cover. DJS

DATE SYSTEM APPROVED 5/10/00 INSPECTOR DJS

APPLICATION

PERCOLATION TESTING

HOWARD COUNTY HEALTH DEPARTMENT
BUREAU OF ENVIRONMENTAL HEALTH
P.O. BOX 476 ELLICOTT CITY, MARYLAND 21043
TELEPHONE 461-9933

A 43083

P _____

DISTRICT 574

DATE 9-20-88

TO: THE COUNTY HEALTH OFFICER
ELLICOTT CITY, MARYLAND

I, HEREBY, APPLY FOR THE NECESSARY TEST IN ORDER TO CONSTRUCT (OR RECONSTRUCT) A SEWAGE DISPOSAL SYSTEM.

PROPERTY OWNER RUSSELL ZEPP

ADDRESS 13790 HIGHLAND RD. PHONE 854-2797

PROSPECTIVE BUYER HENRY L. BIEVINS

ADDRESS 3600 WATERSVILLE RD PHONE 795-2337
MT. AIRY, MD 21771

PROPERTY LOCATION:
SUBDIVISION ZEPP SUBDIVISION LOT NO. 12

ROAD AND DESCRIPTION HIGHLAND ROAD HOWARD CO
ZIP: 21029

TAX MAP 34 PARCEL # 7

SIZE OF LOT 3.00 AC ± TYPE BLDG SINGLE FAMILY
(SINGLE FAMILY DWELLING OR COMMERCIAL)

THE SYSTEM INSTALLED UNDER THIS APPLICATION IS ACCEPTABLE ONLY UNTIL PUBLIC FACILITIES BECOME AVAILABLE. I FULLY UNDERSTAND THE
FEE CONNECTED WITH THE FILING OF THIS PERC TEST APPLICATION IS NON-REFUNDABLE UNDER ANY CIRCUMSTANCES. I ALSO AGREE TO COMPLY

WITH ALL M.O.S.H.A. REQUIREMENTS IN TESTING THIS LOT. [Signature]
(SIGNATURE OF APPLICANT)

APPROVED BY _____ FOR _____ DATE _____

REJECTED BY _____ FOR _____ DATE _____

HOLD PENDING FURTHER TESTS _____ DATE _____

REASONS FOR REJECTION OR HOLDING perc UNSAT, HOLD PENDING FURTHER TESTS


THIS IS NOT A PERMIT

Lot 12
A43083

⑦

SOIL PROFILE

6" topsoil
yellow
purple
pink &
orange
clay loam
Some mica
7 1/2" highly
micaceous
pink
silty
loam
10" 5% frags

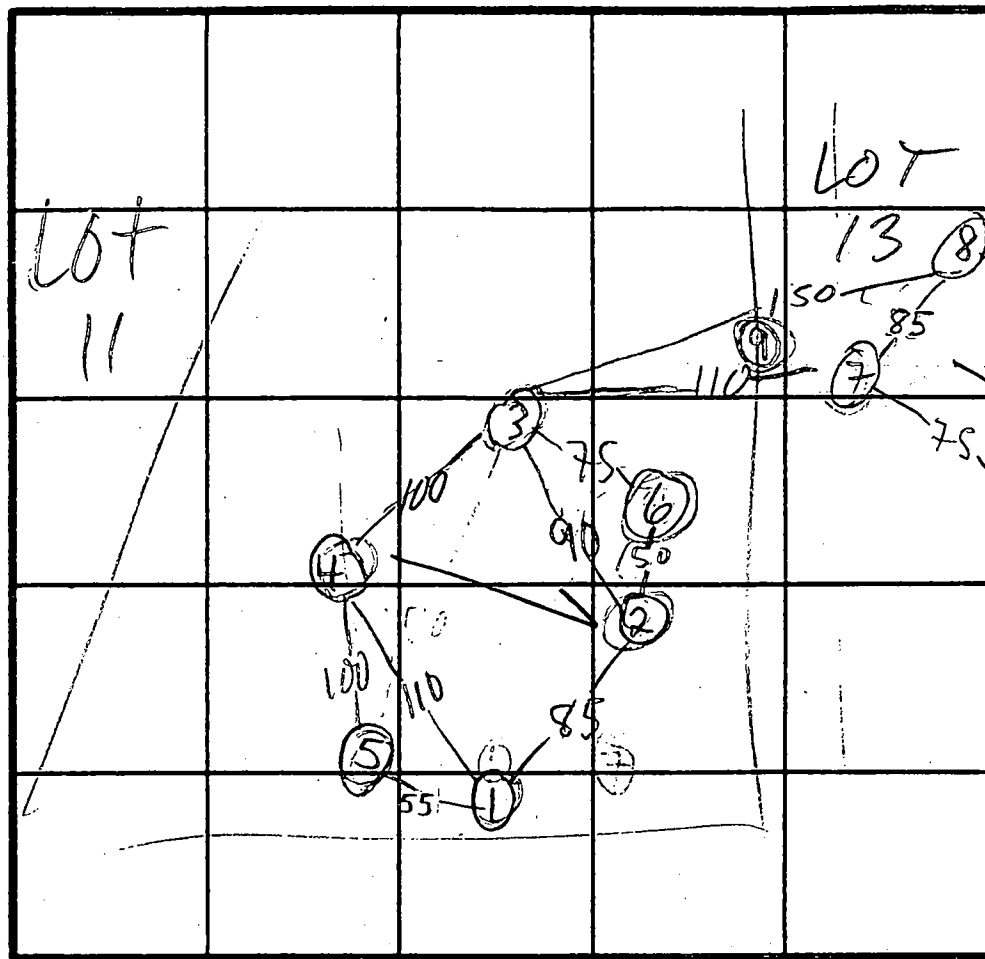

INDICATE NORTH - NAME ADJOINING ROADWAY AS BASE LINE.


DATE	TEST NO.	DEPTH	PRE-WET		TEST - 1" DROP		TIME
			START	STOP	START	STOP	
3/3/89	1	9 1/2	org/red clay to bottom		10% frags	very little mica	
	2	9	sim to ①				
	3	11	sim to ④ clay to 6 1/2		10% frags	high mica	
	4	10 1/2	org/red/yellow clay to 6 1/2 org silty loam below			5-10% frags	
	5	9	sim to ①				
	6	9	sim to ③				
	7S	7	2:43	2:53	2:53	3:23	3:27
	7V	10	"	"			
	8S	5 1/2	2:47	2:49	2:49	2:53	4
	8M	7 1/2	2:47	2:49	2:49	2:55	6
	8V	10	sim to ⑦ clay to 5' 10" frags				

REMARKS HOLES ① ② ③ ④ CLAY TO BOTTOM FAIL
DATA FOR ②-④ ON 2 USE ②-④-⑦-⑧
LOT 13 SHEET.
TESTED BY M. Rifkin ALSO PRESENT

LOT 13
A43084

(3)
SOIL PROFILE

6' topsoil
deep red
yellow
silt & clay
100m
dk red &
brn silt
100m
high mica
5% frags

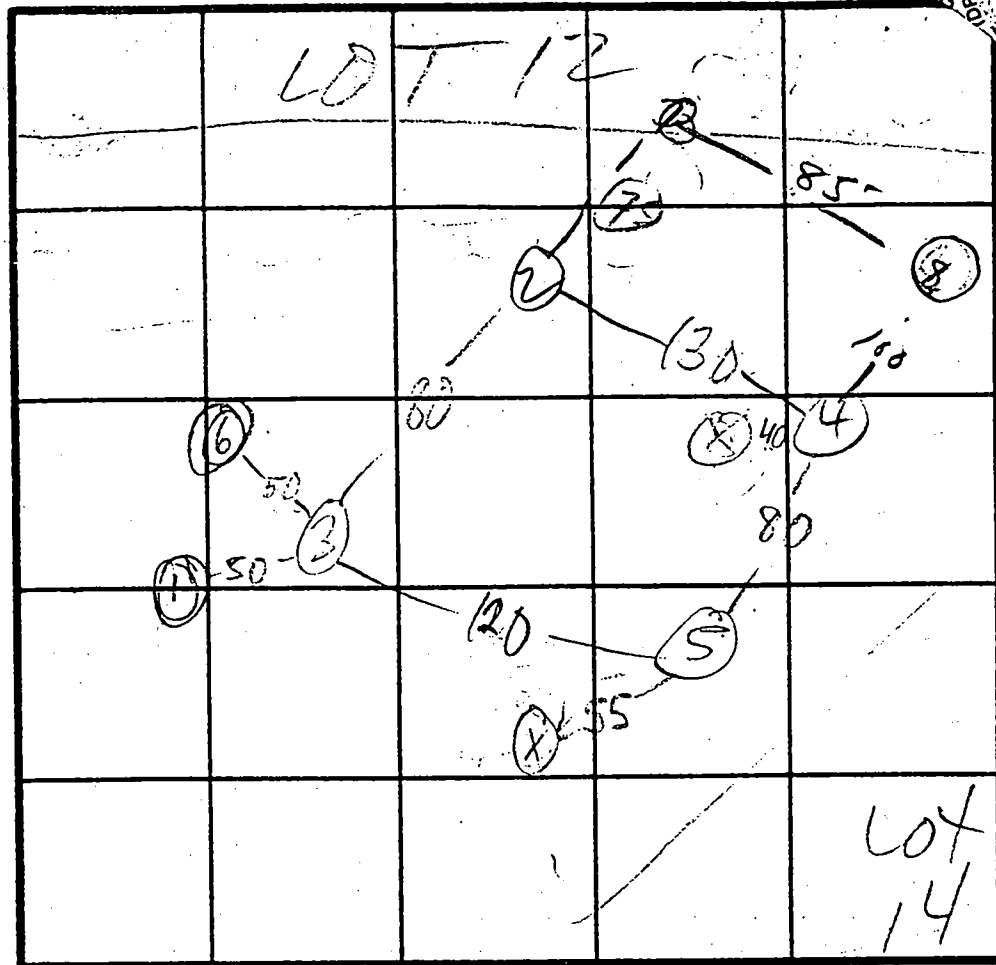

(2) H1
(4) MEAL H1
(3) (5) LO
 $\bar{x} = 4.6$
180 ABR
Inlet 4'
Bottom 6'

INDICATE NORTH - NAME ADJOINING ROADWAY AS BASE LINE.

DATE	TEST NO.	DEPTH	PRE-WET		TEST - 1" DROP		TIME
			START	STOP	START	STOP	
3/3/89	(1) S		CLAY	to bottom			FAIL
"	1 V	8'	clay	to 8'	high mica pos	to 8'	
	2 S	5'	12:30	12:32	12:32	12:36	4
	2 V	10'	12:30	12:32	12:32	12:34	2
	3 S	6'	clay to 4 1/2'	5% frags	dk pink/orange/purple		
	3 V	13'	12:27	12:30	12:30	12:36	6
	4 S	6'	12:41	12:42	12:42	12:45	3
	4 V	11'	clay to 4'	10% frags			
	5 S	7'	12:39	12:41	12:41	12:45	4
	5 V	13 1/2'	clay to 5 1/2'	15% frags			
	(6)	8'	clay to bottom				FAIL

REMARKS: HOLES (1) & (2) S STARTED; DATA FOR (7) (4) (8) ON SHEET FOR LOT 12

TYPE OF SOIL

TESTED BY

M. Rittin

ALSO PRESENT

107517

SEQUENCE NO.
(MDE USE ONLY)

STATE OF MARYLAND
WELL COMPLETION REPORT
FILL IN THIS FORM COMPLETELY
PLEASE TYPE

THIS REPORT MUST BE SUBMITTED AFTER
WELL IS COMPLETED.

COUNTY
NUMBER

A43083

ST/CO USE ONLY
DATE Received
MM DD YY

DATE WELL COMPLETED

Depth of Well

PERMIT NO.
FROM "PERMIT TO DRILL WELL"

11 23 99

22 145 26

10-94-2485

8 13 15 20 28 29 30 31 32 33 34 35 36 37

OWNER Bonford

STREET OR RFD Russell Lepp Drive

SUBDIVISION Brierly

TOWN Highland

SECTION 12

LOT 12

WELL LOG

Not required for driven wells

STATE THE KIND OF FORMATIONS PENETRATED, THEIR COLOR, DEPTH, THICKNESS AND IF WATER BEARING

DESCRIPTION (Use additional sheets if needed)

FEET

FROM

TO

check if water bearing

Top Soil

0

2

Sandy

2

60

Sand Stone

60

75

Micka

75

90

Sand Stone

90

100

Micka

100

145

100 ft Dry Hole Filled with #2 Cement

GROUTING RECORD

yes no

WELL HAS BEEN GROUTED (Circle Appropriate Box)

TYPE OF GROUTING MATERIAL (Circle one)

CEMENT CM BENTONITE CLAY BC

NO. OF BAGS 19 NO. OF POUNDS 1900

GALLONS OF WATER 114

DEPTH OF GROUT SEAL (to nearest foot)

from 0 ft. to 40 ft.

48 TOP 52 54 BOTTOM 58

(enter 0 if from surface)

CASING RECORD

casing types insert appropriate code below

STEEL ST CONCRETE CO

PLASTIC PL OTHER OT

MAIN CASING TYPE

Nominal diameter top (main) casing (nearest inch)

Total depth of main casing (nearest foot)

PL 6 75

60 61 63 64 66 70

OTHER CASING (if used)

diameter inch depth (feet) from to

E C H C A S I N G

SCREEN RECORD

screen type or open hole

insert appropriate code below

STEEL ST BRASS BR OPEN HOLE HO

PLASTIC PL OTHER OT

DEPTH (nearest ft.)

HO 75 145

1 2 8 9 11 15 17 21

23 24 26 30 32 36

38 39 41 45 47 51

SLOT SIZE 1 2 3

DIAMETER OF SCREEN (NEAREST INCH)

56 60

from to

GRAVEL PACK IF WELL DRILLED WAS FLOWING WELL INSERT F IN BOX 68

68

PUMPING TEST

HOURS PUMPED (nearest hour)

3

8 9

PUMPING RATE (gal. per min.)

15

METHOD USED TO MEASURE PUMPING RATE

3 inch

WATER LEVEL (distance from land surface)

BEFORE PUMPING

75

17 20

76

22 25

WHEN PUMPING

TYPE OF PUMP USED (for test)

A air P piston T turbine

27 27 27

C centrifugal R rotary O other (describe below)

27 27 27

J jet S submersible

27 27

PUMP INSTALLED

DRILLER INSTALLED PUMP (CIRCLE) (YES or NO)

YES NO

IF DRILLER INSTALLS PUMP, THIS SECTION MUST BE COMPLETED FOR ALL WELLS.

TYPE OF PUMP INSTALLED PLACE (A,C,J,P,R,S,T,O) IN BOX 29

29

CAPACITY: GALLONS PER MINUTE (to nearest gallon)

31 35

PUMP HORSE POWER

37 41

PUMP COLUMN LENGTH (nearest ft.)

43 47

CASING HEIGHT (circle appropriate box and enter casing height)

above below

LAND SURFACE

2 (nearest foot)

50 51

NUMBER OF UNSUCCESSFUL WELLS

I

WELL HYDROFRACTURED

yes no

Y N

CIRCLE APPROPRIATE LETTER

A A WELL WAS ABANDONED AND SEALED WHEN THIS WELL WAS COMPLETED

E ELECTRIC LOG OBTAINED

P TEST WELL CONVERTED TO PRODUCTION WELL

I HEREBY CERTIFY THAT THIS WELL HAS BEEN CONSTRUCTED IN ACCORDANCE WITH COMAR 26.04.04 "WELL CONSTRUCTION" AND IN CONFORMANCE WITH ALL CONDITIONS STATED IN THE ABOVE CAPTIONED PERMIT, AND THAT THE INFORMATION PRESENTED HEREIN IS ACCURATE AND COMPLETE TO THE BEST OF MY KNOWLEDGE.

DRILLERS LIC NO. 1 M S D 116

DRILLERS SIGNATURE

(MUST MATCH SIGNATURE ON APPLICATION)

LIC. NO. 1 M S D 116

SITE SUPERVISOR (sign. of driller or journeyman responsible for sitework if different from permittee)

GRAVEL PACK IF WELL DRILLED WAS FLOWING WELL INSERT F IN BOX 68


68

MDE USE ONLY (NOT TO BE FILLED IN BY DRILLER)

T (E.R.O.S.) W Q

70 72 74 75 76

TELESCOPE CASING LOG INDICATOR OTHER DATA

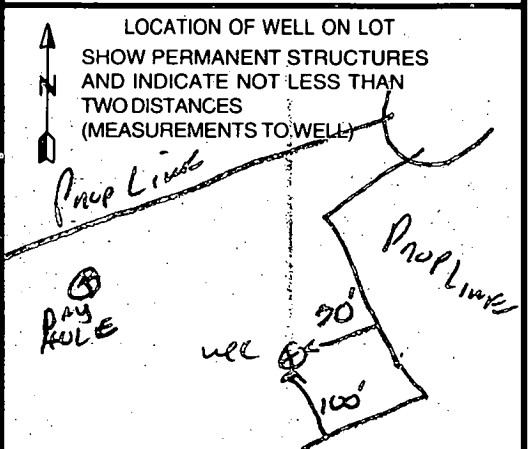

Well Permit No. HO - 94-2485
Location of property (road) Russell Tepp Drive
Subdivision Brierly Lot 12 Block Plat Sec.
Well Driller P. Haynie Owner Bonford

Distance of measuring point (M.P.) above ground 2^m

Static water level (S.W.L.) below M.P. 75


Time pump started 8:45

Pumping rate 15 GPM

Total time 15 min to reach pumping water level 76 ft. below M.P.

[illegible]

75th Casey 40 open 15 bags

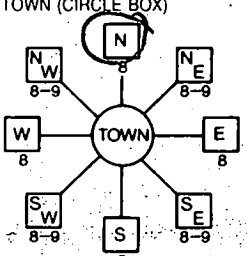
B 1 1 2 3 4 5 6 1978	SEQUENCE NO. (MDE USE ONLY)	STATE OF MARYLAND PERMIT TO DRILL WELL please print or type	STATE PERMIT NUMBER HO 94 - 2485 fill in this form completely
Date Received (APA) 11/4/99 8 MM DD YY 13		B 3 Howard LOCATION OF WELL 8 COUNTY 21 BRIERLY 23 SUBDIVISION 42 SECTION - LOT 12 44 46 48 50 HIGHLAND 52 NEAREST TOWN 71 MILES FROM TOWN (enter 0 if in town) 3 73 76 77 78	
OWNER INFORMATION BENFORD Audrey 15 Last Name Owner First Name 34 3161 Emerald VALLEY DR. 36 Street or RFD 55 ELLICOTT City MD. 21042 57 Town 70 State 72 Zip 76		DRILLER INFORMATION Ralph MAYNE M SD 16 Driller's Name 76 License No. 81 Ralph MAYNE well drilling Firm Name 9120 Brown Church Rd Mt Airy Address Ralph Mayne 10-1-99 Signature Date	
B 2 1 2 WELL INFORMATION APPROX. PUMPING RATE 5 (GAL. PER MIN.) 12 AVERAGE DAILY QUANTITY NEEDED 500 (GAL. PER DAY) 14 20		B 4 1 2 DIRECTION OF WELL FROM TOWN (CIRCLE BOX)  ON WHICH SIDE OF ROAD (CIRCLE APPROPRIATE BOX) 11 NEAR WHAT ROAD 300 37 ON WHICH SIDE OF ROAD (CIRCLE APPROPRIATE BOX) 34 300 37 DISTANCE FROM ROAD 34 ENTER FT OR MI. 38 39. TAX MAP: 34 BLK: PARCEL 7	
USE FOR WATER (CIRCLE APPROPRIATE BOX) ☒ DOMESTIC POTABLE SUPPLY & RESIDENTIAL IRRIGATION ☐ FARMING (LIVESTOCK WATERING & AGRICULTURAL IRRIGATION) ☐ INDUSTRIAL, COMMERCIAL, DEWATERING ☐ PUBLIC WATER SUPPLY WELL ☐ TEST, OBSERVATION, MONITORING ☐ GEO-THERMAL		NOT TO BE FILLED IN BY DRILLER - HEALTH DEPARTMENT APPROVAL Howard A 43083 COUNTY-NAME COUNTY NO. STATE SIGNATURE INSERT S → DATE ISSUED 11/8/99 11/7/99 43 MM DD YY 48 CO SIGNATURE EXP. DATE NORTH GRID 500 000 EAST GRID 0801 000 50 55 57 63	
APPROXIMATE DEPTH OF WELL 150 FEET 24 28 APPROXIMATE DIAMETER OF WELL 6" NEAREST INCH		SHOW MAJOR FEATURES OF BOX & LOCATE WELL WITH AN X SOURCES OF DRILLING WATER 1. well 2. 3. WRITE THE BOX NUMBER FROM THE MAP HERE E 800 N 500 000 000	
METHOD OF DRILLING (circle one) BORED (or Augered) JETTED Jetted & DRIVEN 30 AIR-ROTARY AIR-PERCussion ROTARY (Hydraulic Rotary) 37 CABLE REVerse-ROTary DRive-POINT other		REPLACEMENT OR DEEPEINED WELLS (CIRCLE APPROPRIATE-BOX) ☒ THIS WELL WILL NOT REPLACE AN EXISTING WELL ☐ THIS WELL WILL REPLACE A WELL THAT WILL BE ABANDONED AND SEALED 39 ☐ THIS WELL WILL REPLACE A WELL THAT WILL BE USED AS A STANDBY-CONTACT LOCAL APPROVING AUTHORITY FOR POLICY ON STANDBY WELLS ☐ THIS WELL WILL DEEPEIN AN EXISTING WELL PERMIT NUMBER OF WELL TO BE REPLACED OR DEEPEINED (IF AVAILABLE) 41 52	
Not to be filled in by driller (MDE OR COUNTY USE ONLY) APPROP. PERMIT NUMBER 54 G A P 63 PERMIT No. HO-94-2485 70 71 72 73 74 75 76 77 78 79			
SPECIAL CONDITIONS * NOTE - APPROVING AUTHORITIES SHOULD USE SEPARATE SHEET IF NEEDED *			

GENERAL NOTES

1. ELEVATIONS

- A. BASEMENT: 502.0
- B. FIRST FLOOR 510.0
- C. INVERT OUT OF HOUSE: 492.6
- D. INVERT INTO SEPTIC TANK: 491.6
- E. INVERT OUT OF SEPTIC TANK: 491.4
- F. INVERT INTO DISTRIBUTION BOX: 490.0
- G. INVERT INTO TRENCH: 490.0
- H. EXISTING GRADE AT SEPTIC TANK: 497.0
- I. EXISTING GRADE AT DISTRIBUTION BOX: 493.0
- J. EXISTING GRADE AT TRENCH: 492.8
- K. ELEVATION AT WELL AT GRADE: 497.0

2. PROPERTY INFO.: BRIERLY, LOT 12

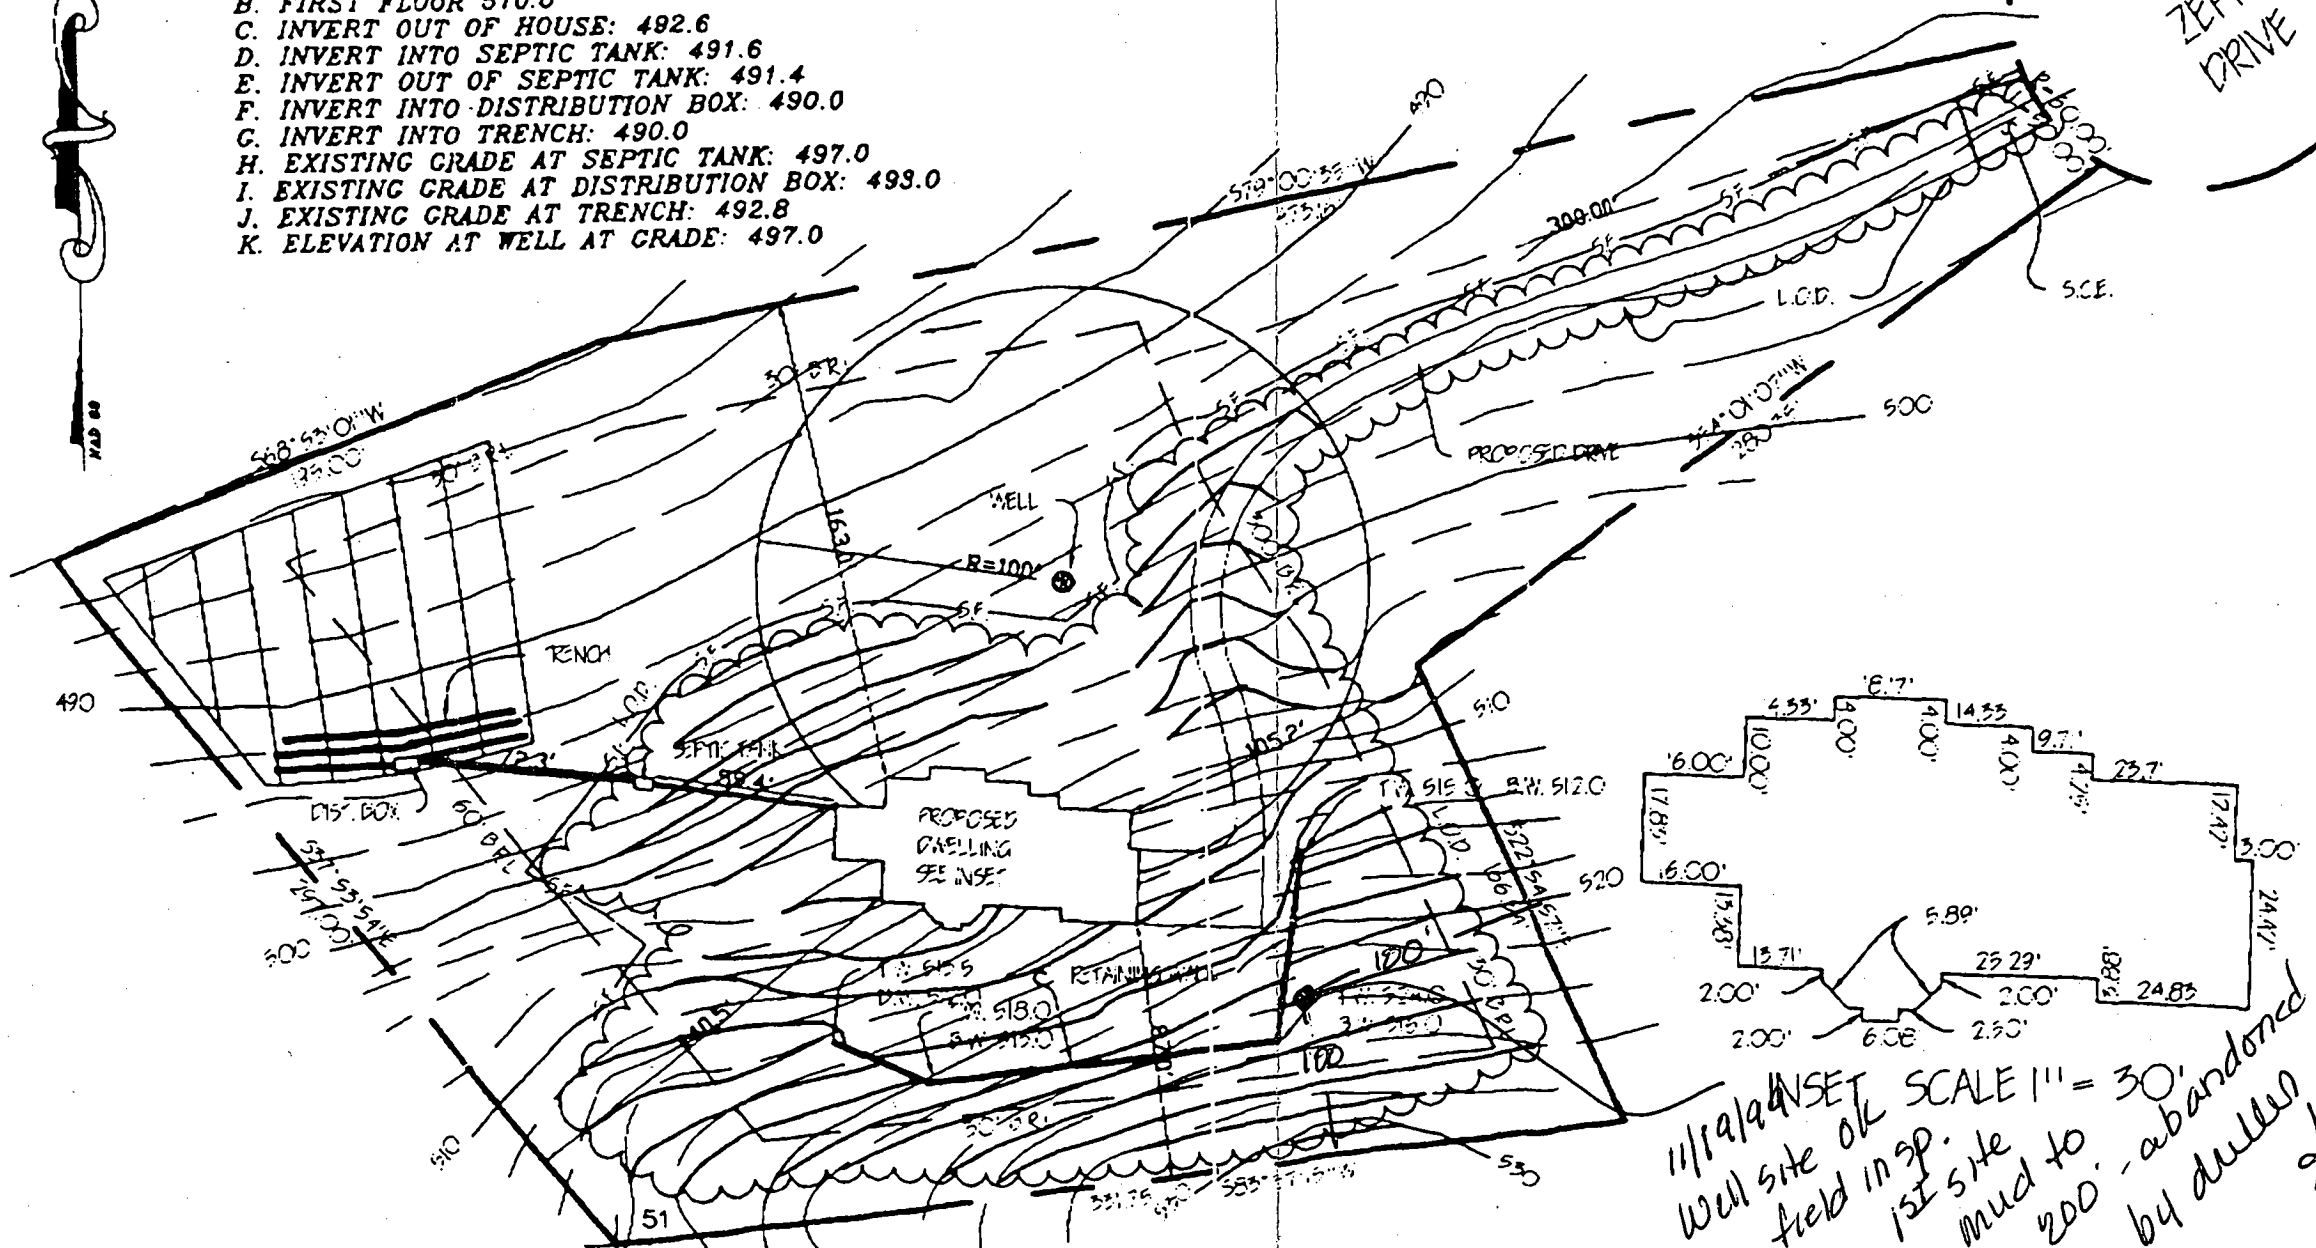

11/8/99

Proposed well site...
OK as shown. (D.S.)

RUSSELL
ZEPP
DRIVE

PLOT PLAN
SINGLE F.

TAX MAP 34

PLAT NO. 100

DATE: 10/19/

SCALE: AS SH.

BUILDER: TRAIL
4540 TEN OAKS
DAYTON, MARYL
(410) 531-920

PREPARED BY:
MARKS & ASSO
4531 COLLEGE
ELLCOTT CITY,
(410) 747-8736

PLAN SCALE; 1"

11/19/99 SET SCALE 1" = 30'
Well site OK
field in sp.
1st site
mud to
200' - abandoned
by diller

HOWARD COUNTY HEALTH DEPARTMENT
Bureau of Environmental Health
3525-H Ellicott Mills Drive
Ellicott City, MD 21043
461-9933

APPLICATION FOR PITLESS ADAPTER, WELL PUMP AND PRESSURE TANK INSTALLATION

New Installation ☒
Replacement ☐

Receipt # _____
Date _____

Name of Installer Gary Eikenberg

Telephone 410-796-8583

License Number 3260

Certified Well Pump Installer _____ Well Driller _____ Registered Plumber ☒

Name of Property Owner Audrey Benford

Telephone _____

Subdivision Brierly Lot # 12

Well Tag # 110-94-2485

Site Address 13856 Russell Zapp Dr
Clarksville Md 21029

Pump

1. Type
 - a. Deep well jet _____
 - b. Shallow well jet _____
 - c. Submersible ☒

Motor

1. Horsepower 3/4
2. RPM 1850
3. Voltage _____
 - a. 110 _____
 - b. 220 ☒

Pitless Adapter

1. Make Harvard
2. Model # PT800
3. Depth 48"

2. Make Coulters

3. Model # 70305

4. Capacity 7 GPM

5. Pump exceeds well capacity Yes _____ No ☒

6. If Yes, is low pressure cutoff switch installed? Yes _____ No _____

7. What methods are used to protect the pump and electrical wiring from vibrations? Torque arrestors ☒ Cable guards ☒ Other _____

Tank

1. Capacity 80 gal
2. Pressure relief valve? Yes

Piping

1. Type Poly
2. Size 1"
3. NSF and/or BOCA Code approved Yes
4. Depth of supply line 48"

Well data

1. Depth 285 ft.
2. Yield 11 GPM
3. Static water level 60 ft.
4. Will water supply be disinfected by installer? Yes

I understand that it is my responsibility to notify the Howard County Health Department when the installation is ready for inspection (otherwise this permit is null and void).

All information given above is true to the best of my knowledge.

Signature of Applicant: [Signature]

Date: 12-12-2000

Note: A sticker indicating approval/status of the installation will be placed on the well casing at the time of the inspection.

HOWARD COUNTY HEALTH DEPARTMENT
Bureau of Environmental Health
3525-H Ellicott Mills Drive
Ellicott City, MD 21043
461-9933

APPLICATION FOR PITLESS ADAPTER, WELL PUMP AND PRESSURE TANK INSTALLATION

New Installation ☒
Replacement ☐

Receipt # _____
Date _____

Name of Installer Gary Eikenberry

Telephone 410-796-8583

License Number 3260

Certified Well Pump Installer _____ Well Driller _____ Registered Plumber ☒

Name of Property Owner Andy Benford

Telephone _____

Subdivision Brierly Lot # 12

Well Tag # 40-94-2485

Site Address 13856 Russell Zapp Dr
Clarksville Md 21029

Pump

1. Type
 - a. Deep well jet _____
 - b. Shallow well jet _____
 - c. Submersible ☒
2. Make Goulds
3. Model # 7ES05
4. Capacity 7 GPM

Motor

1. Horsepower 3/4
2. RPM 1850
3. Voltage _____
 - a. 110 _____
 - b. 220 ☒

Pitless Adapter

1. Make Harvard
2. Model # PT800
3. Depth 48"

5. Pump exceeds well capacity Yes _____ No ☒
6. If Yes, is low pressure cutoff switch installed? Yes _____ No _____
7. What methods are used to protect the pump and electrical wiring from vibrations? Torque arrestors ☒ Cable guards ☒ Other _____

Tank

1. Capacity 80 gal
2. Pressure relief valve? Yes

Piping

1. Type Poly
2. Size 1"
3. NSF and/or BOCA Code approved Yes
4. Depth of supply line 48"

Well data

1. Depth 285 ft.
2. Yield 11 GPM
3. Static water level 60 ft.
4. Will water supply be disinfected by installer? Yes

I understand that it is my responsibility to notify the Howard County Health Department when the installation is ready for inspection (otherwise this permit is null and void).

All information given above is true to the best of my knowledge.

Signature of Applicant: [Signature]

Date: 12-12-2000

Note: A sticker indicating approval/status of the installation will be placed on the well casing at the time of the inspection.


May 08 00 01:07p Tradition Home Builders 410-531-9203 p.1

PLAN SCALE: 1"=60'

BP#
B00121763

RUSSELL
ZEPP
DRIVE

PREPARED BY:
MARKS & ASSOCIATES L.L.C.
4531 COLLEGE AVENUE
ELLCOTT CITY, MARYLAND 21049
(410) 747-8738

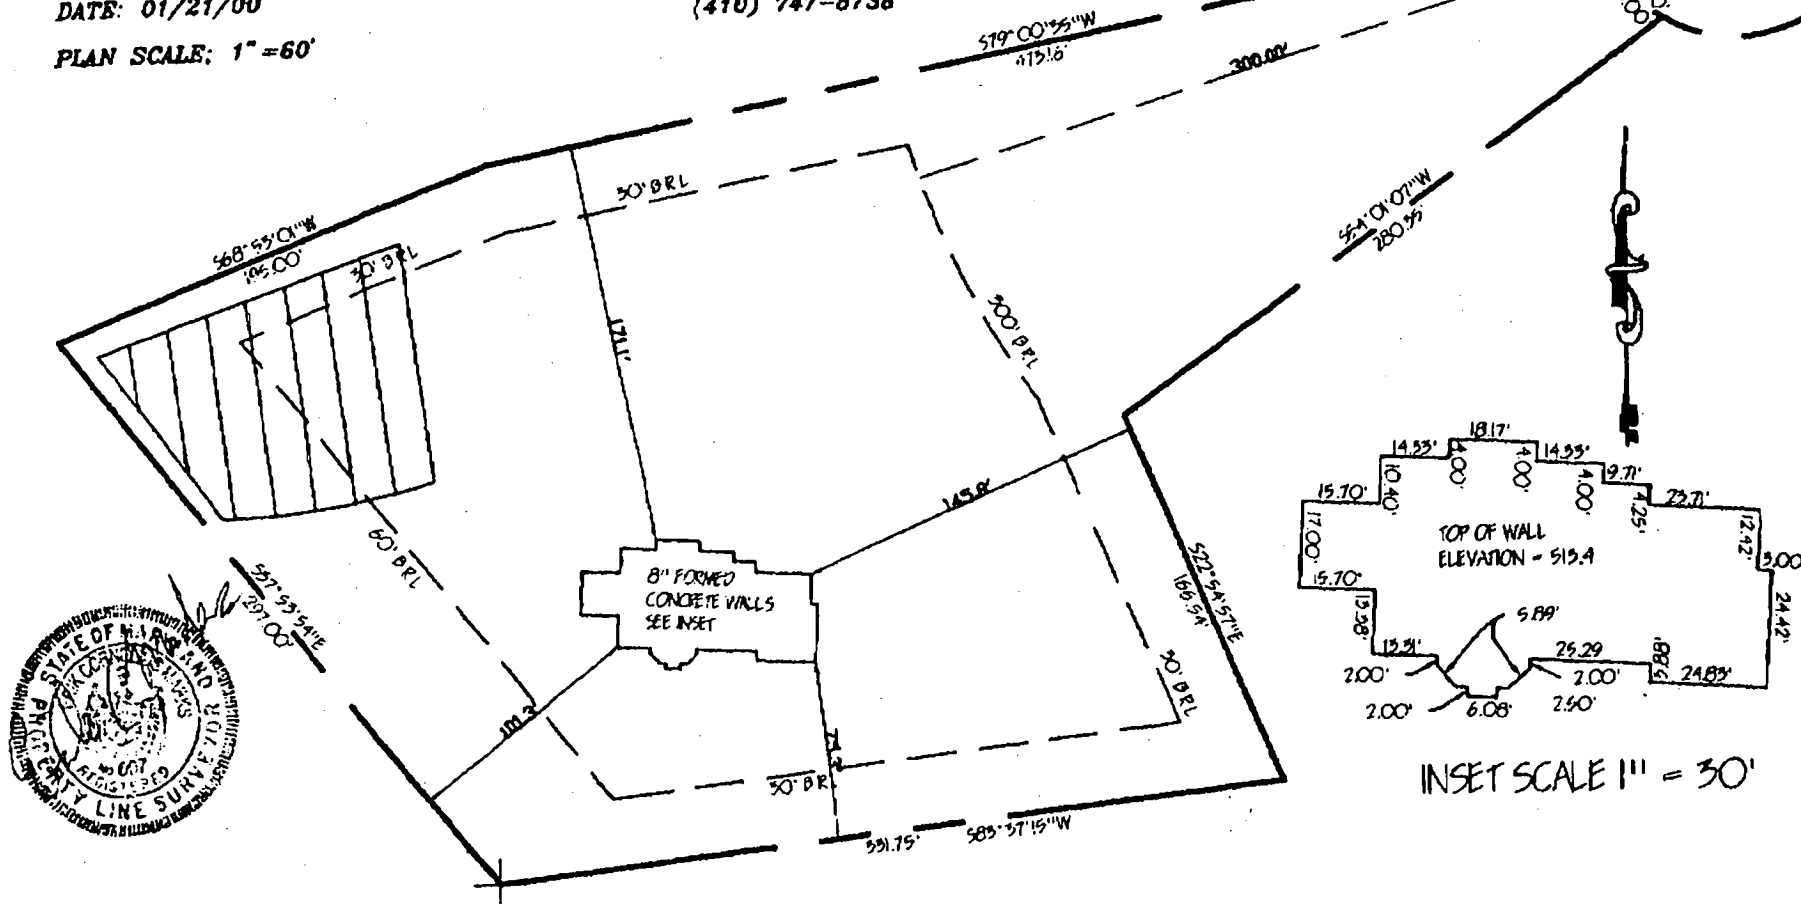

INSET SCALE 1" = 30'

5/8/00
House shifted 10'± towards
331.75' 1st line - Should
not adversely impact
septic system installation
(TKS)

Total linear feet of trench
required 320 feet.

Width of trench(es) 3.0

Depth of trench(es) 6.5


Depth of stone required below
distribution pipe 2.0 feet

GENERAL NOTES

1. ELEVATIONS

- A. BASEMENT: 502.0
- B. FIRST FLOOR 510.0
- C. INVERT OUT OF HOUSE: 492.4
- D. INVERT INTO SEPTIC TANK: 491.6
- E. INVERT OUT OF SEPTIC TANK: 491.4
- F. INVERT INTO DISTRIBUTION BOX: 490.0
- G. INVERT INTO TRENCH: 490.0
- H. EXISTING GRADE AT SEPTIC TANK: 497.0
- I. EXISTING GRADE AT DISTRIBUTION BOX: 493.0
- J. EXISTING GRADE AT TRENCH: 492.8
- K. ELEVATION AT WELL AT GRADE: 520.0

2. PROPERTY INFO.: BRIERLY, LOT 12

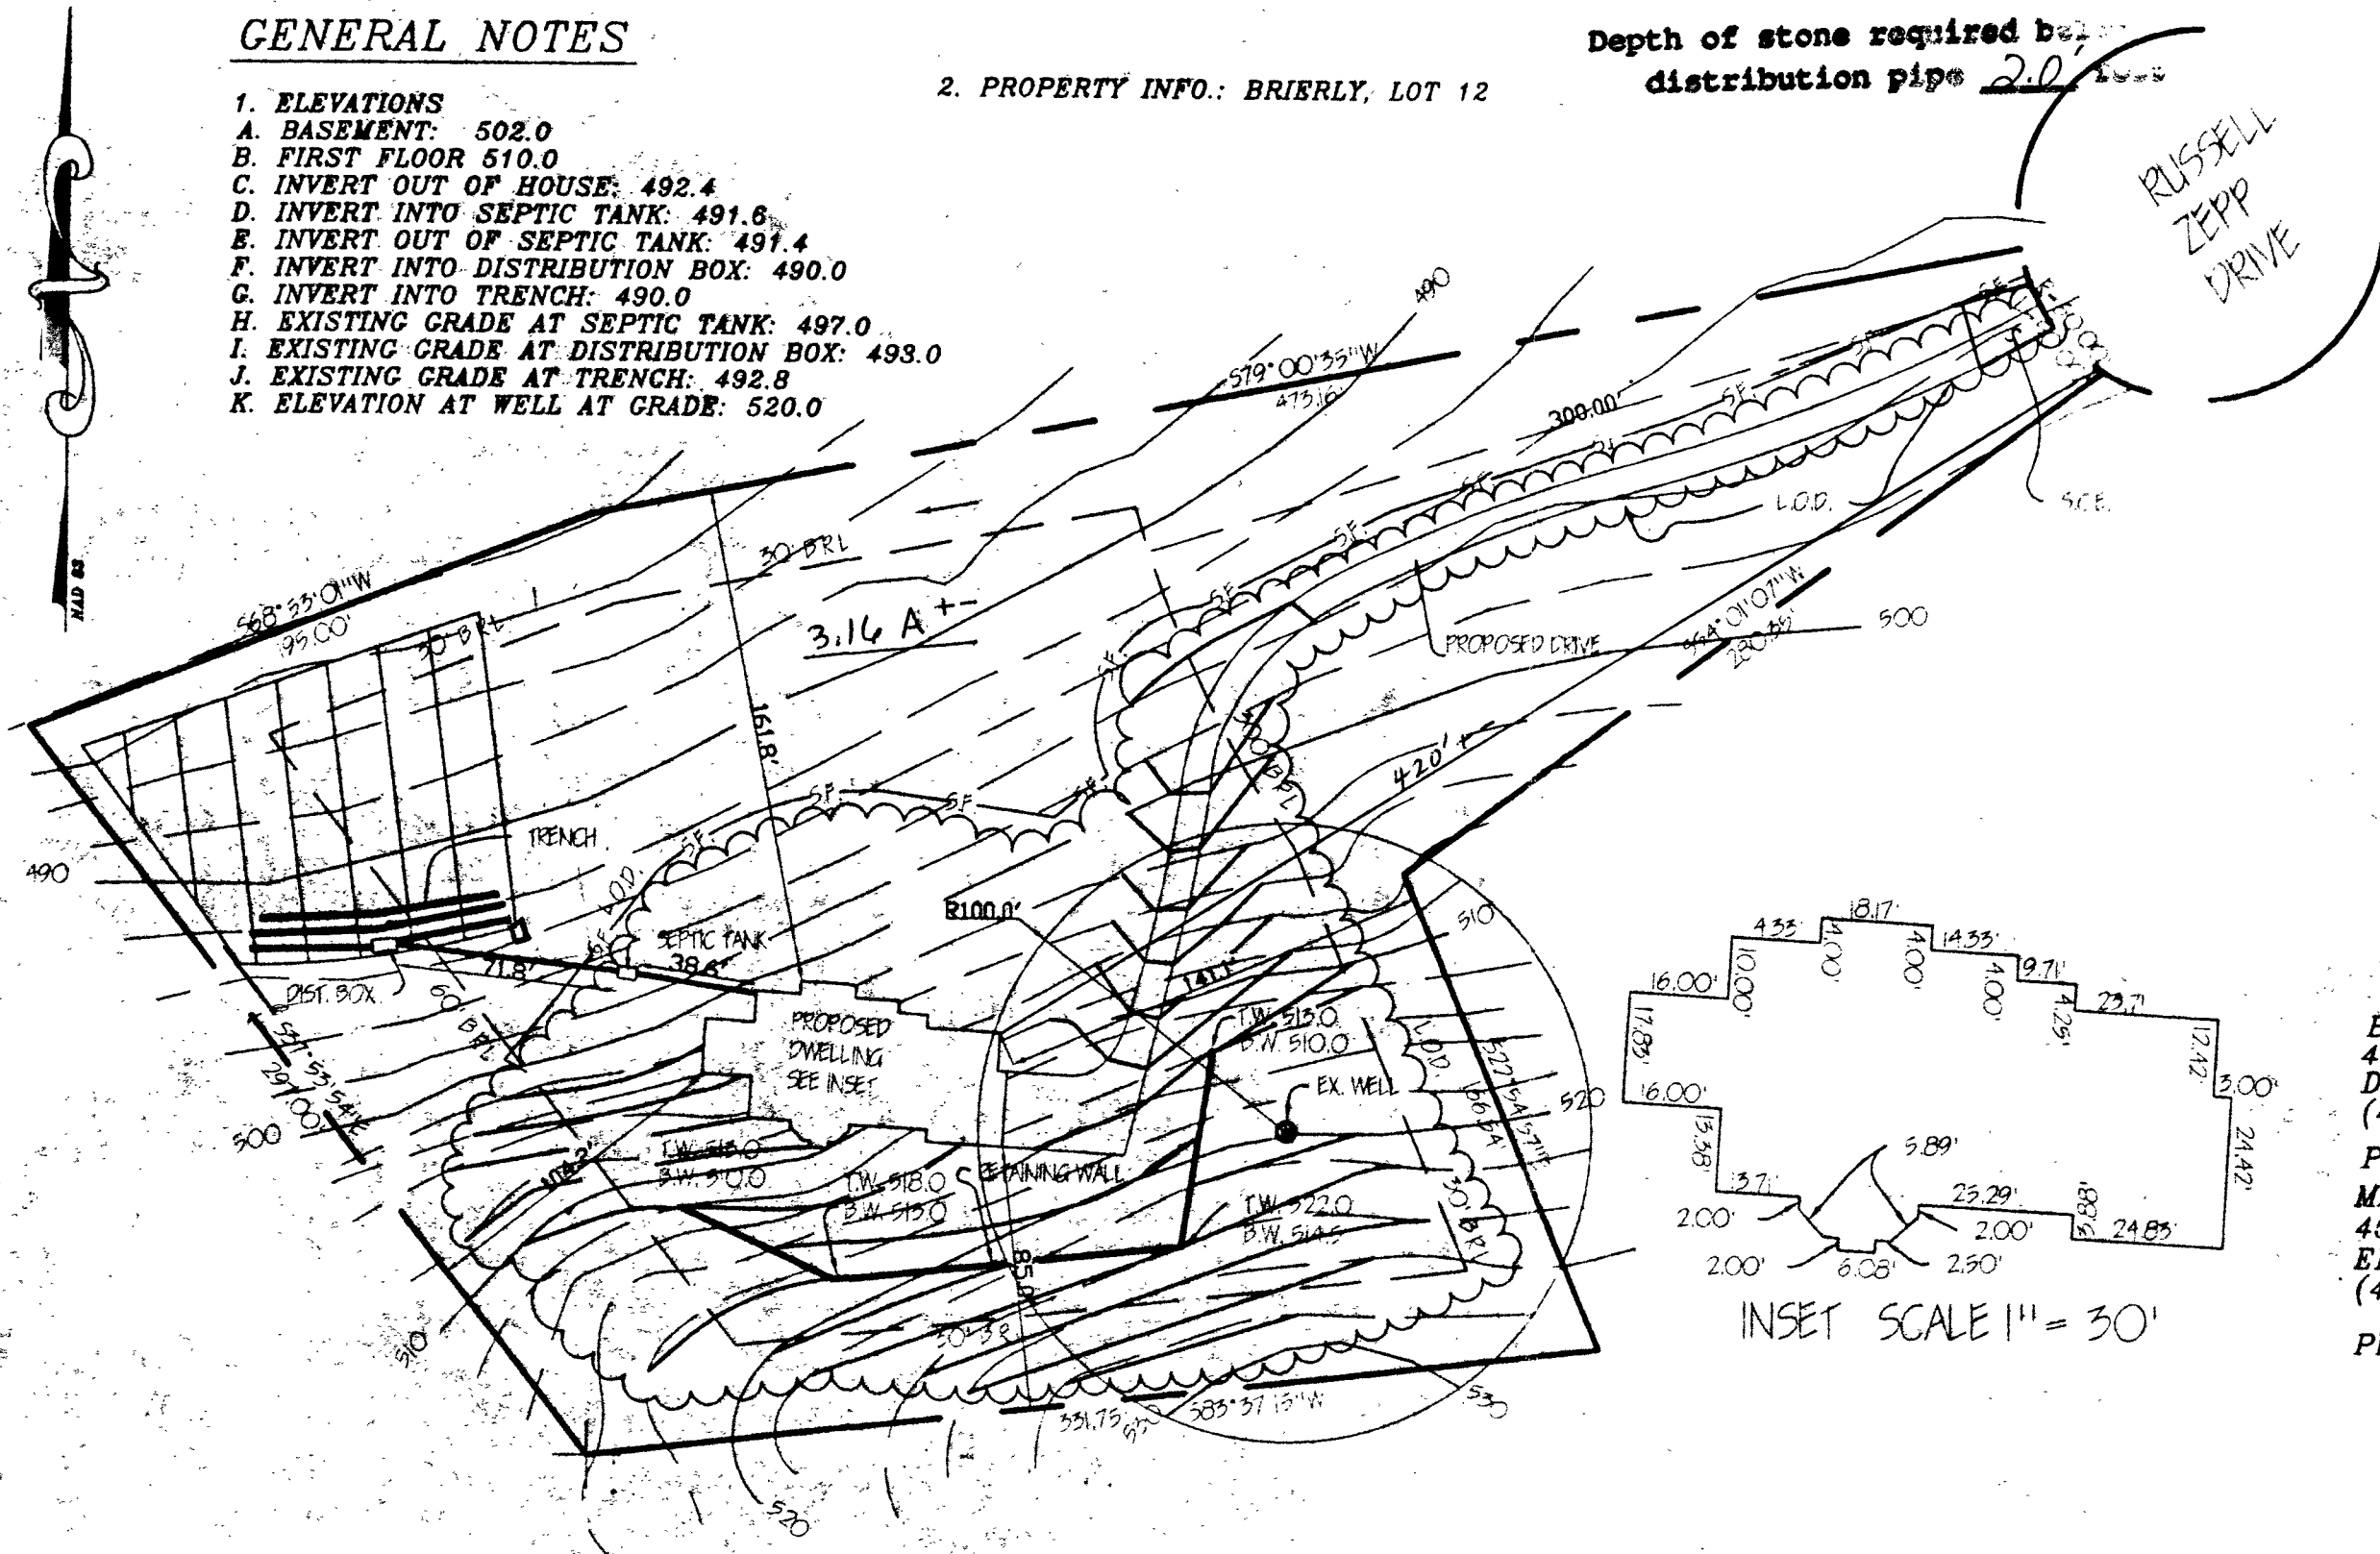

RUSSELL
ZEPP
DRIVE

Approved Septic System Plan
Howard County Health Department

Amy M. McMill 12/27/99
Signature Date

PLOT PLAN FOR PROPOSED SINGLE FAMILY DWELLING

TAX MAP 34 P/O PARCEL 7

PLAT NO. 10004


DATE: 12/02/99

SCALE: AS SHOWN

BUILDER: TRADITION HOME BUILDERS, INC.
4540 TEN OAKS ROAD
DAYTON, MARYLAND, 21036
(410) 531-9203


PREPARED BY:
MARKS & ASSOCIATES L.L.C.
4531 COLLEGE AVENUE
ELLCOTT CITY, MARYLAND 21043
(410) 747-8738


PLAN SCALE: 1" = 60'

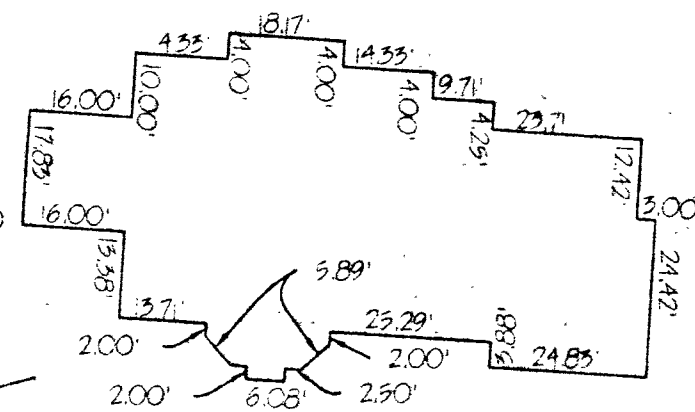

INSET SCALE 1" = 30'

83.7430	806139.1529
82.4695	805774.2810
8666.5518	805582.2146
554.0127	805644.8248
239.0712	805761.4927
407.5909	805805.4822
571.1930	805862.0981
781.5969	805957.2349
52.7336	806136.1091
335.2035	806198.6742
876.9050	806339.9220
806.6950	807294.3020

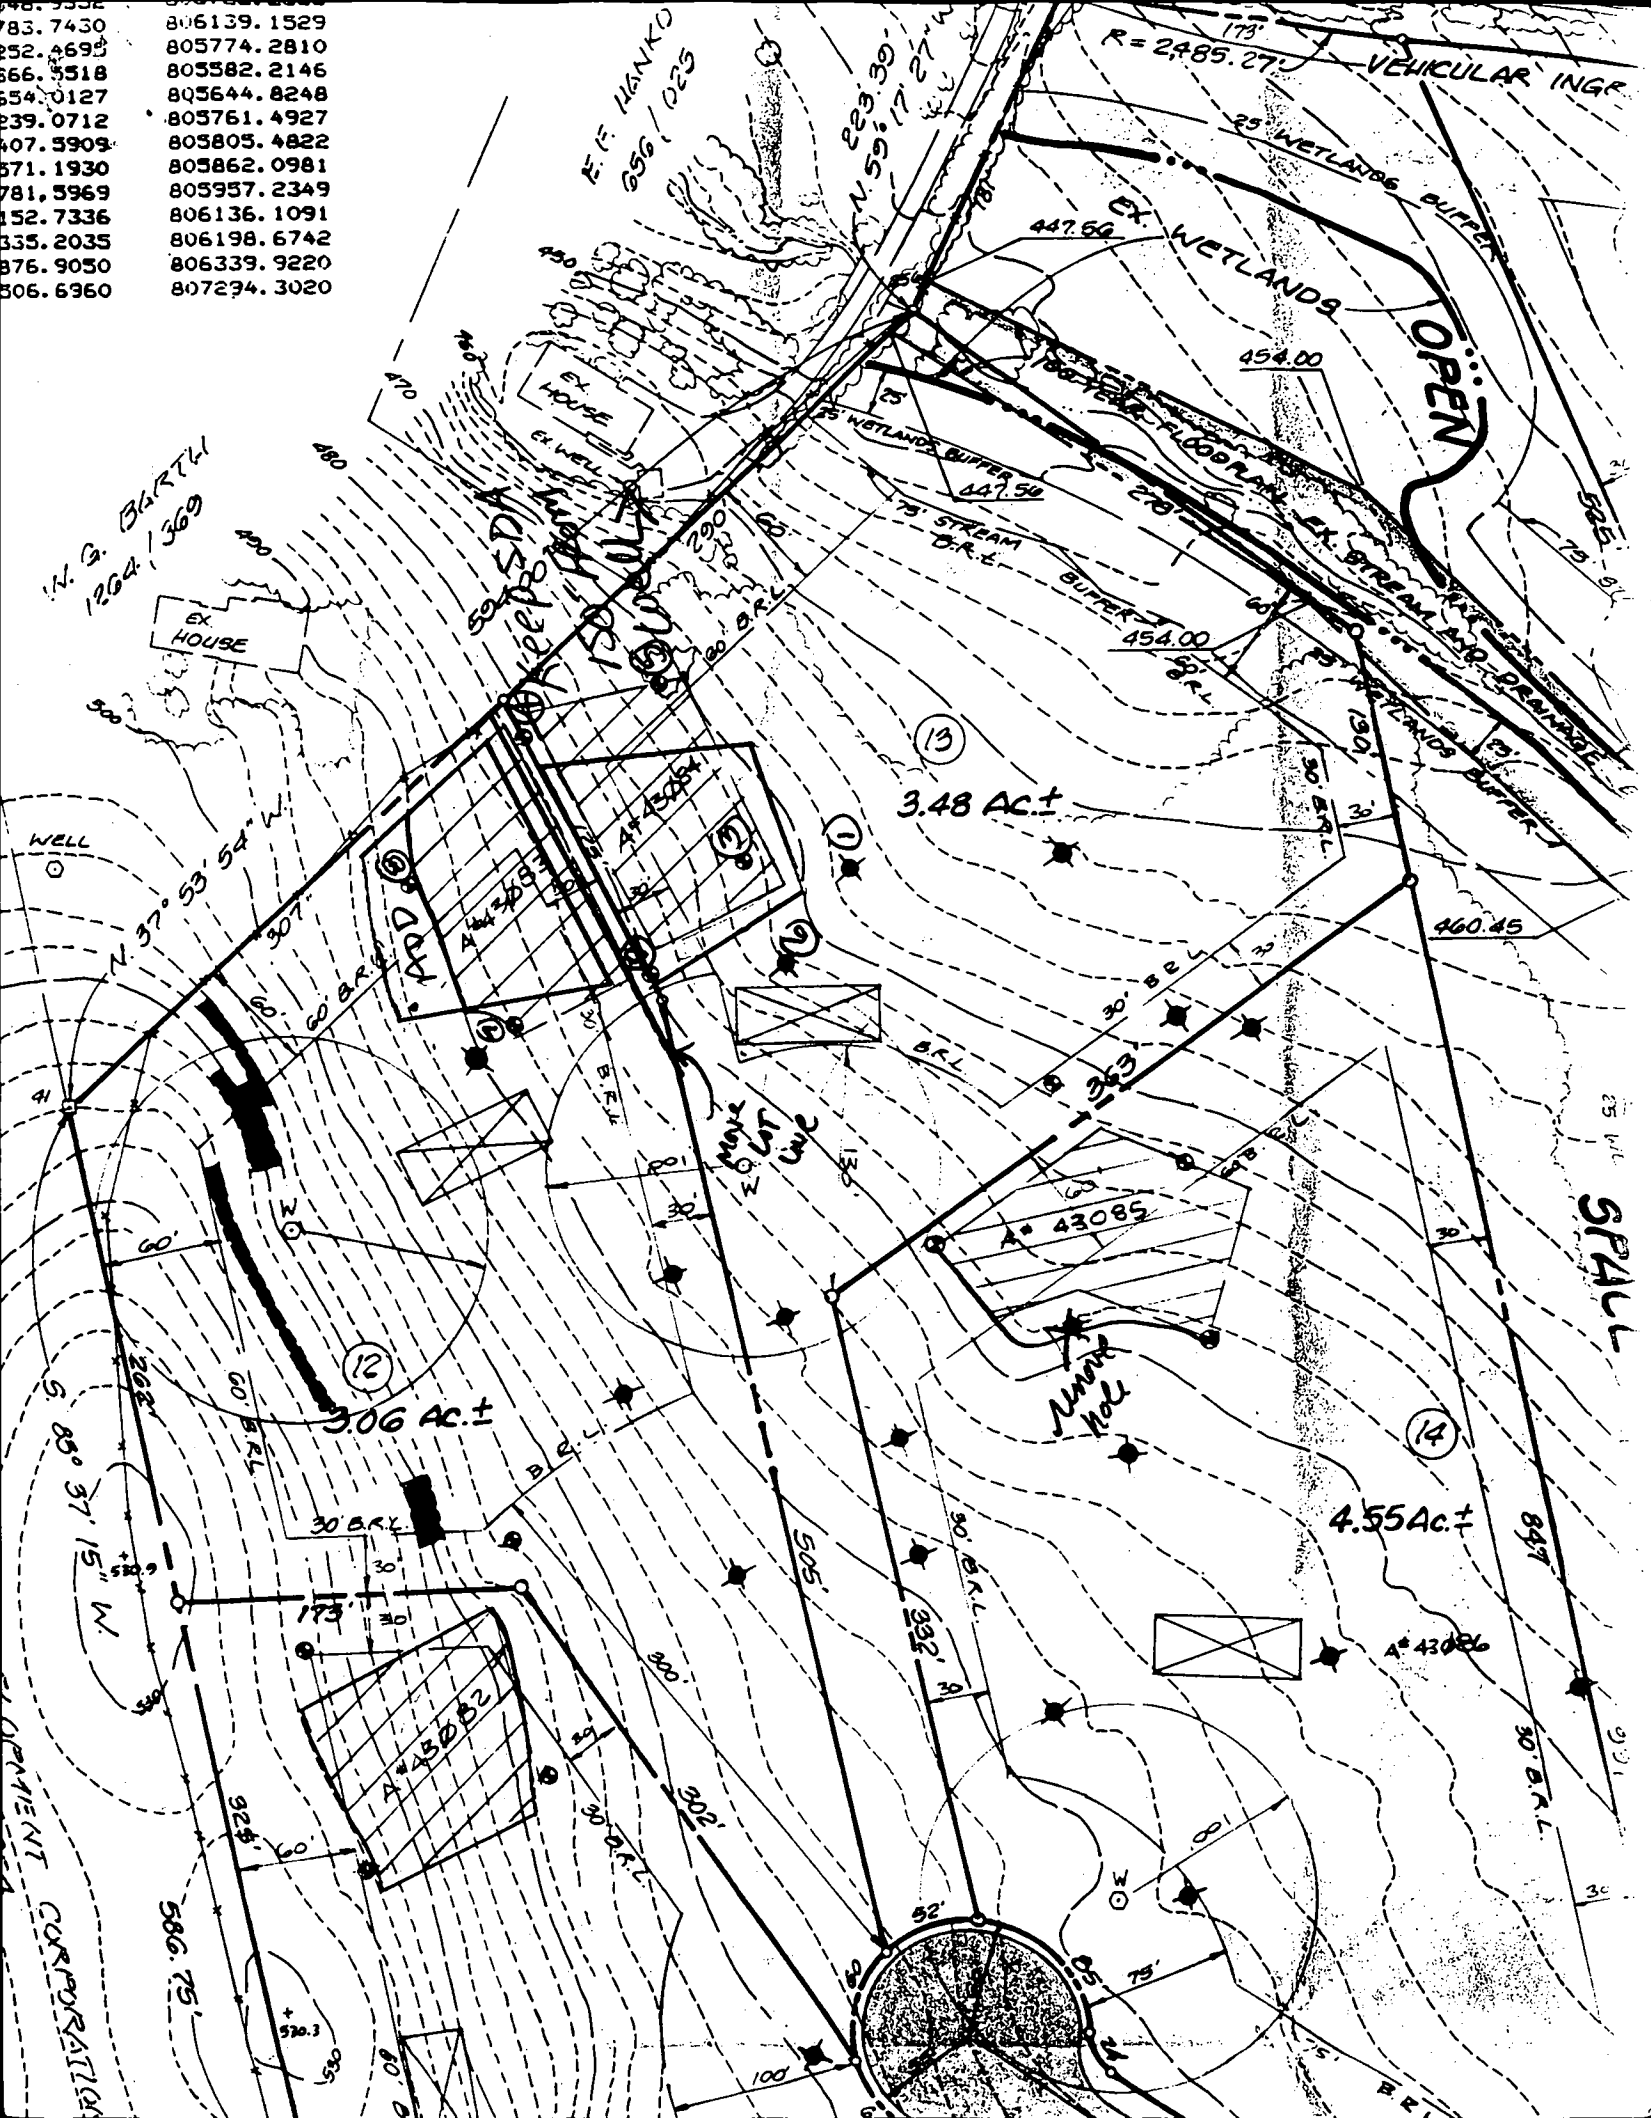

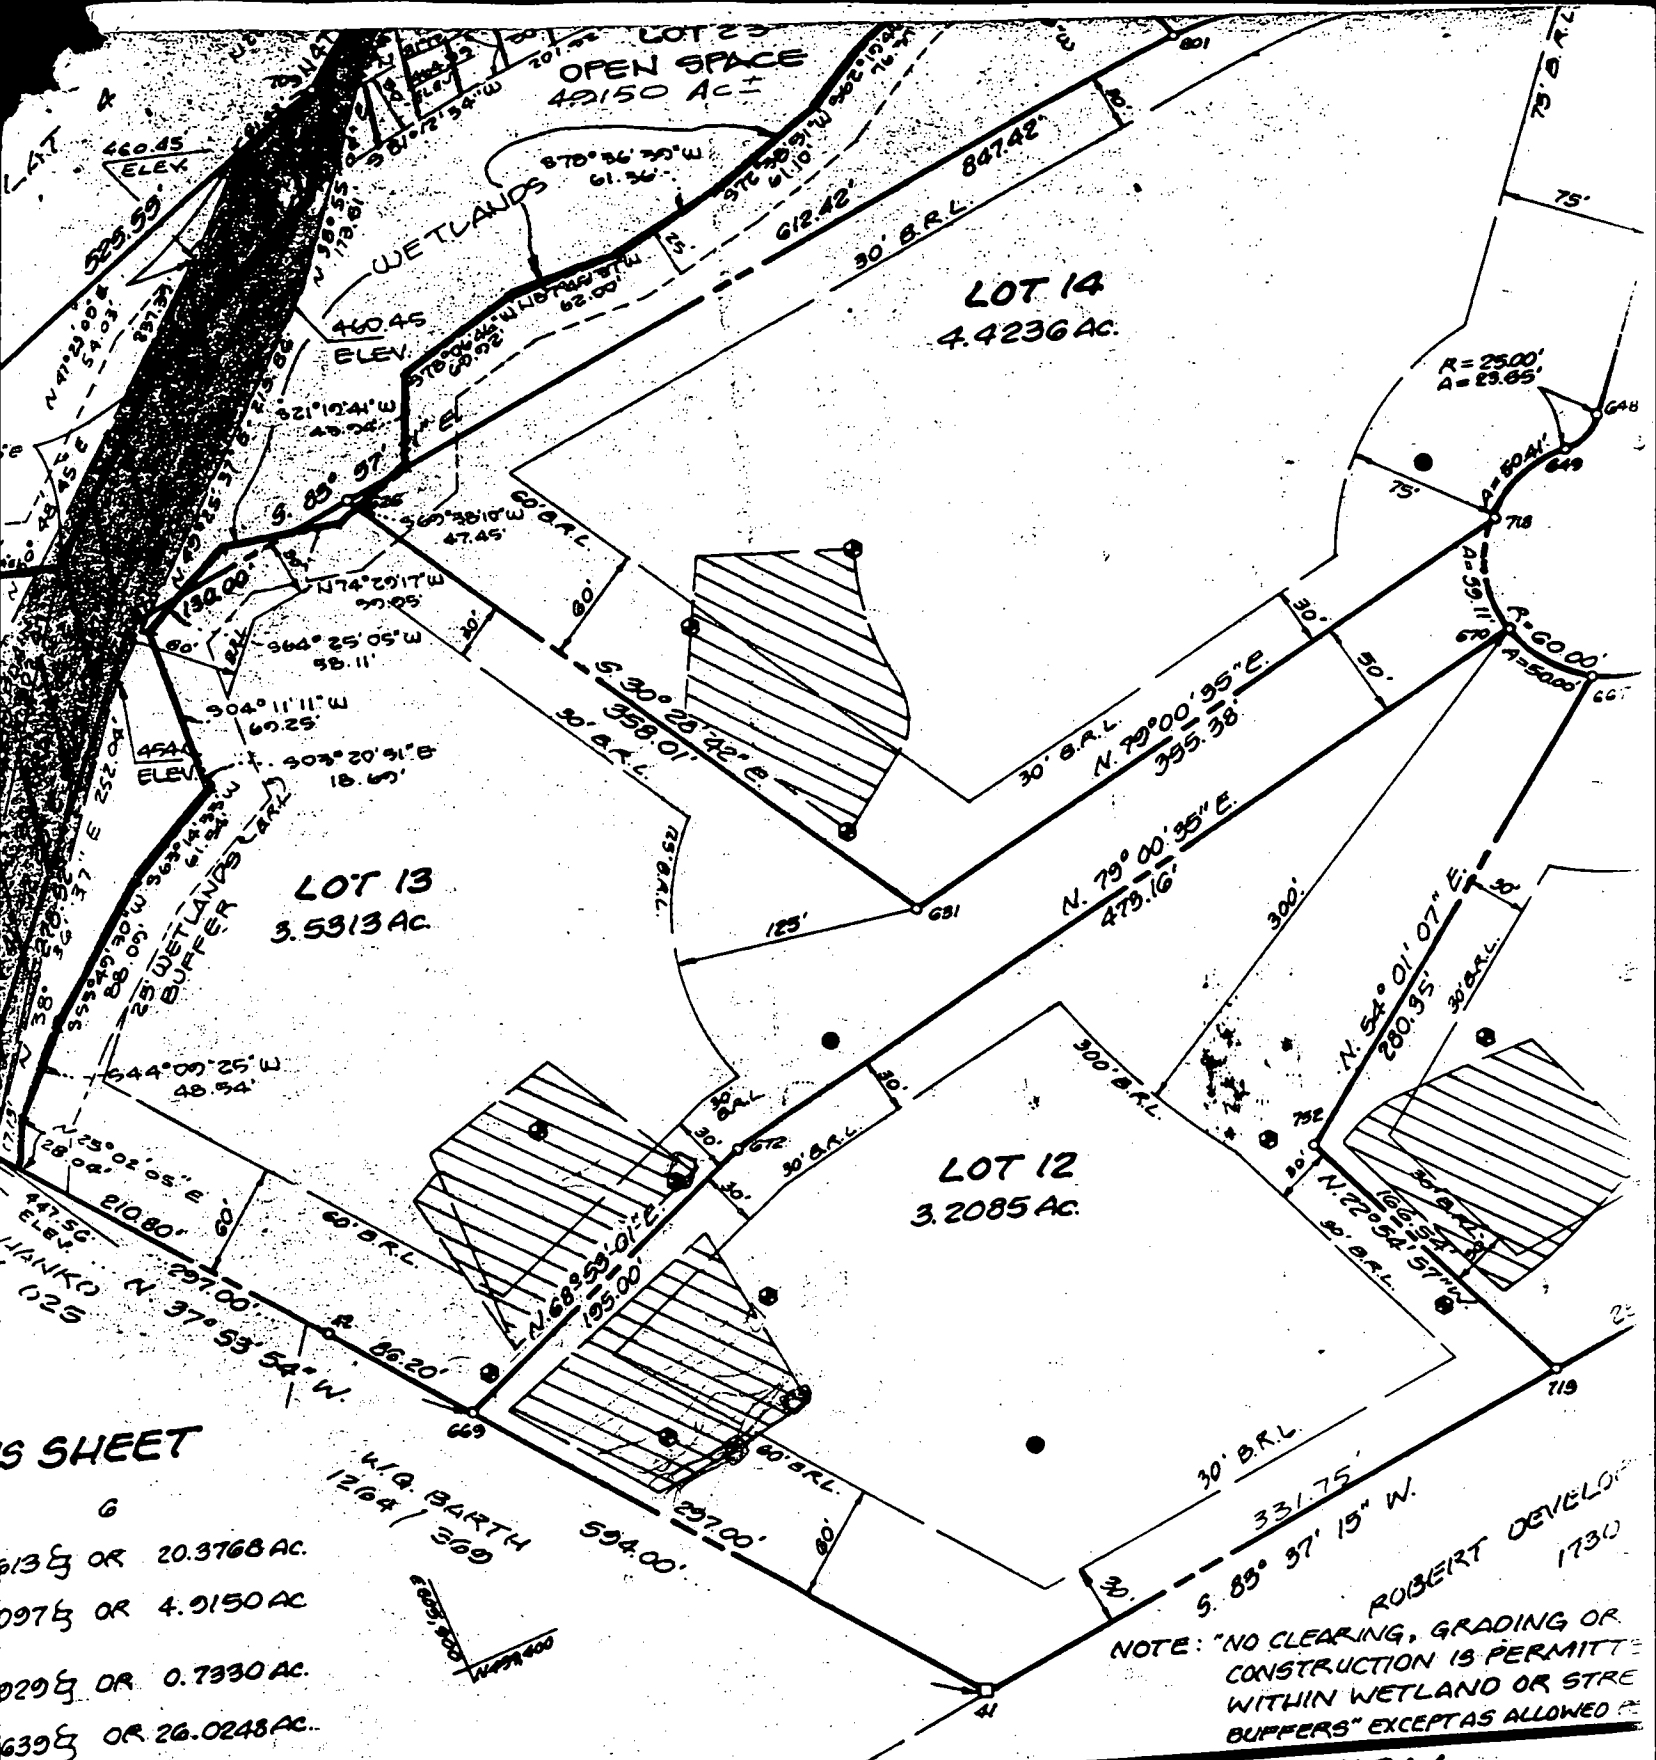

S SHEET

6
 6613 E OR 20.3768 AC.
 097 E OR 4.9150 AC
 029 E OR 0.7330 AC.
 639 E OR 26.0248 AC.

PRIVATE WATER
 WERAGE
 RD COUNTY
 TMENT

per JSM 7/17/17
 DATE

OWNERS DEDICATION


I, LAWRIE B. SARGENT, GENERAL PARTNER OF CLARKSVILLE ASSOCIATES, A GENERAL PARTNERSHIP, OWNER OF THE PROPER AND DESCRIBED HEREON HEREBY ADOPT THIS PLAN OF SUBDIVISION, AND OF THE APPROVAL OF THIS PLAN BY THE OFFICE OF PLANNING AND ESTABLISH THE MINIMUM BUILDING RESTRICTION LINES AND GRANT TO COUNTY, MARYLAND, ITS SUCCESSORS AND ASSIGNS, (1) THE RIGHT AND MAINTAIN SEWERS, DRAIN, WATER PIPES AND OTHER MUNICIPAL SERVICES, IN AND UNDER ALL ROADS AND STREET RIGHT OF WAYS EASEMENT AREAS SHOWN HEREON (2) THE RIGHT TO REQUIRE DEDICATION OF THE STREETS AND/OR ROADS AND FLOOD PLAINS AND OTHER VALUABLE CONSIDERABLE ACQUIRE THE F

GENERAL NOTES

1. ELEVATIONS

- A. BASEMENT: -502.0
B. FIRST FLOOR 510.0
C. INVERT OUT OF HOUSE: 492.6
D. INVERT INTO SEPTIC TANK: 491.6
E. INVERT OUT OF SEPTIC TANK: 491.4
F. INVERT INTO DISTRIBUTION BOX: 490.0
G. INVERT INTO TRENCH: 490.0
H. EXISTING GRADE AT SEPTIC TANK: 497.0
I. EXISTING GRADE AT DISTRIBUTION BOX: 493.0
J. EXISTING GRADE AT TRENCH: 492.8
K. ELEVATION AT WELL AT GRADE: 497.0

2. PROPERTY INFO.: BRIERLY, LOT 12

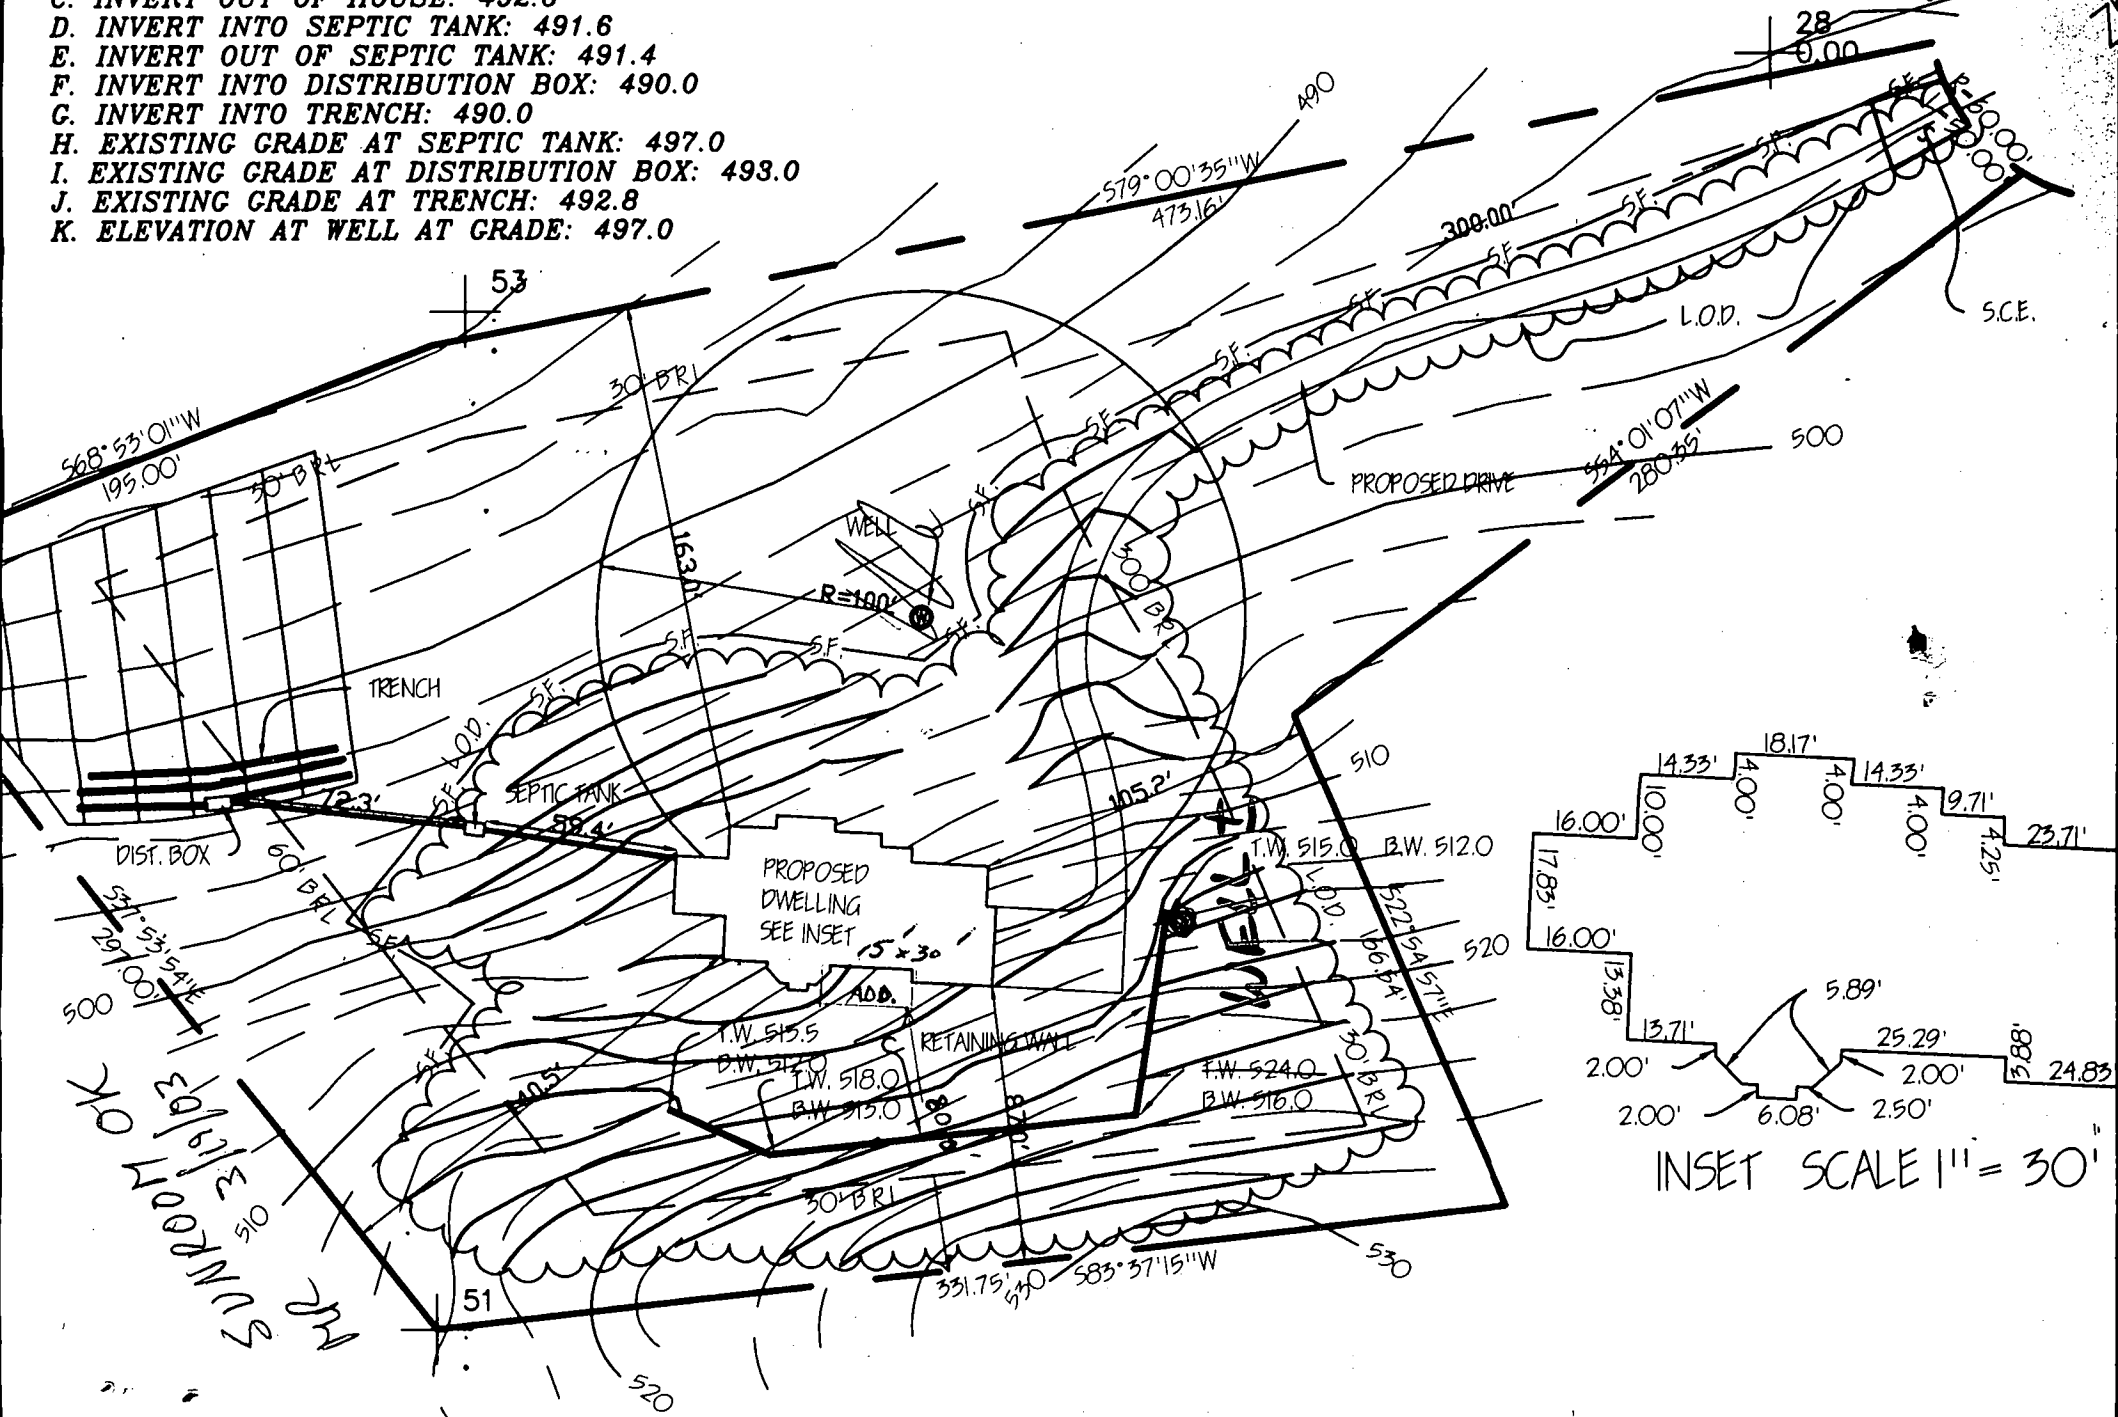

HOWARD COUNTY
PERMIT APPLICATION

PERMIT NUMBER

B000140754

Building Address 13856 Russell Zapp Dr
Clarksville MD 21029

Suite/Apt. #: _____ SDP/WP/Petition #: _____

Census Tract 6051.01 Subdivision Briery

Section _____ Area 5 Lot 12

Tax Map 34 Parcel 7 Grid 939

Zoning PRDEO Map Coordinates 13K7 Lot size _____

Existing Use Single Family Home

Proposed Use Same with Addition

Estimated Construction Cost \$ 25,600

Description of Work Add 1 story Sun

Room of Room with 1 Step

To grade. 15' x 30' wide

Occupant or Tenant Owner

Contact Name _____

Address _____

City _____ State _____ Zip Code _____

Phone _____ Fax _____

Property Owner's Name Ardley Bentel

Address 13856 Russell Zapp Dr

City Clarksville State MD Zip Code 21029

Home Phone _____ Work Phone 4554 1960

Applicant's Name & Mailing Address, (if other than stated hereon):

Phone _____ Fax _____

Contractor Company Owner

Contact Person _____

Address _____

City _____ State _____ Zip Code _____

License No. _____

Phone _____ Fax _____

Engineer or Architect Company _____

Contact Person _____

Address _____

City _____ State _____ Zip Code _____

Phone _____ Fax _____

BUILDING DESCRIPTION - COMMERCIAL

Building Characteristics

Utilities

Height: _____

No. of stories: _____

Gross area, sq. ft. per floor: _____

Use group: _____

Construction type:

☐ Reinforced Concrete

☐ Structural Steel

☐ Masonry

☐ Wood Frame

☐ State Certified Modular

Water Supply:

☐ Public

☐ Private

Sewage Disposal:

☐ Public

☐ Private

Electric Yes ☒ No ☐

Gas Yes ☐ No ☐

Heating System:

Electric ☐ Oil ☐

Natural Gas ☐

Propane Gas ☐

Sprinkler system: N/A ☐

☐ Full

☐ Partial

☐ Other Suppression

of Heads _____

BUILDING DESCRIPTION - RESIDENTIAL

Building Characteristics

Utilities

SE Dwelling ☐ SF Townhouse ☐

Depth Width

1st floor: _____

2nd floor: _____

Basement: _____

Finished Basement ☐ Unfinished Basement ☐

Crawl space ☐ Slab on Grade ☐

No. of Bedrooms _____

Multi-family dwellings:

No. of efficiency units: _____

No. of 1 BR units: _____

No. of 2 BR units: _____

No. of 3 BR units: _____

Other Structure: _____

Dimensions: _____

Footings: _____

Roof: _____

☐ State Certified Modular

☐ Manufactured Home

Water Supply:

☒ Public

☒ Private

Sewage Disposal:

☒ Public

☒ Private

Electric Yes ☒ No ☐

Gas Yes ☐ No ☐

Heating System:

Electric ☒ Oil ☐

Natural Gas ☐

Propane Gas ☐

Sprinkler system: N/A ☐

☐ NFPA #13D

☐ NFPA #13R

☐ Other: _____

THE UNDERSIGNED HEREBY CERTIFIES AND AGREES AS FOLLOWS: (1) THAT HE/SHE IS AUTHORIZED TO MAKE THIS APPLICATION; (2) THAT THE INFORMATION IS CORRECT; (3) THAT HE/SHE WILL COMPLY WITH ALL REGULATIONS OF HOWARD COUNTY WHICH ARE APPLICABLE THERETO; (4) THAT HE/SHE WILL PERFORM NO WORK ON THE ABOVE REFERENCED PROPERTY NOT SPECIFICALLY DESCRIBED IN THIS APPLICATION; (5) THAT HE/SHE GRANTS COUNTY OFFICIALS THE RIGHT TO ENTER ONTO THE PROPERTY FOR THE PURPOSE OF INSPECTING THE WORK PERMITTED AND POSTING NOTICES.

Applicant's Signature _____

Title/Company _____

Print Name _____

Date _____

Checks payable to: DIRECTOR OF FINANCE OF HOWARD COUNTY

** PLEASE WRITE NEATLY AND LEGIBLY **

FOR OFFICE USE ONLY

AGENCY _____ DATE _____ SIGNATURE APPROVAL _____ DBZ SETBACK INFORMATION _____ PROPERTY ID# 44398