

INDEXED

PERMIT
SEWAGE DISPOSAL SYSTEM
HOWARD COUNTY HEALTH DEPARTMENT
BUREAU OF ENVIRONMENTAL HEALTH
410-313-2640

P 513684

A REPAIR

ISSUE DATE 7/13/00

APPROVAL DATE 7/17/00

Jack Fyock Septic Service IS PERMITTED TO INSTALL ALTER X

ADDRESS P.O. Box 89, Glenelg, MD 21737 PHONE 410-988-9270

SUBDIVISION _____ LOT NUMBER _____ ADDRESS 17590 Route 144

PROPERTY OWNER Mary Damico PROPERTY OWNER'S ADDRESS Same

SEPTIC TANK CAPACITY 1000 GALLONS

PUMP CHAMBER CAPACITY N/A GALLONS

NUMBER OF BEDROOMS 3

SQUARE FEET PER BEDROOM N/A

LINEAR FEET OF TRENCH REQUIRED N/A

TRENCHES: Trenches to be _____ feet wide. Inlet _____ feet below original grade. Bottom maximum depth _____ feet below original grade. feet of stone below distribution box.

LOCATION: _____

REPAIR - PURPOSE - To move septic tank in support of building permit

PLANS APPROVED _____ DATE _____

PERMIT VOID AFTER 2 YEARS

NOTE: CONTRACTOR RESPONSIBLE FOR SCHEDULING A PRE-CONSTRUCTION INSPECTION FOR ALL INSTALLATIONS

NOTE: TOP OF SEPTIC TANKS ARE TO BE NO DEEPER THAN 3.0 FEET BELOW FINISH GRADE

NOTE: WATERTIGHT SEPTIC TANKS REQUIRED

NOTE: CLEANOUT REQUIRED EVERY 70 FEET OF SEWER LINE AND/OR AT 90° SWEEPS IN LINES FROM HOUSE TO DRAIN FIELDS, 90° ELBOWS & ARE NOT ACCEPTABLE

NOTE: ALL PARTS OF SEPTIC SYSTEMS (I.E. TANK, DISTRIBUTION BOX, DRAINFIELDS) TO BE 100 FEET FROM ANY WATER WELL UNLESS OTHERWISE SPECIFICALLY AUTHORIZED

NOTE: NO ABSORPTION TRENCH TO EXCEED 100 FEET IN LENGTH UNLESS SPECIFICALLY AUTHORIZED

NOTE: ALL PIPE FROM HOUSE TO SEPTIC TANK MUST BE CAST IRON OR SCHEDULE 35/40 PVC OR ABS

NOTE: MANHOLE RISERS REQUIRED ON ALL SEPTIC TANKS AND PUMP CHAMBERS

NOTE: DISTRIBUTION BOXES MUST HAVE BAFFLES


NOTE: IF PUMPED SEPTIC SYSTEM REQUIRED, (1) SEPTIC PUMP DETAIL TO BE PROVIDED BY INSTALLER PRIOR TO ISSUANCE OF SEPTIC PERMIT (2) PUMP PERFORMANCE TEST IS NECESSARY PRIOR TO HEALTH DEPARTMENT APPROVAL OF SEPTIC PERMIT

NEITHER THE HOWARD COUNTY COUNCIL NOR THE HEALTH DEPARTMENT IS RESPONSIBLE FOR THE
SUCCESSFUL OPERATION OF ANY SYSTEM
PERMITTEE RESPONSIBLE FOR OBTAINING FINAL APPROVAL ON THIS PERMIT
CALL 410-313-2640 FOR INSPECTION OF SEPTIC SYSTEM

OLD PERMIT ~~SIGNED~~
AND RETURNED 7/13/00
000125437 Family Room
Green porch

513684

NOT TO SCALE

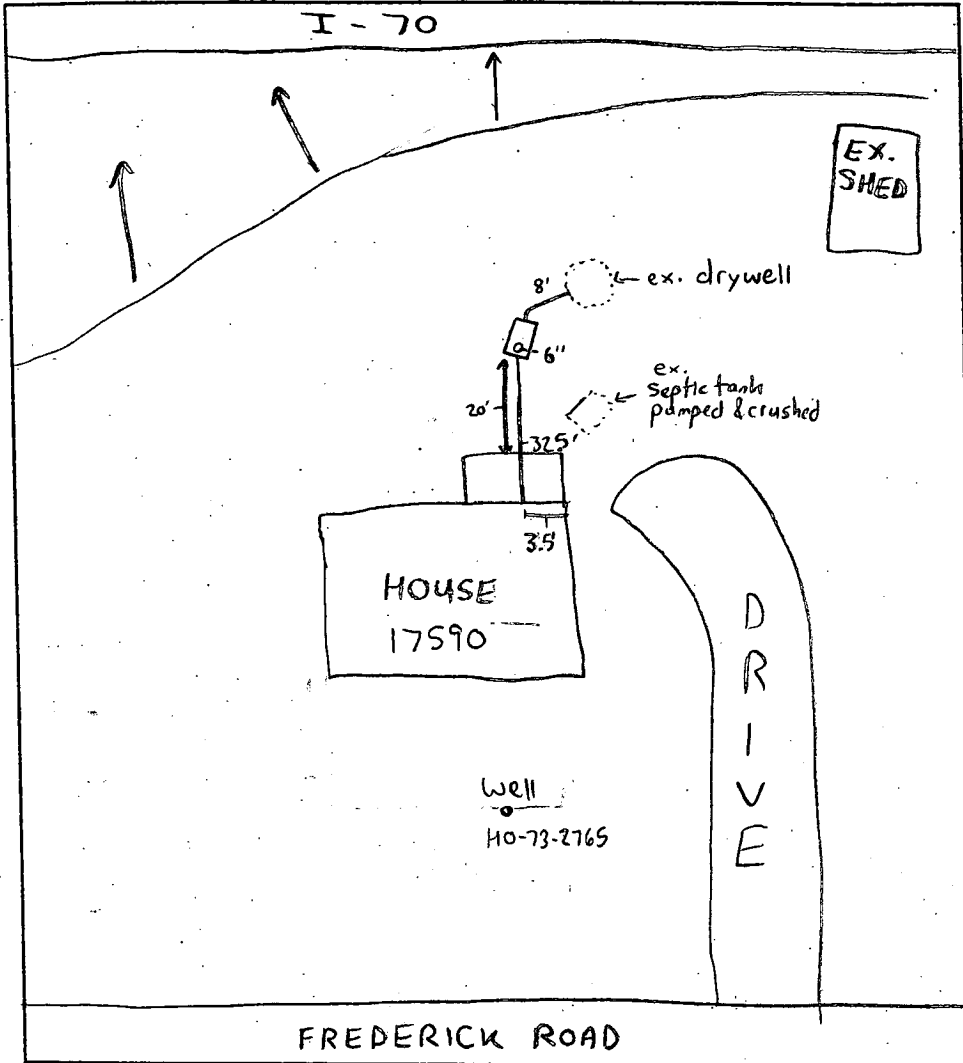

TRENCH DATA

TRENCH WIDTH N/A
TRENCH INLET DEPTH N/A
TRENCH BOTTOM DEPTH N/A
DEPTH OF STONE N/A
NUMBER OF TRENCHES N/A
TOTAL TRENCH LENGTH N/A
ABSORBENT AREA N/A
DISTRIBUTION BOX LEVEL N/A
BAFFLE IN DISTRIBUTION BOX N/A

SEPTIC TANK DATA

SEPTIC TANK 1000 M.S. GALLONS
BAFFLES IN N/A
MANHOLE RISER N/A
6 INCH INSPECTION PORT ☒


PUMP CHAMBER DATA

PUMP CHAMBER GALLONS N/A
MANHOLE RISER N/A
ALARM N/A
PUMP PERFORMANCE TEST N/A

PRE-CONSTRUCTION INSPECTION: _____

INSPECTION COMMENTS: 7/17/00 - OK TO COVER ALL WORK (SRN)

INSPECTOR Steven R. Krieg DATE SYSTEM APPROVED 7/17/00

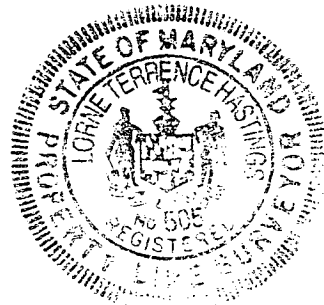

I HEREBY CERTIFY THAT I HAVE LOCATED THE
IMPROVEMENTS ON THE PROPERTY KNOWN AS
17590 NORTH FREDERICK ROAD
HOWARD COUNTY, MARYLAND
AND THE IMPROVEMENTS ARE LOCATED AS SHOWN.
THIS PLAT IS NOT TO BE USED FOR THE
PURPOSE OF ESTABLISHING PROPERTY LINES.

Lorne Hastings

02/06/92

TEMPLAR ENGINEERING
8235 RUXTON CROSSING COURT
RUXTON, MARYLAND 21204
(301) 823-3567

SCALE: 1" = 80'

F-27823

P 0012543D
17590 Frederick Rd

Tox Map 28 and 19 Parcel 50
Addition - New Party Room
and Porch

(A18084) - Septic Tank is

Too Close to proposed addition
Septic again Permit # (P513684) (P)


To Move tank 10 ft was

issued. P/P 7/13/00
Reviewed & Approved

INTERSTATE ROUTE 70

Property is all that land which lies between
Md. Route No. 144 and Interstate 70-U.S. 40 and
bounded on three sides by Maryland State Right
of Ways as described on State Roads Plat #40837
and on the south side by a 25 foot Right of Way,
with the right of ingress and egress
over said 25 foot Right of Way.

25' RIGHT OF WAY

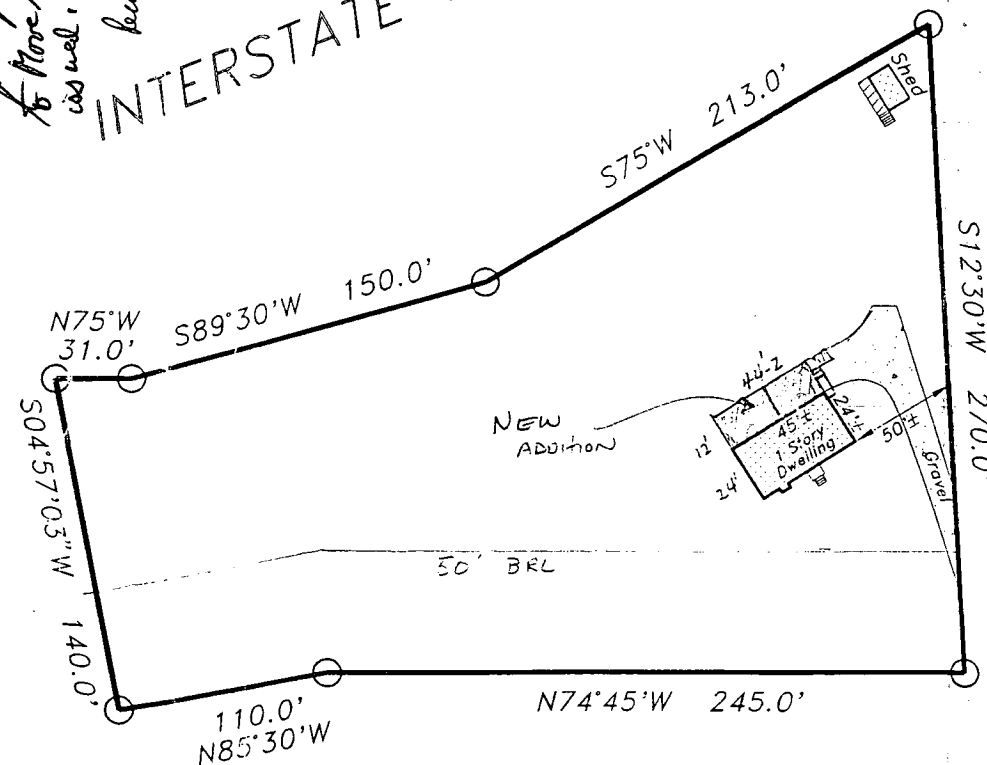

NORTH FREDERICK ROAD

Property Lies in
Flood Zone C

FIRST FLOOR BUILDING PERMIT
SIGNED

PERMIT

127344
18084

SEWAGE DISPOSAL SYSTEM
MARYLAND STATE DEPARTMENT OF HEALTH

HOWARD COUNTY

ELICOTT CITY

DISTRICT 4th

DATE 12/20/78

INDEXED

Olen Kotterman

IS PERMITTED TO INSTALL ☒ ALTER

ADDRESS 6119 Jerry's Drive, Columbia, Md. 21044

PHONE 007-8740

SUBDIVISION ROAD Route 144 LOT

PROPERTY OWNER Edward L. Schriver

Swagger

ADDRESS 8820 Hunting Lane, Apt. 203, Laurel, Md. 20811

SPECIFICATIONS 3 bedrooms

SEPTIC TANK CAPACITY 1000 GALLONS

DRAIN FIELD DEPTH FEET. BOTTOM AREA SQ. FT.

DEEP TRENCH DEPTH FEET. BOTTOM AREA SQ. FT.

SEEPAGE PITS ☒ ABSORBENT SIDE-WALL AREA 120 SQ. FT. sidewall area per bedroom.

INLET PIPE 3 FT. BELOW ORIGINAL GRADE. MAXIMUM DEPTH 9 FT. BELOW ORIGINAL GRADE

EFFECTIVE DEPTH AT FT. BELOW ORIGINAL GRADE.

LOCATE DISPOSAL AREA 175 FT. FROM front LOT LINE AND 60 FT. FROM right LOT LINE AS SHOWN WHEN

FACING LOT FROM Route 144.

PLANS APPROVED BY Donald W. Monaghan

DATE 4/13/78

COVER NO WORK UNTIL INSPECTED AND APPROVED.

NEITHER THE HOWARD COUNTY COUNCIL NOR THE HEALTH DEPARTMENT IS RESPONSIBLE FOR THE SUCCESSFUL OPERATION OF ANY SYSTEM.

NOTE IF TRENCH IS USED CALL FOR INSPECTION BEFORE PLACING GRAVEL IN TRENCH.

NOTE NO DRY WELL SHALL EXCEED 16 FOOT IN DIAMETER.

NOTE ALL PIPE FROM HOUSE TO DISPOSAL AREA MUST BE CAST IRON.

PERMIT VOID AFTER THREE YEARS.


NOTE INSTALL STAND PIPE ON SEPTIC TANK AND DRY WELL. STAND PIPES MUST BE 6 INCHES IN DIAMETER. CAST IRON, CONCRETE OR TERRAZO ACCEPTED.

BLDG. PERMIT SIGNED
AND RETURNED 1/5/79

Serial No. 35566

18084

*INSTALLER IS RESPONSIBLE FOR OBTAINING FINAL APPROVAL ON THIS PERMIT.

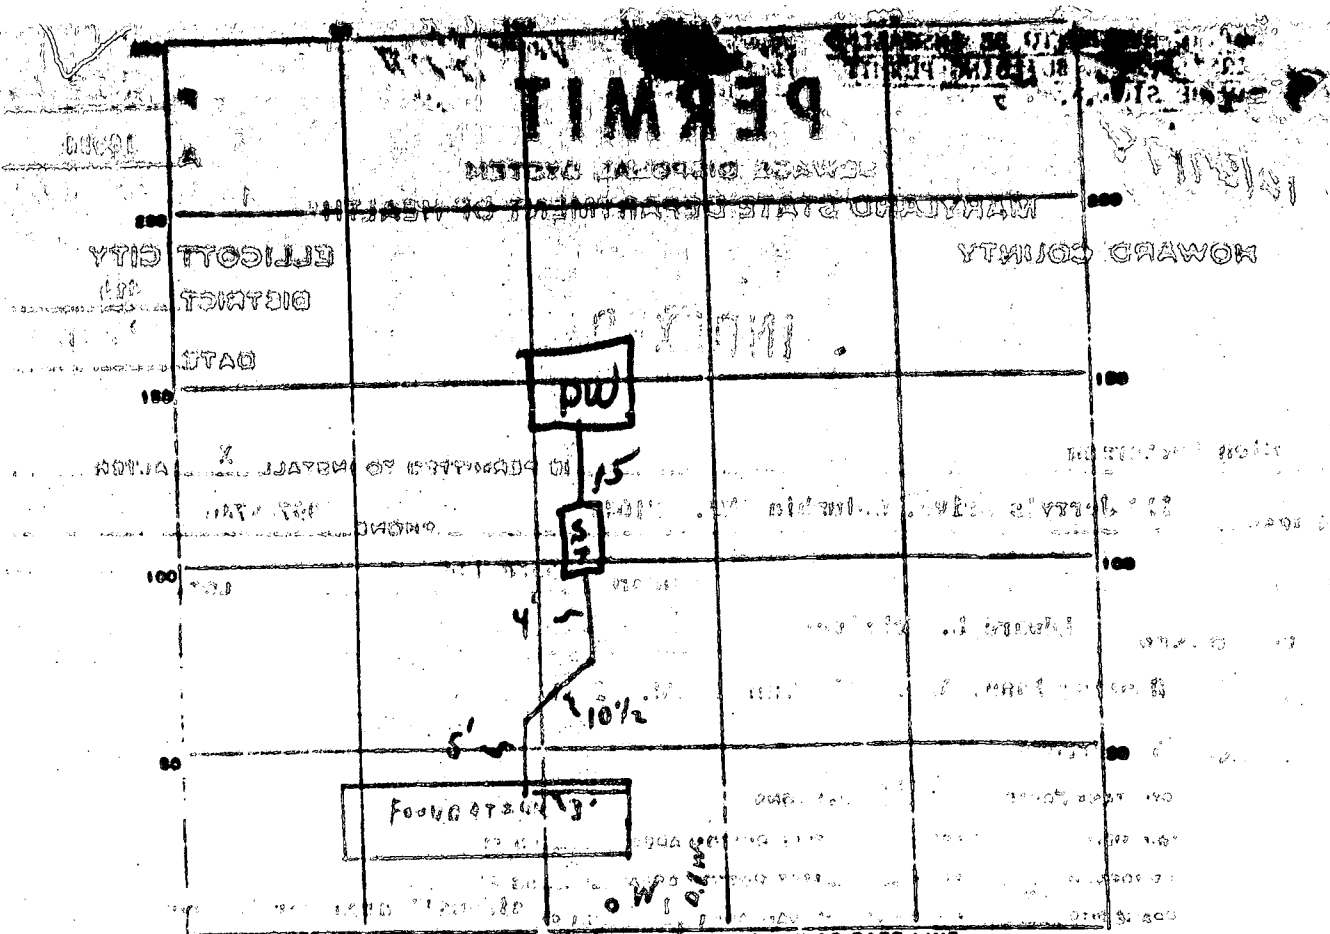

PERMIT CARD OK
 SEPTIC TANK, LEVEL OK CLEANOUTS OK
 DISTRIBUTION BOX, LEVEL _____
 TILE FIELD, DEPTH _____ FT. TRENCH WIDTH _____ FT.
 GRAVEL DEPTH _____ IN. TOTAL LENGTH _____ FT.
 NUMBER OF TRENCHES _____ TOTAL BOTTOM AREA _____
 SEEPAGE PITS, INSIDE DIAMETER 60 FT. DEPTH BELOW INLET 6 FT.
 ABSORBENT AREA 360 SQ. FT.

REMARKS 12/27/75: check inlet of tank - OK 1 cover system - call for final
sign when house is connected to tank & 9'
3/12/79 house not started yet 7/1/81 OK TO COVER HOUSE CONNECTION
TO SEPTIC TANK; IF ITS TO BE OVER 3' OF FILL AT
SEPTIC TANK & 10' DEEP MANHOLE COVER TYPE C/F/101

APPLICATION

SEWAGE DISPOSAL TESTING

STATE OF MARYLAND - DEPARTMENT OF HEALTH AND MENTAL HYGIENE

HOWARD COUNTY HEALTH DEPARTMENT
ENVIRONMENTAL HEALTH SERVICES

P. O. BOX 478, ELLICOTT CITY, MARYLAND 21043
TELEPHONE: 469-8800, EXT. 388

DISTRICT 4

DATE 2/28/73

TO: THE COUNTY HEALTH OFFICER
ELLICOTT CITY, MARYLAND

I, HEREBY, APPLY FOR THE NECESSARY TEST IN ORDER TO CONSTRUCT (OR RECONSTRUCT) A SEWAGE DISPOSAL SYSTEM.

PROPERTY OWNER Norman R. Jenkins

ADDRESS RR. 3, MC. AITY, MD.

PHONE 829-0709

PROPERTY LOCATION:

SUBDIVISION _____ LOT NO. _____

ROAD AND DESCRIPTION Route 144 - just beyond Mally's Tron Works

SIZE OF LOT 1.826 ACRES

TYPE BLDG. 2

NUMBER OF BEDROOMS
(Single Only, Dblg.)

IF NOT SINGLE RESIDENCE DESCRIBE _____

THE SYSTEM INSTALLED UNDER THIS APPLICATION IS ACCEPTABLE ONLY UNTIL PUBLIC FACILITIES BECOME AVAILABLE.

SIGNATURE OF APPLICANT Greg Martin


APPROVED BY _____ FOR _____ DATE _____
(KIND OF SYSTEM)

REJECTED BY _____ FOR _____ DATE _____
(KIND OF SYSTEM)

HOLD PENDING FURTHER TESTS _____ DATE _____

REASONS FOR REJECTION OR HOLDING _____

Wheel 1 to 40 now closed
 Old road

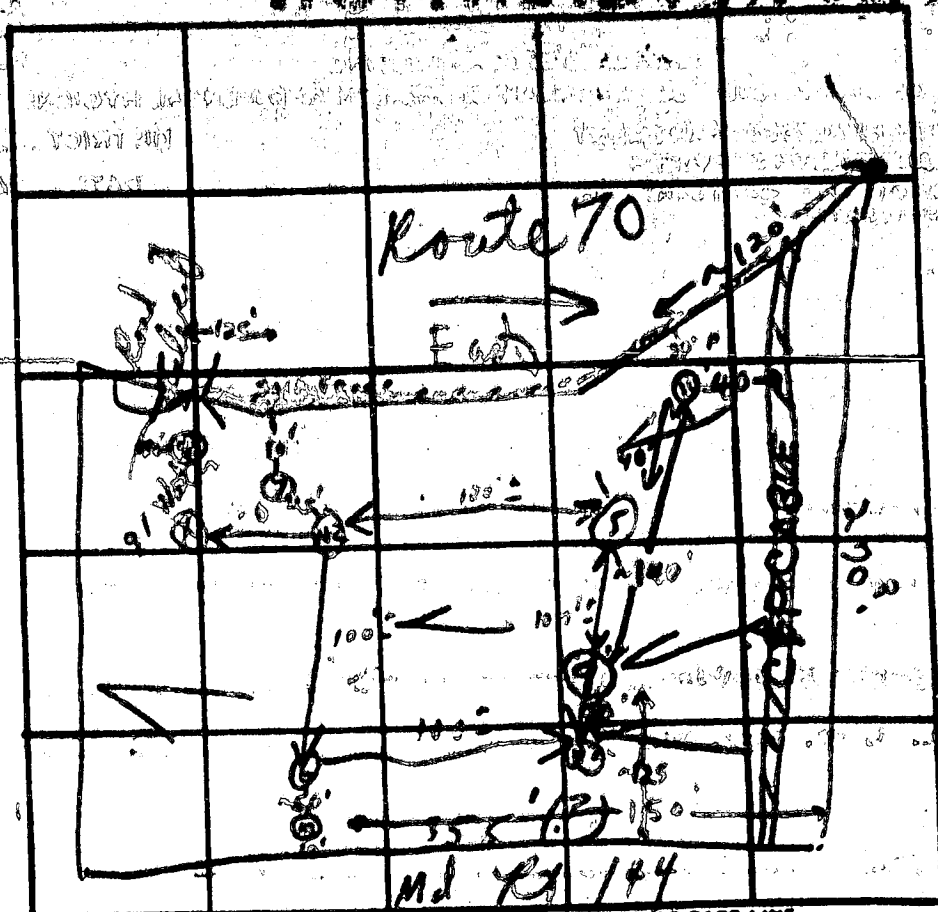

143 1/2

DATE	TEST NO.	DEPTH	PRE-WET		TEST - 1" DROP		TIME
			START	STOP	START	STOP	
7/1/73	1	3 1/2'	9:52	9:54	9:54	9:57	3 min
	2	11'	9:51	9:53	9:53	9:56	3 min
	3	3 1/2'	9:45	9:47	9:49	9:50	3 min
use	4	11 1/2'	9:46	9:48	9:49	9:50	3 min
→	5	8'	Visual	Visual	Visual	Visual	3 min
	6	10'	Visual	Visual	Visual	Visual	3 min
8/5	7	4'	10:06	10:06	10:06	10:06	3 min
10/7/77	7A	11 1/2'	10:06	10:06	10:06	10:06	3 min
	8	11'	10:06	10:06	10:06	10:06	3 min
Edward Schilling	9	13'	12:04	12:09	12:09	12:10	1 min
H. T. Co. 70-1	9A	14 1/2'	10:40	11:13	11:13	11:13	19 min
H. T. Co. 70-1	9A	16 1/2'	11:25	11:33	11:33	11:52	19 min
829-2278	7C	9 1/2'	12:21	12:23	12:23	12:26	3 min
	10	7 1/2'	12:21	12:23	12:23	12:26	3 min

8/5
 Edward Schilling
 H. T. Co. 70-1
 H. T. Co. 70-1
 829-2278

OK
 OK
 OK

TOO FAST FALL
 Claystone
 shale


REMARKS 7/2/73 Hold for certification of hole + loc.

J. J. [Signature]
HEALTH OFFICER

4-14-78
DATE



I 70 N

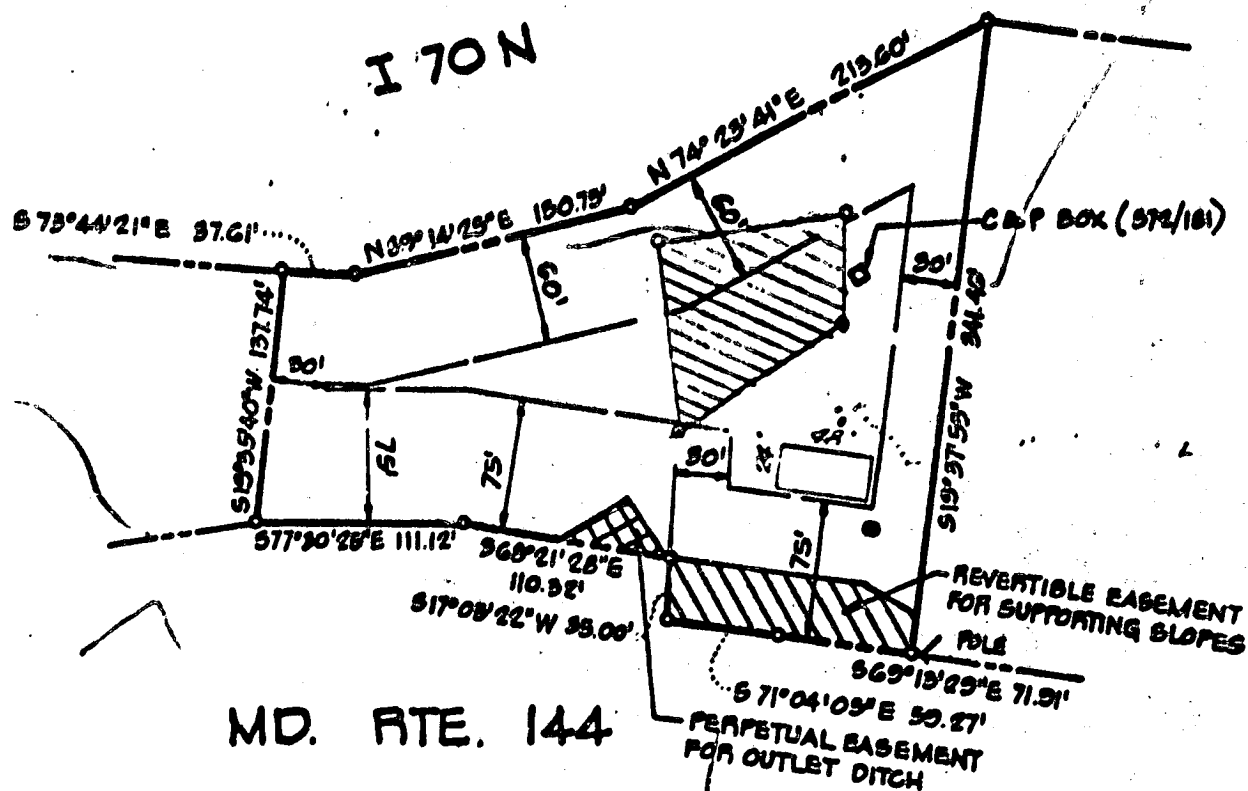

1. THE LOT SHOWN HEREON COMPLIES WITH THE MINIMUM OWNERSHIP WIDTH AND LOT AREAS AS REQUIRED BY THE MARYLAND STATE DEPARTMENT OF HEALTH AND MENTAL HYGIENE.
2. ALL PERCOLATION TEST HOLES HAVE BEEN FIELD LOCATED
3. BEFORE ANY CONSTRUCTION IS BEGUN, NOTIFY THE C.S.P TELEPHONE