

5/4/98
ASD

PERMIT

SEWAGE DISPOSAL SYSTEM

DEPARTMENT OF HEALTH AND MENTAL HYGIENE

HOWARD COUNTY HEALTH DEPARTMENT

BUREAU OF ENVIRONMENTAL HEALTH

~~461-9933~~ 410-313-2640

03-291502
INDEXED

P 513699

A REPAIR

DISTRICT _____

DATE _____

DATE SYSTEM APPROVED 5/4/98

INSPECTOR M. Ripkin

Jack Fyock Septic Service

IS PERMITTED TO INSTALL _____ ALTER X

ADDRESS 13775 Triadelphia Rd, Glenelg, MD 21737 PHONE 410-988-9270

SUBDIVISION J. L. Miller Prop. LOT 1 ROAD 631 River Road

PROPERTY OWNER Paul & Janet Sabine

ADDRESS 631 River Road, Sykesville, Maryland 21784

SEPTIC TANK CAPACITY _____ GALLONS

NUMBER OF BEDROOMS 3

125 SQUARE FEET PER BEDROOM

LINEAR FEET OF TRENCH REQUIRED 165

REPAIR - PURPOSE - SEPTIC SYSTEM HAS FAILED.

Call for an inspection when the ground is opened so a sanitarian can recommend repairs.
5-1-98.

7' NIV 3' BOT 9'

PLANS APPROVED BY _____ DATE _____

COVER NO WORK UNTIL INSPECTED AND APPROVED

NEITHER THE HOWARD COUNTY COUNCIL NOR THE HEALTH DEPARTMENT IS RESPONSIBLE FOR THE SUCCESSFUL OPERATION OF ANY SYSTEM

NOTE: CLEANOUT REQUIRED EVERY 70 FEET OF SEWER LINE AND/OR AT 90° SWEEPS IN LINES FROM HOUSE TO DRAIN FIELDS, 90° ELBOWS NOT ACCEPTABLE.

NOTE: ALL PARTS OF SEPTIC SYSTEMS (I.E. TANK, DISTRIBUTION BOX TRENCHES) TO BE 100 FEET FROM DWELLINGS OTHERWISE SPECIFICALLY AUTHORIZED)

NOTE: IF DEEP TRENCH(ES) ARE USED CALL FOR INSPECTION BEFORE AND AFTER PLACING GRAVEL IN TRENCH(ES) 2/6/03 B00140236 GARAGE/POLE BARN

NOTE: NO DRY WELL SHALL EXCEED 15 FOOT IN DIAMETER NO ABSORPTION TRENCH TO EXCEED 100 FEET IN LENGTH

NOTE: ALL PIPE FROM HOUSE TO SEPTIC TANK MUST BE CAST IRON OR SCHEDULE 35/40 PVC OR ABS

PERMIT VOID AFTER TWO YEARS


NOTE: INSTALL STAND PIPE ON SEPTIC TANK AND DRY WELL STAND PIPES MUST BE 6 INCHES IN DIAMETER CAST IRON. CONCRETE OR TERRA COTTA OR PVA OR ABS ACCEPTED. IF TOP OF SEPTIC TANK IS DEEPER THAN 3 FEET. MANHOLE TO GRADE REQUIRED.

NOTE: DISTRIBUTION BOXES MUST HAVE BAFFLES

***INSTALLER IS RESPONSIBLE FOR OBTAINING FINAL APPROVAL ON THIS PERMIT**

**BUILDING PERMIT SIGNED
AND RETURNED**

A
513699

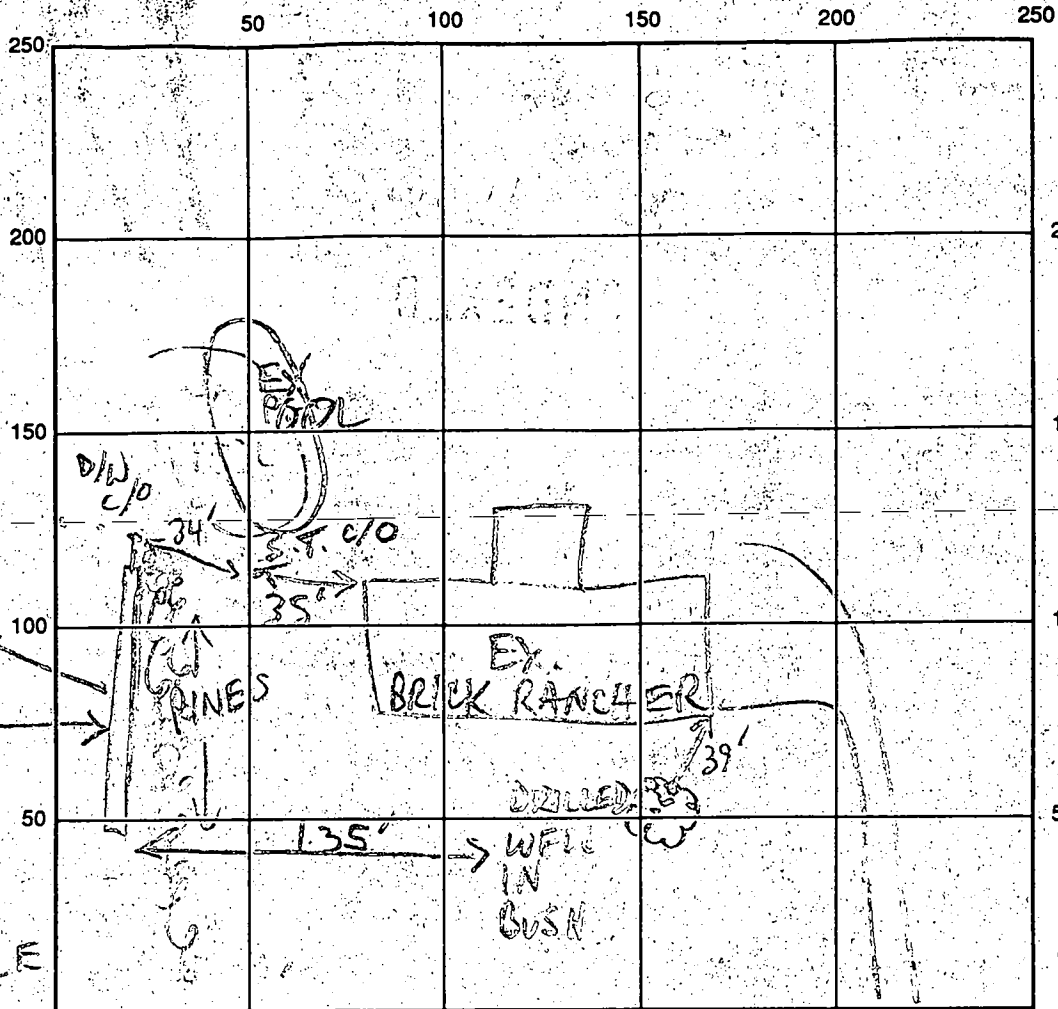

REPAIR TRENCH
brn clay 1m
brn gray sa 1m
25-30% sandstone & other frags

INDICATE NORTH - NAME ADJOINING ROADWAY AS BASE LINE
(CONCRETE)

SEPTIC TANK LEVEL EX. 750 GAL CLEANOUTS EX ON S.T. & DW

DISTRIBUTION BOX LEVEL —

DRAIN FIELD/TITLE DEPTH 8-9 FT. TRENCH WIDTH 2 FT. INLET DEPTH 3 FT.

EFFECTIVE GRAVEL DEPTH 5-6 FT. TOTAL LENGTH 65 FT.

NUMBER OF TRENCHES 1 ONE SIDEWALL/BOTTOM AREA 350± SQ. FT.

DRYWALL INSIDE DIAMETER — FT. EFFECTIVE DEPTH BELOW INLET — FT.

ABSORBENT AREA 350 SQ. FT.

REMARKS: 5/4/98 REVISED INSTALLER TO CONSIDER ADJ. WELLS
WHEN INSTALLING REPAIRS. CONTINUE (MR)
5/4/98 OK TO COVER (MR)

DATE SYSTEM APPROVED 5/4/98

INSPECTOR M. R. P. in



HOWARD COUNTY HEALTH DEPARTMENT

Bureau of Environmental Health
3525-H Ellicott Mills Drive, Ellicott City, Maryland 21043-4544
(410) 313-2640 Fax (410) 313-2648
TDD (410) 313-2323 Toll Free 1-877-4MD-DHMH

Penny E. Borenstein, M.D., M.P.H., Howard County Health Officer

August 30, 2002

Resolved (SRK)

Paul Sabine
631 River Road
Sykesville, MD 21784

RE: **Replacement Well Issues**
631 River Road
Well Permit #: HO-94-3448

Dear Mr. Allen:

This office is requesting that you contact the Community Environmental Health Program at (410) 313-1773 to schedule an initial water sampling for the referenced replacement well, as required by the Maryland Well Construction Regulation (COMAR 26.04.04).

It is preferred that the sample be collected from the indoor primary drinking tap, but if suitable scheduling is not possible, the sample may be taken from an outside tap to complete your sampling obligation. However, the potential for unsuccessful sample results increases when samples are collected from taps exposed to the outside environment.

Additionally, a condition of the well drilling permit was the proper abandonment and sealing of the existing well. This abandonment process is important to restore the subsurface geologic conditions, which existed before the well was drilled and to help protect the groundwater resource from potential contamination. This should be completed as soon as possible to avoid delays in the issuance of potability certification and any future permit approval requests for this property.

The well abandonment process is best accomplished by a licensed well driller, who may perform the work without inspection; however, the driller must then file an abandonment report with this office. **If this well abandonment is performed by any other party, the materials and procedures must be inspected and approved by a sanitarian from this office before any work is initiated.**

Failure to confirm the potability of this well water supply by completion of water sampling requirements or not complying with an abandonment schedule could result in the issuance of an order to abandon and seal the replacement well in accordance with COMAR 26.04.04.



HOWARD COUNTY HEALTH DEPARTMENT

Bureau of Environmental Health
3525-H Ellicott Mills Drive, Ellicott City, Maryland 21043-4544

(410) 313-2640 Fax (410) 313-2648

TDD (410) 313-2323 Toll Free 1-877-4MD-DHMH

Penny E. Borenstein, M.D., M.P.H., Howard County Health Officer

The sampling is free of charge, and if you have any questions, or would like to discuss this matter further, please call me at (410) 313-1771. Thank you for your attention to these important matters.

Sincerely,

A handwritten signature in cursive script that reads 'Mark E. Rifkin'.

Mark E. Rifkin, R.S.
Well and Septic Program

cc: Community Environmental Health Program
File

HOWARD COUNTY HEALTH DEPARTMENT
BUREAU OF ENVIRONMENTAL HEALTH
WATER AND SEWERAGE PROGRAM
TEL: (410)313-2640 FAX: (410)313-2648

Information Form for the Installation of the Well Pump, Pitless Adapter, and Supply Piping

NOTE: The installer is responsible for requesting an inspection prior to 9 am on the day of the desired inspection. No work is to be covered until approved by the Health Department. All installations must comply with the National Standard Plumbing Code (NSPC, as amended locally) and COMAR 26.04.04 (MD Well Construction Regulations). Submission of a complete form is required prior to Use and Occupancy approval.

Company Name: L. FRANKLIN EASTERDAY Telephone #: _____
Address: _____

(Must circle one) Licensed Plumber Licensed Well Driller Licensed Well Pump Installer

License # and name of individual responsible for the field installation:

Name (Print): _____ License# _____

***A licensed individual must perform the actual installation. Apprentices must be under the direct supervision of a licensed journeyman or master plumber, pump installer or well driller. Licenses may be subjected to field verification.**

Name of Property Owner: PAUL SABINE Telephone #: _____
Subdivision: _____ Lot #: _____ Well Tag #: HO - 94 3448
Site Address: 1031 RIVER ROAD

Submersible Pump Data

Make: _____
Model #: _____
Pump Capacity _____ GPM
Well Yield: _____ GPM

Pitless Adapter

Make: _____
Model #: _____
Depth: _____ (36" min)
NSF approved: _____

Well Cap and Electric Conduit

Two piece watertight cap: _____
Screened, vented well cap: _____
Cap secured to casing: _____
Conduit min 18" B.G.: _____
Conduit secured to well cap: _____

Depth of well encountered at time of pump installation: _____ (feet)
If pump capacity exceeds well yield, a low water cut off switch is required by NSPC 1990 Section 17.8.4
Torque arrestors or Cable guards are required - Must circle one
Safety rope, if used, attached to inside of well casing with eye bolt _____

Piping to house

Type: _____
PSI: _____ (160 psi min)
Depth of supply line: _____ (36" min)

House Connection

PVC sleeved to undisturbed soil at wall penetration: _____
Approximate length of sleeve: _____
Sleeve caulked and sealed properly: _____

The water supply line is required to be at least ten feet from the septic tank, pump chamber, sewage piping, distribution box, drainfields, and sewage reserve area. If this cannot be accomplished, contact this office for approval prior to installation.

Signature of company representative responsible for installation _____ date _____

For Health Department Use Only - Not to be completed by Installer

Date Insp. Requested: 7/30/02 9:10am Date Insp. Approved: 7/30/02
Inspection Data: Pitless adapter and water supply line at least 36" below grade _____
Two piece cap installed and attached to casing securely _____
Elec. conduit extends at least 18" below grade/attached to cap properly _____
Safety rope installed inside of well casing _____
Correct well tag attached properly and casing 8" above finished grade _____
Water supply line sleeved adequately at house connection _____
Adequate grout observed below pitless adapter _____

No tag } 7/30/02
SO

C109879

SEQUENCE NO.
(MDE USE ONLY)

STATE OF MARYLAND
WELL COMPLETION REPORT
FILL IN THIS FORM COMPLETELY
PLEASE TYPE

THIS REPORT MUST BE SUBMITTED AFTER
WELL IS COMPLETED.
COUNTY
NUMBER1714706

ST/CO USE ONLY
DATE Received
08 28 02

DATE WELL COMPLETED
1/25/02

Depth of Well
22 200 26
(TO NEAREST FOOT)

PERMIT NO.
FROM "PERMIT TO DRILL WELL"
110-941-3448

OWNERsabine Paul

STREET OR RFD631 River Rd

TOWNSYKESVILLE

SUBDIVISIONSECTIONLOT

WELL LOG		
Not required for driven wells		
STATE THE KIND OF FORMATIONS PENETRATED, THEIR COLOR, DEPTH, THICKNESS AND IF WATER BEARING		
DESCRIPTION (Use additional sheets if needed)	FEET	check if water bearing
	FROM	TO
Top Soil	0	2
Brown Shale	2	15
Sand Stone	15	30
Gray Micr	30	65
opening Gravel Bed	65	67
Gray Micr	67	100
Brown Micr	100	101
Gray Micr	101	110
Brown Micr	110	111
Gray Micr	111	200

GROUTING RECORD

WELL HAS BEEN GROUTED
(Circle Appropriate Box)
yes (Y) no (N)
44 44

TYPE OF GROUTING MATERIAL (Circle one)
CEMENT (CM) BENTONITE CLAY (BC)
NO. OF BAGS 48 NO. OF POUNDS 4800
GALLONS OF WATER 288
DEPTH OF GROUT SEAL (to nearest foot) 40
from 48 TOP 52 ft. to 54 BOTTOM 58 ft.
(enter 0 if from surface)

CASING RECORD

casing types insert appropriate code below
ST STEEL CO CONCRETE
PL PLASTIC OT OTHER
MAIN CASING TYPE ST Nominal diameter top (main) casing (nearest inch) 6 Total depth of main casing (nearest foot) 72
60 61 63 64 66 70

OTHER CASING (if used)
EACH CASING diameter inch depth (feet) from to

SCREEN RECORD

screen type or open hole insert appropriate code below
ST STEEL BR BRASS HO OPEN HOLE
PL PLASTIC OT OTHER

C3

PUMPING TEST

HOURS PUMPED (nearest hour) 3
8 9

PUMPING RATE (gal. per min.) 20
11 15

METHOD USED TO MEASURE PUMPING RATE Bucket

WATER LEVEL (distance from land surface)
BEFORE PUMPING 50 ft.
17 20
WHEN PUMPING 200 ft.
22 25

TYPE OF PUMP USED (for test)
A air P piston T turbine
C centrifugal R rotary O other (describe below)
J jet S submersible

PUMP INSTALLED

DRILLER INSTALLED PUMP YES (NO)
(CIRCLE) (YES OR NO)

IF DRILLER INSTALLS PUMP, THIS SECTION MUST BE COMPLETED FOR ALL WELLS.

TYPE OF PUMP INSTALLED PLACE (A,C,J,P,R,S,T,O) IN BOX 29

CAPACITY: GALLONS PER MINUTE (to nearest gallon) 31 35

PUMP HORSE POWER 37 41

PUMP COLUMN LENGTH (nearest ft.) 43 47

CASING HEIGHT (circle appropriate box and enter casing height)
+ above LAND SURFACE
- below 2 (nearest foot)
49 50 51

NUMBER OF UNSUCCESSFUL WELLS: 0

WELL HYDROFRACTURED yes (Y) no (N)

CIRCLE APPROPRIATE LETTER
A A WELL WAS ABANDONED AND SEALED WHEN THIS WELL WAS COMPLETED
E ELECTRIC LOG OBTAINED
P TEST WELL CONVERTED TO PRODUCTION WELL

I HEREBY CERTIFY THAT THIS WELL HAS BEEN CONSTRUCTED IN ACCORDANCE WITH COMAR 26.04.4 "WELL CONSTRUCTION" AND IN CONFORMANCE WITH ALL CONDITIONS STATED IN THE ABOVE CAPTIONED PERMIT, AND THAT THE INFORMATION PRESENTED HEREIN IS ACCURATE AND COMPLETE TO THE BEST OF MY KNOWLEDGE.

DRILLERS LIC. NO. 1 MW D 040
George F. Eustenlang
DRILLERS SIGNATURE
(MUST MATCH SIGNATURE ON APPLICATION)
LIC. NO. 1 JS D 038
Bruce Thompson

SITE SUPERVISOR (sign. of driller or journeyman responsible for sitework if different from permittee)

C2


DEPTH (nearest ft.)
1 2 HO 70 200
E 8 9 11 15 17 21
A 23 24 26 30 32 36
C 38 39 41 45 47 51
S
R
E
N

SLOT SIZE 1 2 3

DIAMETER OF SCREEN (NEAREST INCH)
56 60
from to

GRAVEL PACK IF WELL DRILLED WAS FLOWING WELL INSERT F IN BOX 68

MDE USE ONLY (NOT TO BE FILLED IN BY DRILLER)
T (E.R.O.S.) W Q
70 72 74 75 76
TELESCOPE CASING LOG INDICATOR OTHER DATA

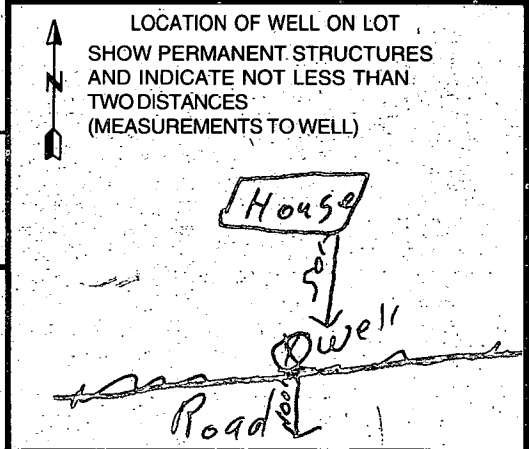

B 1 2198		SEQUENCE NO. (MDE USE ONLY)		STATE OF MARYLAND APPLICATION FOR PERMIT TO DRILL WELL please type		STATE PERMIT NUMBER H0-94-3448	
Date Received (APA) 072602				OWNER INFORMATION 9105			
8 MM DD YY 13 SABINE PAUL				LOCATION OF WELL B 3 Howard			
15 Last Name Owner First Name 34 631 RIVER RD				8 COUNTY 21 J.L. Miller			
36 Street or RFD 55 SYKESVILLE, MD 21784				23 SUBDIVISION 42 Sykesville			
57 Town 70 State 72 Zip 76 				SECTION 44 46 LOT 48 50 			
DRILLER INFORMATION George F. Easterday				52 NEAREST TOWN 71 			
Driller's Name 76 License No. 81 L. Franklin Easterday, Inc.				MILES FROM TOWN (enter 0 if in town) 73 76 77 78 2			
Firm Name 9265 Brown Church Rd., MT. Airy, Md. 21771				B 4 1 2 DIRECTION OF WELL FROM TOWN (CIRCLE BOX) 			
Address George F. Easterday				631 River Rd 11 NEAR WHAT ROAD 30 			
Signature Date 7/24/2002				ON WHICH SIDE OF ROAD (CIRCLE APPROPRIATE BOX) 			
B 2 WELL INFORMATION APPROX. PUMPING RATE (GAL. PER MIN.) 8 12 5				DISTANCE FROM ROAD Ft. 34 50 37 ENTER FT OR MI 38 39 4			
AVERAGE DAILY QUANTITY NEEDED (GAL PER DAY) 14 20 500				TAX MAP: 4 BLK: 23 PARCEL: 98			
USE FOR WATER (CIRCLE APPROPRIATE BOX) ☒ DOMESTIC POTABLE SUPPLY & RESIDENTIAL IRRIGATION ☐ FARMING (LIVESTOCK WATERING & AGRICULTURAL IRRIGATION) ☐ INDUSTRIAL, COMMERCIAL, DEWATERING ☐ PUBLIC WATER SUPPLY WELL ☐ TEST, OBSERVATION, MONITORING ☐ GEO-THERMAL				NOT TO BE FILLED IN BY DRILLER HEALTH DEPARTMENT APPROVAL HOWARD			
22				COUNTY NAME A14076			
STATE SIGNATURE 072502				DATE ISSUED 7/25/03			
NORTH GRID 50 55 554				CO SIGNATURE 0814			
EAST GRID 57 63 000				EXP. DATE 000			
APPROXIMATE DEPTH OF WELL 24 28 300 FEET				SHOW MAJOR FEATURES OF BOX & LOCATE WELL WITH AN X 			
APPROXIMATE DIAMETER OF WELL 6 INCH 				SOURCES OF DRILLING WATER 1. wells 2. 3.			
METHOD OF DRILLING (circle one) BORED (or Augered) JETTED Jetted & DRIVEN ☒ AIR-ROTARY ☐ AIR-PERCUSION ☐ ROTARY (Hydraulic Rotary) ☐ CABLE ☐ REVERSE-ROTARY ☐ DRIVE-POINT other				WRITE THE BOX NUMBER FROM THE MAP HERE 554			
REPLACEMENT OR DEEPEMED WELLS (CIRCLE APPROPRIATE BOX) ☐ THIS WELL WILL NOT REPLACE AN EXISTING WELL ☒ THIS WELL WILL REPLACE A WELL THAT WILL BE ABANDONED AND SEALED ☐ THIS WELL WILL REPLACE A WELL THAT WILL BE USED AS A STANDBY-CONTACT LOCAL APPROVING AUTHORITY FOR POLICY ON STANDBY WELLS ☐ THIS WELL WILL DEEPEM AN EXISTING WELL PERMIT NUMBER OF WELL TO BE REPLACED OR DEEPEMED (IF AVAILABLE) 41 52				DRAW A SKETCH BELOW SHOWING LOCATION OF WELL IN RELATION TO NEARBY TOWNS AND ROADS AND GIVE DISTANCE FROM WELL TO NEAREST ROAD JUNCTION 506			
Not to be filled in by driller (MDE OR COUNTY USE ONLY) APPROP. PERMIT NUMBER G				PERMIT No. H0-94-3448			
SPECIAL CONDITIONS NOTE: APPROVING AUTHORITIES SHOULD USE SEPARATE SHEET IF NEEDED							

SITE INSPECTION SHEET

OWNER: Sabine

DATE REQUESTED: _____

PHONE #: _____

CONTRACTOR: Easterday


ADDRESS: _____

WELL TAG #: 94-3448

COUNTY #: _____

PROPOSAL: repl. well requested via T/c Dry well

LOCATION DIAGRAM

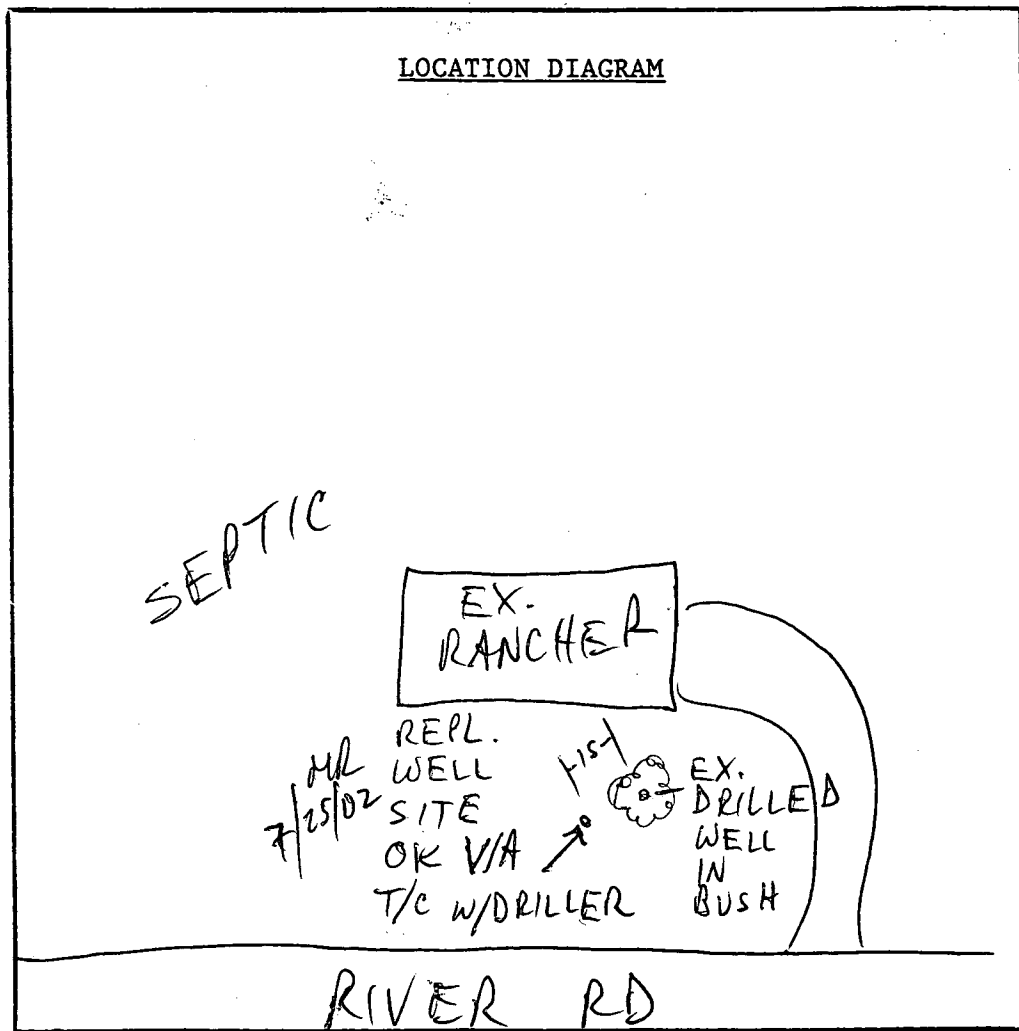

COMMENTS: _____

DATE: _____

INSPECTOR: _____

MARYLAND DEPARTMENT OF THE ENVIRONMENT, WATER MANAGEMENT ADMINISTRATION
2500 BROENING HIGHWAY, BALTIMORE, MARYLAND 21224, (410) 631-3784

WATER WELL ABANDONMENT-SEALING REPORT FORM

SUBMIT COPIES OF COMPLETED FORM TO:

- * COUNTY ENVIRONMENT AGENCY (contact MDE, WMA if address needed)
- * WELL OWNER
- * MDE, WATER MANAGEMENT ADMINISTRATION, WELL PROGRAM

DATE WELL ABANDONED: 11/29/02 (month/day/year)

* PERMIT NUMBER OF ABANDONED WELL (if any) _____

* PERMIT NUMBER OF REPLACEMENT WELL _____


* PERSON ABANDONING WELL: Richard A. Crummitt WELL DRILLERS LICENSE NUMBER: WLD 014

CIRCLE: MWD/MSD/MGD

* OWNER'S NAME: PAUL SABINE

SITE LOCATION MAP

* WELL LOCATION:
COUNTY: Howard
NEAREST TOWN: SYKESVILLE
TAX MAP _____ BLOCK _____ PARCEL _____
SUBDIVISION: _____
SECTION: _____ LOT: _____
NEAREST ROAD: 631 RIVER RD

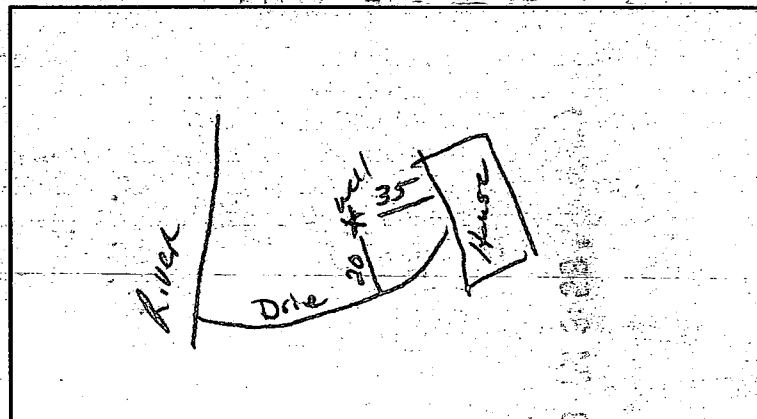

* TYPE OF WELL BEING ABANDONED:

☒ DRILLED ☐ JETTED
☐ BORED/AUGERED ☐ HAND DUG
☐ OTHER (specify) _____

* USE CODE:

☒ DOMESTIC ☐ MUNICIPAL/PUBLIC
☐ IRRIGATION ☐ INDUSTRIAL
☐ TEST/OBSERVATION ☐ GEOTHERMAL

* TYPE OF CASING:

☒ STEEL ☐ PLASTIC
☐ CONCRETE ☐ OTHER (specify) _____

* SIZE OF CASING: 6 INCHES IN DIAMETER

* DEPTH OF WELL: 54 FEET DEEP

* WAS ANY CASING REMOVED? ☐ YES ☒ NO
if yes, length removed, in feet: 3

* WAS CASING RIPPED OR PERFORATED? ☐ YES ☒ NO

SIGNATURE-MASTER WELL DRILLER OR SUPERVISING SANITARIAN George F. Eastman

LICENSE # 1240

CIRCLE ONE MWD/MSD/MGD

DATE 12-17-02

LOG OF SEALING MATERIAL

MATERIAL	FEET	
	FROM	TO
Bentonite	54	1
Grout	1	0
VOLUME OF MATERIAL USED		
5 Bags Bentonite		

12/5/69 approved by JTG

PERMIT

SEWAGE DISPOSAL SYSTEM

MARYLAND STATE DEPARTMENT OF HEALTH

HOWARD COUNTY

ELLICOTT CITY

DISTRICT 3

INDEXED

DA. 11/13/68

Herman Rife

IS PERMITTED TO INSTALL X ALTER

ADDRESS Annapolia Rock Road, Woodbine, Md.

PHONE 489-4724

A SEWAGE DISPOSAL SYSTEM LOCATED AT

SUBDIVISION

ROAD

631 River Rd. Aykerville Lot

approx. 2 mi. east of Rt. 32

PROPERTY OWNER

Marion M. Miller, Jr. & wife
Mr. Paul & Janet Sabine

ADDRESS

SPECIFICATIONS 2 houses - 3 bedrooms in each

DRAIN FIELD _____ DEPTH _____ FEET, BOTTOM AREA _____ SQ. FT.

SEEPAGE PITS _____ ABSORBENT SIDE-WALL AREA _____ SQ. FT.

SEPTIC TANK CAPACITY 750 GALLONS for each house.

FOR GARBAGE GRINDER, INCREASE DISPOSAL AREA 22% & TANK CAPACITY 50%.

OTHER Dry wells for bath houses to be 300 sq. ft. of absorbent sidewall area

below the inlet pipe. House No. 1 locate dry well 294 ft. from right side line

and 73 ft. from rear lot line with a maximum depth of 12 ft. Inlet pipe to be

3' below original grade. House No. 2 locate dry well 60 ft. from left side line

and 81 ft. from rear lot line as bath house sites are seen from facing lot standing
on River Road. NOTE: ALL PIPE FROM HOUSE TO SEPTIC TANK MUST BE CAST IRON.

FORN By Paul & Janet Sabine DATE 11/13/68

PERMIT VOID AFTER THREE YEARS.


FILL SEPTIC TANK AND DISTRIBUTION BOX WITH WATER BEFORE CALLING FOR AN INSPECTION. COVER NO WORK UNTIL INSPECTED AND APPROVED.

NEITHER THE HOWARD COUNTY COMMISSIONERS NOR THE HEALTH DEPARTMENT IS RESPONSIBLE FOR THE SUCCESSFUL OPERATION OF ANY SYSTEM.

LOG. PERMIT SIGNED
AND RETURNED

Serial # 70184 Prod

NOTIFY THE HEALTH DEPARTMENT 48 HOURS BEFORE EXCAVATIONS ARE TO BE BACK FILLED.

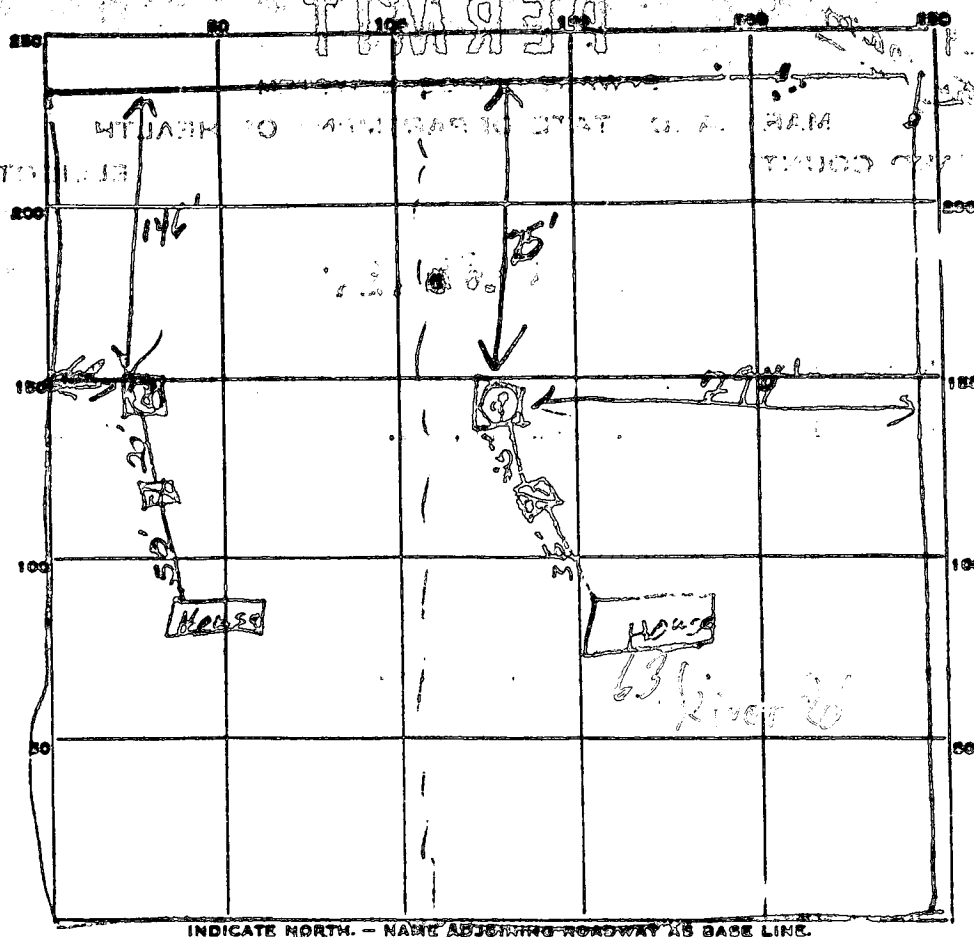

PERMIT CARD

SEPTIC TANK, LEVEL

CLEANOUTS

DISTRIBUTION BOX, LEVEL

TILE FIELD, DEPTH

-FT. TRENCH WIDTH

GRAVEL DEPTH.

TOTAL LENGTH

NUMBER OF TRENCHES

TOTAL BOTTOM AREA

SEEPAGE PITS, INSIDE DIAMETER

FT.

DEPTH BELOW INLET 1-9 FT.

ABSORBENT AREA

-99. FT.

REMARKS

DATE SYSTEM APPROVED

INSPECTOR

APPLICATION

SEWAGE DISPOSAL TESTING

A 14074

P

MARYLAND STATE DEPARTMENT OF HEALTH

HOWARD COUNTY

Septic tanks for House 1-2 750 ELLICOTT CITY

DISTRICT 3

DATE 11/13/68

Dry septic for path houses to be 30 ft

ft of (discharge) side wall area below the inlet pipe

House NO 1 ~~Septic~~ Well 184 ft from Right side line and 36 ft from

near lat line with to 10 ft from - 12 ft

House NO 2 locate by Well 60 ft from left side line and 35 ft from near lat line

As path house sites are seen from facing lot standing on River Road.

TO: THE COUNTY HEALTH OFFICER
ELLICOTT CITY, MARYLAND

I, HEREBY, APPLY FOR THE NECESSARY TESTS IN ORDER TO CONSTRUCT (OR RECONSTRUCT) A SEWAGE DISPOSAL SYSTEM.

PROPERTY OWNER Maurice M. Miller, Jr. & Wife, Janet L.

ADDRESS 423-G Town & Country Blvd., Ellicott City PHONE 465-4901

PROPERTY LOCATION:

SUBDIVISION _____ LOT NO. _____

ROAD AND DESCRIPTION River Rd., Sykesville - approx. 2 mi. east of Rt. 32

OCCUPANT _____ PHONE _____

PERSON TO CONSTRUCT SYSTEM _____

ADDRESS _____ PHONE _____

SIZE OF LOT 5.0 acres TYPE BLDG. 2 houses

3 in one house

2 in other house

IF NOT SINGLE RESIDENCE DESCRIBE _____

(2 separate septic systems
to be installed)

SIGNATURE OF APPLICANT Maurice M. Miller, Jr.


APPROVED BY James T. Whit FOR Dep. Sec. DATE 11/13/68

REJECTED BY _____ FOR _____ DATE _____

HOLD PENDING FURTHER TESTS _____ DATE _____

REASONS FOR REJECTION OR HOLDING _____

THIS IS NOT A PERMIT

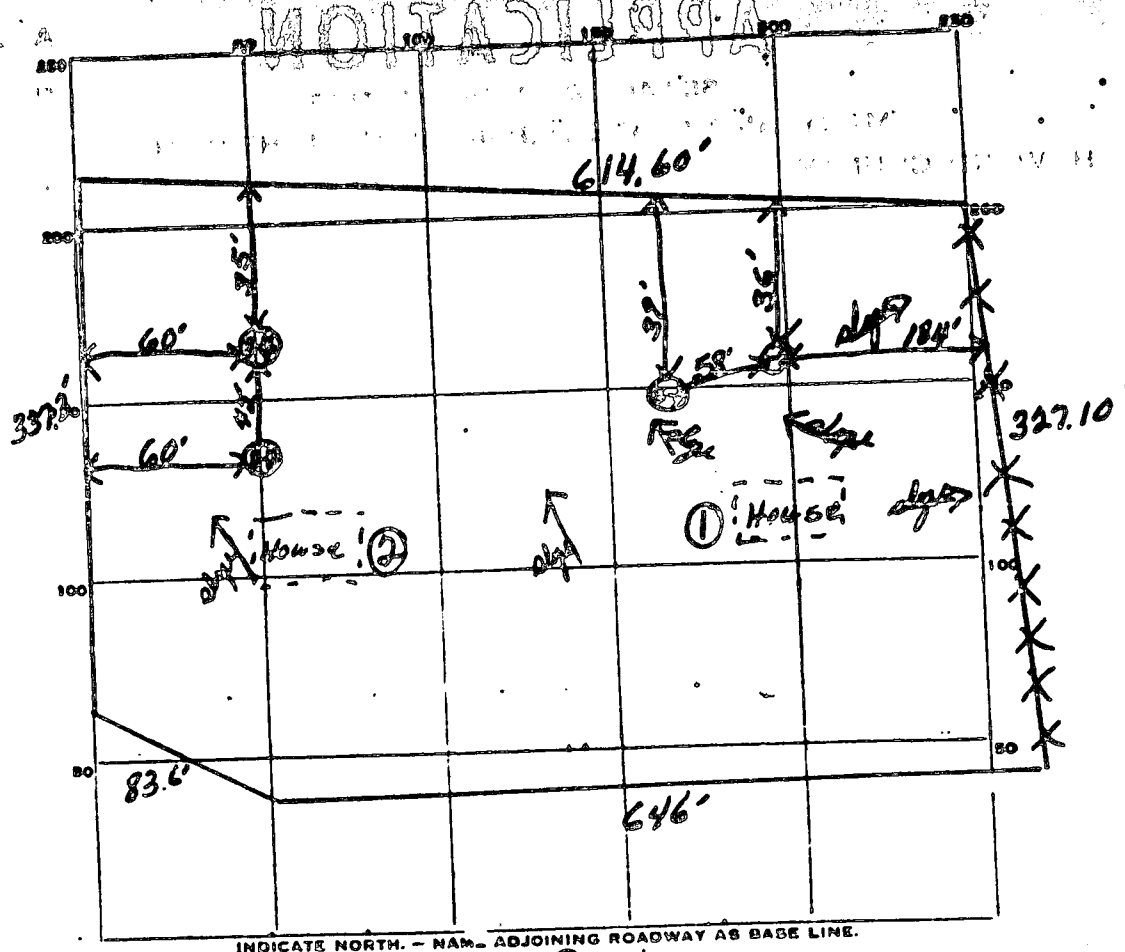

Rolling Road

DATE	TEST NO.	DEPTH	PRE-WET		TEST - 1" DROP		TIME
			START	STOP	START	STOP	
11/13/68	1	10 1/2'	11 36	11 39	11 39	11 44	5 min
	2	4'	11 37	11 39	11 39	11 43	4 min
	3	10 1/2'	12 06	12 09	12 09	12 13	4 min
	4	4'	12 10	12 11	12 11	12 13	2 min
	1	10'	11 59	12 00	12 00	12 02	2 min
	2	4'	1 15	1 20	1 20	1 25	5 min
	3	12 1/2'	1 36	1 37	1 37	1 39	2 min
	4	4 1/2'	1 39	1 43	1 43	1 48	5 min

15

4 min AV


14

4 min AV

SOIL AUGER FINDING Rock & sand X Fence

TESTED BY J. Taylor

REMARKS

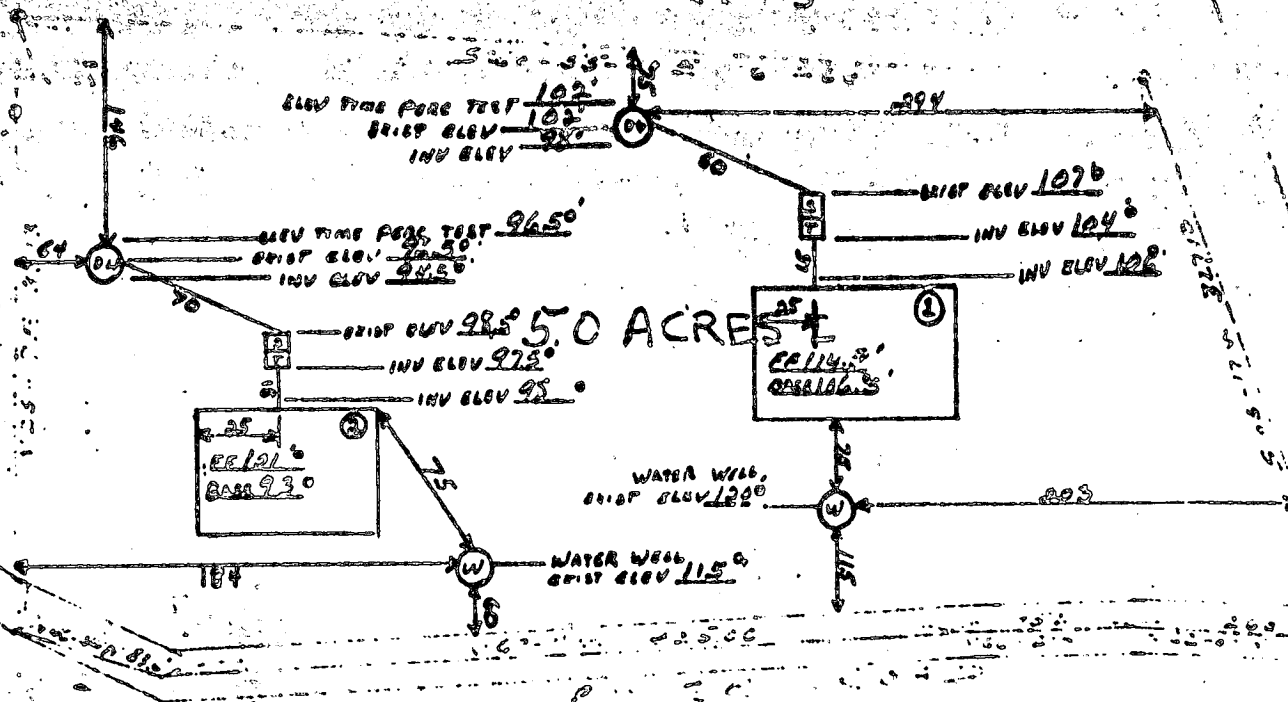

Part of the Sec. 12, T. 1, R. 1, S. 1.

3/4 Sec. 12, T. 1, R. 1, S. 1.

5.0 ACRES

I CERTIFY THE ABOVE MEASUREMENTS AND CALCULATIONS
 ARE CORRECT AND ACCURATE FOR THIS PROPERTY

Robert M. Morris

22 MAY 1969

Scale: 1" = 100.0 Feet

Robert C. Morris, Reg. Surveyor
 1012 Court Road, State, N.C.

DATE RECEIVED

DATE WELL COMPLETED

WELL COMPLETION REPORT

DEPTH OF WELL

FILL IN THE SPACES COMPLETELY

PERMIT NO. FROM STATE OF ILL. 44-94-00220

DRILLER'S IDENTIFICATION NO. 238

OWNER MILLER, J. H.

LAST NAME

MAURICE

FIRST NAME

CITY OR TOWN

POST OFFICE

CITY

WELL LOG

WELL DESCRIPTION

THE KIND OF FORMATIONS PENETRATED, THEIR DEPTH, THICKNESS AND IF WATER BEARING

DESCRIPTION OF ADDITIONAL OBSERVATIONS IF NECESSARY

FEET

FROM

TO

GROUTING RECORD

WELL HAS BEEN GROUTED (CIRCLE APPROPRIATE BOX)

DEPTH OF GROUT SEAL (TO NEAREST FOOT)

FROM 40 TO 54 FT. TO 58 FT.

ENTER 0 IF FROM SURFACE

CASING RECORD

CASING TYPE

IDENTIFY

APPROPRIATE CODE BELOW

STEEL

CONCRETE

PLASTIC

OTHER

MAIN CASING TYPE

NOMINAL DIAMETER TOP (INCH)

TOTAL DEPTH OF MAIN CASING (NEAREST FOOT)

FROM 01 TO 03 TO 04 TO 06 TO 07

OTHER CASING (IF USED)

DIAMETER (INCH)

DEPTH (FEET) FROM TO

EACH CASING

SCREEN RECORD

SCREEN TYPE

IDENTIFY

APPROPRIATE CODE BELOW

STEEL

BRASS OR BRONZE

OPEN HOLE

PLASTIC

OTHER

C 2

DEPTH (NEAREST WHOLE FOOT) FROM TO

EACH CASING

CIRCLE APPROPRIATE BOXES

WELL WAS ABANDONED AND SEALED WHEN THIS REPORT WAS COMPLETED

ELECTRIC LOG OBTAINED

TYPE OF ELECTRIC LOG ATTACHED

I CERTIFY THAT I HAVE COMPLIED WITH ALL REQUIREMENTS OF THE ADVISORY BOARD "DEWITT ACT", AND THAT INFORMATION CONTAINED HEREIN IS TRUE, ACCURATE, AND COMPLETE TO THE BEST OF MY KNOWLEDGE, INFORMATION AND BELIEF

NAME

Joseph H. Hays

Joseph Hays

HEALTH

C 1 5166

(THIS NUMBER IS TO BE FURNISHED IN COLO. B-5 ON ALL CARDS)

DATE RECEIVED
JANUARY 1967

STATE OF MARYLAND
DEPARTMENT OF WATER RESOURCES
WELL COMPLETION REPORT

THIS REPORT MAY BE SUBMITTED
WITHIN 30 DAYS AFTER COMPLETION
OF THE WELL

FILL IN THIS FORM COMPLETELY

DEPTH OF WELL

DATE WELL COMPLETED

28 170 NEAREST FOOT 20

PERMIT NO. FROM PERMIT TO DRILL WELL

MD-70-0000

DRILLER'S IDENTIFICATION NO.

OWNER
M. Miller
LAWYER

STREET OR RFD

POST OFFICE

FIRST NAME

WELL LOG

WELL DESCRIPTION

GROUTING RECORD

WELL HAD BEEN GROUTED
(CIRCLE APPROPRIATE BOX)

DEPTH OF GROUT SEAL (TO NEAREST FOOT)

FROM 40 60 FT. TO 27 60

(ENTER 0 IF FROM SURFACE)

CASING RECORD

CASING TYPE
(CIRCLE APPROPRIATE CODE BELOW)

STEEL

CONCRETE

PLASTIC

OTHER

MAIN CASING TYPE

NOMINAL DIAMETER
TOP MAIN CASING
(NEAREST INCH)

TOTAL DEPTH
OF MAIN CASING
(NEAREST FOOT)

60 61 60 60 60 70

OTHER CASING (IF ANY)

DIAMETER (INCH) DEPTH (FEET)
FROM TO

SCREEN RECORD

SCREEN TYPE
(CIRCLE APPROPRIATE CODE BELOW)

STEEL

BRASS OR BRONZE

OPEN HOLE

PLASTIC

OTHER

C 2

DEPTH (NEAREST WHOLE FOOT)

FROM TO
1 15 17 21
2 27 24 20 30 32 20
3 34 30 41 49 47 31
4 50 54 50 60 62 60

WELL SIZE 1. 2. 3. 4.

IF WELL DRILLED WAS A
FLOODING WELL CIRCLE ONE

ONE USE ONLY (NOT TO BE FILLED IN IF DRILLED)

70 TELESCOPE CASING 72 LOG INDICATED

74 75 76 OTHER DATA AVAILABLE

PUMPING TEST

HOURLY PUMPING (TO NEAREST GALLON)

PUMPING RATE
(GALLONS PER MINUTE TO NEAREST GALLON)

METHOD USED TO
MEASURE PUMPING RATE

WATER LEVEL (IN FEET FROM LAND SURFACE)

BEFORE PUMPING

WHEN PUMPING

TYPE OF PUMP USED (CIRCLE APPROPRIATE ONE)

A

D

T

27

27

27

C

R

O

27

27

27

J

S

27

PUMP INSTALL.

TYPE OF PUMP (WRITE APPROPRIATE LETTER IN
BOX - SEE ABOVE: A, C, J, P, R, D, T, O)

20

CAPACITY:

GALLONS PER MINUTE
(TO NEAREST GALLON)

PUMP HORSE POWER

PUMP COLUMN LENGTH
(NEAREST FOOT)

CASING HEIGHT

(CIRCLE APPROPRIATE ONE
AND ENTER CASING HEIGHT)

+

ABOVE

-


BELOW

LAND SURFACE

NEAREST FOOT

LOCATION OF WELL ON LOT

SHOW PERMANENT STRUCTURE SUCH AS BUILDING,
SEPTIC TANKS, AND/OR OTHER LAND MARKS AND
INDICATE NOT LESS THAN TWO DISTANCES
(MEASUREMENTS TO WELL).

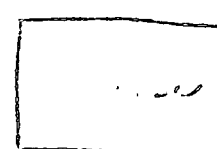

THIS
WELL
BELIEVED
TO SERVE
LOT 2

CIRCLE APPROPRIATE BOXES

A WELL WAS ABANDONED AND SEALED WHEN THIS
WELL WAS COMPLETED

ELECTRIC LOG OBTAINED

COPY OF ELECTRIC LOG ATTACHED

I CERTIFY THAT I HAVE COMPLIED WITH ALL
REGULATIONS STATED ON THE ABOVE CAPTIONED "PERMIT"
WELL LOG, AND THAT INFORMATION CONTAINED
HEREIN IS TRUE, ACCURATE, AND COMPLETE
TO THE BEST OF MY KNOWLEDGE, INFORMATION AND
FAITH

DATE

SIGNATURE

PRINT NAME

ADDRESS

CITY

STATE

ZIP

DATE

SIGNATURE


PRINT NAME

ADDRESS

CITY

STATE

ZIP

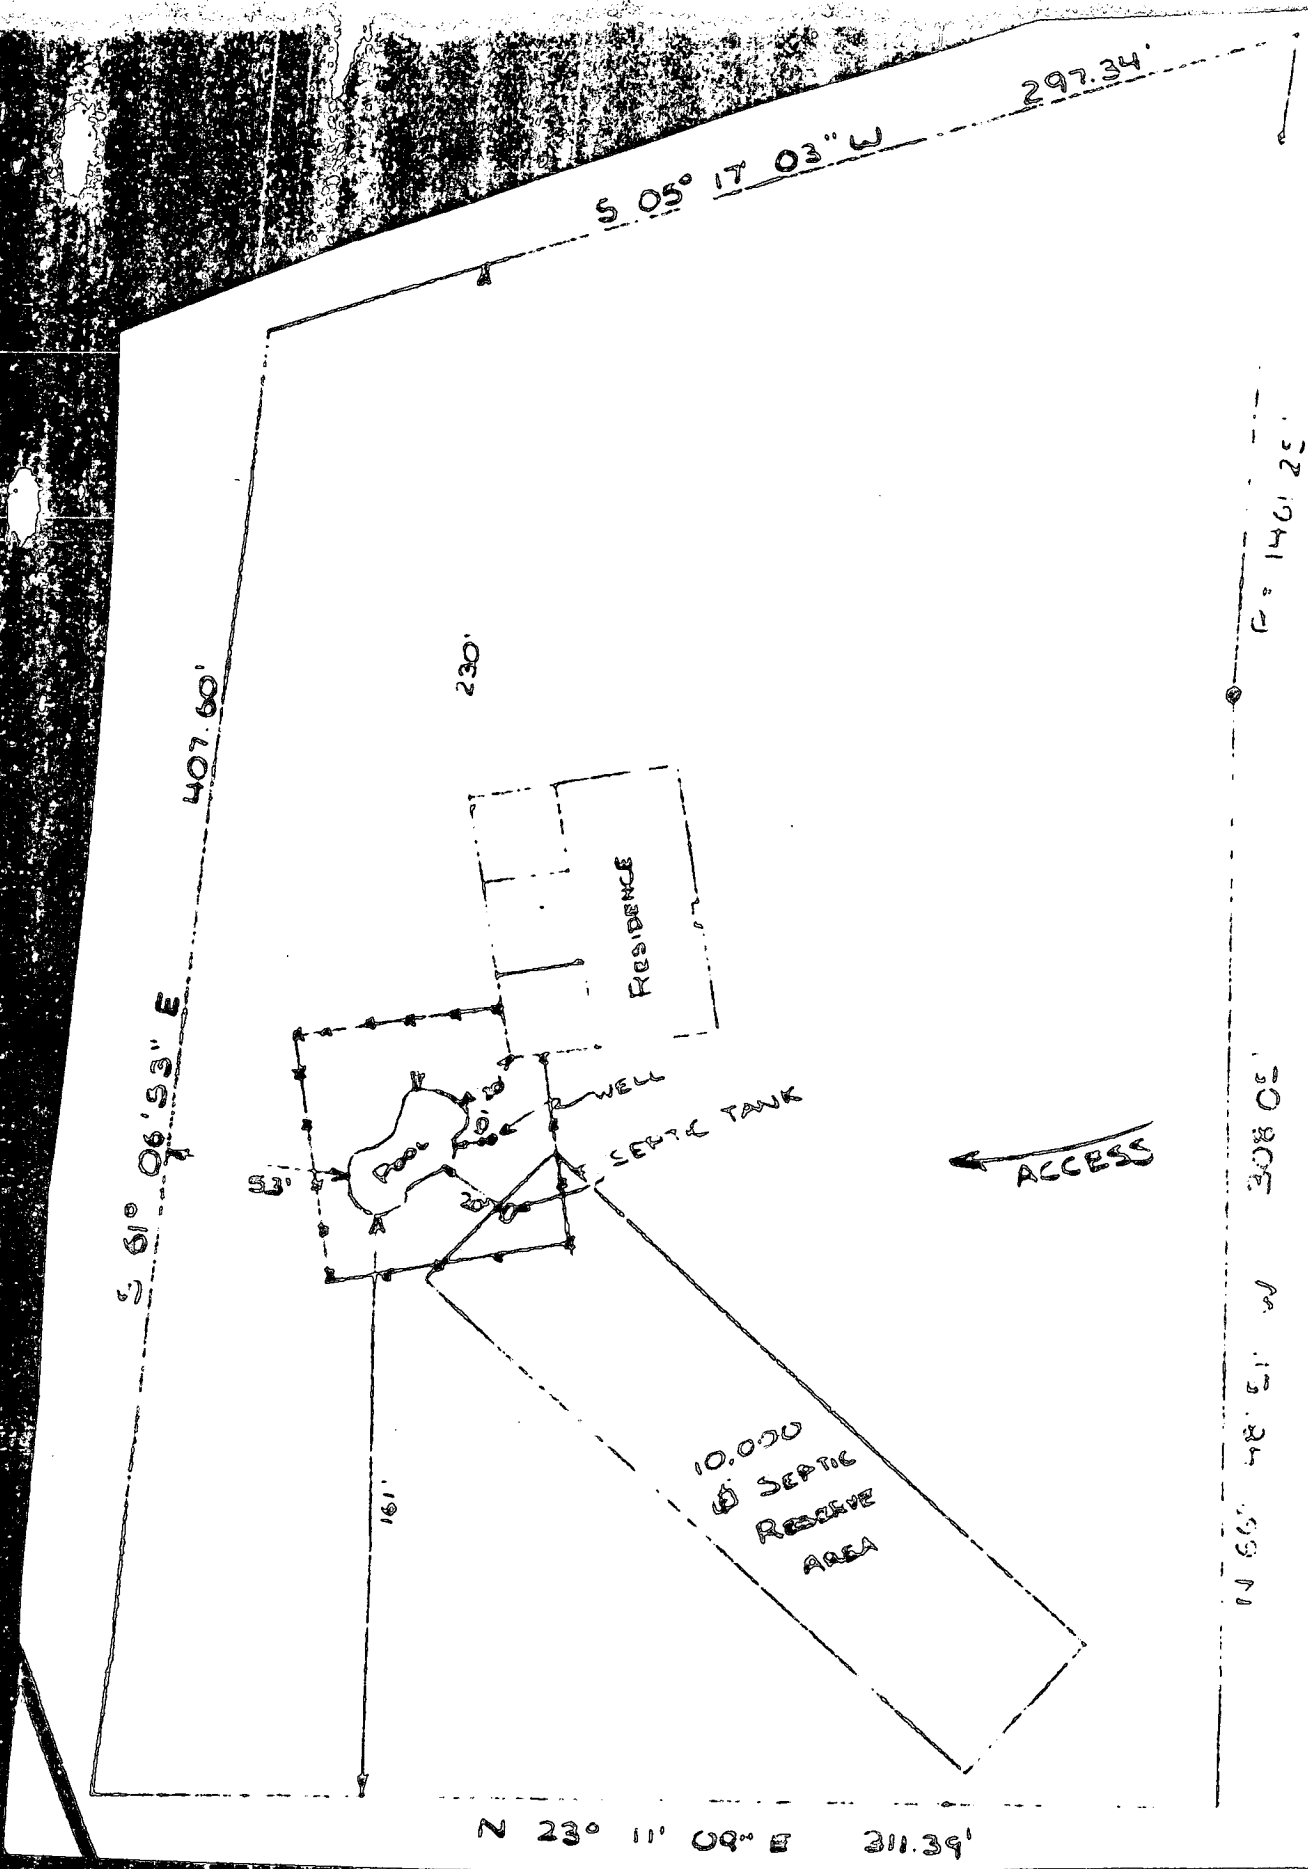

614.60'
407.60'

Septic System ○

brick rancher


73.0'

well ▲

141.2'

153.1'

2/6/03
proposed
garage/pole barn
OK (SRK)

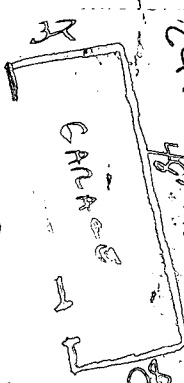

50° 51' 03" E
227.34 39'

327.10'

N 60° 23' 51" W
25.79'

A 163.65'

N 66° 22' 57" W
95.30'

①

N 62° 11' 57" W
126.13'

631 River Road