

Layout 10-11 (if possible)

8 Trenches Later

12/22/00 ASAP Final

1/5/01 1/25/01 House Conn
10AM

PERMIT

SEWAGE DISPOSAL SYSTEM

HOWARD COUNTY HEALTH DEPARTMENT

BUREAU OF ENVIRONMENTAL HEALTH

410-313-2640

P 514 221

A 50619-M

ISSUE DATE 8/31/2000

APPROVAL DATE 1/25/01

INDEXED

South Carroll Backhoe, Inc.

IS PERMITTED TO INSTALL ☒ ALTER ☐

ADDRESS 4410 Salem Bottom Road, Westminster, MD 21157

PHONE 410-875-4197

SUBDIVISION Holly Hills

LOT NUMBER 19

ADDRESS 3306 Sang Road

PROPERTY OWNER Holly Hills, LLC

PROPERTY OWNER'S ADDRESS P.O. Box 39

Columbia, MD 21045

SEPTIC TANK CAPACITY 1250 GALLONS

PUMP CHAMBER CAPACITY GALLONS

NUMBER OF BEDROOMS 4

SQUARE FEET PER BEDROOM 180

LINEAR FEET OF TRENCH REQUIRED 240

RPS# 359747

TRENCHES: Trenches to be 3 feet wide. Inlet 3 feet below original grade. Bottom maximum depth 5 feet below original grade. 2 feet of stone below distribution box.

LOCATION: Place the distribution box 125' from the rear lot line and 20' from the right lot line. Run trenches on contour to left side of lot.

PLANS APPROVED Mark Rifkin

OK 7/18/00 DS

DATE 7/10/00

PERMIT VOID AFTER 2 YEARS

NOTE: CONTRACTOR RESPONSIBLE FOR SCHEDULING A PRE-CONSTRUCTION INSPECTION FOR ALL INSTALLATIONS

NOTE: TOP OF SEPTIC TANKS ARE TO BE NO DEEPER THAN 3.0 FEET BELOW FINISH GRADE

NOTE: WATERTIGHT SEPTIC TANKS REQUIRED

NOTE: CLEANOUT REQUIRED EVERY 70 FEET OF SEWER LINE AND/OR AT 90° SWEEPS IN LINES FROM HOUSE TO DRAIN FIELDS, 90° ELBOWS ARE NOT ACCEPTABLE

NOTE: ALL PARTS OF SEPTIC SYSTEMS (I.E. TANK, DISTRIBUTION BOX, DRAINFIELDS) TO BE 100 FEET FROM ANY WATER WELL UNLESS OTHERWISE SPECIFICALLY AUTHORIZED

NOTE: NO ABSORPTION TRENCH TO EXCEED 100 FEET IN LENGTH UNLESS SPECIFICALLY AUTHORIZED

NOTE: ALL PIPE FROM HOUSE TO SEPTIC TANK MUST BE CAST IRON OR SCHEDULE 35/40 PVC OR ABS

NOTE: MANHOLE RISERS REQUIRED ON ALL SEPTIC TANKS AND PUMP CHAMBERS

NOTE: DISTRIBUTION BOXES MUST HAVE BAFFLES

NOTE: IF PUMPED SEPTIC SYSTEM REQUIRED, (1) SEPTIC PUMP DETAIL TO BE PROVIDED BY INSTALLER PRIOR TO ISSUANCE OF SEPTIC PERMIT (2) PUMP PERFORMANCE TEST IS NECESSARY PRIOR TO HEALTH DEPARTMENT APPROVAL OF SEPTIC PERMIT

NEITHER THE HOWARD COUNTY COUNCIL NOR THE HEALTH DEPARTMENT IS RESPONSIBLE FOR THE SUCCESSFUL OPERATION OF ANY SYSTEM

PERMITTEE RESPONSIBLE FOR OBTAINING FINAL APPROVAL ON THIS PERMIT


CALL 410-313-2640 FOR INSPECTION OF SEPTIC SYSTEM

514221

504

LP TANK MOVED TO BE 30' FROM EX. WELL
PER BUILDER 3/22/01

NOT TO SCALE

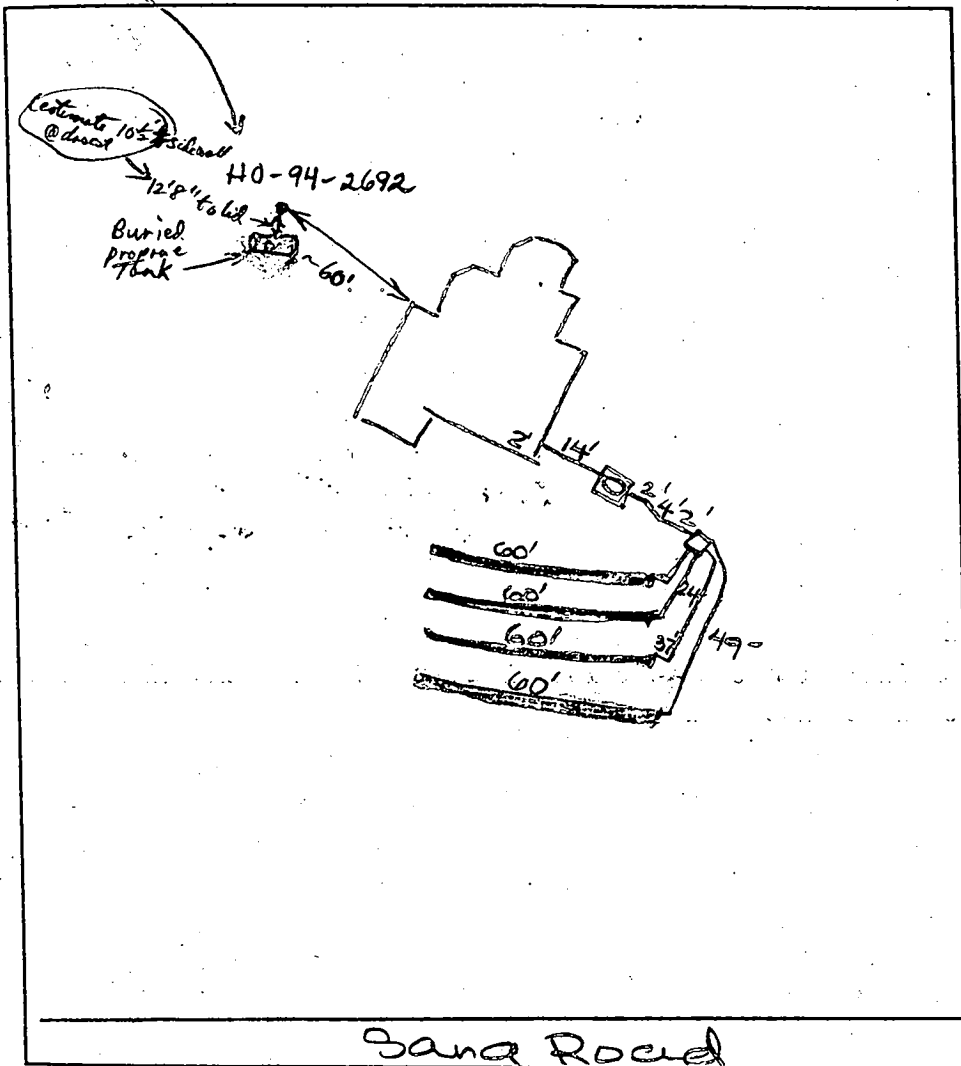

TRENCH DATA

TRENCH WIDTH 3

TRENCH INLET DEPTH 3

TRENCH BOTTOM DEPTH 5

DEPTH OF STONE 2

NUMBER OF TRENCHES 4

TOTAL TRENCH LENGTH 240'

ABSORBENT AREA 720 sq. ft.

DISTRIBUTION BOX LEVEL ☒

BAFFLE IN DISTRIBUTION BOX ☒

SEPTIC TANK DATA

SEPTIC TANK 1500 GALLONS

MANHOLE RISER ☒

6 INCH INSPECTION PORT ☐

PUMP CHAMBER DATA

PUMP CHAMBER GALLONS ☐

MANHOLE RISER ☐

ALARM ☒

PUMP PERFORMANCE TEST ☐

PRE-CONSTRUCTION INSPECTION: 12/21/00 100% confirmed - SDA
staked. DRC

INSPECTION COMMENTS: 12/21/00 Needs house connection.
OK to cover from 2' off house to d. box
and first three trenches. DRC 12/22/00 OK to cover
last trench. Need house connection (BB) OK 1/25/01 PFP


1/5/01 No house connection. Need to check well caps. (BB)

1/25/01 - Well caps on tight, (2) well is only 12 ft from Buried Propane Gas Tank!! This May be Too Close.

MR. Says 30' separation Required! House Connection OK. 1/25/01 PFP

INSPECTOR R. H. H. H. DATE SYSTEM APPROVED 1/25/01

2-14-01
 DPZ OK FOR
 A buried TANK
 with no structure
 above ground
 per cell

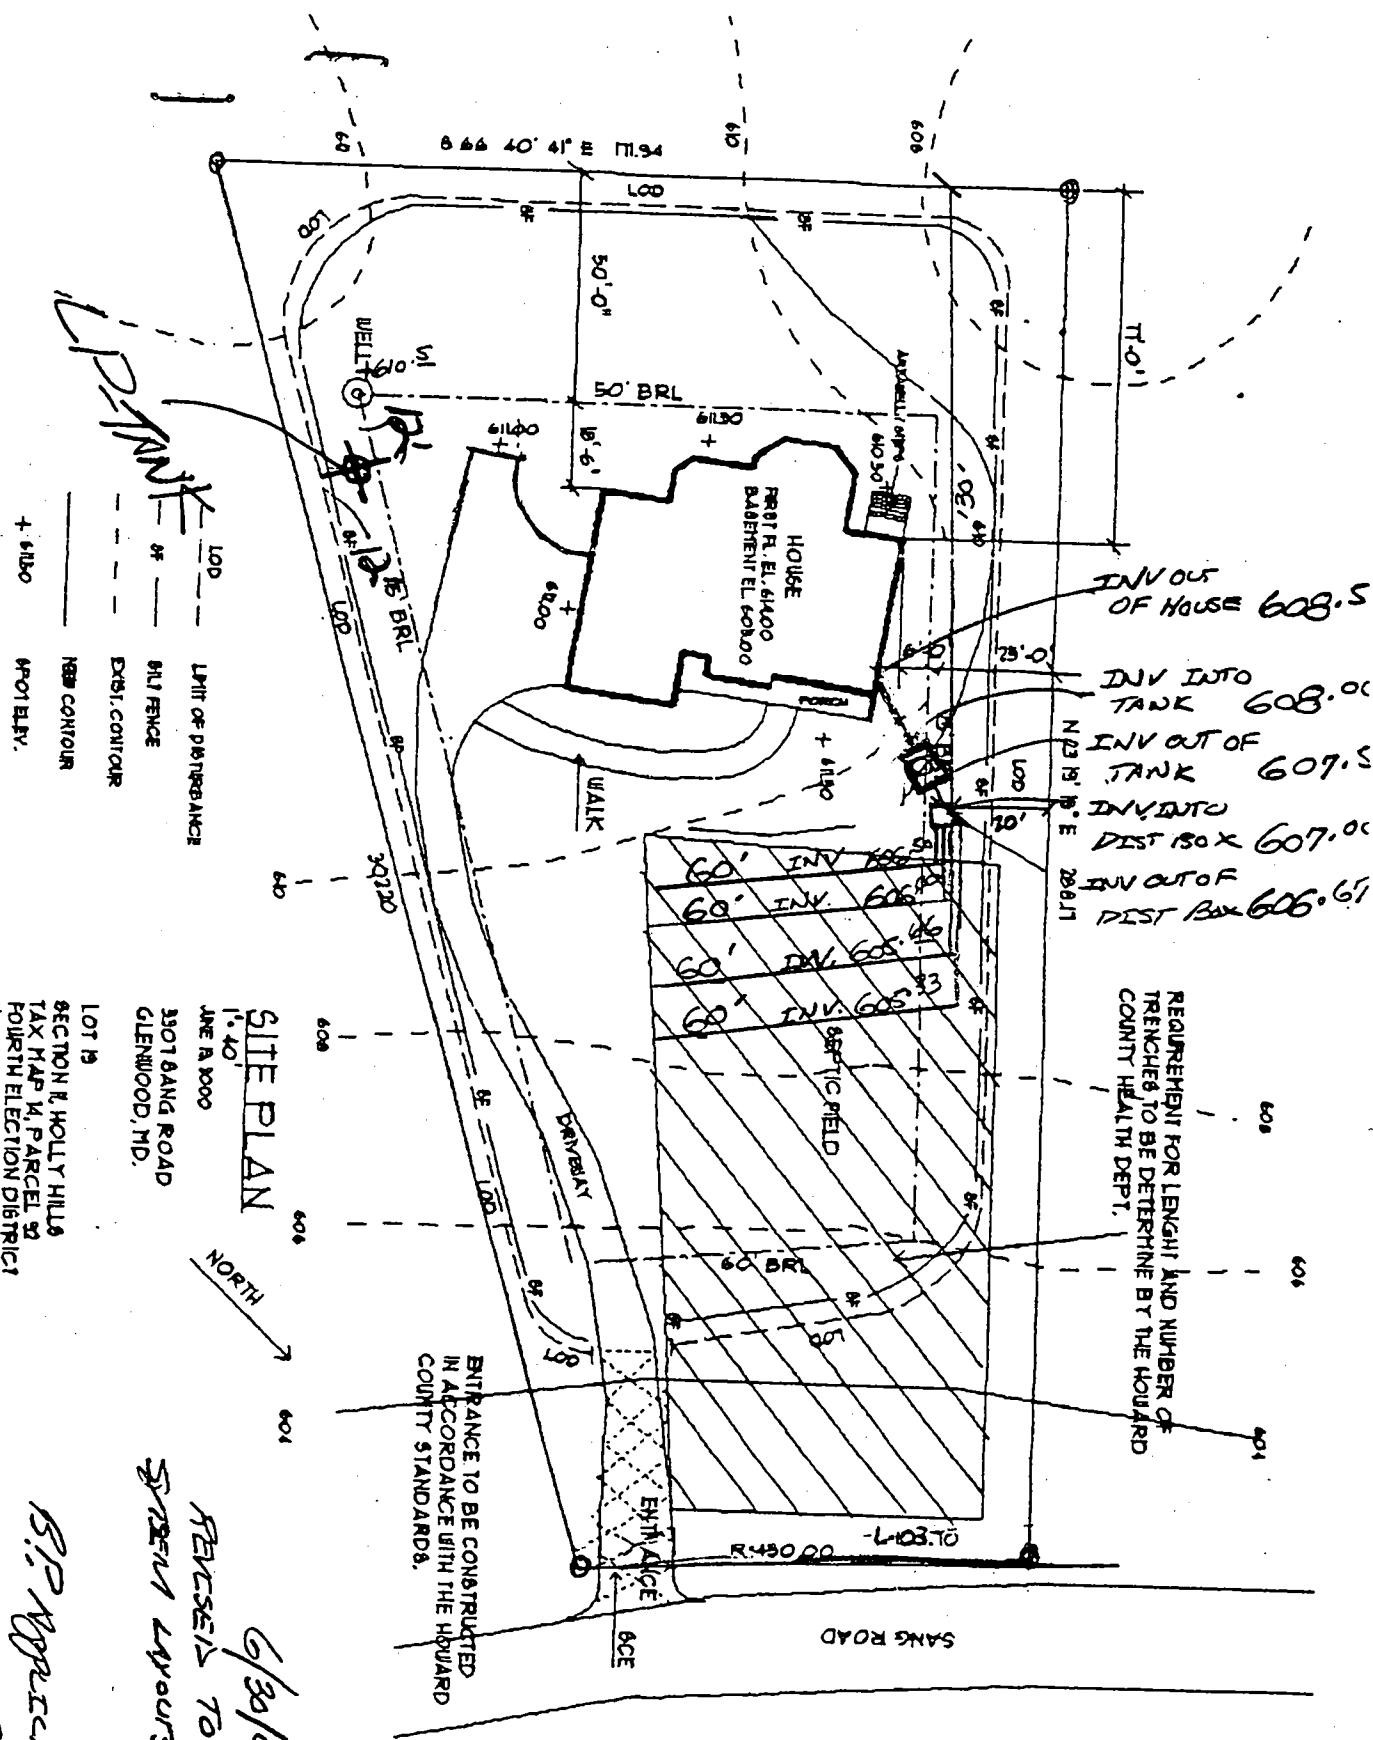

NOTE: TOP OF FLOOR ELEVATION TO BE DETERMINE
 BY THE BUILDING CONTRACTOR. GRADE SITE SO THAT
 DRAINAGE WILL FALL AWAY FROM MAIN BUILDING.



LOT 15
 SECTION 8, HOLLY HILLS
 TAX MAP 14, PARCEL 92
 FOURTH ELECTION DISTRICT
 HOWARD COUNTY, MD.

SITE PLAN
 1" = 40'
 3501 BANG ROAD
 GLENWOOD, MD.

6/30/00
 REVEALS TO SHOW SEPTIC
 TANK LAYOUTS + ELEVATIONS

B.P. APPLICATION #
 1500124995

3/22/01 - ~~REMOVED~~ Ex. LP Tank
 moved to be 30' away from
 well per Mr. Paul Mueller
 (Builder) OK SRK


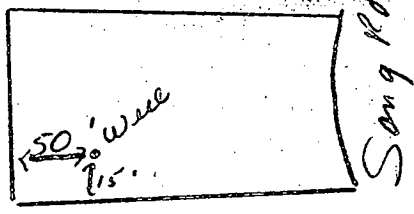
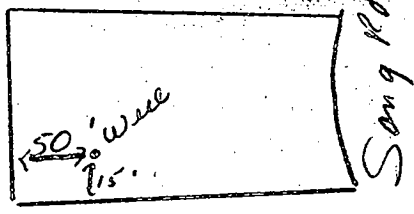
C1 07776 SEQUENCE NO. (MDE USE ONLY) 1 2 3 4 5 6 7 8 9 10 11 12		STATE OF MARYLAND WELL COMPLETION REPORT FILL IN THIS FORM COMPLETELY PLEASE TYPE		THIS REPORT MUST BE SUBMITTED AFTER WELL IS COMPLETED.									
		COUNTY NUMBER A50619-M		PERMIT NO. FROM "PERMIT TO DRILL WELL" HO 94 2692									
ST/CO USE ONLY DATE Received MM DD YY 8 13		DATE WELL COMPLETED MM DD YY 6 2 2000		Depth of Well 22 285 26 (TO NEAREST FOOT)									
OWNER Martin last name STREET OR RFD Sang Road first name SUBDIVISION Holly Hills SECTION Steve first name TOWN Glenwood LOT 19													
WELL LOG Not required for driven wells		GROUTING RECORD											
STATE THE KIND OF FORMATIONS PENETRATED, THEIR COLOR, DEPTH, THICKNESS AND IF WATER BEARING		WELL HAS BEEN GROUTED (Circle Appropriate Box) Y N											
DESCRIPTION (Use additional sheets if needed)		TYPE OF GROUTING MATERIAL (Circle one)											
		CEMENT CM BENTONITE CLAY BC											
		NO. OF BAGS 18 NO. OF POUNDS 1692											
		GALLONS OF WATER 108											
Sand Gray Mica Rock		DEPTH OF GROUT SEAL (to nearest foot)											
		from 0 ft. to 72 ft.											
		(enter 0 if from surface)											
		FEET FROM TO 0 75 75 285											
check if water bearing		CASING RECORD											
		casing types insert appropriate code below											
		ST CO STEEL CONCRETE PL OT PLASTIC OTHER											
		MAIN CASING TYPE ST Nominal diameter top (main) casing (nearest inch) 6 Total depth of main casing (nearest foot) 80											
EACH CASING		OTHER CASING (if used)											
		diameter inch depth (feet) from to											
		screen type or open hole											
		insert appropriate code below											
NUMBER OF UNSUCCESSFUL WELLS: 0		SCREEN RECORD											
		ST BR HO STEEL BRASS OPEN HOLE PL OT PLASTIC OTHER											
		DEPTH (nearest ft.)											
		1 78 285											
WELL HYDROFRACTURED Y N		CIRCLE APPROPRIATE LETTER A A WELL WAS ABANDONED AND SEALED WHEN THIS WELL WAS COMPLETED E ELECTRIC LOG OBTAINED P TEST WELL CONVERTED TO PRODUCTION WELL											
						I HEREBY CERTIFY THAT THIS WELL HAS BEEN CONSTRUCTED IN ACCORDANCE WITH COMAR 26.04.04 "WELL CONSTRUCTION" AND IN CONFORMANCE WITH ALL CONDITIONS STATED IN THE ABOVE CAPTIONED PERMIT, AND THAT THE INFORMATION PRESENTED HEREIN IS ACCURATE AND COMPLETE TO THE BEST OF MY KNOWLEDGE							
										DRILLERS LIC. NO. MS D024 Joseph L. Mayne DRILLERS SIGNATURE (MUST MATCH SIGNATURE ON APPLICATION) LIC. NO. D			
GRAVEL PACK IF WELL DRILLED WAS FLOWING WELL INSERT F IN BOX 68 MDE USE ONLY (NOT TO BE FILLED IN BY DRILLER) T (E.R.O.S.) W Q 70 72 74 75 76 TELESCOPE CASING LOG INDICATOR OTHER DATA													
				PUMPING TEST HOURS PUMPED (nearest hour) 3 PUMPING RATE (gal. per min.) 5 METHOD USED TO MEASURE PUMPING RATE Bucket WATER LEVEL (distance from land surface) BEFORE PUMPING 52 ft. WHEN PUMPING 171 ft. TYPE OF PUMP USED (for test) A air P piston T turbine C centrifugal R rotary O other (describe below) J jet S submersible									
								PUMP INSTALLED DRILLER INSTALLED PUMP (CIRCLE) (YES OR NO) NO IF DRILLER INSTALLS PUMP, THIS SECTION MUST BE COMPLETED FOR ALL WELLS. TYPE OF PUMP INSTALLED PLACE (A,C,J,P,R,S,T,O) IN BOX 29 CAPACITY: GALLONS PER MINUTE (to nearest gallon) 31 35 PUMP HORSE POWER 37 41 PUMP COLUMN LENGTH (nearest ft.) 43 47 CASING HEIGHT (circle appropriate box and enter casing height) + above LAND SURFACE - below 2 (nearest foot)					
LOCATION OF WELL ON LOT SHOW PERMANENT STRUCTURES AND INDICATE NOT LESS THAN TWO DISTANCES (MEASUREMENTS TO WELL) 													
				DRILLERS LIC. NO. MS D024 Joseph L. Mayne DRILLERS SIGNATURE (MUST MATCH SIGNATURE ON APPLICATION) LIC. NO. D									
								SITE SUPERVISOR (sign. of driller or journeyman responsible for sitework if different from permittee)					
GRAVEL PACK IF WELL DRILLED WAS FLOWING WELL INSERT F IN BOX 68 MDE USE ONLY (NOT TO BE FILLED IN BY DRILLER) T (E.R.O.S.) W Q 70 72 74 75 76 TELESCOPE CASING LOG INDICATOR OTHER DATA													
				PUMPING TEST HOURS PUMPED (nearest hour) 3 PUMPING RATE (gal. per min.) 5 METHOD USED TO MEASURE PUMPING RATE Bucket WATER LEVEL (distance from land surface) BEFORE PUMPING 52 ft. WHEN PUMPING 171 ft. TYPE OF PUMP USED (for test) A air P piston T turbine C centrifugal R rotary O other (describe below) J jet S submersible									
								PUMP INSTALLED DRILLER INSTALLED PUMP (CIRCLE) (YES OR NO) NO IF DRILLER INSTALLS PUMP, THIS SECTION MUST BE COMPLETED FOR ALL WELLS. TYPE OF PUMP INSTALLED PLACE (A,C,J,P,R,S,T,O) IN BOX 29 CAPACITY: GALLONS PER MINUTE (to nearest gallon) 31 35 PUMP HORSE POWER 37 41 PUMP COLUMN LENGTH (nearest ft.) 43 47 CASING HEIGHT (circle appropriate box and enter casing height) + above LAND SURFACE - below 2 (nearest foot)					
LOCATION OF WELL ON LOT SHOW PERMANENT STRUCTURES AND INDICATE NOT LESS THAN TWO DISTANCES (MEASUREMENTS TO WELL) 													
				DRILLERS LIC. NO. MS D024 Joseph L. Mayne DRILLERS SIGNATURE (MUST MATCH SIGNATURE ON APPLICATION) LIC. NO. D									
								SITE SUPERVISOR (sign. of driller or journeyman responsible for sitework if different from permittee)					
GRAVEL PACK IF WELL DRILLED WAS FLOWING WELL INSERT F IN BOX 68 MDE USE ONLY (NOT TO BE FILLED IN BY DRILLER) T (E.R.O.S.) W Q 70 72 74 75 76 TELESCOPE CASING LOG INDICATOR OTHER DATA													

Well Permit No. HO - 94-2692
Location of property (road) Sang Road
Subdivision Holly Hills Lot 19 Block Plat Sec.
Well Driller be Mayne Owner Steve Martin

Depth of well 285'
Distance of measuring point (M.P.) above ground 1/2
Static water level (S.W.L.) below M.P. 52'

Time pump started 7:00 Pumping rate 15 gpm.
Total time 30 min. to reach pumping water level 171 ft. below M.P.

[illegible]

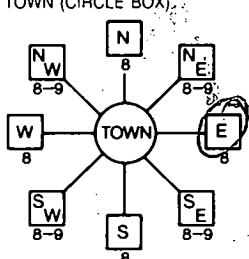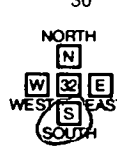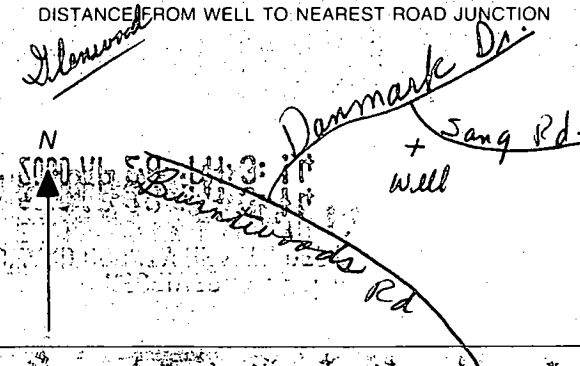B 1 09738 1 2 3 6	SEQUENCE NO. (MDE USE ONLY)	STATE OF MARYLAND PERMIT TO DRILL WELL please print or type	STATE PERMIT NUMBER 40-94-2692 70 79 fill in this form completely
Date Received (APA) 4/20/2000 8 MM DD YY 13 Martin Stone 15 Last Name Owner First Name 34 5934 Iron Frame Way 36 Street or RFD 55 Columbia Md 21044 57 Town 70 State 72 Zip 76		B 3 Howard LOCATION OF WELL 8 COUNTY 21 Holly Hills 23 SUBDIVISION 42 SECTION 19 LOT 48 44 46 48 50 Glenwood 52 NEAREST TOWN 71 MILES FROM TOWN (enter 0 if in town) 3 73 76 77 78	
DRILLER INFORMATION Joseph L Maime MSD 024 Driller's Name 76 License No. 81 Joseph R. Maime Well Drilling Firm Name 5512 Ridge Rd Mt Airy Md 21771 Address Joseph L Maime 4/21/2000 Signature Date		B 4 4 1 42 DIRECTION OF WELL FROM TOWN (CIRCLE BOX) 	
B 2 2 WELL INFORMATION 1 2 APPROX. PUMPING RATE (GAL. PER MIN.) 5 8 12 AVERAGE DAILY QUANTITY NEEDED (GAL. PER DAY) 500 14 20		11 Sang Rd 30 NEAR WHAT ROAD ON WHICH SIDE OF ROAD (CIRCLE APPROPRIATE BOX)  34 245 37 DISTANCE FROM ROAD ENTER FT OR MI 38 39 TAX MAP: 14 BLK: 24 PARCEL 92	
USE FOR WATER (CIRCLE APPROPRIATE BOX) ☒ DOMESTIC POTABLE SUPPLY & RESIDENTIAL IRRIGATION ☐ FARMING (LIVESTOCK WATERING & AGRICULTURAL IRRIGATION) ☐ INDUSTRIAL, COMMERCIAL, DEWATERING ☐ PUBLIC WATER SUPPLY WELL ☐ TEST, OBSERVATION, MONITORING ☐ GEO-THERMAL		NOT TO BE FILLED IN BY DRILLER HEALTH DEPARTMENT APPROVAL Howard A50619-M COUNTY NAME COUNTY NO. STATE SIGNATURE _____ INSERT S → DATE ISSUED 5/19/2000 Brian Baker 5/19/2000 43 MM DD YY 48 CO SIGNATURE EXP. DATE NORTH GRID 529 0 0 0 EAST GRID 798 0 0 0 50 55 57 63	
APPROXIMATE DEPTH OF WELL 260 FEET 24 28 APPROXIMATE DIAMETER OF WELL 6 INCH NEAREST INCH		SHOW MAJOR FEATURES OF BOX & LOCATE WELL WITH AN X SOURCES OF DRILLING WATER 1. well 2. 3. WRITE THE BOX NUMBER FROM THE MAP HERE E 798 N 529	
METHOD OF DRILLING (circle one) BORED (or Augered) <u> JETTED </u> <u> Jettied & DRIVEN </u> 30 AIR-ROTARY AIR-PERCussion ROTARY (Hydraulic Rotary) 37 CABLE Reverse-ROTARY Drive-POINT other _____		6/2/00 9:30am GROUT 11:45 6/2/00 GROUT, LOC 4 TAG OK (MRB)	
REPLACEMENT OR DEEPEMED WELLS (CIRCLE APPROPRIATE BOX) ☒ THIS WELL WILL NOT REPLACE AN EXISTING WELL ☐ THIS WELL WILL REPLACE A WELL THAT WILL BE ABANDONED AND SEALED 39 ☐ THIS WELL WILL REPLACE A WELL THAT WILL BE USED AS A STANDBY-CONTACT LOCAL APPROVING AUTHORITY FOR POLICY ON STANDBY WELLS ☐ THIS WELL WILL DEEPEM AN EXISTING WELL PERMIT NUMBER OF WELL TO BE REPLACED OR DEEPEMED (IF AVAILABLE) 41 _____ 52		DRAW A SKETCH BELOW SHOWING LOCATION OF WELL IN RELATION TO NEARBY TOWNS AND ROADS AND GIVE DISTANCE FROM WELL TO NEAREST ROAD JUNCTION 	
Not to be filled in by driller (MDE OR COUNTY USE ONLY)			
APPROP. PERMIT NUMBER 54 G.A.P. 63 PERMIT No. 40-94-2692 70 71 72 73 74 75 76 77 78 79			
SPECIAL CONDITIONS NOTE - APPROVING AUTHORITIES SHOULD USE SEPARATE SHEET IF NEEDED			

EX. SEPTIC AREA

EX. SEPTIC AREA

EX. WELL

EX. WELL

EX. WELL

EX. WELL

LOT 8

LOT 7


5/19/00
Well Site
Staked by
Surveyor.
AB

SANG ROAD

LOT 5

EX. PAVEMENT TO BE REMOVED

50
59

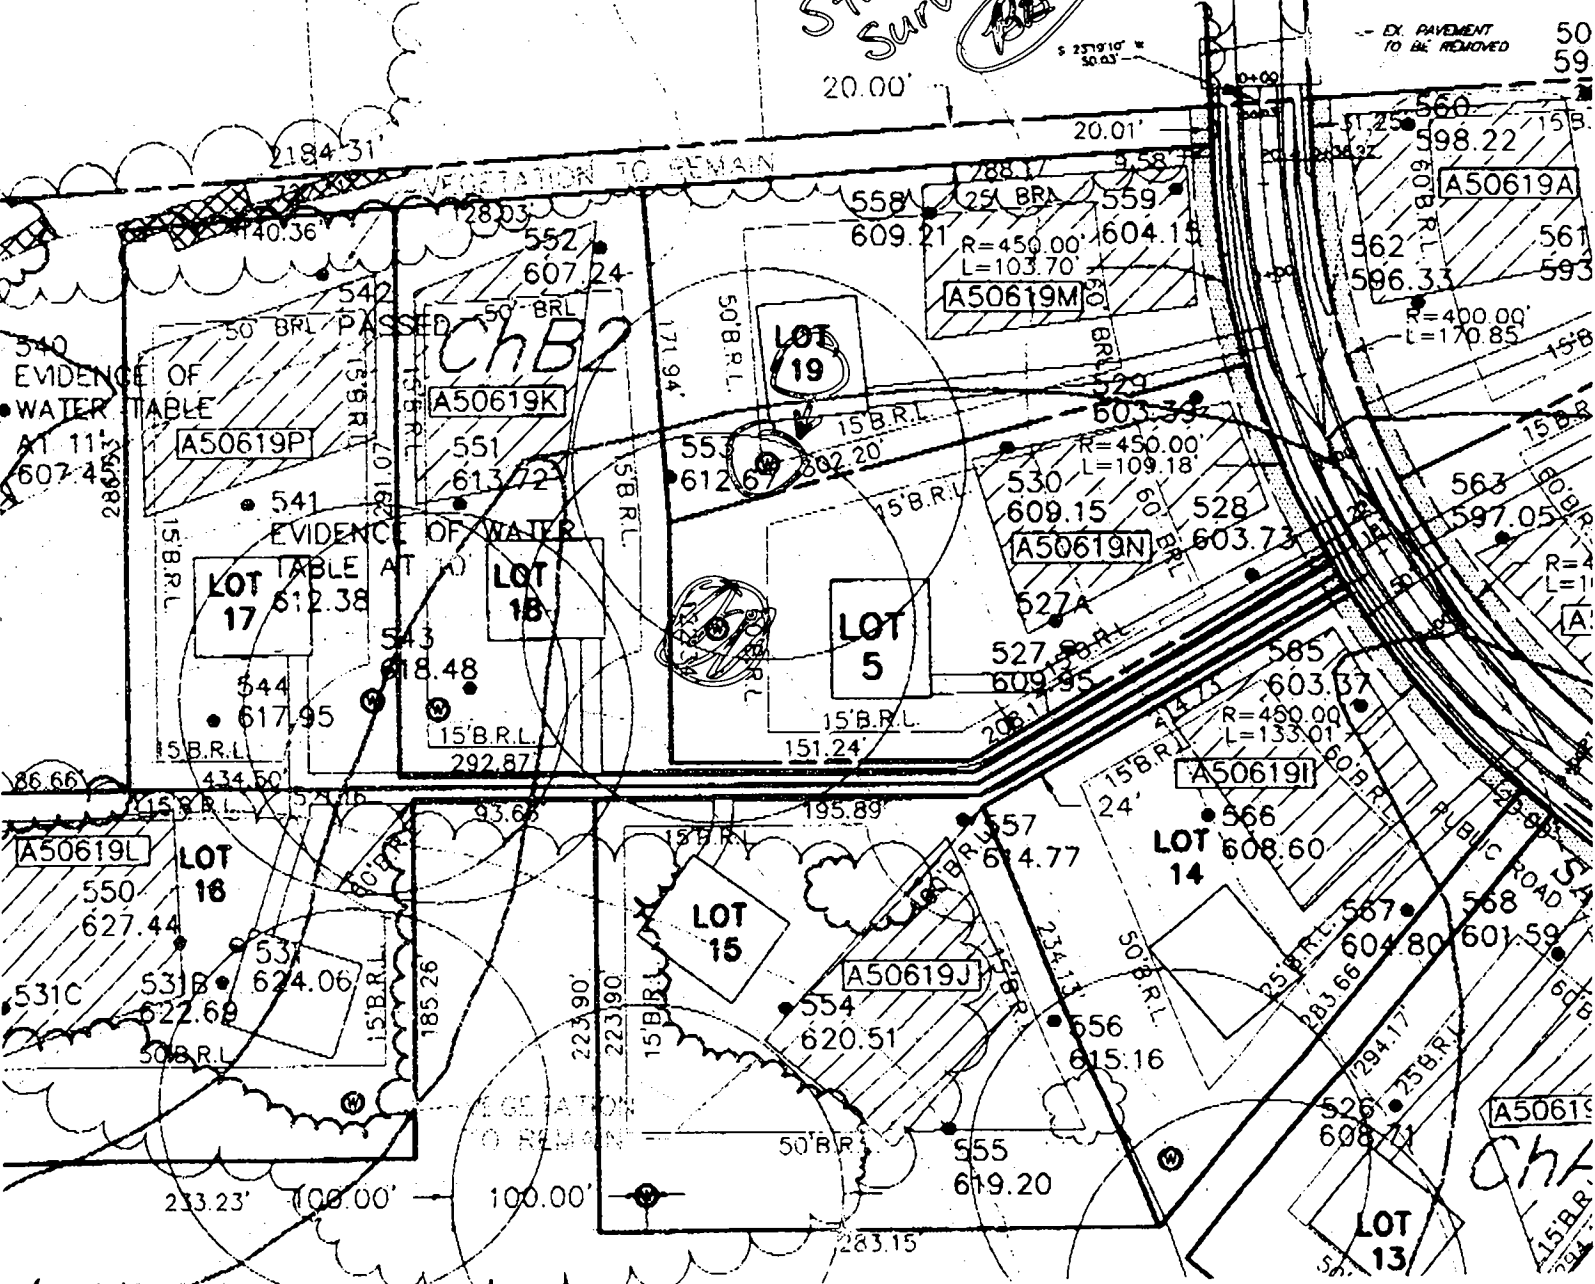

**HOWARD COUNTY HEALTH DEPARTMENT
BUREAU OF ENVIRONMENTAL HEALTH
WATER AND SEWAGE PROGRAM
TEL: (410)313-2640 FAX: (410)313-2648**

Information Form for the Installation of the Well Pump Pitless Adapter, and Supply Piping

NOTE: The installer is responsible for requesting an inspection prior to 9 am on the day of the desired inspection. No work is to be covered until approved by the Health Department. All installations must comply with the National Standard Plumbing Code (NSPC, as amended locally) and COMAR 26.04.04 (MD Well Construction Regulations). Submission of a complete form is required prior to Use and Occupancy approval.

Company Name: Garvey Plumbing & Heating Telephone #: 442-250-9189
Address: 5626 OAKWOOD RD
RAIF MD 21122

(Must circle one) Licensed Plumber Licensed Well Driller Licensed Well Pump Installer
License # and name of individual responsible for the field installation. License # 1736
Name (Print): JAMES F GARVEY
"A Licensed individual must perform the actual installation. Apprentices must be under the direct supervision of a licensed journeyman or master plumber, pump installer or well driller. Licensees may be subjected to field verification."

Name of Property Owner: Holly Hills LLC Telephone #: 410-442-1455
Subdivision: HOLLY HILLS Lot #: 19 Well Tag #: HO-94-2692
Site Address: 3306 SANK RD
CLAYWOOD MD 21118

Submersible Pump Data

Make: Mayco
Model #: 25702-3
Pump Capacity: 3 GPM
Well Yield: 5 GPM

Depth of well encountered at time of pump installation: 25.2 (feet)
If pump capacity exceeds well yield, a low water cut off switch is required by NSPC 1990 Section 17.8.4 (2)
Torque arrestors or Cable guards are required - Must circle one Both
Safety rope, if used, attached to inside of well casing with eye bolt _____

Pitless Adapter

Make: Garvey
Model #: A-300X
Depth: 42" (36" min)
NSP approved: _____

Well Cap and Electric Conduit

Two piece watertight cap: ☒
Screened, vented well cap: _____
Cap secured to casing: ☒
Conduit min 18" B.C.: _____
Conduit secured to well cap: _____

Piping to house

Type: Poly
PSI: 200 (160 psi min)
Depth of supply line: 42" (36" min)

House Connection

PVC sleeved to undisturbed soil at wall penetration: ☒
Approximate length of sleeve: 6 ft
Sleeve caulked and sealed properly: ☒

The water supply line is required to be at least 18 feet from the septic tank, pump chamber, sewage piping, driveway, lot line, etc. If this cannot be achieved, contact this office for approval prior to installation.

Signature of company representative responsible for installation _____

date 1/21/01

For Health Department Use Only - Not to be completed by Installer

Date Insp. Requested: 1/5/01

Date Insp. Approved: 1/5/01

Inspection Data: Pitless adapter and water supply line at least 16" below grade ☒
Two piece cap installed and attached to casing securely ☒
Elec. conduit extends at least 18" below grade/attached to cap properly ☒
Safety rope installed inside of well casing ☒
Correct well tag attached properly and casing 8" above finished grade ☒
Water supply line sleeved adequately at house connection ☒
Adequate grout observed below pitless adapter ☒

(BB) SRK

Att Steve

HOWARD COUNTY
PERMIT APPLICATION

PERMIT NUMBER

B 0024995

Building Address 3306 SANG ROAD
GLENWOOD 21738

Suite/Apt. #: _____ SDP/WP/Petition #: _____

Census Tract 6040 Subdivision HOLLY HILLS

Section — Area — Lot 19

Tax Map 14 Parcel 92 Grid 24

Zoning RR Map Coordinates 9E6 Lot size —

Existing Use VACANT LOT

Proposed Use NEW SFD

Estimated Construction Cost \$ 250000

Description of Work CUSTOM
CONSTRUCT NEW SFD W/ TWO
CAR ATTACHED GARAGE, 4 BED ROOMS
3 1/2 BATHS, POWDER ROOM, PAINT FIN
PAINT WITH BATH

Contractor License # _____

Occupant or Tenant STEVEN & JOYCE MARTEN

Contact Name STEVE MARTEN

Address 5934 LEXON FARMWAY

City COLUMBIA State MD Zip Code 21044

Phone _____ Fax _____

Property Owner's Name HOLLY HILLS LLC

Address PO Box 39

City COLUMBIA State MD Zip Code 21045

Home Phone _____ Work Phone 410 442 1455

Applicant's Name & Mailing Address, (if other than stated hereon):

PAUL MUELLER

PO Box 115

WEST FRIENDSHIP, MD 21794

Phone 410 442 1455 Fax 410 442 1873

Contractor Company MUELLER HOMES INC.

Contact Person PAUL MUELLER

Address PO Box 115

City WEST FRIENDSHIP State MD Zip Code 21794

License No. CE11410-184-3265

Phone 410 442 1455 Fax 410 442 1873

Engineer or Architect Company VEC CHAO

Contact Person VEC CHAO

Address 10738 GREEN MOUNTAIN CIRCLE

City COLUMBIA State MD Zip Code 21044

Phone 410 730 4698 Fax 410 730 4698

BUILDING DESCRIPTION - COMMERCIAL

Building Characteristics	Utilities
Height: _____	Water Supply: _____ Public _____ Private _____
No. of stories: _____	Sewage Disposal: _____ Public _____ Private _____
Gross area, sq. ft. per floor: _____	Electric Yes ☐ No ☐ Gas Yes ☐ No ☐
Use group: _____	Heating System: _____ Electric ☐ Oil ☐ Natural Gas ☐ Propane Gas ☐
Construction type: _____ Reinforced Concrete _____ Structural Steel _____ Masonry _____ Wood Frame _____	Sprinkler system: N/A ☐ Full _____ Partial _____ Other Suppression _____ # of Heads _____
State Certified Modular _____	

BUILDING DESCRIPTION - RESIDENTIAL

Building Characteristics	Utilities
SF Dwelling ☒ SF Townhouse ☐ Depth _____ Width _____	Water Supply: _____ Public _____ Private _____
1st floor: _____	Sewage Disposal: _____ Public _____ Private _____
2nd floor: _____	Electric Yes ☒ No ☐ Gas Yes ☐ No ☒
Basement: _____	Heating System: _____ Electric ☒ Oil ☐ Natural Gas ☐ Propane Gas ☒
Finished Basement ☒ Unfinished Basement ☐ Crawl space ☐ Slab on Grade ☐	Sprinkler system: N/A ☐ NFPA #13D _____ NFPA #13R _____ Other: _____
No. of Bedrooms <u>4</u>	
Multi-family dwellings: _____ No. of efficiency units: _____ No. of 1 BR units: _____ No. of 2 BR units: _____ No. of 3 BR units: _____	
Other Structure: _____ Dimensions: _____ Footings: _____ Roof: _____	
State Certified Modular _____ Manufactured Home _____	

THE UNDERSIGNED HEREBY CERTIFIES AND AGREES AS FOLLOWS: (1) THAT HE/SHE IS AUTHORIZED TO MAKE THIS APPLICATION; (2) THAT THE INFORMATION IS CORRECT; (3) THAT HE/SHE WILL COMPLY WITH ALL REGULATIONS OF HOWARD COUNTY WHICH ARE APPLICABLE THEREON; (4) THAT HE/SHE WILL PERFORM NO WORK ON THE ABOVE REFERENCED PROPERTY NOT SPECIFICALLY DESCRIBED IN THIS APPLICATION; (5) THAT HE/SHE GRANTS COUNTY OFFICIALS THE RIGHT TO ENTER ONTO THIS PROPERTY FOR THE PURPOSES OF INSPECTING THE WORK PERMITTED AND POSTING NOTICES.

Applicant's Signature _____

Title/Company _____

Print Name PAUL F. MUELLER

Date 6/2/00

Checks payable to: DIRECTOR OF FINANCE OF HOWARD COUNTY

** PLEASE WRITE NEATLY AND LEGIBLY **

FOR OFFICE USE ONLY


AGENCY _____ DATE _____ SIGNATURE APPROVAL _____
☒ Land Development, DPZ
☒ State Highways
☒ Building Official
☒ Dev. Engineering, DPZ
☒ Health 4/10/00 Mark E. Roffen
☒ Fire Protection
☒ Is Sediment Control approval required prior to issuance?
YES ☐ NO ☒

CONTINGENCY CONSTRUCTION START: ☐
ONE STOP SHOP: ☐

DEPT. SETBACK INFORMATION
Front: _____
Rear: _____
Side: _____
Side St: _____
All minimum setbacks met? YES ☐ NO ☐
Is Entrance Permit required? YES ☐ NO ☐
Historic District? YES ☐ NO ☐
Lot Coverage for New Town Zone _____
SDP/Red-line approval date _____

PROPERTY ID# 46835
Filing fee \$ 25
Permit fee \$ _____
Excise tax \$ _____
Sub-total paid \$ _____
Add'l permit fee \$ _____
TOTAL FEES \$ _____
Balance due \$ _____
Check # 1060
Validation # 32782
Accepted by DR

see Revised BPP
 floor was built
 closer to Septic Area (15'±)
 than as shown here
 App 11/28/00

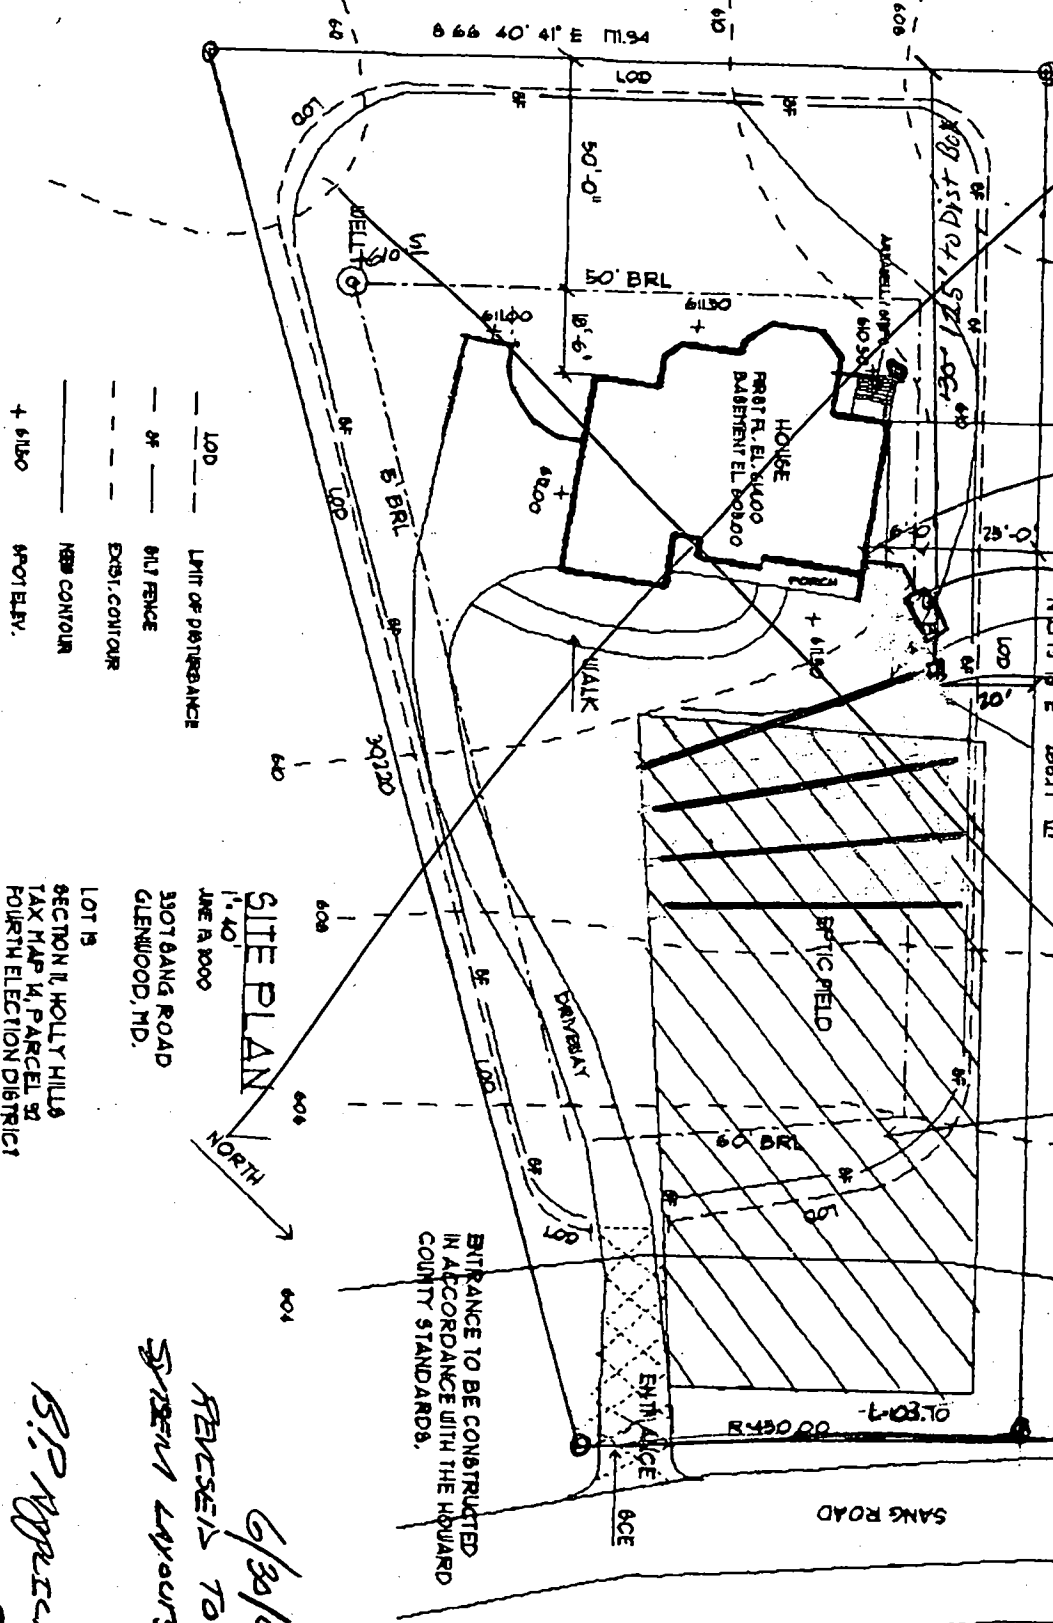

INV OUT OF HOUSE 608.5
 INV INTO TANK 608.00
 INV OUT OF TANK 607.5
 INV INTO DIST BOX 607.00
 INV OUT OF DIST BOX 606.67
 EX. GRADE AT DIST. BOX 609.67

REQUIREMENT FOR LENGTH AND NUMBER OF TRENCHES TO BE DETERMINE BY THE HOWARD COUNTY HEALTH DEPT.

ENTRANCE TO BE CONSTRUCTED IN ACCORDANCE WITH THE HOWARD COUNTY STANDARDS.

NOTE: TOP OF FLOOR ELEVATION TO BE DETERMINE BY THE BUILDING CONTRACTOR, GRADE SITE SO THAT DRAINAGE WILL FALL AWAY FROM MAIN BUILDING.

LOT 15
 SECTION II, HOLLY HILLS
 TAX MAP 14, PARCEL 32
 FOURTH ELECTION DISTRICT
 HOWARD COUNTY, MD.

SITE PLAN
 1" = 40'
 3307 BANG ROAD
 GLENWOOD, MD.

REVISION TO SHOW SEPTIC
 SYSTEM LAYOUTS & ELEVATIONS

B.P. APPLICATION #
 500124995

Approved Septic System Plan
 Howard County Health Department

see Revised BPP
 Mark E. Pflin
 Signature

7/10/00
 Date

Total linear feet of trench required 240 feet
 width of trench(es) 3 feet
 Depth of trench(es) 5 feet
 Depth of stone required below distribution pipe 2 feet

TREE
MAINTENANCE
ESMT.

SANG
ROAD
(50' R/W)

PRIVATE
SEWAGE
EASEMENT

PRESERVATION
PARCEL
16.40 AC.

- INV OUT DIST 130' 19" E
- INV INTO DIST 607
- INV OUT OF TANK 607.5
- INV INTO TANK 608.4
- INV OUT OF HOUSE 608.5

Total linear feet of trench
required 240 feet

Width of trench (as)
3 feet

Depth of trench (as)
5 feet


Depth of stone required below
distribution pipe 2 feet

Approved Septic System Plan

Howard County Health Department

Revised SPP Plan incorporated New House location
as per well check

See Note
12/11/00
Date

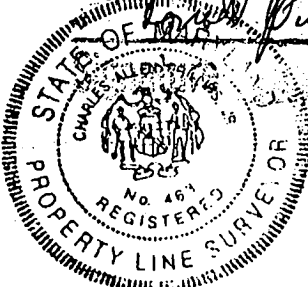


THIS IS TO CERTIFY that I have located the improvements on the lot shown
hereon, and that said improvements exist, and that said improvements lie
entirely within the boundaries, except as shown.

Per KCI TECHNOLOGIES, INC.

THIS PLAT NOT INTENDED FOR USE IN THE ESTABLISHMENT OF
PROPERTY LINES

HOLLY HILLS-SECTION II
LOTS 10 THROUGH OPEN SPACE
LOT 22 AND 23, AND
PRESERVATION PARCEL A
A RESUBDIVISION OF
HOLLY HILLS, SECTION I
BLK PARCELS A AND B
PLAT MOR 12602

TAX MAP 14 PARCEL #92 BLOCK 24
ELECT DIST. 4TH HOWARD CO. MD.

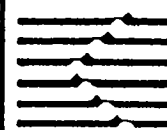

KCI
TECHNOLOGIES, INC.

10 North Park Drive
Hunt Valley, Maryland 21030-1888
(410) 316-7800
Direct Dial Number

SCALE: 1" = 50'

DATE: 8-5-2000

Note: exact trench orientation
to be discussed at preconstruction
inspection 8/13/11/00

REVISED BUILDING

PERMIT SITE PLAN

11/6/00 FOR HEALTH DEPT.

HOUSE ROTATED 10°

CLOCKWISE, AND

~~FOUNDATION~~ SHOWING
CERTIFICATION / REVISED

PER AREA

LOT 19

OF

HOLLY HILLS-SECTION II

LOTS 10 THROUGH OPEN SPACE

LOT 22 AND 23, AND

PRESERVATION PARCEL A

A RESUBDIVISION OF

HOLLY HILLS, SECTION I

BLK PARCELS A AND B


PLAT MOR 12602

TREE
MAINTENANCE
ESMT.

SANG
ROAD
(50' RW)

PRIVATE
SEWAGE
EASEMENT

PRESERVATION
PARCEL
16.40 AC.

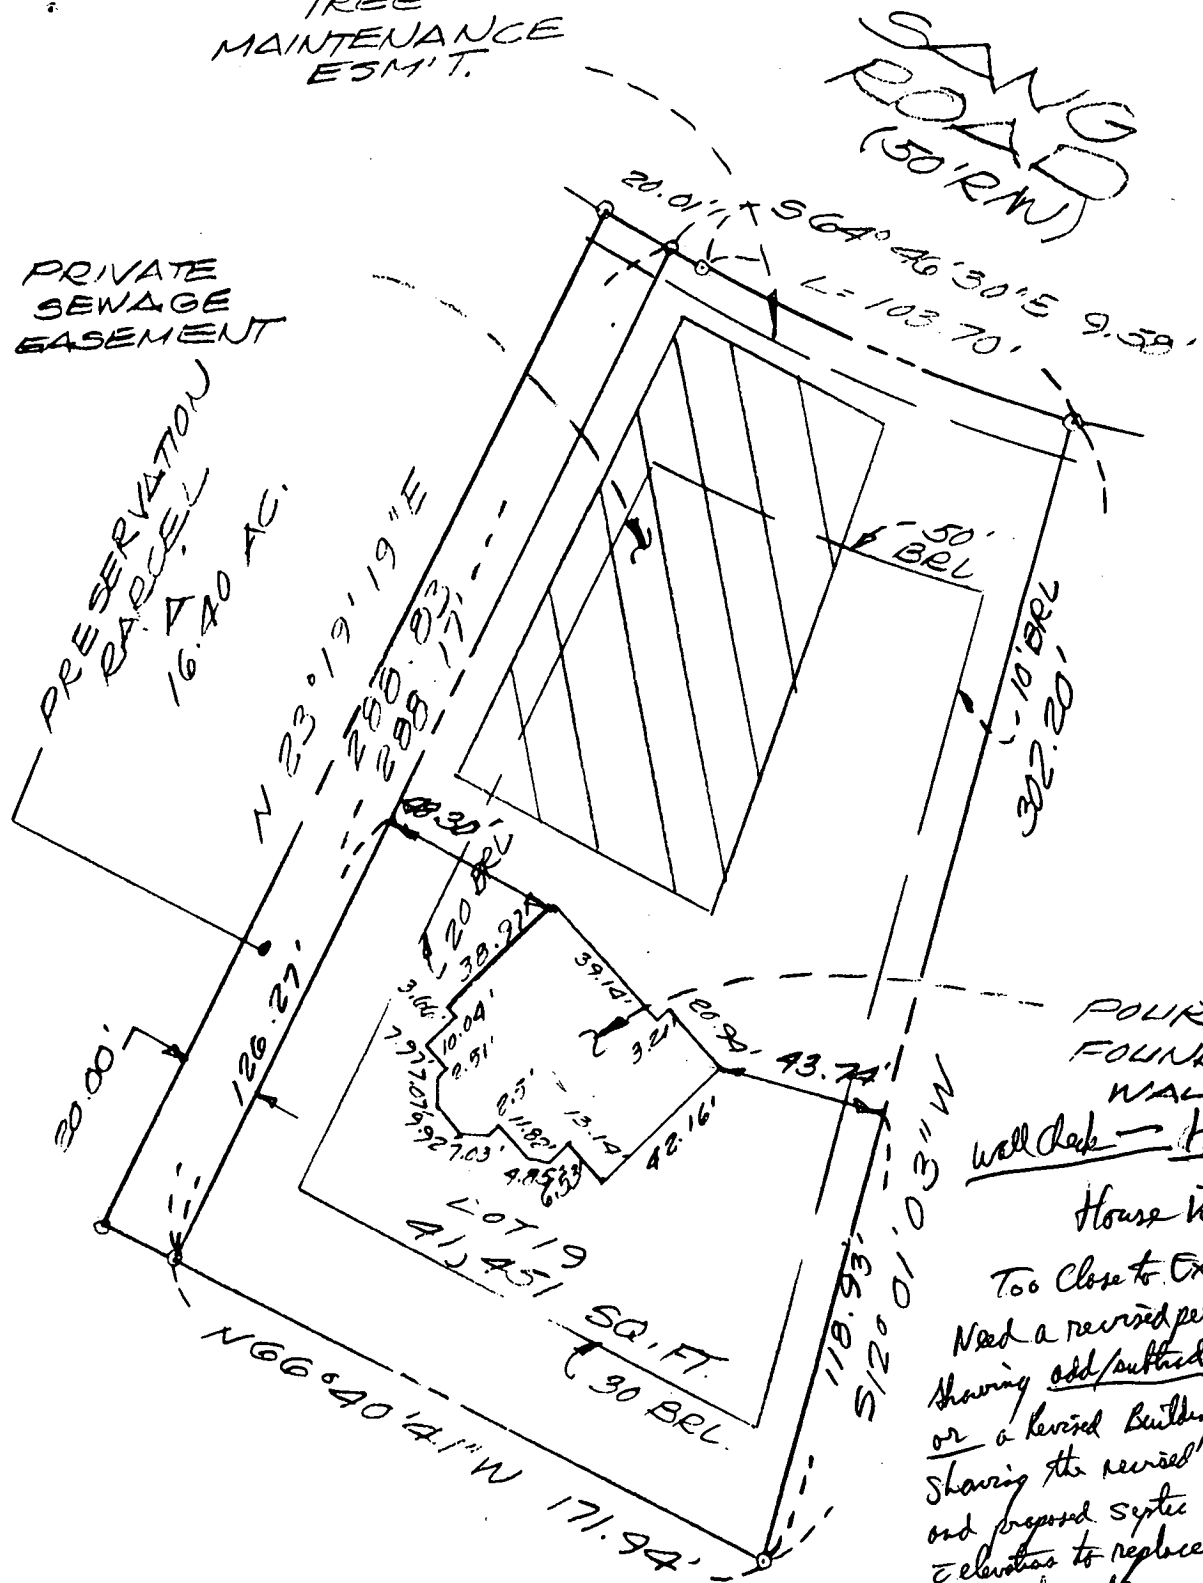


POURED
FOUNDATION
WALLS
will check - Hold Septic Permit until
House is No w resolved

Too Close to Existing Septic Area!
Need a revised perc Cert Plan
Showing add/subtract from existing SDA
or a revised Building Permit Plan
Showing the revised & old SDA's
and proposed septic layout (properly oriented)
& elevations to replace incorrect
one we have now
PP 11/28/00
Message left to Paul Krueger
Machine - Also
for other review

FOUNDATION CERTIFICATION

LOT 19
OF
HOLLY HILLS - SECTION II
LOTS 10 THROUGH OPEN SPACE
LOT 22 AND 23, AND
PRESERVATION PARCEL 'A'
A RESUBDIVISION OF
HOLLY HILLS, SECTION I
BULK PARCELS 'A' AND 'B'
PLAT MDR 12602

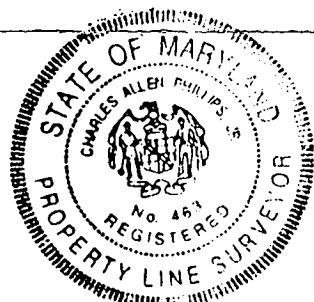

THIS IS TO CERTIFY that I have located the improvements on the lot shown hereon, and that said improvements exist, and that said improvements lie entirely within the boundaries, except as shown.

[Signature] 8/9/00
Per KCI TECHNOLOGIES, INC.

THIS PLAT NOT INTENDED FOR USE IN THE ESTABLISHMENT OF PROPERTY LINES

TAX MAP 14 PARCEL #92 BLOCK 24
ELECT DIST. 4TH HOWARD CO. MD

KCI
TECHNOLOGIES, INC.

10 North Park Drive
Hunt Valley, Maryland 21030-1888
(410) 316-7800
Direct Dial Number

SCALE: 1" = 50' DATE: 8-5-2000

APPLICATION

PERCOLATION TESTING

A 50619M

P _____

HOWARD COUNTY HEALTH DEPARTMENT

BUREAU OF ENVIRONMENTAL HEALTH

3525-H ELLICOTT MILLS DRIVE/ELLICOTT CITY, MARYLAND 21043

TELEPHONE: 313-2640

DISTRICT _____

DATE 8/29/95

TO: THE COUNTY HEALTH OFFICER
ELLICOTT CITY, MARYLAND

I HEREBY APPLY FOR THE NECESSARY TEST PRIOR TO APPLICATION FOR PERMIT TO CONSTRUCT (OR RECONSTRUCT) A SEWAGE DISPOSAL SYSTEM.

PROPERTY OWNER WAYNE NEWSOME

ADDRESS P.O. BOX 39, COLUMBIA, MD PHONE (410) 792-2100
21045

AGENT OR PROSPECTIVE BUYER _____

ADDRESS _____ PHONE _____

PROPERTY LOCATION:

SUBDIVISION HOLLY HILLS ESTATES LOT NO. 4 ^{ORIGINAL} NEW LOT 8/19

ROAD AND DESCRIPTION PROPERTY HAS APPROX. 175' OF FRONTAGE ON
BURNTWOODS ROAD - 21 LOT (17 NEW SFD'S) SUBDIVISION
EXTENSION OF SANG ROAD

TAX MAP 14 PARCEL # 92

SIZE OF LOT LOT 8: 40,093 SQ FT TYPE BLDG. SFD
(SINGLE FAMILY DWELLING OR COMMERCIAL)

THE SYSTEM INSTALLED UNDER THIS APPLICATION IS ACCEPTABLE ONLY UNTIL PUBLIC FACILITIES BECOME AVAILABLE. I FULLY UNDERSTAND THE

FEE CONNECTED WITH THE FILING OF THIS PERC TEST APPLICATION IS NON-REFUNDABLE UNDER ANY CIRCUMSTANCES. I ALSO AGREE TO

COMPLY WITH ALL M.O.S.H.A. REQUIREMENTS IN TESTING THIS LOT. Stephanie Demchuk
(SIGNATURE OF APPLICANT)

APPROVED BY _____ FOR _____ DATE _____

DISAPPROVED BY _____ FOR _____ DATE _____

HOLD PENDING FURTHER TESTS _____

REASONS FOR REJECTION OR HOLDING _____

PERCOLATION TEST PLAT/PRELIMINARY PLAT - TITLE OR I.D. # _____ DATE _____

SITE DEVELOPMENT PLAN/FINAL PLAT - TITLE OR I.D. # _____ DATE _____

THIS IS NOT A PERMIT

50619-M

COUNTY #

SOIL PROFILE
558SIMILAR
TO
559


530

topsoil
med brn
sil cl
pale
gray-red
mica
loam
saprolite

529

topsoil
cl
sil m

558 WOODS

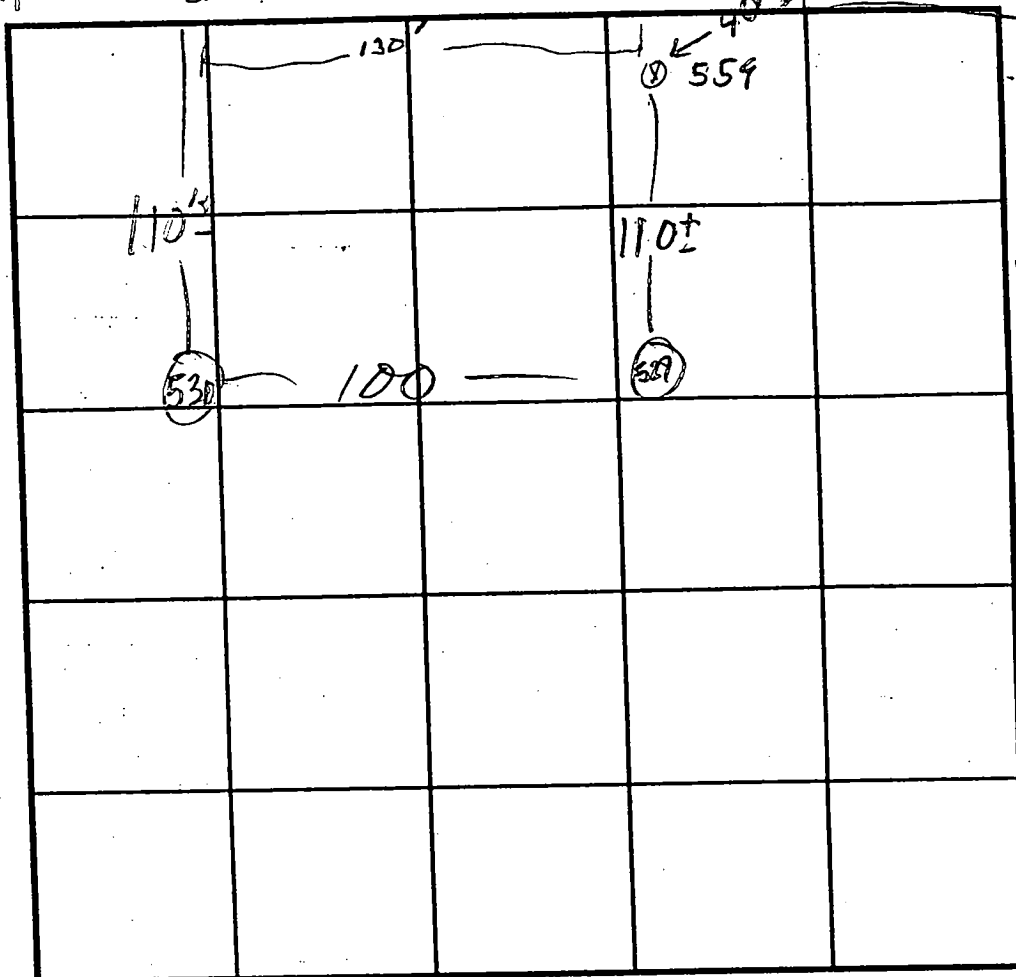ACCESS
ROAD

SOIL PROFILE

559

TOPSOIL
Brown
CLAYTAN
SANDY
SILTY
LOAM

INDICATE NORTH - NAME ADJOINING ROADWAY AS BASE LINE.

REPOUR

DATE	TEST NO.	DEPTH	PRE-WET		TEST - 1" DROP		TIME
			START	STOP	START	STOP	
9/29/95	OK TO 11 559	5'	3:28	3:29	3:30	3:32	2 MIN
	OK TO 11 558	4' 6"	3:53	3:55	3:55	3:57	2 MIN
4/20/95	530M	4'					8 5
		v Depth NOT recorded					
	529 v	11 1/2	OK				

REMARKS LOT 19 SEE ALSO "N" (LOT 5)

TYPE OF SOIL

TESTED BY GLEN SAUSAGE

ALSO PRESENT WILL HARRIS-HELOIR

TRENCH DESIGN DATA: AVERAGE PERCOLATION TIME

4

TRENCH WIDTH

3

INLET DEPTH


3

MAXIMUM BOTTOM DEPTH

5

SQ. FT./BEDROOM

180

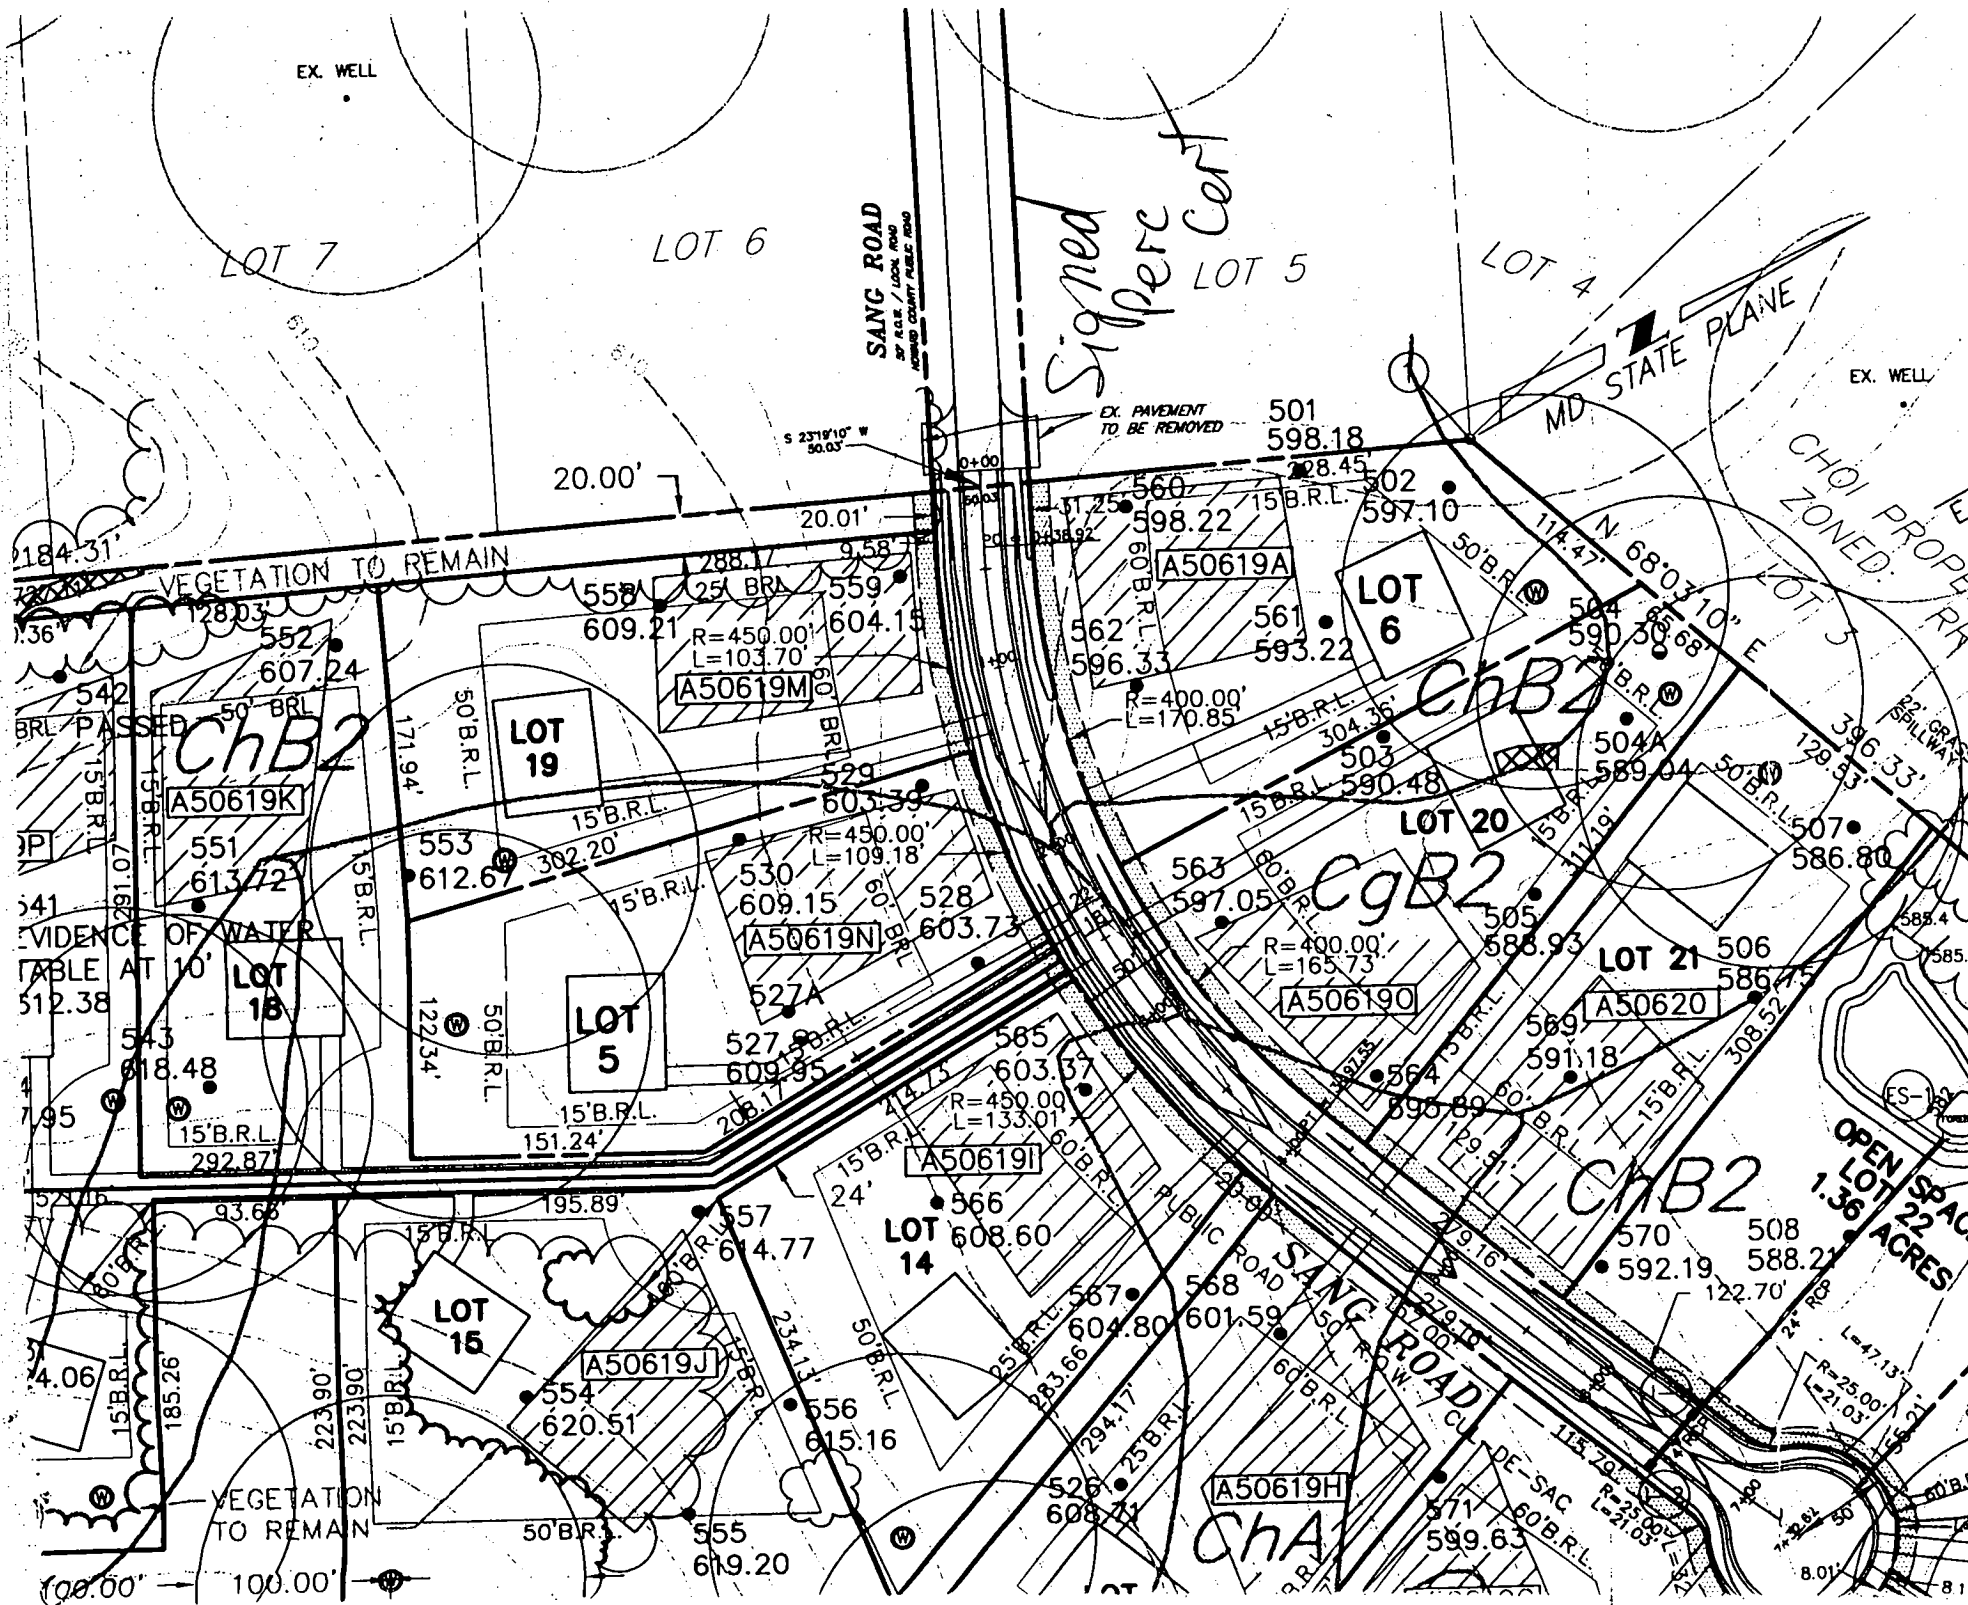

EX. WELL

LOT 7

LOT 6

SANG ROAD
30' R.O.W. / LOOK ROAD
USDA COUNTY PUBLIC ROAD

Signed Sippert Cent

LOT 5

LOT 4

MD STATE PLANE

EX. WELL

CHOI PROPERTY
ZONED: R-1

VEGETATION TO REMAIN

EX. PAVEMENT
TO BE REMOVED

ChB2

LOT 19

LOT 6

LOT 20

LOT 21

LOT 5

LOT 18

LOT 14

LOT 15

ChB2

OPEN SPACE
1.36 ACRES

VEGETATION
TO REMAIN

ChA

SANG ROAD

DE-SAC