

PERMIT
SEWAGE DISPOSAL SYSTEM
HOWARD COUNTY HEALTH DEPARTMENT
BUREAU OF ENVIRONMENTAL HEALTH
410-313-2640

P 514229

A REPAIR

ISSUE DATE 9/6/2000

APPROVAL DATE 9/11/00

INDEXED

Hatfield's Equipment

IS PERMITTED TO INSTALL ALTER X

ADDRESS 13785 Burntwoods Road, Glenelg, MD 21737 PHONE 301-854-6172

SUBDIVISION Kings Manor LOT NUMBER 6 ADDRESS Queen Street

PROPERTY OWNER HL WESSEL PROPERTY OWNER'S ADDRESS 11909 Queen Street

SEPTIC TANK CAPACITY ex: 1000 GALLONS

PUMP CHAMBER CAPACITY N/A GALLONS

NUMBER OF BEDROOMS 3

SQUARE FEET PER BEDROOM 180

LINEAR FEET OF TRENCH REQUIRED 77 (720k)

DNE

TRENCHES: Trenches to be 2 feet wide. Inlet 3-3 1/2 feet below original grade. Bottom maximum depth 10 feet below original grade. 7 feet of stone below distribution box.

LOCATION: _____

REPAIR - PURPOSE- Existing septic system has failed.

Call for inspection when ground is opened so sanitarian can recommend repair. 9/7/00

PLANS APPROVED Steven R. Krieg DATE 9/11/00

PERMIT VOID AFTER 2 YEARS

NOTE: CONTRACTOR RESPONSIBLE FOR SCHEDULING A PRE-CONSTRUCTION INSPECTION FOR ALL INSTALLATIONS

NOTE: TOP OF SEPTIC TANKS ARE TO BE NO DEEPER THAN 3.0 FEET BELOW FINISH GRADE

NOTE: WATERTIGHT SEPTIC TANKS REQUIRED

NOTE: CLEANOUT REQUIRED EVERY 70 FEET OF SEWER LINE AND/OR AT 90° SWEEPS IN LINES FROM HOUSE TO DRAIN FIELDS, 90° ELBOWS ARE NOT ACCEPTABLE

NOTE: ALL PARTS OF SEPTIC SYSTEMS (I.E. TANK, DISTRIBUTION BOX, DRAINFIELDS) TO BE 100 FEET FROM ANY WATER WELL UNLESS OTHERWISE SPECIFICALLY AUTHORIZED

NOTE: NO ABSORPTION TRENCH TO EXCEED 100 FEET IN LENGTH UNLESS SPECIFICALLY AUTHORIZED

NOTE: ALL PIPE FROM HOUSE TO SEPTIC TANK MUST BE CAST IRON OR SCHEDULE 35/40 PVC OR ABS


NOTE: MANHOLE RISERS REQUIRED ON ALL SEPTIC TANKS AND PUMP CHAMBERS

NOTE: DISTRIBUTION BOXES MUST HAVE BAFFLES


NOTE: IF PUMPED SEPTIC SYSTEM REQUIRED, (1) SEPTIC PUMP DETAIL TO BE PROVIDED BY INSTALLER PRIOR TO ISSUANCE OF SEPTIC PERMIT (2) PUMP PERFORMANCE TEST IS NECESSARY PRIOR TO HEALTH DEPARTMENT APPROVAL OF SEPTIC PERMIT

NEITHER THE HOWARD COUNTY COUNCIL NOR THE HEALTH DEPARTMENT IS RESPONSIBLE FOR THE
SUCCESSFUL OPERATION OF ANY SYSTEM
PERMITTEE RESPONSIBLE FOR OBTAINING FINAL APPROVAL ON THIS PERMIT
CALL 410-313-2640 FOR INSPECTION OF SEPTIC SYSTEM

P 514229

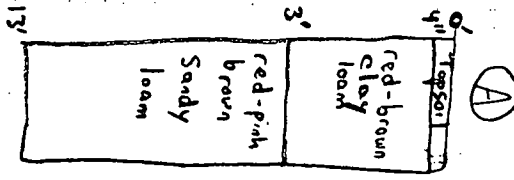

NOT TO SCALE

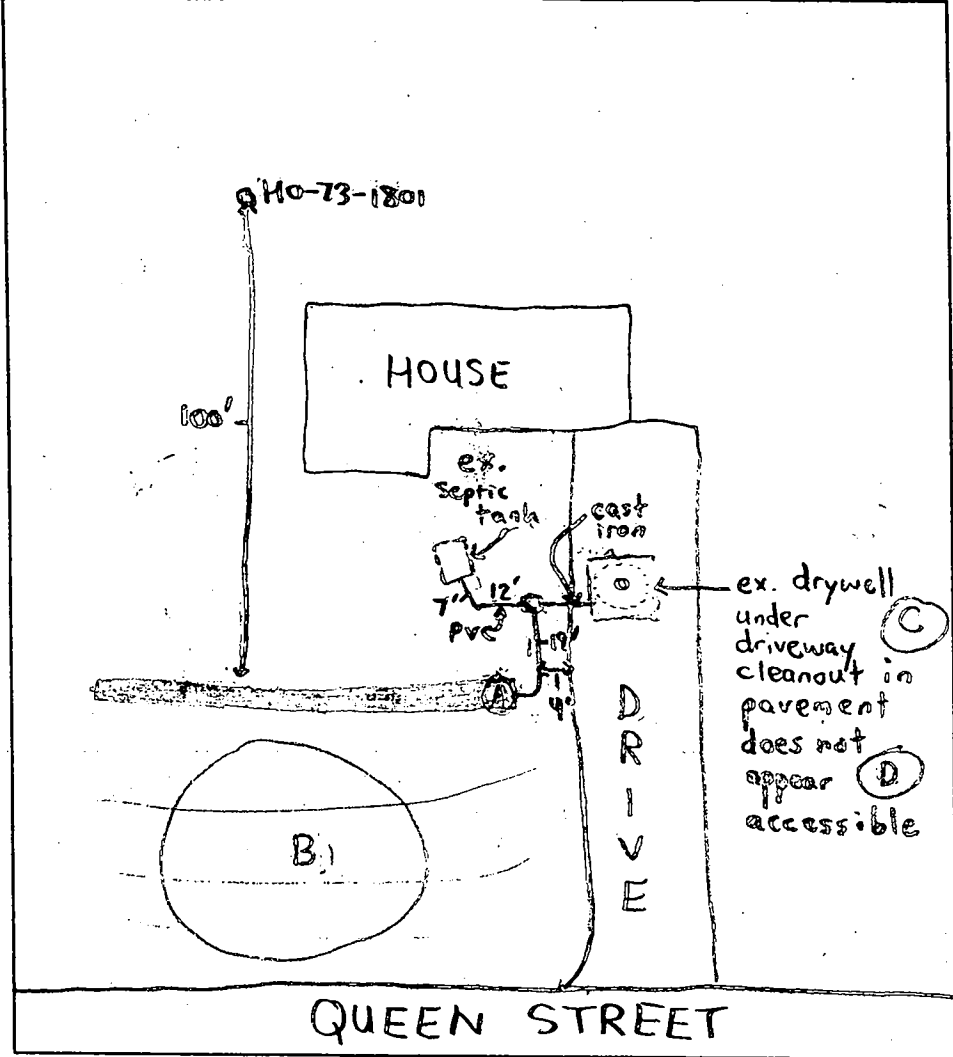

TRENCH DATA	
TRENCH WIDTH	2'
TRENCH INLET DEPTH	3'
TRENCH BOTTOM DEPTH	10'
DEPTH OF STONE	7'
NUMBER OF TRENCHES	1
TOTAL TRENCH LENGTH	72'
ABSORBENT AREA	504 ft ²
DISTRIBUTION BOX LEVEL	☒
BAFFLE IN DISTRIBUTION BOX	☒

SEPTIC TANK DATA	
SEPTIC TANK	ex: 1000 GALLONS
MANHOLE RISER	No
6 INCH INSPECTION PORT	existing
PUMP CHAMBER DATA	
PUMP CHAMBER GALLONS	N/A
MANHOLE RISER	N/A
ALARM	N/A
PUMP PERFORMANCE TEST	N/A

PRE-CONSTRUCTION INSPECTION: _____

INSPECTION COMMENTS: 9/11/00 - Ex. Dry well full and presumed clogged. Perc hole dug in location (A) - See profile, soil good. PVC Sanitary T baffle added in rear of septic tank. Pipe from ST outlet to DBOX replaced with PVC and original cast iron line to dry well snaked. New trench excavated along contour maintaining 100' from ex. well. Room for additional repairs exists in location (B) presuming "good" soil and underneath driveway to (C) & (D). If necessary. Ok to cover all work (SRK)

INSPECTOR Steven R. Krieg DATE SYSTEM APPROVED 9/11/00

7/6/77 2/11/77 Final
PERMIT

SEWAGE DISPOSAL SYSTEM

MARYLAND STATE DEPARTMENT OF HEALTH

HOWARD COUNTY

Approved
7/7/77
RB & T.D.
P 26005
A 28114
ELLICOTT CITY

DISTRICT 5th

INDEXED

DATE 6/3/77

Robert

Albert Orndorff

IS PERMITTED TO INSTALL ☒ ALTER ☐

ADDRESS

PHONE

A SEWAGE DISPOSAL SYSTEM LOCATED AT

SUBDIVISION Kings Manor

ROAD Queen Street off Pindell School Rd. LOT 6

PROPERTY OWNER Howard Wessel

ADDRESS 3136 East Normandy Woods Drive, Ellicott City, Md. 461-2274

SPECIFICATIONS 3 bedrooms

DRAIN FIELD DEPTH FEET, BOTTOM AREA SQ. FT.

SEEPAGE PITS ABSORBENT SIDE-WALL AREA SQ. FT.

SEPTIC TANK CAPACITY 1000 GALLONS

FOR GARBAGE GRINDER, INCREASE DISPOSAL AREA 22% & TANK CAPACITY 50%.

OTHER DRY WELL-400 sq. feet sidewall area. Dry well inlet to be 4 ft. deep below original grade and bottom of dry well to be 12 ft. deep below original grade. Place the dry well 90 ft. from front lot line and 45 ft. from right side of the lot as seen when facing lot from Queen Street.

NOTE: ALL PIPE FROM HOUSE TO DISPOSAL AREA MUST BE CAST IRON. PERMIT VOID AFTER 3 YEARS.

NOTE: INSTALL STAND PIPES ON SEPTIC TANK AND DRY WELL. STAND PIPES MUST BE 6 INCHES IN DIAMETER. CAST IRON, CONCRETE OR TERRA COTTA ACCEPTED.

PLANS APPROVED BY Raymond Hodges & R. Biggs DATE 12/8/76

FILL SEPTIC TANK AND DISTRIBUTION BOX WITH WATER BEFORE CALLING FOR AN INSPECTION. COVER NO WORK UNTIL INSPECTED AND APPROVED.


NEITHER THE HOWARD COUNTY COMMISSIONERS NOR THE HEALTH DEPARTMENT IS RESPONSIBLE FOR THE SUCCESSFUL OPERATION OF ANY SYSTEM.

garage # 37938
signed 11/29/78

24114

A24114

60' perimeter
1 1/2' below inlet

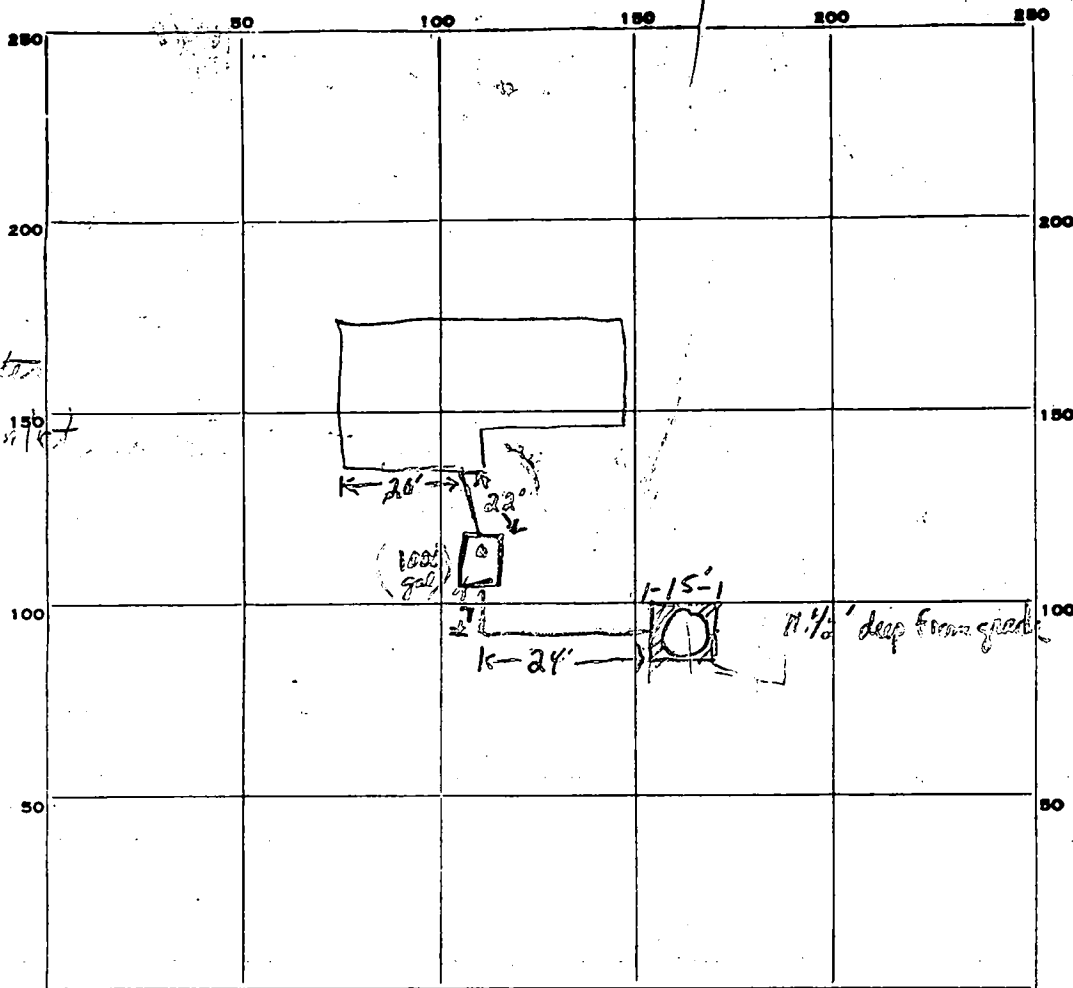

INDICATE NORTH. - NAME ADJOINING ROADWAY AS BASE LINE.

Queen Street

PERMIT CARD ☒

SEPTIC TANK, LEVEL ☒

CLEANOUTS

ST	DW
☒	☒

DISTRIBUTION BOX, LEVEL

TILE FIELD, DEPTH _____ FT. TRENCH WIDTH _____ FT.

GRAVEL DEPTH _____ IN. TOTAL LENGTH _____ FT.

NUMBER OF TRENCHES _____ TOTAL BOTTOM AREA _____

SEEPAGE PITS, INSIDE DIAMETER 60 FT. DEPTH BELOW INLET 7 1/2 FT.

ABSORBENT AREA 450 SQ. FT.

REMARKS

Red pipe cleanouts DW lid must depth is critical must be at 4' as DW is only 11.5' deep RAB 7.6.77

DATE SYSTEM APPROVED

2/2/77

INSPECTOR

RAB & T.O.

RECORDED

APPLICATION

A 24114

SEWAGE DISPOSAL TESTING

P _____

STATE OF MARYLAND - DEPARTMENT OF HEALTH AND MENTAL HYGIENE

HOWARD COUNTY HEALTH DEPARTMENT
ENVIRONMENTAL HEALTH SERVICES

DISTRICT 5th

P. O. BOX 476, ELLICOTT CITY, MARYLAND 21043
TELEPHONE: 465-5000, EXT. 356

DATE 10/4/76

1000 gal Tank

DRY WELL - ~~200~~⁴⁰⁰ 30 ft redwood away
 DRY WELL INLET 4 FT DEEP } Relined
 BOTTOM OF DW 12 ft DEEP } on grade
 Place DW ~~12~~⁹⁰ ft from front lot line
 & 45 ft from Right side of the lot
 TO THE COUNTY HEALTH OFFICER
 ELLICOTT CITY, MARYLAND as seen when facing lot

I, HEREBY, APPLY FOR THE NECESSARY TEST IN ORDER TO CONSTRUCT (OR RECONSTRUCT) A SEWAGE
 DISPOSAL SYSTEM.

PROPERTY OWNER Phillip M. Brown Howard Wessel

ADDRESS 3136 East Normandy Woods Drive PHONE 725-4906 461-2274
Ellicott City, Md.

PROPERTY LOCATION:

SUBDIVISION Kings Manor LOT NO. 6

ROAD AND DESCRIPTION Queen Street - off Pindell School Road

SIZE OF LOT 40,000 sq. ft. TYPE BLDG. 3 BR 3 bedrooms

NUMBER OF BEDROOMS

IF NOT SINGLE RESIDENCE DESCRIBE _____

THE SYSTEM INSTALLED UNDER THIS APPLICATION IS ACCEPTABLE ONLY UNTIL PUBLIC
 FACILITIES BECOME AVAILABLE.

SIGNATURE OF APPLICANT /s/ Phillip M. Brown BLDG. PERMIT SIGNED
 AND RETURNED 2/16/77
Serial No. 30883

APPROVED BY RH & RB FOR DRY WELL DATE 12/8/76
 (KIND OF SYSTEM)

REJECTED BY _____ FOR _____ DATE _____
 (KIND OF SYSTEM)

HOLD PENDING FURTHER TESTS _____ DATE _____

REASONS FOR REJECTION OR HOLDING _____

THIS IS NOT A PERMIT


A hand-drawn map on a grid background. The map shows a path with several points and distances:

- Point 1 is a sun-like symbol with rays, located in the upper right quadrant.
- Point 2 is a circle with a dot inside, located in the lower center.
- Point 3 is a circle with a dot inside, located in the lower left.
- Point 4 is a small circle, located between Point 1 and Point 3.
- Point 5 is a small circle, located in the upper left quadrant.
- Distances are marked along the path:
 - 12 between Point 1 and Point 2.
 - 59 between Point 2 and Point 3.
 - 45 between Point 5 and Point 3.
 - 102 between Point 5 and Point 1.
 - 102 between Point 1 and Point 2.
- There are also some other markings: a small circle in the upper right, a small circle in the lower left, and a small circle in the lower center.

ME ADJOINING ROADWAY AS
QUEEN ST

6

AZ4114

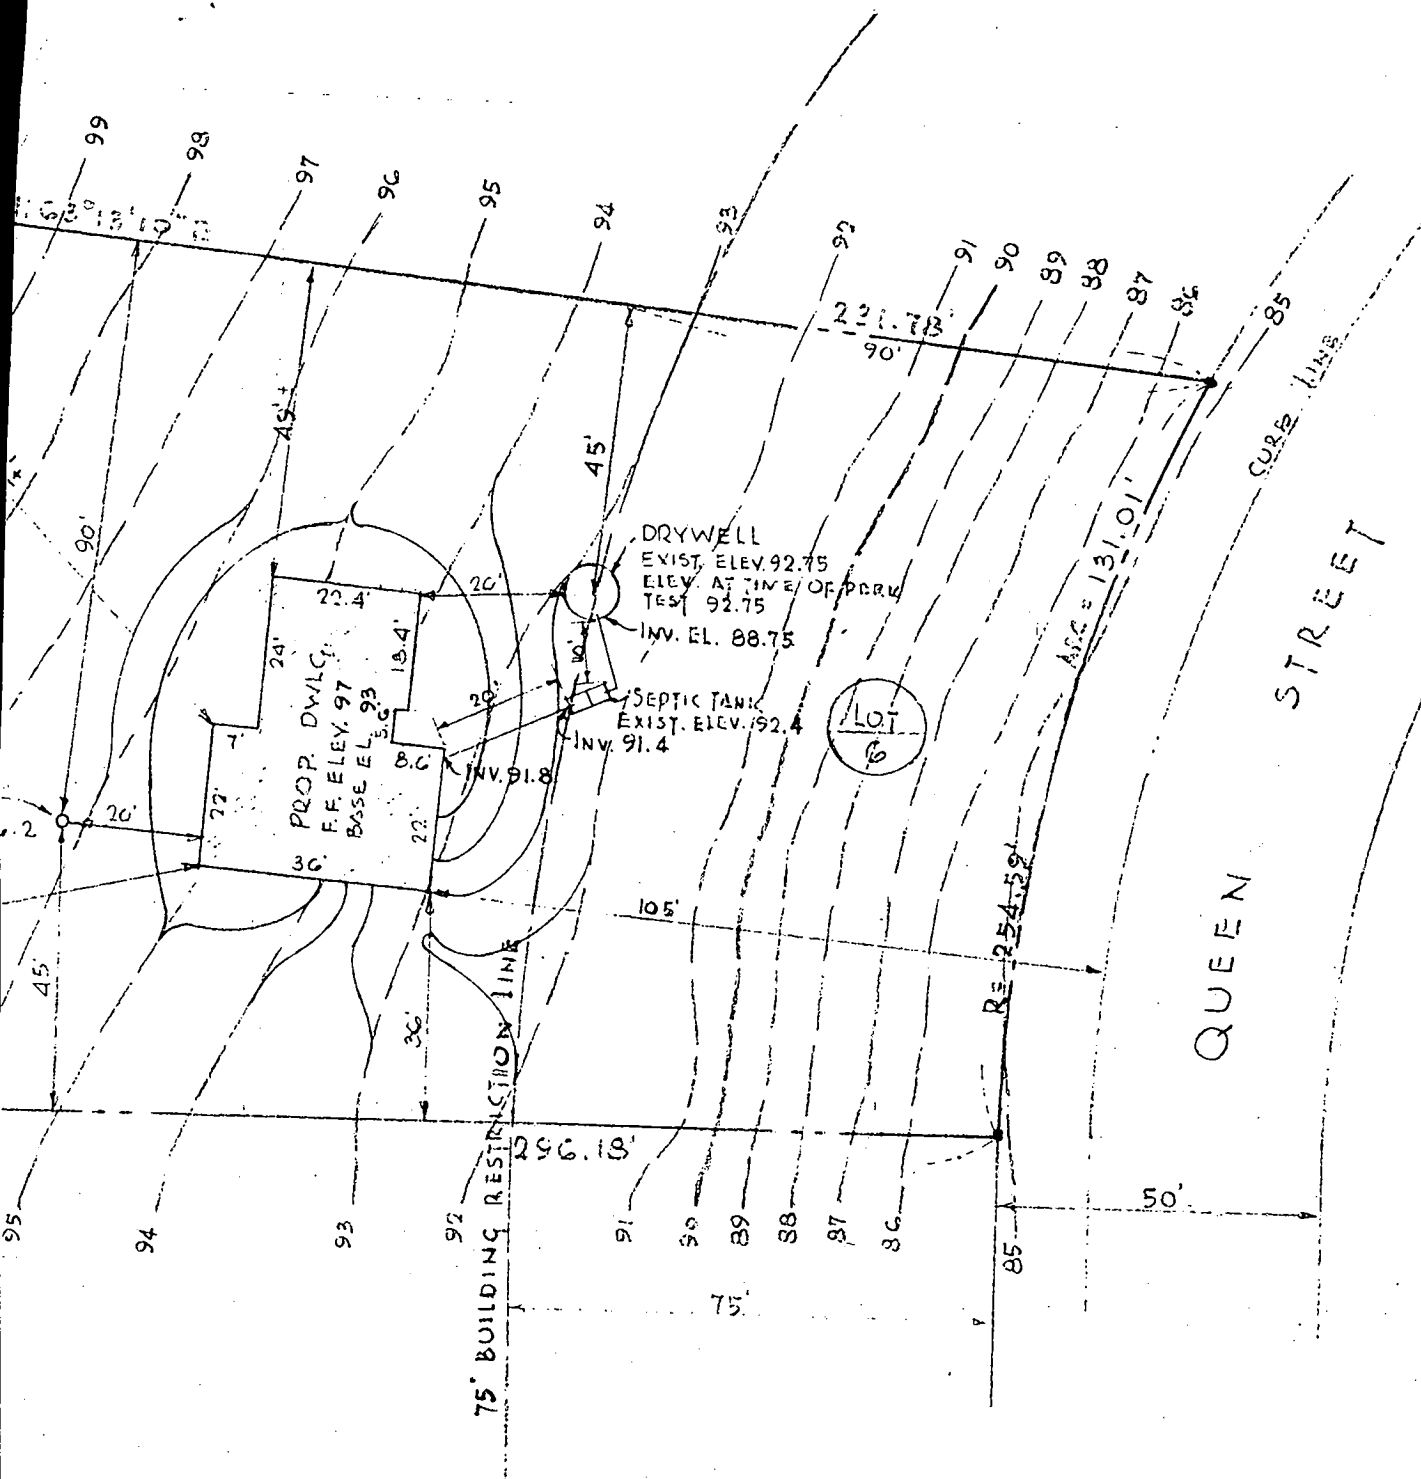

1/26/77-PLANS OK BX



— PROPERTY OF —
MR. & MRS. HOWARD L. W.
"KING'S MANOR"

5TH DIST. DIST. HOWARD COUNT
PLAYBOOK W.H.H. NO. 9 FOLIO 52

1/13/77 12/20/76 12/20/76

