

10/6/00 3:30
RPS# 313259

PERMIT

SEWAGE DISPOSAL SYSTEM HOWARD COUNTY HEALTH DEPARTMENT BUREAU OF ENVIRONMENTAL HEALTH

P. 514236

A REPAIR

ISSUE DATE 9-8-00

410-313-2640

APPROVAL DATE 11/5/00

James Beck

IS PERMITTED TO INSTALL ☐ ALTER ☒

ADDRESS 784 W. Watersville Road, Mt. Airy, MD 21771 PHONE 301-252-7471

SUBDIVISION Dickey Property LOT NUMBER 13 ADDRESS 784 West Watersville Road

PROPERTY OWNER James Beck PROPERTY OWNER'S ADDRESS Same

SEPTIC TANK CAPACITY 1250 GALLONS (Top Seamed)

PUMP CHAMBER CAPACITY NA GALLONS

NUMBER OF BEDROOMS 3 bdrm -

SQUARE FEET PER BEDROOM 210 ÷ 3 ft deep sidewalk = 70 LF/br

LINEAR FEET OF TRENCH REQUIRED Recommend 240 LF of trench (210 LF is acceptable)

BUILDING PERMIT SIGNED

AND RETURNED

8-19-03 BOD MB239 - GARAGE

TRENCHES: Trenches to be 2 feet wide. Inlet 3 feet below original grade. Bottom maximum depth 6-6 1/2 feet below original grade. 3 feet of stone below distribution box.

LOCATION:

REPAIR - PURPOSE - To move septic tank in support of Building Permit # B00125795

Install recommended length of trench on contour, at least 10 ft spacing between trenches (center to center) and first trench at least 7 ft (nearest edge to edge) from sidewalk of old dry well (to be abandoned, collapsed & filled). Connect new trenches with a distribution box. Use a Top Seamed Septic Tank 10/3/00

PLANS APPROVED Ronald P. [Signature] DATE 10/3/00

PERMIT VOID AFTER 2 YEARS

NOTE: CONTRACTOR RESPONSIBLE FOR SCHEDULING A PRE-CONSTRUCTION INSPECTION FOR ALL INSTALLATIONS

NOTE: TOP OF SEPTIC TANKS ARE TO BE NO DEEPER THAN 3.0 FEET BELOW FINISH GRADE

NOTE: WATERTIGHT SEPTIC TANKS REQUIRED

NOTE: CLEANOUT REQUIRED EVERY 70 FEET OF SEWER LINE AND/OR AT 90° SWEEPS IN LINES FROM HOUSE TO DRAIN FIELDS, 90° ELBOWS ARE NOT ACCEPTABLE

NOTE: ALL PARTS OF SEPTIC SYSTEMS (I.E. TANK, DISTRIBUTION BOX, DRAINFIELDS) TO BE 100 FEET FROM ANY WATER WELL UNLESS OTHERWISE SPECIFICALLY AUTHORIZED

NOTE: NO ABSORPTION TRENCH TO EXCEED 100 FEET IN LENGTH UNLESS SPECIFICALLY AUTHORIZED

NOTE: ALL PIPE FROM HOUSE TO SEPTIC TANK MUST BE CAST IRON OR SCHEDULE 35/40 PVC OR ABS

NOTE: MANHOLE RISERS REQUIRED ON ALL SEPTIC TANKS AND PUMP CHAMBERS

NOTE: DISTRIBUTION BOXES MUST HAVE BAFFLES

NOTE: IF PUMPED SEPTIC SYSTEM REQUIRED, (1) SEPTIC PUMP DETAIL TO BE PROVIDED BY INSTALLER PRIOR TO ISSUANCE OF SEPTIC PERMIT (2) PUMP PERFORMANCE TEST IS NECESSARY PRIOR TO HEALTH DEPARTMENT APPROVAL OF SEPTIC PERMIT

NEITHER THE HOWARD COUNTY COUNCIL NOR THE HEALTH DEPARTMENT IS RESPONSIBLE FOR THE SUCCESSFUL OPERATION OF ANY SYSTEM

PERMITTEE RESPONSIBLE FOR OBTAINING FINAL APPROVAL ON THIS PERMIT

CALL 410-313-2640 FOR INSPECTION OF SEPTIC SYSTEM

BUILD PERMIT SIGNED

AND RETURNED 11/6/00

Garage B00125795

514236

APPROX. L.25 AC.

8/16/00

EXIST. GAR.

APPEARS TO BE
AN ADD'N SINCE
ORIG. HOUSE CONST.
EX. S.T. 3-4'
BEHIND EX. HOUSE
WALL; TANK REPLACEMENT
& ~~WELL~~ DRAINFIELD
EVAL. REQ'D; NO ONE
HOME TO VERIFY
USE OF EX. GAR.
SPACE (MR)

335.00'

1125°13'14"E

WEST

WATERVILLE

Well 0

(W) Wood Fence

Mac Brien ROAD

567°12'10"E

130.77'

150.06

50' R/W
Others

350.10'

Gravel Drive - Others

528°13'14"E

Note: Wood
Post & Rail Fence
Extends 3' into
Adjoining Fd R/W

Reg. Point
718/722

Iron Pipe
Found



This is to certify that the improvements
indicated hereon are located as shown. This is
not a property line survey and should not be
used as such.

Sourabh Munshi


Azimuth Consultants
and
Land Surveyors
4900 Belair Road
Baltimore Md. 21206

Scale: 1" = 40' Date: 1/20/00

[illegible]

all holes

0 clayed
1 sandy-type
to broken
shale
12 Rock

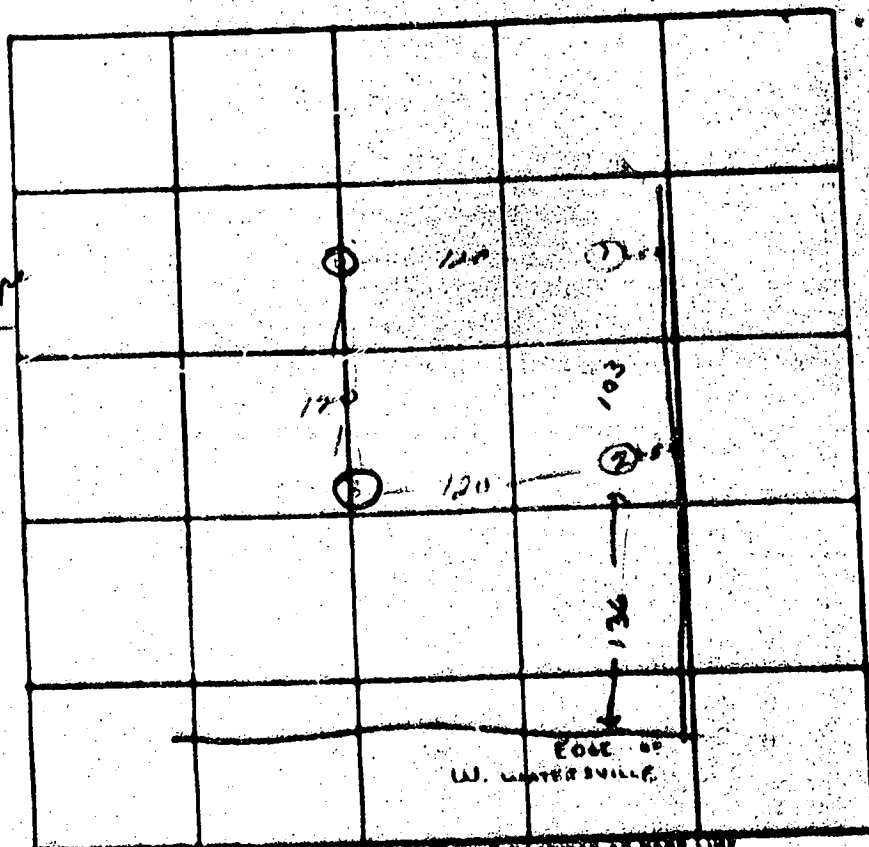

INDICATE WIDTH - BASE ASSUMING ROADWAY AS BASE LINE
ROAD 13

DATE	TEST NO	DEPTH	START	STOP	TEST NO	DEPTH	START	STOP	TIME
7/15/75	1	11	11:07	11:09	15	12	11:09	11:11	
	1-A	12	11:07	11:09	16	12	11:09	11:11	7
	2	3 1/2	11:09	11:11					
	2 A	2	11:09	11:11	17	12	11:11	11:13	10
	1	5	11:39	11:36	18	12	11:36	11:40	10
	2	4 1/2	11:38	11:45	19	12	11:45	11:51	12
	3	12	11:46	11:49	20	12	11:49	11:56	7
	11-A	12	11:47	11:48	21	12	11:48	11:51	3

1210 mm
1150/BR
+
200 + 230
↓
1400/BR

REMARKS #1-11 dug to 12' then hand rock
TYPE OF SOIL


19/3/60

48 C & owner 766 W. Lakeside Rd

P5/4236

Repair

-784 W. Watersville Rd

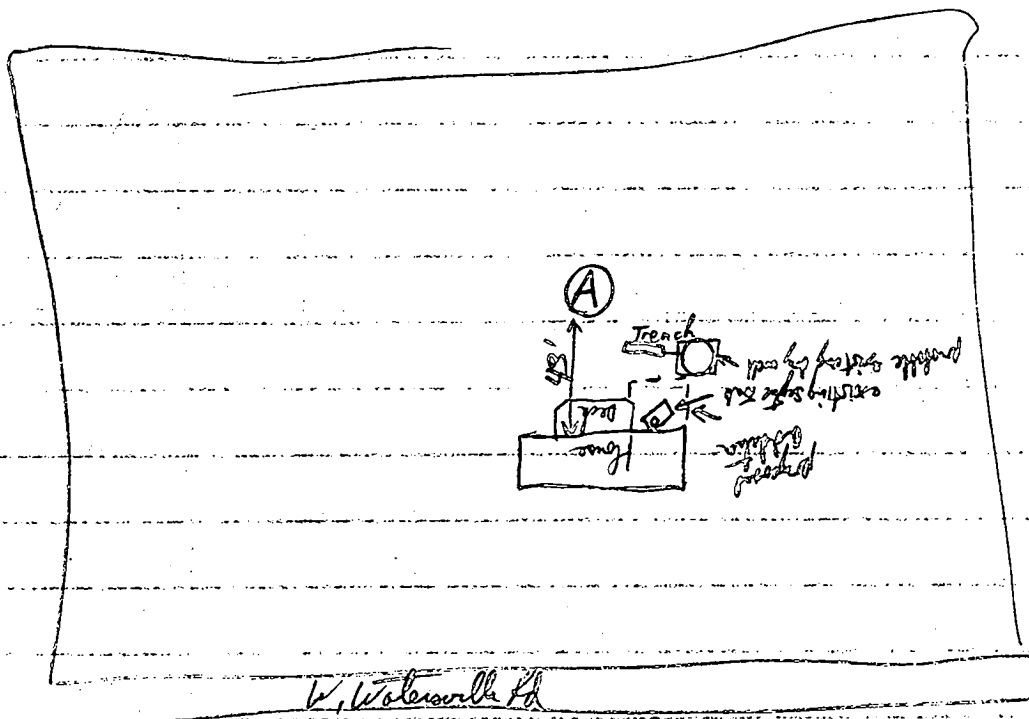

pers

@ 3½'

6 1/2'

Top Mail

1:40:00

11:05:00

2nd Mail

1:49:00

1:09:00

37 miles

1:16:00

~~Impi~~

174 dry soil - yellow-brown ch. CL
horizon in top 25 ft.

Test Hole A

3/1 Barb Branch Sil

gelben chsill

2 1/2 yelkt-bray/bray
oh hL

4" Mix colors
Bury, Red Bury, Creamy
peach
ch L

chances

vary
ex. v. f. = 20%
f = 10-15%

10



HOWARD COUNTY HEALTH DEPARTMENT

Diane L. Matuszak, M.D., M.P.H., County Health Officer

August 16, 2000

James Beck
784 West Watersville Road
Mt. Airy, MD 21771

RE: Building Permit Application B00125795
784 West Watersville Road
Dickey Property, Lot 13
Proposed Addition

Dear Mr. Beck:

This office has received the above referenced building permit application, but cannot recommend approval at this time because of concerns about the location of the proposed addition relative to the existing septic tank.

A field inspection conducted this date reveals that the existing septic tank is located three to four feet directly behind the existing garage. A structural expansion to the rear would require prior replacement of the existing septic tank to a location which provides the minimum ten feet of required separation distance.

A Health Department recommendation for approval is contingent upon issuance of a septic system repair permit (\$25 fee), septic tank replacement, inspection of your septic drainfield capacity for adequacy/saturation, and, if necessary, installation of additional septic system drainfield capacity. The process is best completed through a professional septic contractor prior to building permit issuance.

Please contact this office at (410) 313-2640 if you have any questions or to arrange permit issuance.

Very Truly Yours,

Mark E. Rifkin, R.S.

Water & Sewerage Program

MR

cc: Department of Inspections, Licenses & Permits
File

PERMIT

SEWAGE DISPOSAL SYSTEM

MARYLAND STATE DEPARTMENT OF HEALTH

HOWARD COUNTY

ELLCOTT CITY

DISTRICT 6th

DATE 10/17/75

INDEXED

William Hopkins

IS PERMITTED TO INSTALL ☒ ALTER

ADDRESS Jennings Chapel Road, Woodbine, Maryland 21797 PHONE 402-1711

A SEWAGE DISPOSAL SYSTEM LOCATED AT

SUBDIVISION ROAD West Watersville Road LOT 11

PROPERTY OWNER Dickey Farms, Inc.

ADDRESS Foreythe Road, Bytownville, Md.

SPECIFICATIONS 3 bedrooms

DRAIN FIELD DEPTH FEET, BOTTOM AREA SQ. FT.

SEEPAGE PITS ABSORBENT SIDE WALL AREA SQ. FT.

SEPTIC TANK CAPACITY 1000 GALLONS

FOR GARBAGE GRINDER, INCREASE DISPOSAL AREA 25% & TANK CAPACITY 50%.


OTHER DRY WELL AND TRENCH - Dig pit 12' x 12' x 10 ft. deep. Set block for 10 ft. 114. Gravel space between block and pit wall with No. 8 stone. Inlet into dry well no deeper than 4 ft. Locate dry well 60 ft. from right lot line, 135 ft. from West Watersville Road, as seen when facing lot from road. Leave 5 ft. solid earth buffer between dry well and trench. Dig trench 30 ft. long, 10 ft. deep, with 2 ft. of stone under distribution pipe. Run trench from left side of dry well, parallel to West Watersville Road, following contour of ground. CALL FOR INSPECTION OF TRENCH BEFORE GRAVEL IS INSTALLED. NOTE: ALL PIPE FROM HOUSE TO DISPOSAL AREA MUST BE CAST IRON. TRENCH VOID AFTER THREE YEARS. NOTE: INSTALL 6" DRAIN PIPE ON SEPTIC TANK AND DRY WELL. DRAIN PIPES MUST BE 6 INCHES IN DIAMETER. CAST IRON, CONCRETE OR TERRA COTTA ACCEPTED.

PLANS APPROVED BY William W. Epp DATE 8/1/75

FILL SEPTIC TANK AND DISTRIBUTION BOX WITH WATER BEFORE CALLING FOR AN INSPECTION. COVER IS WORK UNTIL INSPECTED AND APPROVED.

NEITHER THE HOWARD COUNTY COMMISSIONERS NOR THE HEALTH DEPARTMENT IS RESPONSIBLE FOR THE SUCCESSFUL OPERATION OF ANY SYSTEM.

21855

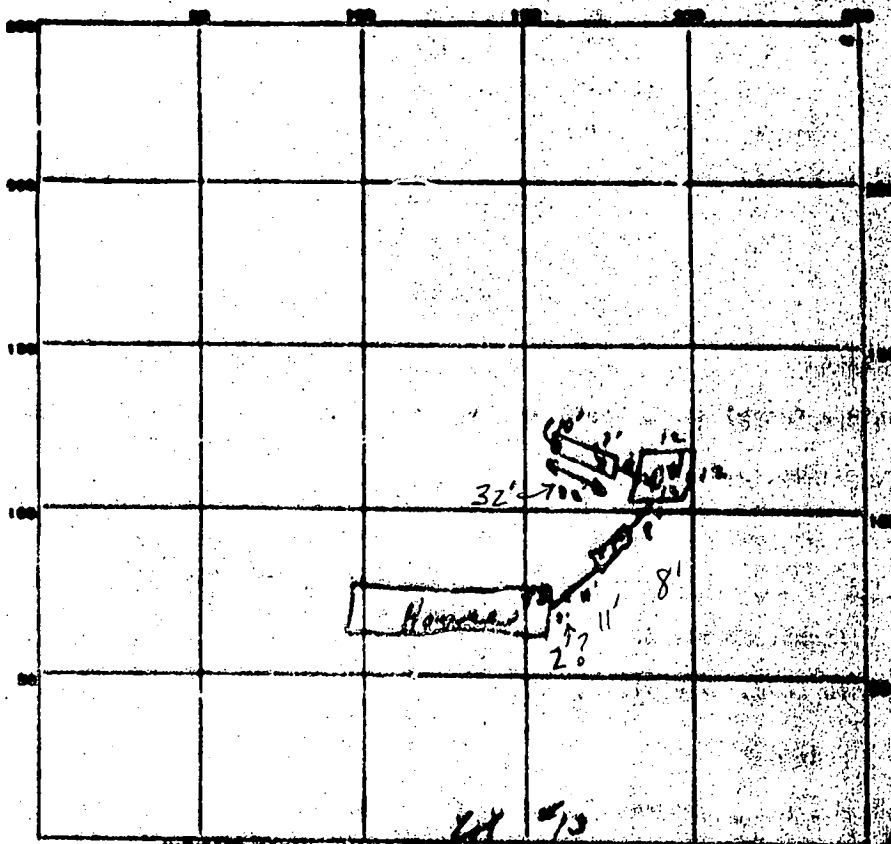

INSEWER NORTH - NAME ADDRESS ROADWAY AS PER PERMIT

PERMIT CARD

SEPTIC TANK, LEVEL

CLEANOUT

DISTRIBUTION SOL. LEVEL

TILE FIELD, DEPTH 5 1/2 FT. TRENCH WIDTH 18 IN.

GRAVEL DEPTH 5 1/2 IN. TOTAL LENGTH 32 FT.

NUMBER OF TRENCHES 1 TOTAL BOTTOM AREA

SEEPAGE PYS. INSIDE DIAMETER 18 IN. DEPTH BELOW INLET 5 1/2 FT.

ABSORBENT AREA 440 SQ. FT.

REMARKS

11/14/25 Trench at ground 32' long
deep - about 4'-4 1/2'; 11/17/25 Trench at ground 32' long
Trench checked 11/17/25. Also checked 11/17/25.

App'd 11/17/25

C. B. Streaker

APPLICATION

SEWAGE DISPOSAL TESTING

STATE OF MARYLAND · DEPARTMENT OF HEALTH AND MENTAL HYGIENE

HOWARD COUNTY HEALTH DEPARTMENT
ENVIRONMENTAL HEALTH SERVICES

P. O. BOX 470, ELLICOTT CITY, MARYLAND 21043
TELEPHONE: 469-3000, EXT. 300

DISTRICT 8

DATE 7/17/78

TO: THE COUNTY HEALTH OFFICER
ELLICOTT CITY, MARYLAND

I, HEREBY, APPLY FOR THE NECESSARY TEST IN ORDER TO CONSTRUCT (OR RECONSTRUCT) A SEWAGE DISPOSAL SYSTEM.

PROPERTY OWNER Edney Farms, Inc.

ADDRESS _____ PHONE any questions call:
John Schindler
469-7977

PROPERTY LOCATION:

SUBDIVISION _____ LOT NO. 12

ROAD AND DESCRIPTION N. Westerville Road

SIZE OF LOT 1.221 acres TYPE BLDG. 1.5 x 4

IF NOT SINGLE RESIDENCE DESCRIBE _____ (100' x 60' x 20')

THE SYSTEM INSTALLED UNDER THIS APPLICATION IS ACCEPTABLE ONLY UNTIL PUBLIC FACILITIES BECOME AVAILABLE.

SIGNATURE OF APPLICANT /s/ John Schindler

APPROVED BY _____ FOR _____ DATE _____
(KIND OF SYSTEM)

REJECTED BY _____ FOR _____ DATE _____
(KIND OF SYSTEM)

HOLD PENDING FURTHER TESTS _____ DATE _____

REASONS FOR REJECTION OR HOLDING _____


THIS IS NOT A PERMIT

8-18-03
ANYTIME

SITE INSPECTION SHEET

OWNER: James Beck PHONE #: 301-252-7471
ADDRESS: 784 W. Watersville Rd CONTRACTOR: N/A
WELL TAG #: _____
SUBDIVISION: Dickey Farms LOT: 13 COUNTY #: _____
PROPOSAL: BP 00143239 - Garage

LOCATION DIAGRAM

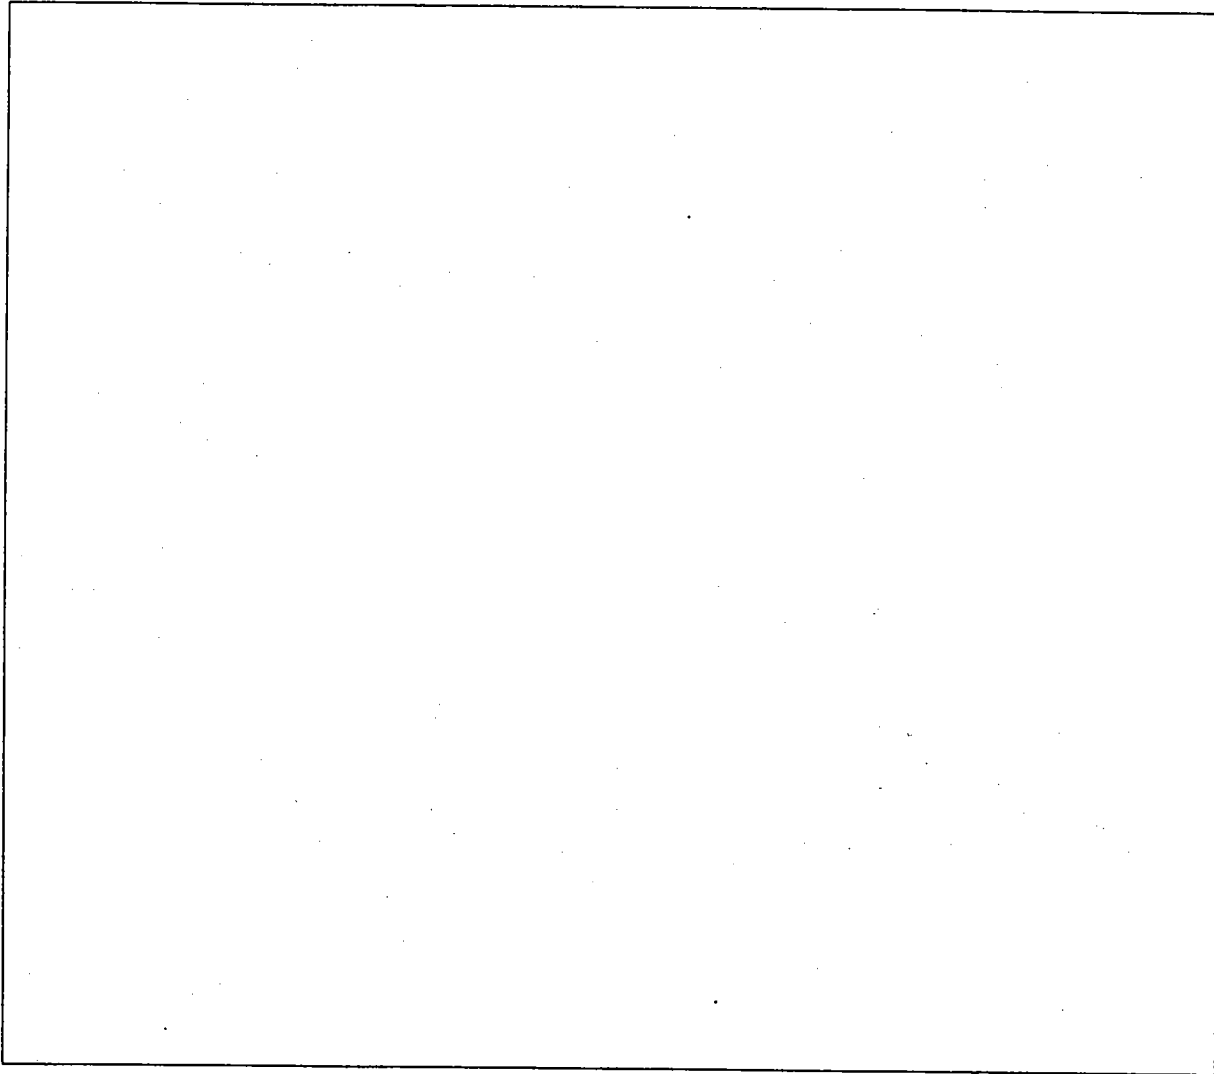

COMMENTS: _____


DATE: _____ INSPECTOR: _____



TDL, LIMITED

16. FREDERICK AVENUE
GAITHERSBURG, MARYLAND 20877
(301) 840-9747

301-252-7471

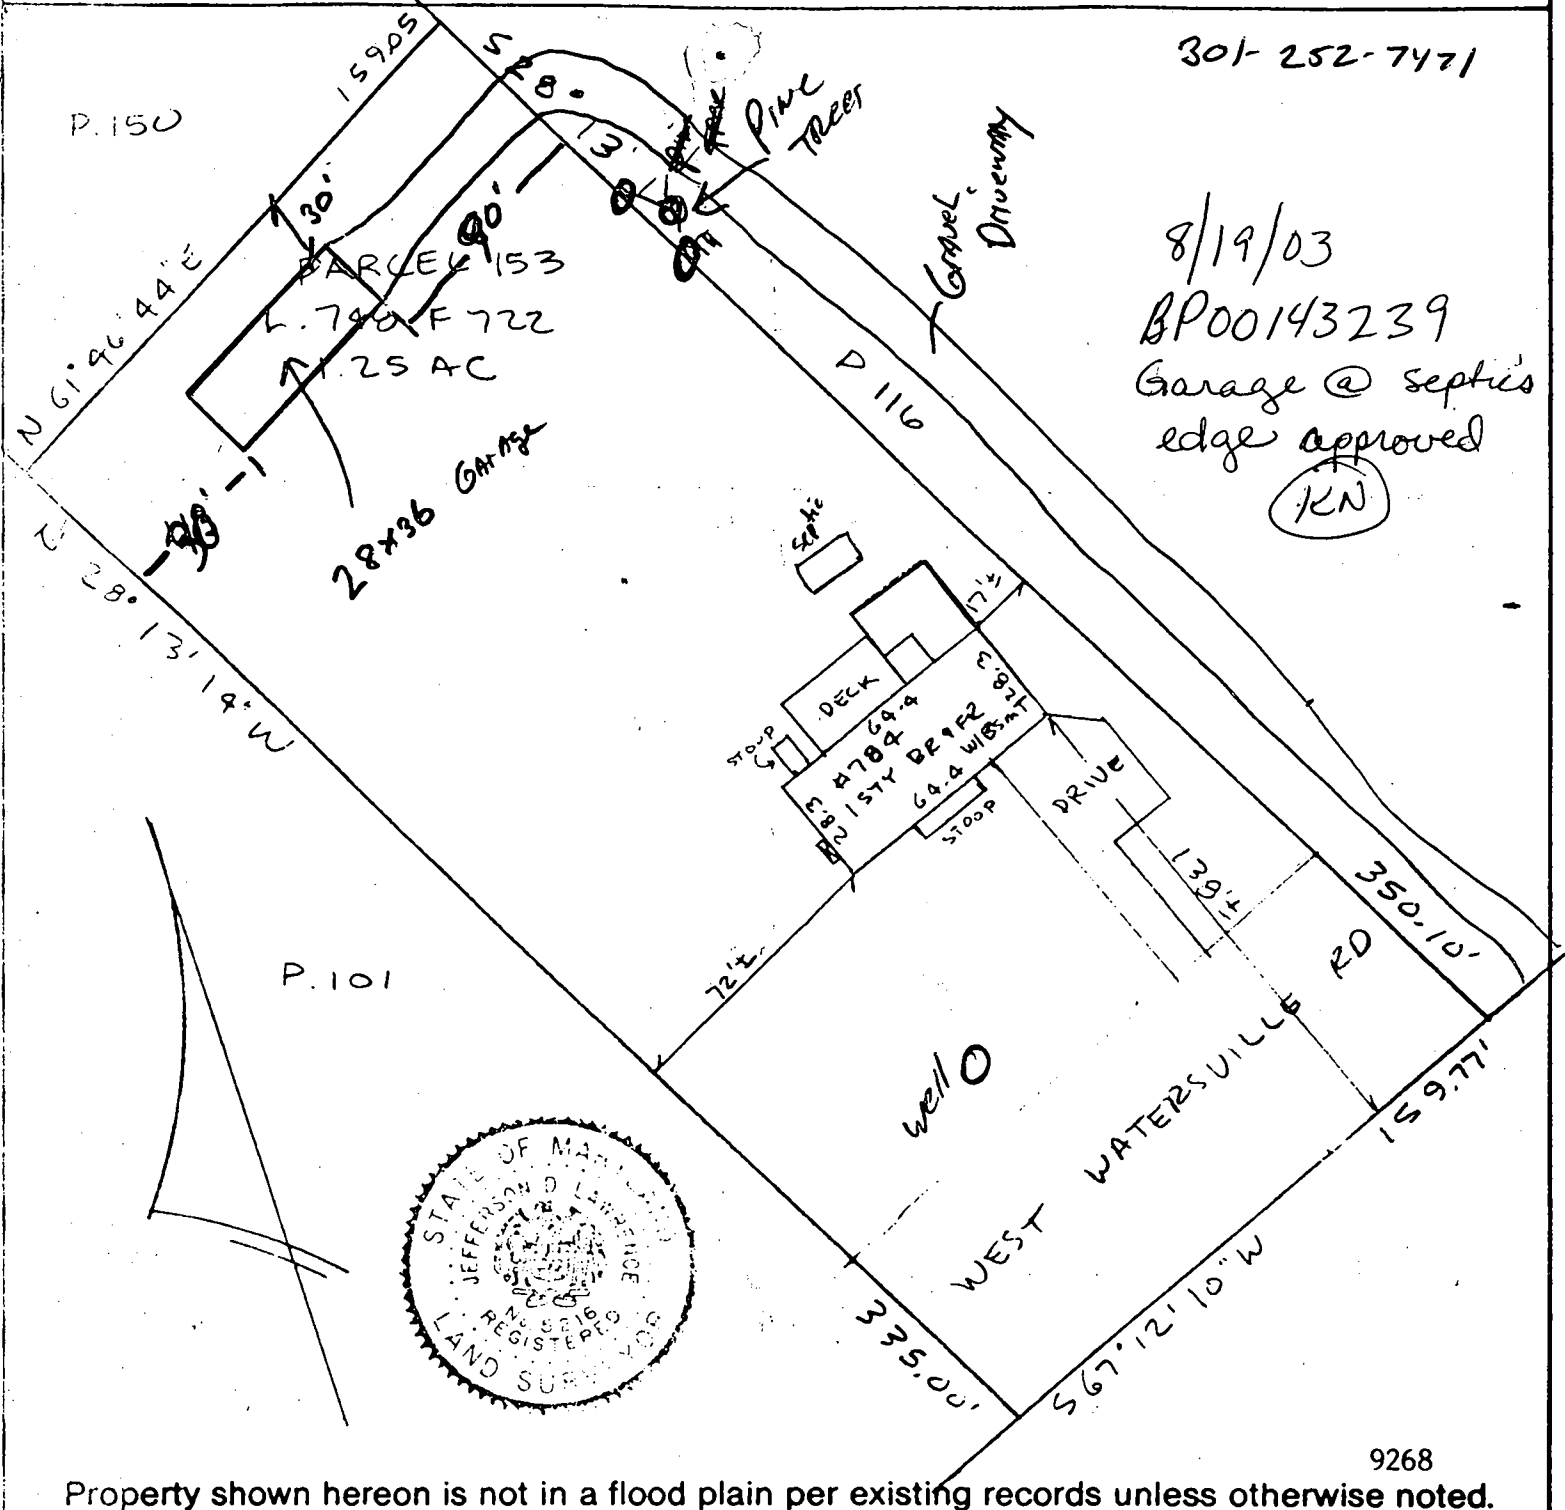

8/19/03
BP00143239
Garage @ septic
edge approved
(1KN)



Property shown hereon is not in a flood plain per existing records unless otherwise noted.

SCALE: 1" = 50'
RECORDED IN:
PLAT BOOK: LIBER: 748
PLAT: FOLIO: 722

NOTE: This drawing is not intended to establish property lines nor are the existence of corner markers guaranteed. All information shown hereon taken from the land records of the county in which the property is located. Do not attempt to erect fences from information contained on this drawing.

HOUSE LOCATION
PARCEL 153
784 WEST WATERSVILLE ROAD
HOWARD COUNTY, MD

I hereby certify that to the best of my knowledge and belief, the position of all the existing improvements on the above described property has been established by accepted field practices.

Date: January 15, 1992

Jefferson D. Lawrence
JEFFERSON D. LAWRENCE,
PROFESSIONAL LAND SURVEYOR #5216

THIS DRAWING TO BE USED FOR TITLE PURPOSES ONLY

TQL, LIMITED


16. . FREDERICK AVENUE
GAITHERSBURG, MARYLAND 20877
(301) 840-9747

41D-604-2282

8/14/03 Lim.

SEE ATTACHED SHEET (OLD)
with SDA LOCATION. Is it
possible to place the
garage closer to the right
lot line (ie: 30' off?) or
is there a topographical
issue?? CALL ME
IF YOU NEED TO
DISCUSS OPTIONS.

Thanks,
Kacie

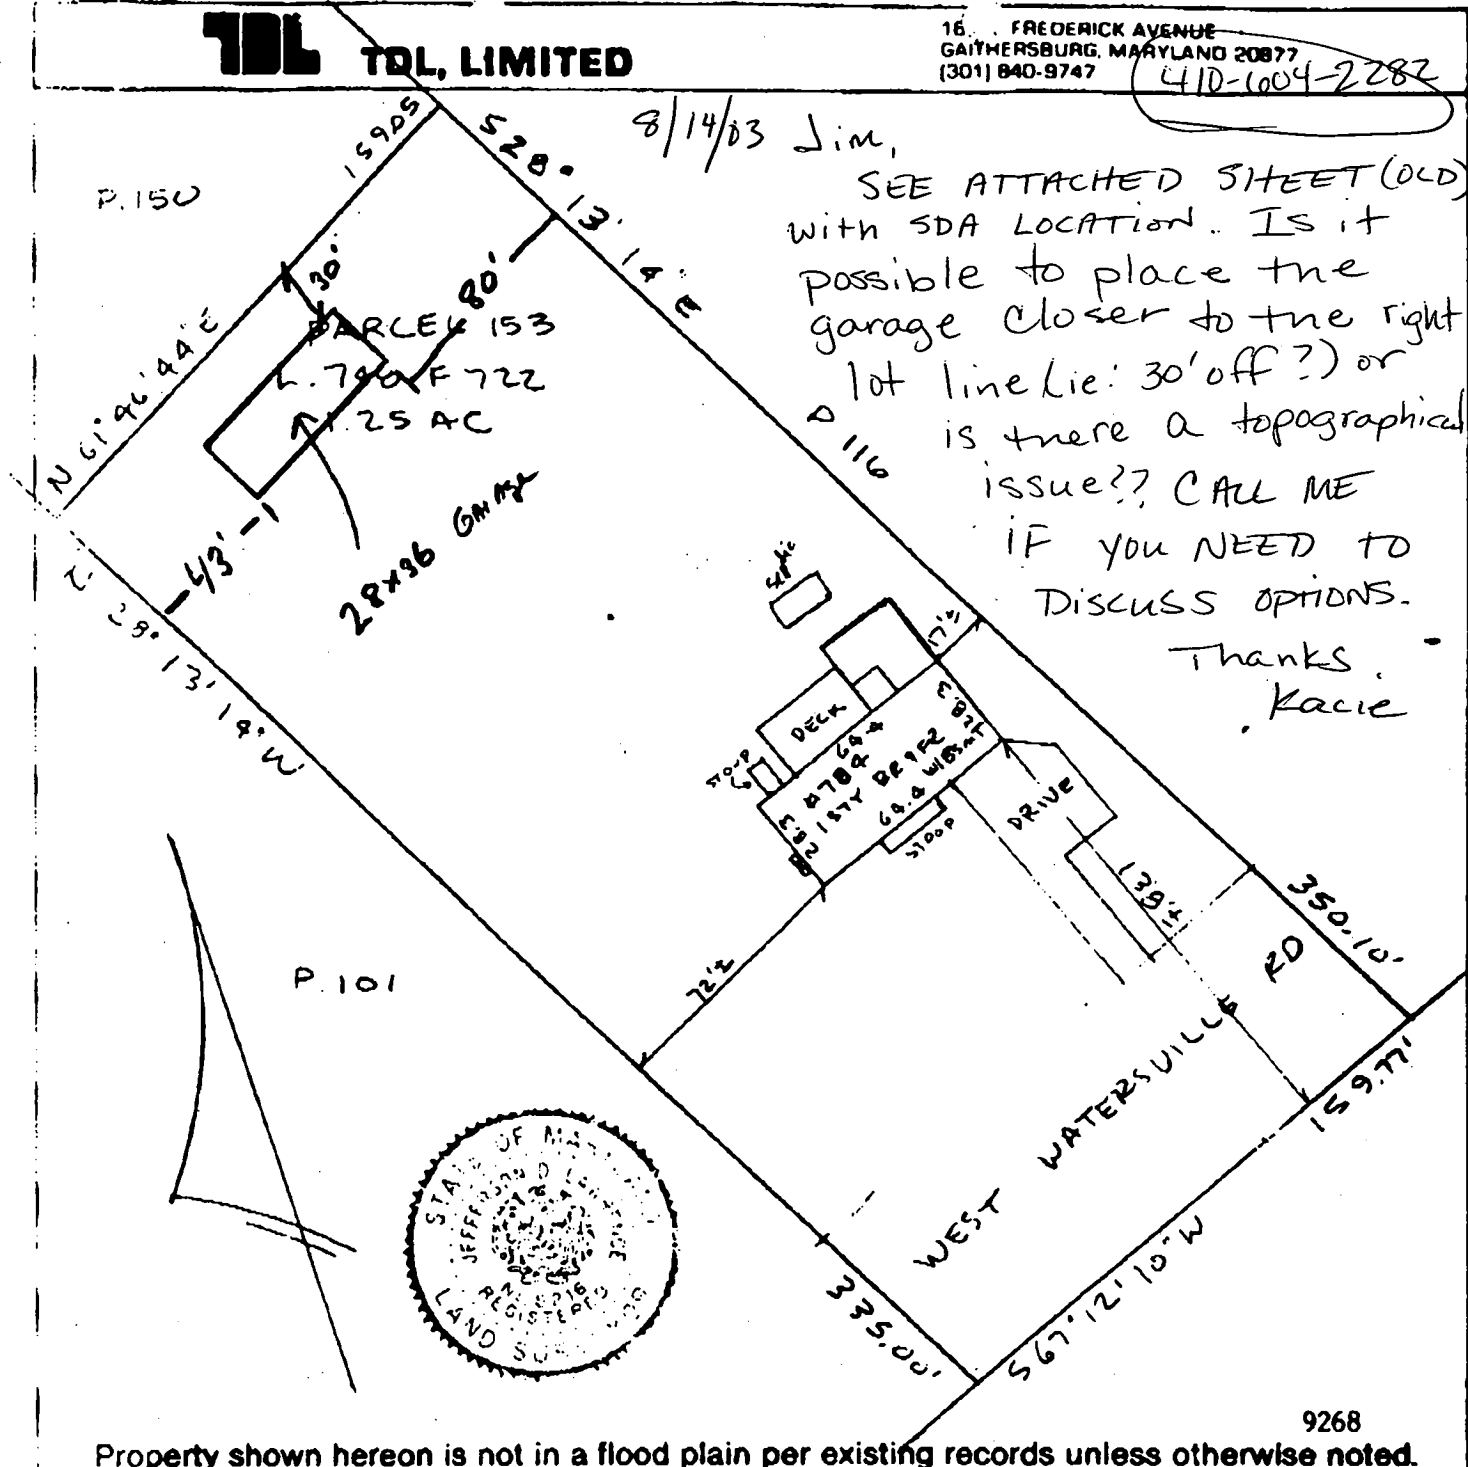

9268

Property shown hereon is not in a flood plain per existing records unless otherwise noted.

NOTE: This drawing is not intended to establish property lines nor are the existence of corner markers guaranteed. All information shown hereon taken from the land records of the county in which the property is located. Do not attempt to erect fences from information contained in this drawing.

HOUSE LOCATION

PARCEL 153
784 WEST WATERSVILLE ROAD
HOWARD COUNTY, MD

I hereby certify that to the best of my knowledge and belief, the position of all the existing improvements on the above described property has been established by accepted field practices.

Date: January 15, 1992

JEFFERSON D. LAWRENCE,
PROFESSIONAL LAND SURVEYOR #6218

THIS DRAWING TO BE USED FOR TITLE PURPOSES ONLY

1 of 2

Woodbine Blvd
795-1414


[illegible]

I CERTIFY THE ABOVE MEASUREMENTS AND ELEVATION DIFFERENCES ARE ACTUAL AND CORRECT FOR THIS PROPERTY.


SIGNED: Michael P. Marshall

Plat of Property known as #784 West Watersville Road, and recorded among the Land Records of Howard County in Liber 748, Folio 722.

2.25 AC.

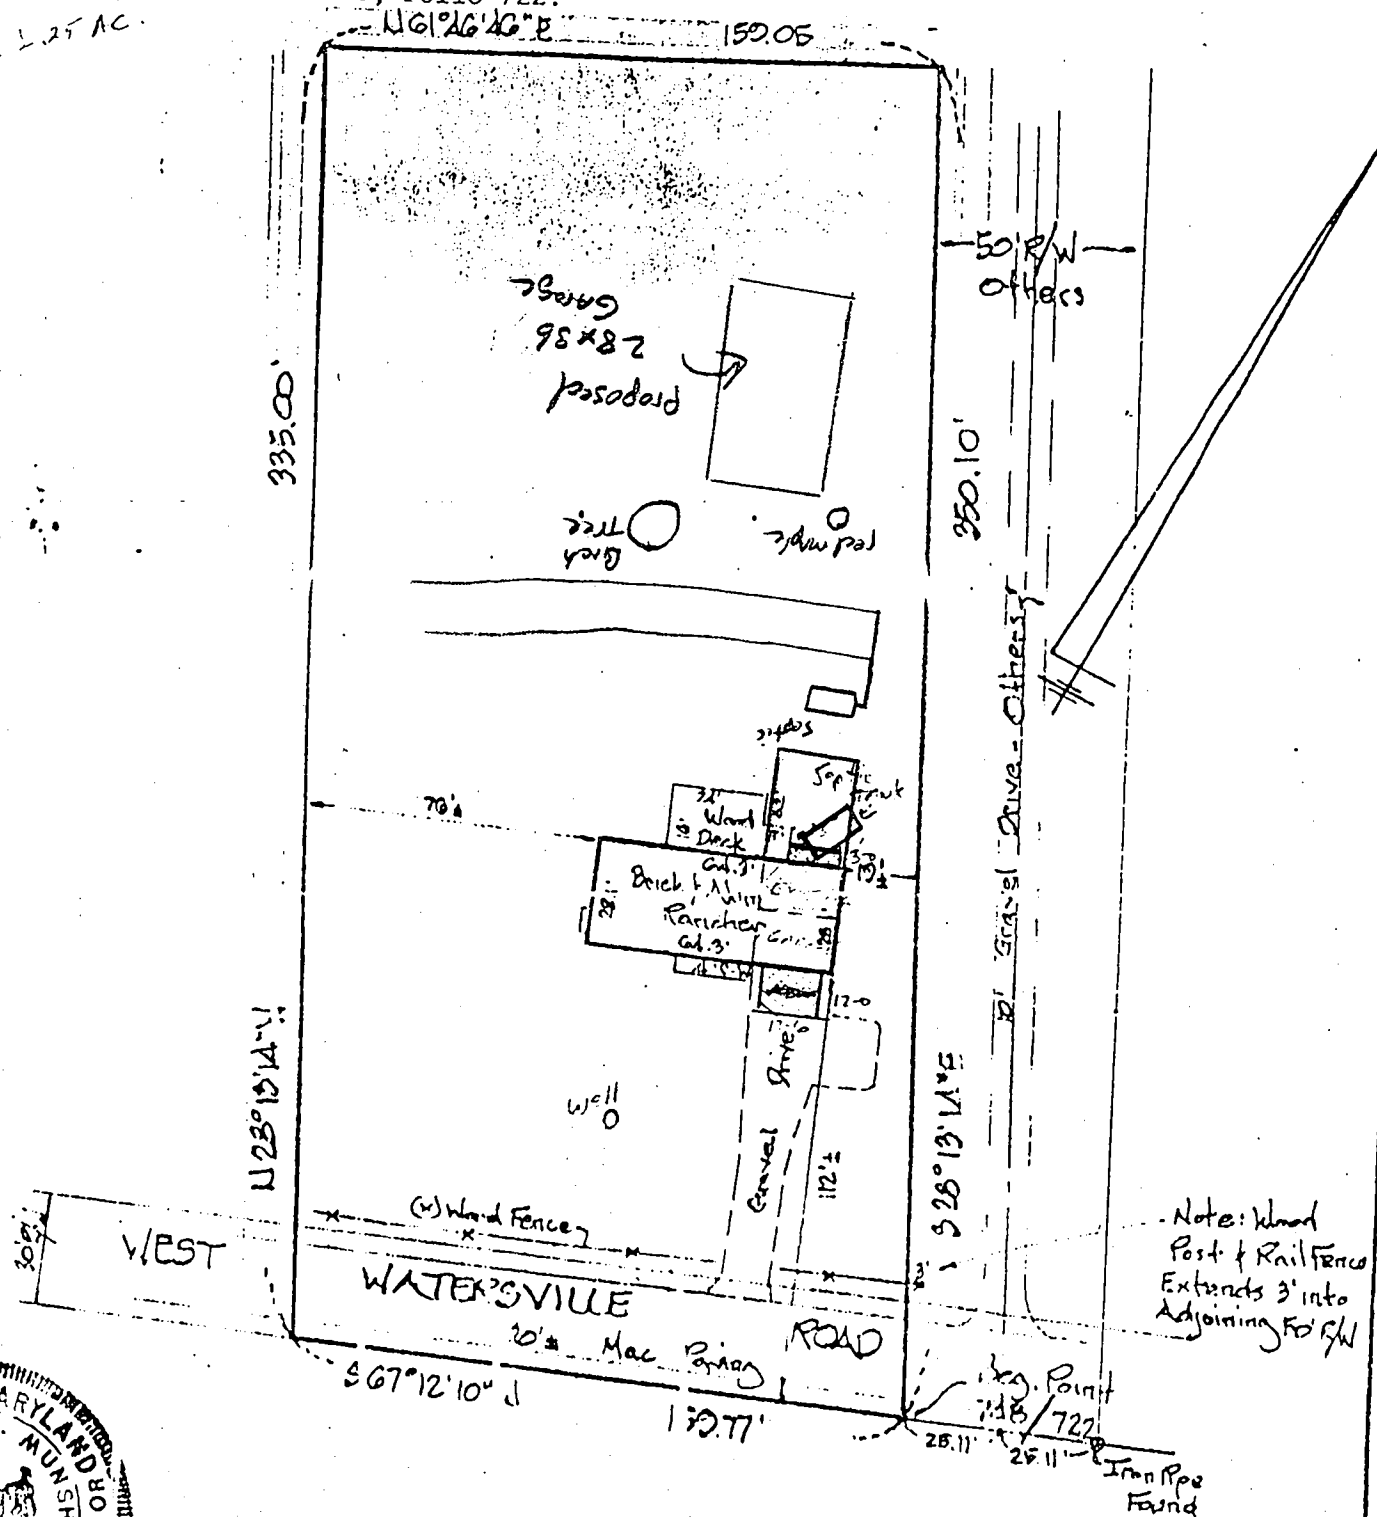

Note: Wood Post & Rail Fence Extends 3' into Adjoining R/W

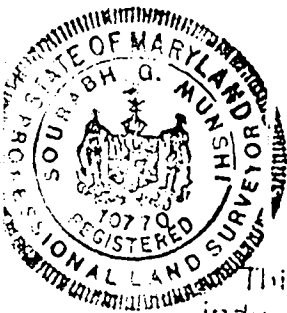

This is to certify that the improvements indicated hereon are located as shown. This is not a property line survey and should not be used as such.


Sourabh Munshi

**Azimuth Consultants
and
Land Surveyors**
4900 Belair Road
Baltimore Md. 21206

Scale: 1" = 40' Date: 1/22/88



William L. Hostel
7/20/75

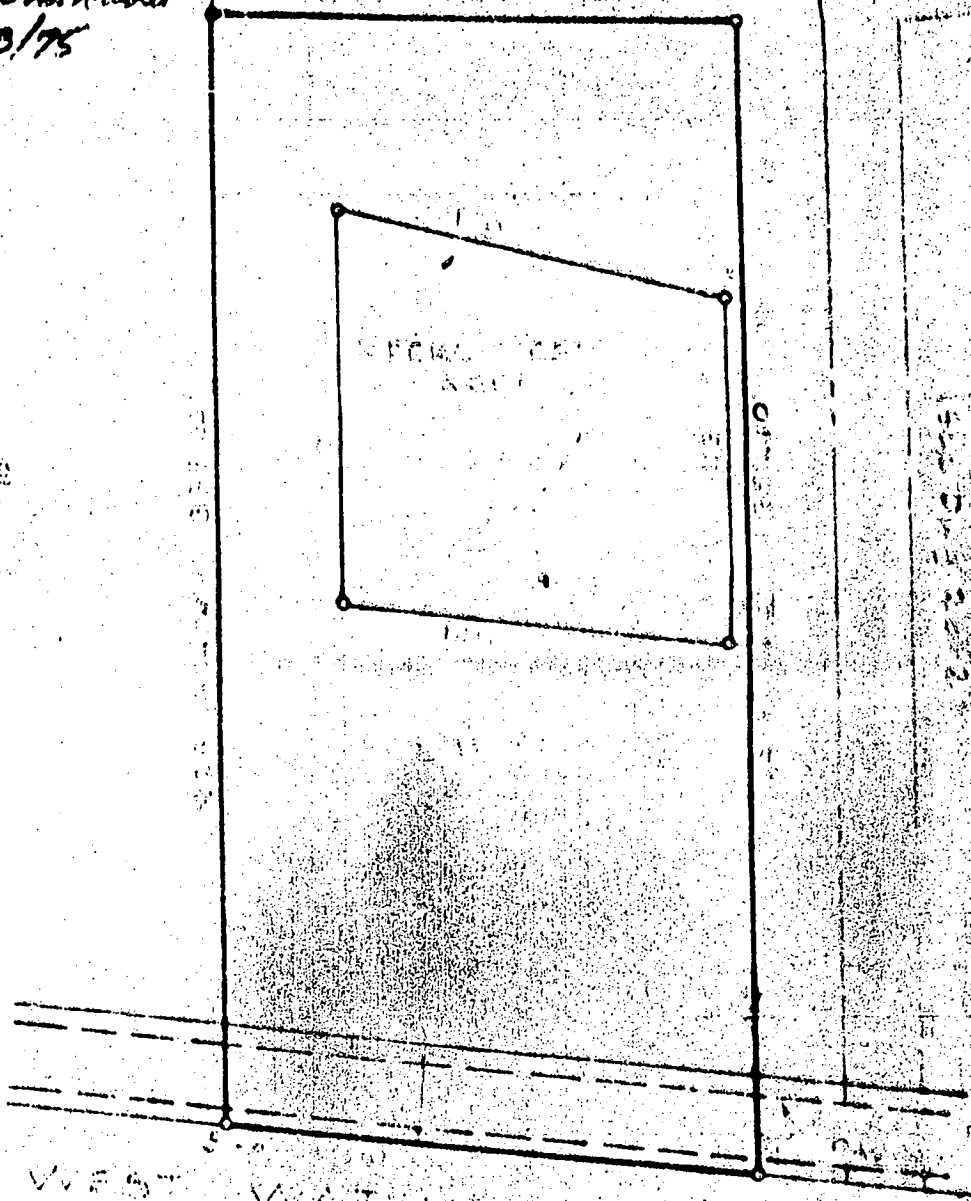

THE BOARD OF HEALTH OF THE CITY OF NEW YORK
HAS REVIEWED THE ABOVE VENTILATION
PLAN AND FINDS IT TO BE IN ACCORDANCE
WITH THE REQUIREMENTS OF THE HEALTH
DEPARTMENT OF HEALTH.

APPROVED PRIVATE WATER AND SEWAGE
SYSTEMS

J. J. J. J. J.

8/26/25

DEPARTMENT OF INSPECTIONS, LICENSES AND PERMITS
3430 COURT HOUSE DRIVE
ELLCOTT CITY, MD 21043
PERMITS (410) 313-2455 INSPECTIONS (410) 313-1810
AUTOMATED INFORMATION (410) 313-3900

HOWARD COUNTY
PERMIT APPLICATION

PERMIT NUMBER

000125795

Building Address 784 West Waterside Rd
MT Airy MD 21771
Suite/Apt. # _____ SDP/WP/Petition # _____
Census Tract 6040 Subdivision Dickey Property
Section _____ Area _____ Lot 13
Tax Map 702 Parcel 153 Grid 19
Zoning RC Map Coordinates 387256 Lot size _____

Property Owner's Name James L. Beck
Address 784 West Waterside Rd
City MT Airy State MD Zip Code 21771
Home Phone 301 607 5200 Work Phone 301 252 7971
Applicant's Name & Mailing Address, (if other than stated hereon):
410-829-3803
Phone _____ Fax _____

Existing Use SFD
Proposed Use SFD w/ Addl AIT
Estimated Construction Cost \$ 10,000
Description of Work: Finish gald crista garage
rt den add 17x12 addition to
back of garage for garage

Contractor Company OWNER
Contact Person _____
Address _____
City _____ State _____ Zip Code _____
License No. _____
Phone _____ Fax _____

Occupant or Tenant same
Contact Name _____
Address _____
City _____ State _____ Zip Code _____
Phone _____ Fax _____

Engineer or Architect Company _____
Contact Person _____
Address _____
City _____ State _____ Zip Code _____
Phone _____ Fax _____

BUILDING DESCRIPTION - COMMERCIAL

Building Characteristics	Utilities
Height: _____	Water Supply: _____ Public _____ Private _____
No. of stories: _____	Sewage Disposal: _____ Public _____ Private _____
Gross area, sq. ft. per floor: _____	Electric Yes ☐ No ☐ Gas Yes ☐ No ☐
Use group: _____	Heating System: _____ Electric ☐ Oil ☐ Natural Gas ☐ Propane Gas ☐
Construction type: _____ Reinforced Concrete _____ Structural Steel _____ Masonry _____ Wood Frame _____	Sprinkler system: N/A ☐ Full _____ Partial _____ Other Suppression _____ # of Heads _____
State Certified Modular _____	

BUILDING DESCRIPTION - RESIDENTIAL

Building Characteristics	Utilities
SF Dwelling ☒ SF Townhouse ☐ Depth _____ Width _____	Water Supply: _____ Public _____ Private _____
1st floor: _____	Sewage Disposal: _____ Public _____ Private _____
2nd floor: _____	Electric: Yes ☐ No ☐ Gas Yes ☐ No ☐
Basement: _____	Heating System: _____ Electric ☐ Oil ☐ Natural Gas ☐ Propane Gas ☐
Finished Basement ☐ Unfinished Basement ☐ Crawl space ☐ Slab on Grade ☐ No. of Bedrooms: _____	Sprinkler system: N/A ☐ NFPA #13D _____ NFPA #13R _____ Other: _____
Multi-family dwellings: _____ No. of efficiency units: _____ No. of 1 BR units: _____ No. of 2 BR units: _____ No. of 3 BR units: _____	
Other Structure: _____ Dimensions: _____ Footings: _____ Roof: _____ State Certified Modular _____ Manufactured Home _____	

THE UNDERSIGNED HEREBY CERTIFIES AND AGREES AS FOLLOWS: (1) THAT HE/SHE IS AUTHORIZED TO MAKE THIS APPLICATION; (2) THAT THE INFORMATION IS CORRECT; (3) THAT HE/SHE WILL COMPLY WITH ALL REGULATIONS OF HOWARD COUNTY WHICH ARE APPLICABLE THEREON; (4) THAT HE/SHE WILL PERFORM NO WORK ON THE ABOVE REFERENCED PROPERTY NOT SPECIFICALLY DESCRIBED IN THIS APPLICATION; (5) THAT HE/SHE GRANTS COUNTY OFFICIALS THE RIGHT TO ENTER ONTO THIS PROPERTY FOR THE PURPOSE OF INSPECTING THE WORK PERMITTED AND POSTING NOTICES.

Applicant's Signature James Beck
Title/Company OWNER

Print Name James Beck
Date 8-2-00

Checks payable to: DIRECTOR OF FINANCE OF HOWARD COUNTY
** PLEASE WRITE NEATLY AND LEGIBLY **
FOR OFFICE USE ONLY

AGENCY _____ DATE _____ SIGNATURE APPROVAL _____
Land Development DPZ _____
State Highways _____
Building Official _____
Dev Engineering DPZ _____
Health _____
Fire Protection _____
Is Sediment Control approval required prior to issuance?
YES ☐ NO ☐

DPZ SETBACK INFORMATION
Front: _____
Rear: _____
Side: _____
Side St: _____
All minimum setbacks met? YES ☐ NO ☐
Is Entrance Permit required? YES ☐ NO ☐
Is Historic District? YES ☐ NO ☐
Lot Coverage for New Town Zone _____
SDP/Red-line approval date _____

PROPERTY ID: 47420
Filing fee \$ 25
Permit fee \$ 25
Excise tax \$ 0
Sub-total paid \$ 50
Add'l permit fee \$ 0
TOTAL FEES \$ 50
Balance due \$ 0
Check _____
Validation _____

CONTINGENCY CONSTRUCTION START: ☐
ONE STOP SHOP ☐

Distribution of Copies: White: Building Official Green: LDD, DPZ Yellow: DED, DPZ Pink: Health Gold: SHA

21855

DEPARTMENT OF INSPECTIONS, LICENSES AND PERMITS 3430 COURT HOUSE DRIVE ELLICOTT CITY, MD 21043 PERMITS (410)313-2455 INSPECTIONS (410)313-1810 AUTOMATED INFORMATION (410) 313-3800		HOWARD COUNTY PERMIT APPLICATION		PERMIT NUMBER <u>800125795</u>	
Building Address <u>784 West Waterhouse Rd</u> <u>PT 1A, MD 21221</u>			Property Owner's Name <u>James I Beck</u>		
Suite/Apt. #: _____ SDP/WP/Petition #: _____ Census Tract <u>6040</u> Subdivision <u>Dickey Property</u>			Address <u>784 West Waterhouse Rd</u> City <u>PT 1A</u> State <u>MD</u> Zip Code <u>21221</u>		
Section _____ Area _____ Lot <u>13</u> Tax Map <u>22</u> Parcel <u>153</u> Grid <u>19</u>			Home Phone <u>201 675 5200</u> Work Phone <u>201 721 7471</u> Applicant's Name & Mailing Address, (if other than stated herein): <u>410-829-3803</u>		
Zoning <u>RC</u> Map Coordinates <u>387256</u> Lot size _____			Phone _____ Fax _____		
Existing Use <u>SFD</u> Proposed Use <u>SFD with Adpts. A17</u> Estimated Construction Cost \$ <u>10,000</u>			Contractor Company <u>CHINER</u> Contact Person _____ Address _____ City _____ State _____ Zip Code _____ License No. _____ Phone _____ Fax _____		
Description of Work <u>Finish partial single garage</u> <u>at Den add 12x12 add 12x12</u> <u>add at garage for garage</u>			Engineer or Architect Company _____ Contact Person _____ Address _____ City _____ State _____ Zip Code _____ Phone _____ Fax _____		
Occupant or Tenant <u>SHAC</u> Contact Name _____ Address _____ City _____ State _____ Zip Code _____ Phone _____ Fax _____			Building Description - <u>RESIDENTIAL</u>		
BUILDING DESCRIPTION - COMMERCIAL			BUILDING DESCRIPTION - RESIDENTIAL		
Building Characteristics Height: _____ No. of stories: _____ Gross area, sq. ft. per floor: _____ Use group: _____ Construction type: ☐ Reinforced Concrete ☐ Structural Steel ☐ Masonry ☐ Wood Frame ☐ State Certified Modular			Utilities Water Supply: ☐ Public ☐ Private Sewage Disposal: ☐ Public ☐ Private Electric Yes ☐ No ☐ Gas Yes ☐ No ☐ Heating System: Electric ☐ Oil ☐ Natural Gas ☐ Propane Gas ☐ Sprinkler system: N/A ☐ ☐ Full ☐ Partial ☐ Other Suppression ☐ # of Heads		
Building Characteristics SF Dwelling ☒ SF Townhouse ☐ Depth _____ Width _____ 1st floor: _____ 2nd floor: _____ Basement: _____ Finished Basement ☐ Unfinished Basement ☐ Crawl space ☐ Slab on Grade ☐ No. of Bedrooms _____ Multi-family dwellings: No. of efficiency units: _____ No. of 1 BR units: _____ No. of 2 BR units: _____ No. of 3 BR units: _____ Other Structure: _____ Dimensions: _____ Footings: _____ Roof: _____ ☐ State Certified Modular ☐ Manufactured Home			Utilities Water Supply: ☐ Public ☐ Private Sewage Disposal: ☐ Public ☒ Private Electric Yes ☐ No ☐ Gas Yes ☐ No ☐ Heating System: Electric ☐ Oil ☐ Natural Gas ☐ Propane Gas ☐ Sprinkler system: N/A ☐ ☐ NFPA #13D ☐ NFPA #13R ☐ Other:		

THE UNDERSIGNED HEREBY CERTIFIES AND AGREES AS FOLLOWS: (1) THAT HE/SHE IS AUTHORIZED TO MAKE THIS APPLICATION; (2) THAT THE INFORMATION IS CORRECT; (3) THAT HE/SHE WILL COMPLY WITH ALL REGULATIONS OF HOWARD COUNTY WHICH ARE APPLICABLE THEREIN; (4) THAT HE/SHE WILL PERFORM NO WORK ON THE ABOVE REFERENCED PROPERTY NOT SPECIFICALLY DESCRIBED IN THIS APPLICATION; (5) THAT HE/SHE GRANTS COUNTY OFFICIALS THE RIGHT TO ENTER ONTO THE PROPERTY FOR THE PURPOSE OF INSPECTING THE WORK PERMITTED AND POSTING NOTICES.

Applicant's Signature _____

Title/Company _____

Print Name James Beck

Date 7-2-00

Checks payable to: DIRECTOR OF FINANCE OF HOWARD COUNTY
 ** PLEASE WRITE NEATLY AND LEGIBLY. **

- FOR OFFICE USE ONLY -

AGENCY ☒ Land Development, DPZ ☒ State Highways ☒ Building Official ☒ Dev. Engineering, DPZ ☒ Health ☒ Fire Protection Is Sediment Control approval required prior to issuance? YES ☐ NO ☐	DATE <u>11/10/00</u>	SIGNATURE APPROVAL <u>[Signature]</u>	DPZ SETBACK INFORMATION Front: _____ Rear: _____ Side: _____ Side St.: _____ All minimum setbacks met? YES ☐ NO ☐ Is Entrance Permit required? YES ☐ NO ☐ Historic District? YES ☐ NO ☐ Lot Coverage for New Town Zone _____ SDP/Red-line approval date _____	PROPERTY ID# <u>417420</u> Filing fee \$ _____ Permit fee \$ _____ Excise tax \$ _____ Sub-total paid \$ _____ Add'l permit fee \$ _____ TOTAL FEES \$ _____ Balance due \$ _____ Check # <u>6661</u> Validation # <u>35867</u>
CONTINGENCY CONSTRUCTION START: ☐ ONE STOP SHOP: ☐				

Distribution of Copies-

White: Building Official

Green: LDD, DPZ

Yellow: DED, DPZ

Pink: Health

Gold: SHA