

DEPT. OF INSPECTIONS, LICENSES AND PERMITS 3430 COURT HOUSE DRIVE ELLICOTT CITY, MD 21043 PERMITS (410) 313-2453 INSPECTIONS (410) 313-1810 AUTOMATED INFORMATION (410) 313-3800		HOWARD COUNTY PERMIT APPLICATION	PERMIT NUMBER B11002569
Building Address: <u>13832 Wayside Drive</u> <u>Clarksville MD 21022</u>		Property Owner's Name <u>Shane Hartman</u> Address <u>13832 Wayside Drive</u> City <u>Clarksville</u> State <u>MD</u> Zip Code <u>21022</u> Home Phone <u>301-854-1513</u> Work Phone <u>301-576-1043</u> Applicant's Name & Mailing Address, (if other than stated herein): 	
Suite/Apt #: _____ SDP/WP/Petition #: _____ Census Tract _____ Subdivision _____ Section _____ Area _____ Lot _____ Tax Map _____ Parcel _____ Grid _____ Zoning _____ Map Coordinates _____ Lot Size _____		Phone _____ Fax _____ Contractor Company _____ Contact Person _____ Address _____ City _____ State _____ Zip Code _____ License No. _____ Phone _____ Fax _____ Engineer or Architect Company _____ Contact Person _____ Address _____ City _____ State _____ Zip Code _____ Phone _____ Fax _____	
Existing Use _____ Proposed Use _____ Estimated Construction Cost \$ _____ Description of Work <u>New Front Porch</u> <u>+ Front Door</u> Occupant or Tenant <u>Occupant</u> Contact Name <u>Shane Hartman</u> Address <u>13832 Wayside Drive</u> City <u>Clarksville</u> State <u>MD</u> Zip Code <u>21022</u> Phone <u>301-854-1513</u> Fax _____			


BUILDING DESCRIPTION - COMMERCIAL		BUILDING DESCRIPTION - RESIDENTIAL	
Building Characteristics Height: _____ No. of stories: _____ Gross area, sq. ft. per floor: _____ Use group: _____ Construction type: ☐ Reinforced Concrete ☐ Structural Steel ☐ Masonry ☐ Wood Frame ☐ State Certified Modular	Utilities Water Supply: ☐ Public ☐ Private Sewage Disposal: ☐ Public ☐ Private Electric Yes ☐ No ☐ Gas Yes ☐ No ☐ Heating System: Electric ☐ Oil ☐ Natural Gas ☐ Propane Gas ☐ Sprinkler system: N/A ☐ ☐ Full ☐ Partial ☐ Other Suppression ☐ # of Heads	Building Characteristics SF Dwelling ☐ SF Townhouse ☐ Depth _____ Width _____ 1 st floor: _____ 2 nd floor: _____ Basement: _____ Finished Basement ☐ Unfinished Basement ☐ Crawlspace ☐ Slab on Grade ☐ No. of Bedrooms: _____ Multi-family dwellings: No. of efficiency units: _____ No. of 1 BR units: _____ No. of 2 BR units: _____ No. of 3 BR units: _____ Other Structure: _____ Dimensions: _____ Footings: _____ Roof: _____ ☐ State Certified Modular ☐ Manufactured Home	Utilities Water Supply: ☐ Public ☐ Private Sewage Disposal: ☐ Public ☐ Private Electric Yes ☐ No ☐ Gas Yes ☐ No ☐ Heating System: Electric ☐ Oil ☐ Natural Gas ☐ Propane Gas ☐ Sprinkler system: N/A ☐ ☐ NFPA #13D ☐ NFPA #13R ☐ Other:

THE UNDERSIGNED HEREBY CERTIFIES AND AGREES AS FOLLOWS: (1) THAT HE/SHE IS AUTHORIZED TO MAKE THIS APPLICATION; (2) THAT THE INFORMATION IS CORRECT; (3) THAT HE/SHE WILL COMPLY WITH ALL REGULATIONS OF HOWARD COUNTY WHICH ARE APPLICABLE THERETO; (4) THAT HE/SHE WILL PERFORM NO WORK ON THE ABOVE REFERENCED PROPERTY NOT SPECIFICALLY DESCRIBED IN THIS APPLICATION; (5) THAT HE/SHE GRANTS COUNTY OFFICIALS THE RIGHT TO ENTER ONTO THIS PROPERTY FOR THE PURPOSE OF INSPECTING THE WORK PERMITTED AND POSTING NOTICES.

Applicant's Signature Shane K Hartman Print Name Shane Hartman
 Email Address _____ Date 8/25/11
 Title/Company _____

Checks payable to: DIRECTOR OF FINANCE OF HOWARD COUNTY
 PLEASE WRITE NEATLY AND LEGIBLY
 FOR OFFICE USE ONLY

AGENCY: _____ DATE: <u>8-25-11</u> SIGNATURE APPROVAL: <u>[Signature]</u> DPZ SETBACK INFORMATION Front: _____ Rear: _____ Side: _____ Side Setback: _____ All minimum setbacks met? YES ☐ NO ☐ Is Entrance Permit Required? YES ☐ NO ☐ Historic District? YES ☐ NO ☐ Lot Coverage for New Town Zone: _____ SDP/Redline approval date: _____ CONTINGENCY CONSTRUCTION START ☐ ONE STOP SHOP: ☐ Distribution of Copies: _____ White: Building Officials Green: LDD, DPZ Yellow: DED, DPZ Pink: Health Gold: SEA	PROPERTY ID # _____ Filing fee \$ _____ Permit fee \$ _____ Excise tax \$ _____ Add'l per fee \$ _____ TOTAL FEES \$ _____ Sub-total paid \$ _____ Balance due \$ _____ Check # _____ Validation # _____ Accepted by _____
---	--

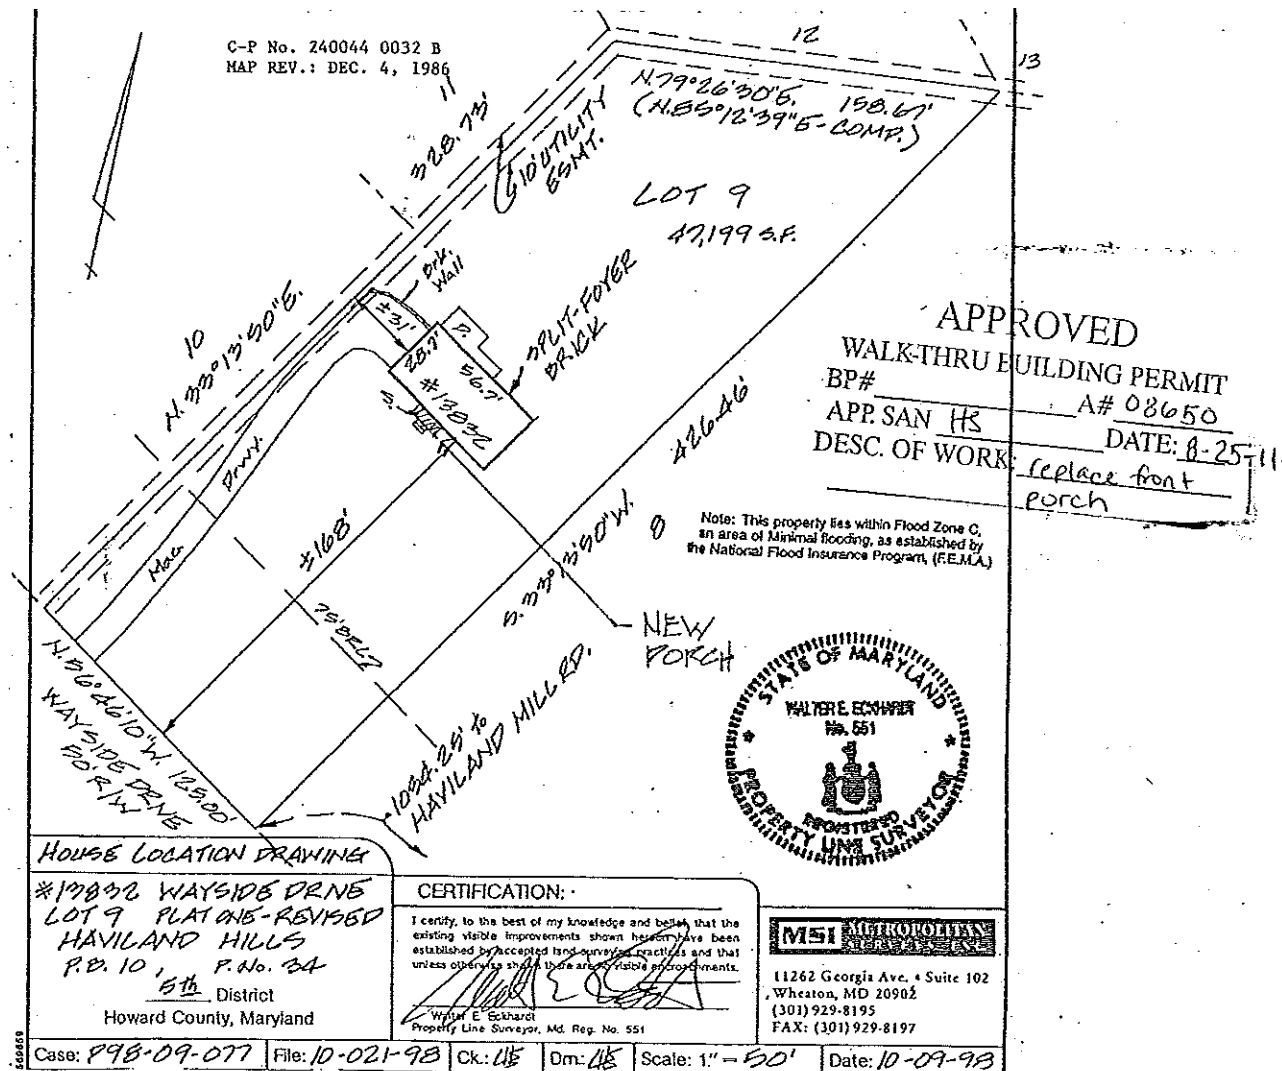

MICHE BOOZ

ARCHITECT

208 Market St
Brykettville
Maryland 20833
(301) 774 6911
fax 774 1908

Project

HARTMAN
PORCH

13832 WAYSIDE DRIVE
CLARKSVILLE, MD 21029

Howard County

Drawings:

Dates:

TODAY'S DATE 24 OCT 2010

HARTMAN PORCH

13832 WAYSIDE DRIVE CLARKSVILLE, MD 21029