

10/13/77

10/24/77

PERMIT

10/31/77

P 27015

A 25202

SEWAGE DISPOSAL SYSTEM
MARYLAND STATE DEPARTMENT OF HEALTH

HOWARD COUNTY

05-378 753

ELLICOTT CITY

DISTRICT 5th

DATE 10/7/77

11/1/77

Final

INDEXED

Allan Van Stant/ Bill Gavigan

IS PERMITTED TO INSTALL ☒ ALTER ☐

ADDRESS Laurel, Md. PHONE

A SEWAGE DISPOSAL-SYSTEM LOCATED AT

SUBDIVISION HOMER PARSLEY PROP ROAD 471 Ten Oaks Road LOT 3

PROPERTY OWNER Thomas E. Mullinix, Jr.

ADDRESS 12045 Scaggsville Road, Fulton, Md. 20759

SPECIFICATIONS 2 bedrooms

DRAIN FIELD DEPTH FEET, BOTTOM AREA SQ. FT.

SEEPAGE PITS ABSORBENT SIDE-WALL AREA SQ. FT.

SEPTIC TANK CAPACITY 1000 GALLONS

FOR GARBAGE GRINDER, INCREASE DISPOSAL AREA 22% & TANK CAPACITY 50%.

OTHER DRY WELL AND TRENCH - Dry well to have 390 sq. ft. effective sidewall area. Inlet at 3 ft. and maximum depth 10 ft. below original grade. Locate dry well 165 ft. from front lot line and 20 ft. from left lot line as seen from Ten Oaks Road. If 4 bedroom trench to be 20 ft. long and if 5 bedroom trench to be 40 feet long. Inlet to trench at 3 1/2 ft. and maximum depth 10 ft. below original grade. Trench to come off dry well and follow the land's contour and run parallel to Ten Oaks Road.

NOTE: CALL FOR INSPECTION OF TRENCH BEFORE PLACING STONE IN TRENCH.

NOTE: ALL PIPE FROM HOUSE TO DISPOSAL AREA MUST BE CAST IRON.

PERMIT VOID AFTER THREE YEARS.

NOTE: INSTALL STAND PIPE ON SEPTIC TANK AND DRY WELL. STAND PIPES MUST BE 6 INCHES IN

PLANS APPROVED BY Hal Benson DATE 2/24/77

DIAMETER. CAST IRON, CONCRETE OR TERRA COTTA ACCEPTED.

FILL SEPTIC TANK AND DISTRIBUTION BOX WITH WATER BEFORE CALLING FOR AN INSPECTION. COVER NO WORK UNTIL INSPECTED AND APPROVED.

NEITHER THE HOWARD COUNTY COMMISSIONERS NOR THE HEALTH DEPARTMENT IS RESPONSIBLE FOR THE SUCCESSFUL OPERATION OF ANY SYSTEM.


BLDG. PERMIT SIGNED

AND RETURNED 8/24/92
Serial # 45763 - patch

BLDG. PERMIT SIGNED

AND RETURNED 3/10/91
Serial # 45749
Garage

24202

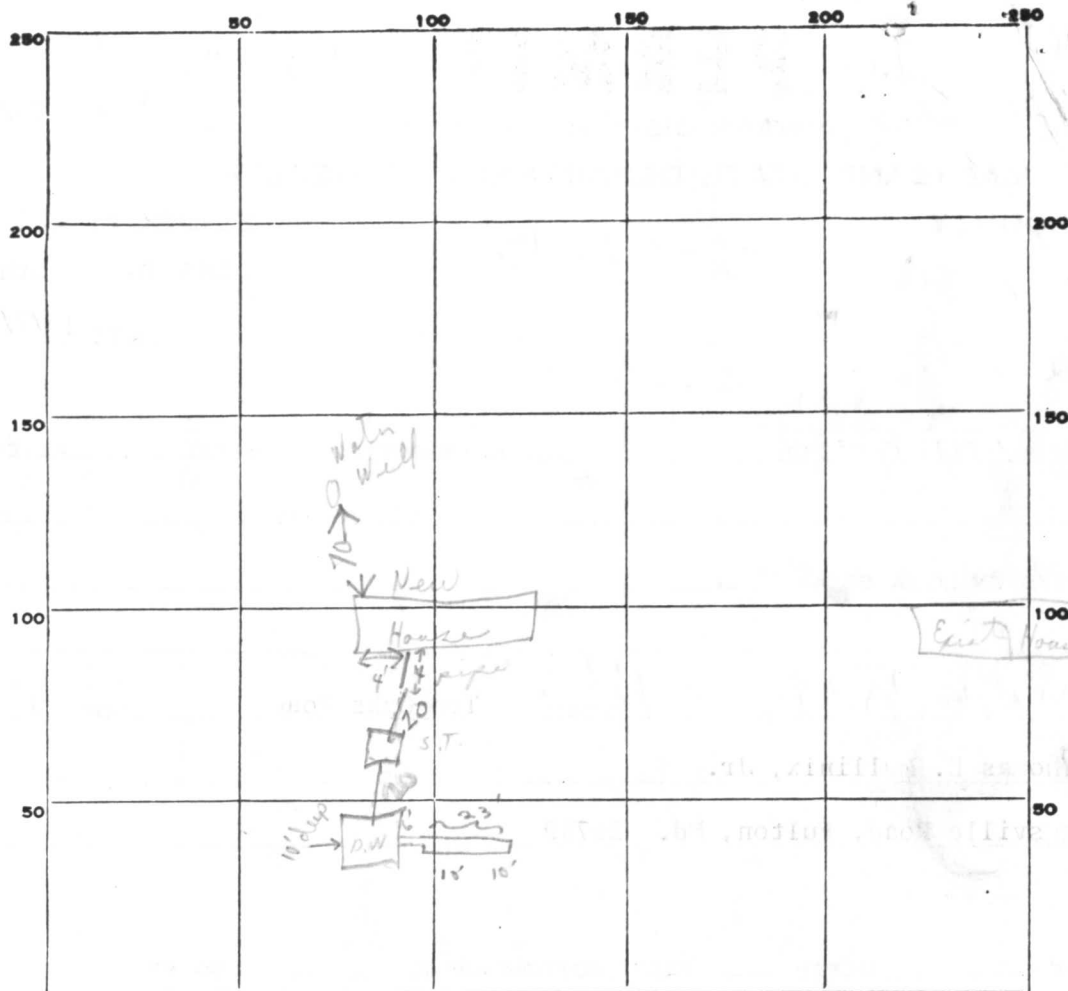

INDICATE NORTH. - NAME ADJOINING ROADWAY AS BASE LINE.

PERMIT CARD

SEPTIC TANK, LEVEL

DISTRIBUTION BOX, LEVEL

TILE FIELD, DEPTH

10

FT.

TRENCH WIDTH

2

FT.

GRAVEL DEPTH

7ft

IN.

TOTAL LENGTH

23

FT.

NUMBER OF TRENCHES

1

TOTAL BOTTOM AREA

141 ONE SIDE

SEEPAGE PITS, INSIDE DIAMETER

59

FT.

DEPTH BELOW INLET

7

FT.

ABSORBENT AREA

413 ±

SQ. FT.

REMARKS

10/13/77 No pipe; no tank; no dry well; just excavation
the site. sh'd trench for gravel. c & d

10/26/77 - DW inlet 3 1/2 ft deep, ① Put 6" Cleanout on DW

② In trench put holes side of pipe down ③ Cover pipe
in trench with 2" stone. ④ Cover Tank & House sewer

④ Over tank & house sewer RH 10/31/77 Gravel covered
in trench; new cleanout on dry well & plug. gully backfill

DATE SYSTEM APPROVED

10/31/77

INSPECTOR

C. P. Street

APPLICATION

A 24202

SEWAGE DISPOSAL TESTING

P. _____

STATE OF MARYLAND - DEPARTMENT OF HEALTH AND MENTAL HYGIENE

HQWARD COUNTY HEALTH DEPARTMENT
ENVIRONMENTAL HEALTH SERVICES
P. O. BOX 476, ELLICOTT CITY, MARYLAND 21043
TELEPHONE: 465-5000, EXT. 356

DISTRICT 5

DATE 10/6/76

TO: THE COUNTY HEALTH OFFICER
ELLICOTT CITY, MARYLAND

I, HEREBY, APPLY FOR THE NECESSARY TEST IN ORDER TO CONSTRUCT (OR RECONSTRUCT) A SEWAGE DISPOSAL SYSTEM.

PROPERTY OWNER Parsley

ADDRESS _____ PHONE _____

PROPERTY LOCATION:

SUBDIVISION _____ LOT NO. Lot 3

ROAD AND DESCRIPTION ten oaks Rd

SIZE OF LOT _____ TYPE BLDG. _____

NUMBER OF BEDROOMS _____

IF NOT SINGLE RESIDENCE DESCRIBE _____

THE SYSTEM INSTALLED UNDER THIS APPLICATION IS ACCEPTABLE ONLY UNTIL PUBLIC FACILITIES BECOME AVAILABLE.

BLDG. PERMIT SIGNED

AND RETURNED 5/11/77

SIGNATURE OF APPLICANT _____

APPROVED BY _____ FOR _____ DATE _____

(KIND OF SYSTEM)

REJECTED BY _____ FOR _____ DATE _____

(KIND OF SYSTEM)

HOLD PENDING FURTHER TESTS receipt of perc plat DATE Oct 8 1976

REASONS FOR REJECTION OR HOLDING hal benson 10/8/76

THIS IS NOT A PERMIT

Hole 2 & 4


A-2402

Hole 1 & 3

CLAY
4 1/2
SANDY
MICA
LOAM
8
WISSAHICKON
SCHIST - SAPPHIRE
12 1/2

CLAY
4 1/2
SANDY
MICA
LOAM

Parsley
Lot 3

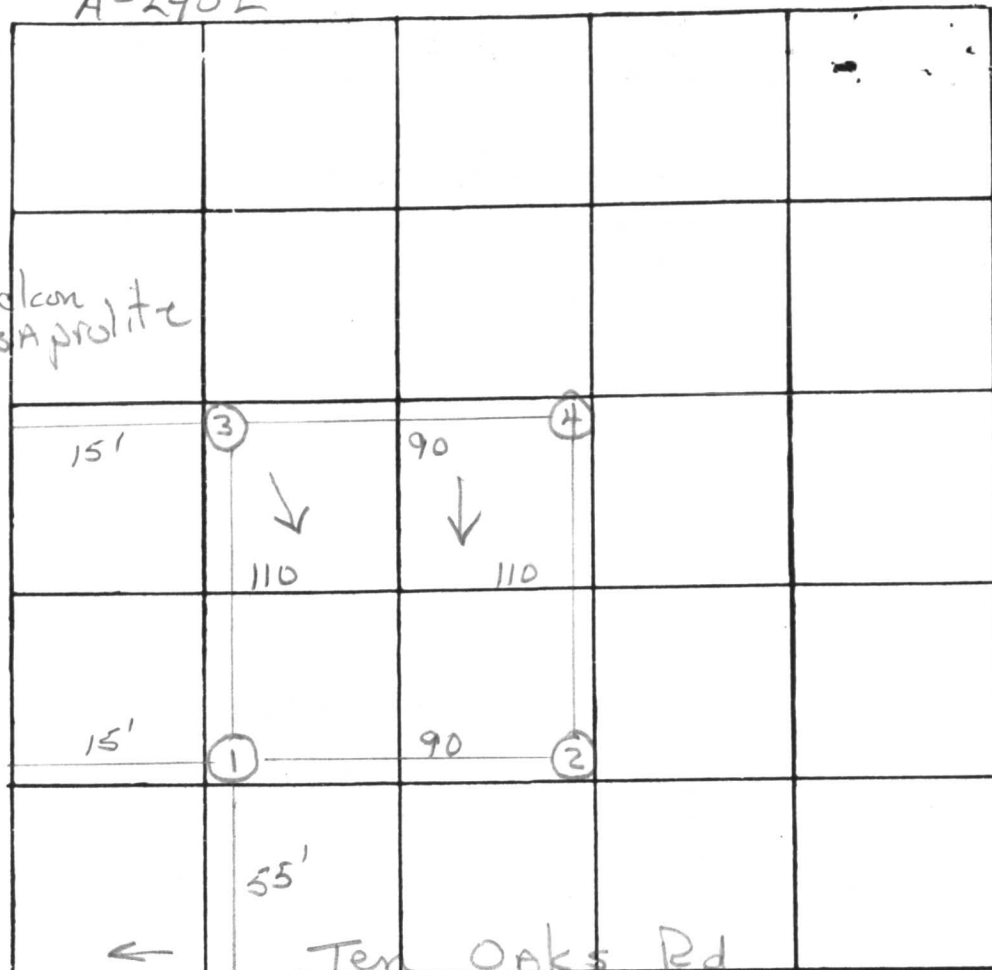

Tridelphia

INDICATE NORTH. - NAME ADJOINING ROADWAY AS BASE LINE.

DATE	TEST NO.	DEPTH	PRE-WET		TEST - 1" DROP		TIME
			START	STOP	START	STOP	
	1S	4	220	pulled At	3:00		No Perk
	1S ²	4 1/2	302	303	303	305	2
	1d	12 1/2	220	226	226	237	11
	2S	3 1/2	227	230	230	235	5
	2d	12 1/2	235	243	243	300	17
	3S	5	259	301	301	310	9
	3d	13	250	257	257	306	9
	4V	12 1/2	similar to #2 - dry				

REMARKS

use hole 3 for DW

TYPE OF SOIL

see profile

TESTED BY

hal benson

ALSO PRESENT:

School

APPLICATION

A 24202

SEWAGE DISPOSAL TESTING

P _____

STATE OF MARYLAND - DEPARTMENT OF HEALTH AND MENTAL HYGIENE

HOWARD COUNTY HEALTH DEPARTMENT
ENVIRONMENTAL HEALTH SERVICES
P. O. BOX 476, ELLICOTT CITY, MARYLAND 21043
TELEPHONE: 465-5000, EXT. 356

DISTRICT 5DATE 10/6/76

TO: THE COUNTY HEALTH OFFICER
ELLICOTT CITY, MARYLAND

I, HEREBY, APPLY FOR THE NECESSARY TEST IN ORDER TO CONSTRUCT (OR RECONSTRUCT) A SEWAGE DISPOSAL SYSTEM.

PROPERTY OWNER Thomas E. Mullinix, Jr.ADDRESS 12045 Scaggsville Road, Fulton, Maryland PHONE 20759

PROPERTY LOCATION:

SUBDIVISION Homer C. Parsley property LOT NO. 3ROAD AND DESCRIPTION Ten Oaks RoadSIZE OF LOT 2 acres m/1 TYPE BLDG. 3 or 4IF NOT SINGLE RESIDENCE DESCRIBE _____
NUMBER OF BEDROOMS
(Single Fmly. Dwllg.)

THE SYSTEM INSTALLED UNDER THIS APPLICATION IS ACCEPTABLE ONLY UNTIL PUBLIC FACILITIES BECOME AVAILABLE.

SIGNATURE OF APPLICANT /s/ Thomas E. Mullinix, Jr.APPROVED BY _____ FOR _____ DATE _____
(KIND OF SYSTEM)REJECTED BY _____ FOR _____ DATE _____
(KIND OF SYSTEM)

HOLD PENDING FURTHER TESTS _____ DATE _____

REASONS FOR REJECTION OR HOLDING _____

THIS IS NOT A PERMIT

A-2402


original copy - there is also duplicate copy.

Hole 2 & 4

4 1/2' clay
sandy loam
8' wisconsin
schist
12 1/2' saprolite

Hole 1 & 3

5' clay
sandy
mich
loam
13'

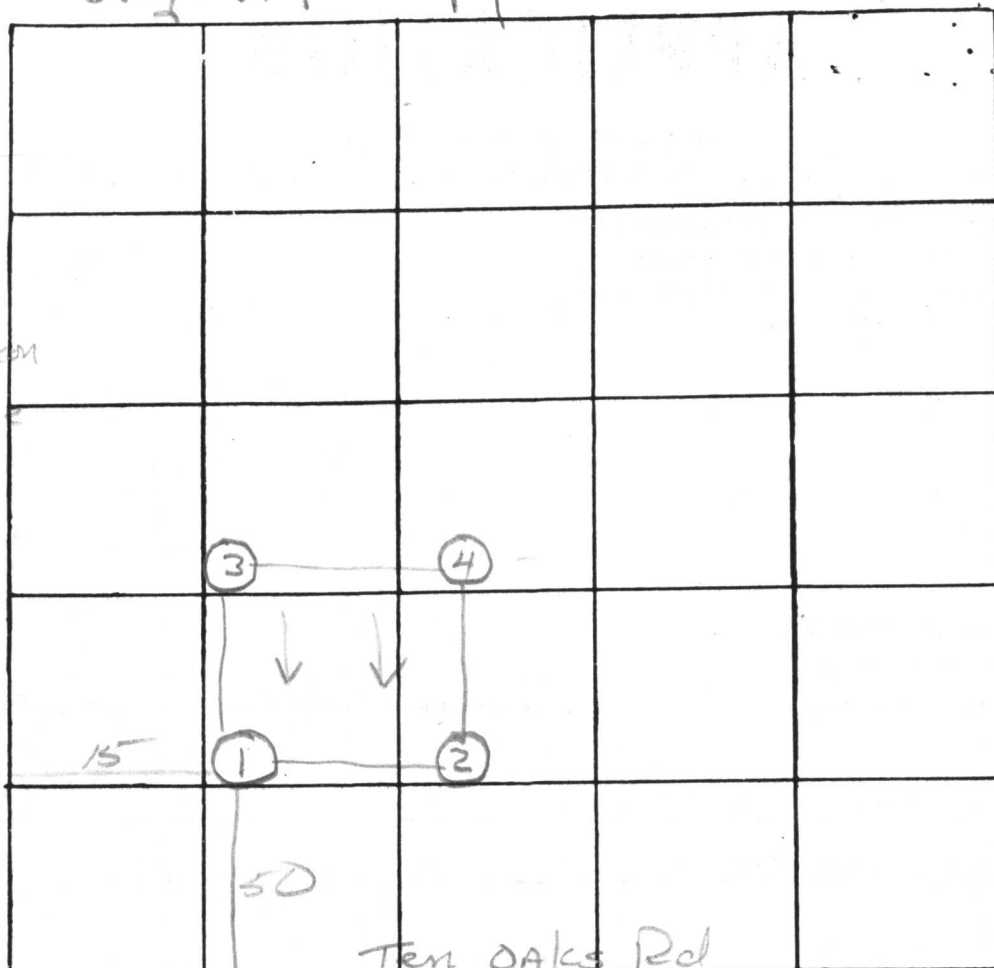

Tridelpia

Ten Oaks Rd

INDICATE NORTH. - NAME ADJOINING ROADWAY AS BASE LINE.

DATE	TEST NO.	DEPTH	PRE-WET		TEST - 1" DROP		TIME
			START	STOP	START	STOP	
10/6/76	15'	4	2:20	2:37	pulled at		3:00 NO PERK
"	1d	12 1/2	2:20	2:26	2:26	2:37	
"	2S	3 1/2	2:27		2:30	2:35	
"	2d	12 1/2	2:35	2:43	2:43	3:00	
	3S	5	2:59	3:01	3:01	3:10	
	3d	13	2:50	2:57	2:57	3:06	
	15 ²	4 1/2	3:02	3:03	3:03	3:05	2
	4V	SIMILAR to 2					- dry

REMARKS

DW in Hole 3

TYPE OF SOIL

Sandy Mich loam - Wisconsin saprolite


TESTED BY

hal benson

ALSO PRESENT:

Schoel


THOMAS MULLINIX.

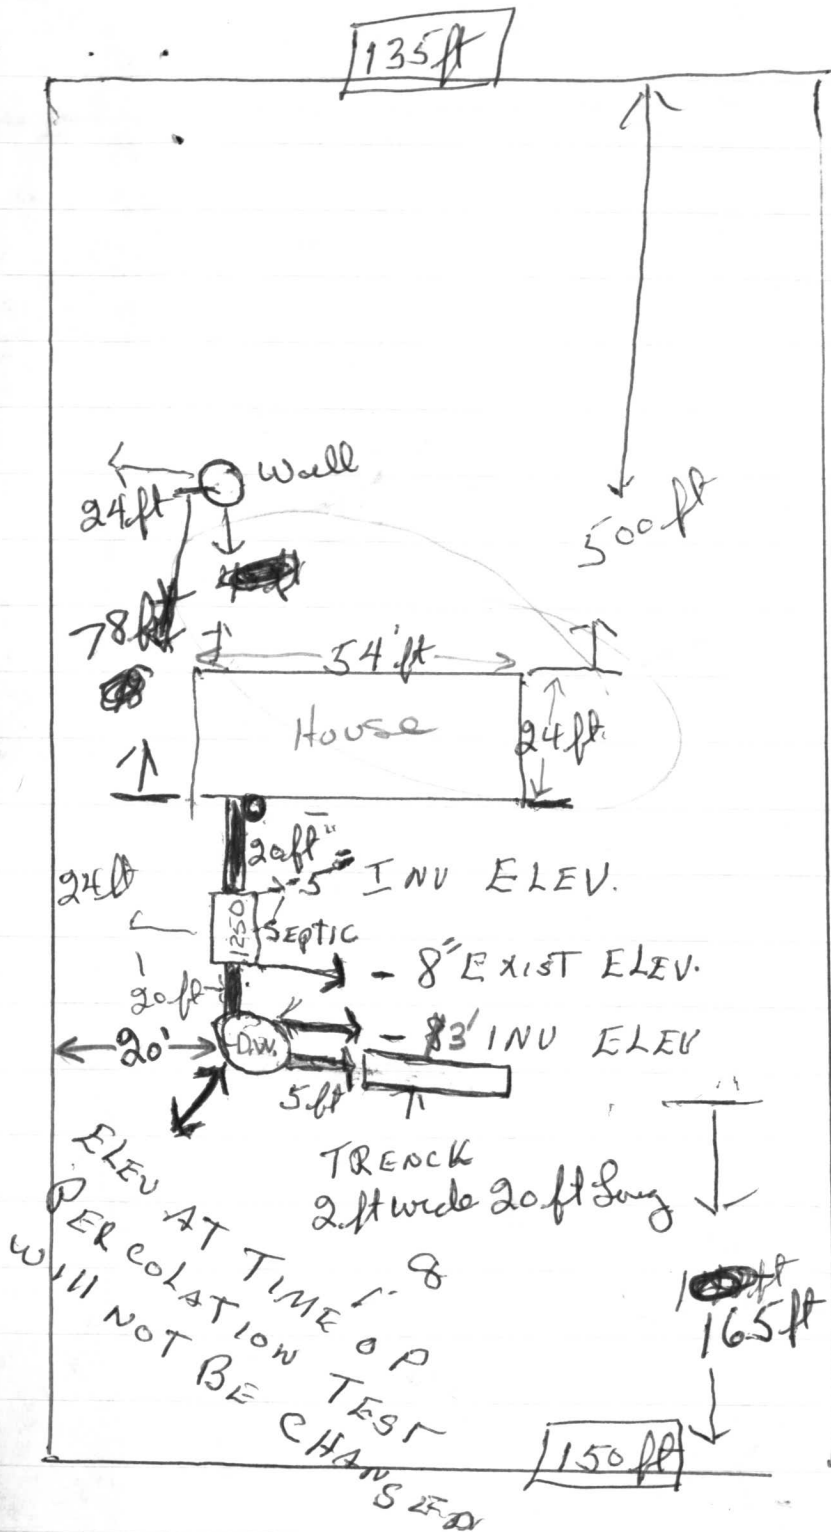

5/5/77
Sketch O.K.
G. Skinner

Bill Sawyer
[497-0668] office

Base - 5' 6"
FF + 2' 6"
WE + 3' 6"
House Inv. 0'
ST Inv. - 5"
ST SITE + 1'
DW SITE 0'
DW Inv. - 3'

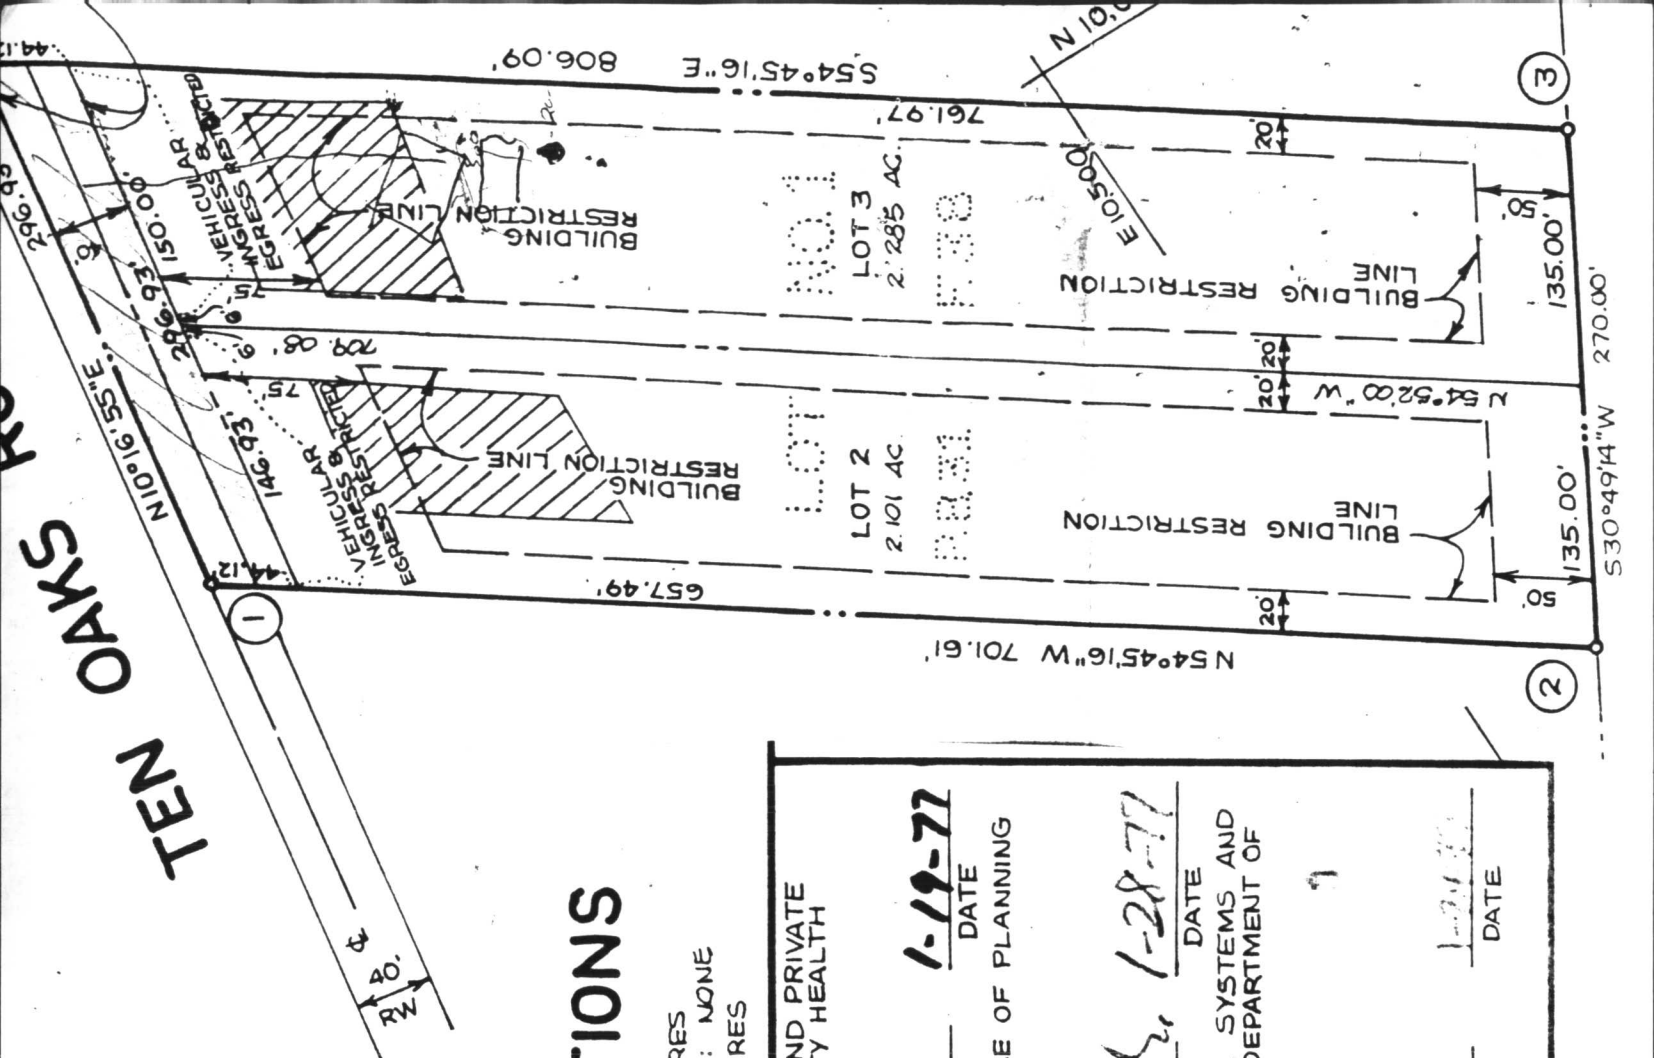

AREA TABULATIONS

1. TOTAL NO. OF LOTS: 2
2. TOTAL AREA OF LOTS: 4.386 ACRES
3. TOTAL AREA OF ROAD DEDICATION: NONE
4. TOTAL AREA OF PLAT: 4.386 ACRES

APPROVED: FOR PRIVATE WATER AND PRIVATE SEWAGE SYSTEMS. HOWARD COUNTY HEALTH DEPARTMENT.

James H. Boyd
COUNTY HEALTH OFFICER
DATE 1-19-77

APPROVED: HOWARD COUNTY OFFICE OF PLANNING AND ZONING.

James L. Janis
DIRECTOR
DATE 1-28-77

APPROVED: FOR STORM DRAINAGE SYSTEMS AND PUBLIC ROADS. HOWARD COUNTY DEPARTMENT OF PUBLIC WORKS.

P. J. Pappas
DIRECTOR
DATE 1-24-77