

11/18/76 - applied for

PERMIT

SEWAGE DISPOSAL SYSTEM

MARYLAND STATE DEPARTMENT OF HEALTH

HOWARD COUNTY

ELLICOTT CITY

INDEXED

DISTRICT 6th

DATE 11/18/76

Highland Turf Farm

IS PERMITTED TO INSTALL X ALTER

ADDRESS 12655 Lime Kiln Road, Fulton, Md. 20759

PHONE 497-0937

A SEWAGE DISPOSAL-SYSTEM LOCATED AT

SUBDIVISION ROAD Route 32 LOT

PROPERTY OWNER The Rouse Company - King's Contrivance Inn

ADDRESS Columbia, Md. 21044

SPECIFICATIONS

DRAIN FIELD DEPTH FEET, BOTTOM AREA SQ. FT.

SEEPAGE PITS ABSORBENT SIDE-WALL AREA SQ. FT.

SEPTIC TANK CAPACITY GALLONS

FOR GARBAGE GRINDER, INCREASE DISPOSAL AREA 22% & TANK CAPACITY 50%.

OTHER 40 by 40 pit- 9 feet deep with 4 1/2 ft. of stone under pipe 6 inches stone over pipe use distributor box and call for inspection of Bed before gravel is installed. System to be installed in area of perc test by Mr. Streaker.

NOTES: ALL PIPE FROM HOUSE TO DISPOSAL AREA MUST BE CAST IRON.

PERMIT VOID AFTER THREE YEARS.


NOTE: INSTALL STAND PIPE ON SEPTIC TANK. STAND PIPES MUST BE 6 INCHES IN DIAMETER. CAST IRON, CONCRETE OR TERRA COTTA ACCEPTED. CALL FOR INSPECTION BEFORE ANY GRAVEL IS INSTALLED IN BED.

PLANS APPROVED BY Donald W. Mongghan DATE 11/12/76

FILL SEPTIC TANK AND DISTRIBUTION BOX WITH WATER BEFORE CALLING FOR AN INSPECTION. COVER NO WORK UNTIL INSPECTED AND APPROVED.

NEITHER THE HOWARD COUNTY COMMISSIONERS NOR THE HEALTH DEPARTMENT IS RESPONSIBLE FOR THE SUCCESSFUL OPERATION OF ANY SYSTEM.

A24368

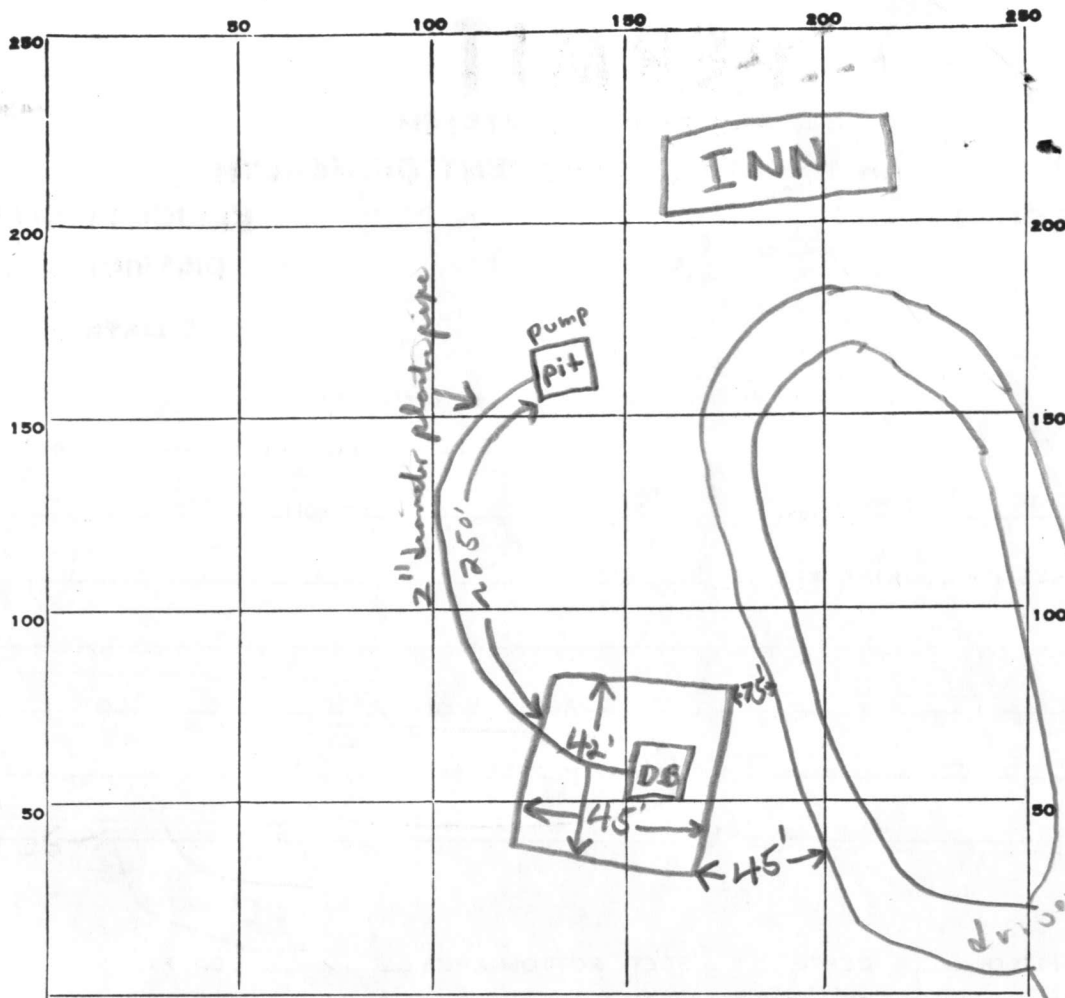

INDICATE NORTH. - NAME ADJOINING ROADWAY AS BASE LINE.

PERMIT CARD ✓ signed final, overall work

SEPTIC TANK, LEVEL n.a.

CLEANOUTS n.a.

DISTRIBUTION BOX, LEVEL O.K.

TILE FIELD, DEPTH 7-9 FT. TRENCH WIDTH — FT.

GRAVEL DEPTH 5 FT. TOTAL LENGTH — FT.

NUMBER OF TRENCHES — TOTAL BOTTOM AREA 1890 ϕ

SEEPAGE PITS, INSIDE DIAMETER — FT. DEPTH BELOW INLET 4 1/2' FT.

ABSORBENT AREA — SQ. FT.

REMARKS 11/18/76 - Mr. Monaghan gave permission for them to install gravel in bed. / to
11/18/76 System installed & ready for backfill at time of inspection
leaching bed is on slight slope ~4% ∇ S.

DATE SYSTEM APPROVED 11/18/76

INSPECTOR G. Skinner

APPLICATION

A 24368

SEWAGE DISPOSAL TESTING

P _____

STATE OF MARYLAND - DEPARTMENT OF HEALTH AND MENTAL HYGIENE

HOWARD COUNTY HEALTH DEPARTMENT
ENVIRONMENTAL HEALTH SERVICES

P. O. BOX 476, ELLICOTT CITY, MARYLAND 21043
TELEPHONE: 465-5000, EXT. 356

DISTRICT 6

DATE 10/28/76

TO: THE COUNTY HEALTH OFFICER
ELLICOTT CITY, MARYLAND

I, HEREBY, APPLY FOR THE NECESSARY TEST IN ORDER TO CONSTRUCT (OR RECONSTRUCT) A SEWAGE DISPOSAL SYSTEM.

PROPERTY OWNER The Rouse Company - King's Contrivance Inn

ADDRESS Columbia, Maryland

PHONE Any questions call:
Robert Young
992-6086

PROPERTY LOCATION:

SUBDIVISION (King's Contrivance Inn)

LOT NO. _____

ROAD AND DESCRIPTION Route 32

SIZE OF LOT 15 acres

TYPE BLDG. Restaurant facility
holds 118 customers
NUMBER OF BEDROOMS _____

IF NOT SINGLE RESIDENCE DESCRIBE _____

THE SYSTEM INSTALLED UNDER THIS APPLICATION IS ACCEPTABLE ONLY UNTIL PUBLIC FACILITIES BECOME AVAILABLE.

SIGNATURE OF APPLICANT /s/ Robert Young

APPROVED BY _____ FOR _____ DATE _____
(KIND OF SYSTEM)

REJECTED BY _____ FOR _____ DATE _____
(KIND OF SYSTEM)

HOLD PENDING FURTHER TESTS _____ DATE _____

REASONS FOR REJECTION OR HOLDING _____

THIS IS NOT A PERMIT

