

PERMIT

SEWAGE DISPOSAL SYSTEM

MARYLAND STATE DEPARTMENT OF HEALTH

HOWARD COUNTY

ELLICOTT CITY

DISTRICT 5th

DATE 8/28/81

INDEX

Harry R. Huber, III

IS PERMITTED TO INSTALL ☒ ALTER ☐

ADDRESS 14968 Frederick Road, Woodbine, Md. 21797

PHONE 854-6266

SUBDIVISION Allnutt Farm Estates

ROAD 13453 Long Days Court LOT 2, Sec. 2

PROPERTY OWNER Edward Pacylowski

ADDRESS

SPECIFICATIONS 4 bedrooms

SEPTIC TANK CAPACITY 1250 GALLONS

DRAIN FIELD DEPTH FEET, BOTTOM AREA SQ. FT.

DEEP TRENCH DEPTH FEET, BOTTOM AREA SQ. FT.

SEEPAGE PITS ABSORBENT SIDE-WALL AREA 150 SQ. FT. per bedroom

INLET PIPE FT. BELOW ORIGINAL GRADE, MAXIMUM DEPTH FT. BELOW ORIGINAL GRADE

EFFECTIVE DEPTH AT FT. BELOW ORIGINAL GRADE.

LOCATE DISPOSAL AREA FT. FROM LOT LINE AND FT. FROM LOT LINE AS SEEN WHEN

TRENCH SYSTEM - ^{FACING LOT FROM} to contain 600 sq. ft. total sidewall area (one side only). Trench inlet to be 3 ft. below original grade and maximum depth of trench bottom to be no deeper than 10 feet below original grade. Locate the trench in the area of the highest perc test hole which is 130 ft. from the front lot line and 30 ft. from the left side line as seen when facing the property from Long Days Court. Trench must be placed on level ground. NOTE: CALL FOR INSPECTION OF TRENCH BEFORE PLACING GRAVEL (#2 SORTE) IN TRENCH.

PLANS APPROVED BY Frank Skinner

DATE 8/25/81

COVER NO WORK UNTIL INSPECTED AND APPROVED. NO WORK SHALL EXCEED 15 FOOT IN DIAMETER.

NEITHER THE HOWARD COUNTY COUNCIL NOR THE HEALTH DEPARTMENT IS RESPONSIBLE FOR THE SUCCESSFUL OPERATION OF ANY SYSTEM.

NOTE: IF TRENCH IS USED CALL FOR INSPECTION BEFORE PLACING GRAVEL IN TRENCH.

NOTE: NO DRY WELL SHALL EXCEED 15 FOOT IN DIAMETER.

NOTE: ALL PIPE FROM HOUSE TO DISPOSAL AREA MUST BE CAST IRON.

PERMIT VOID AFTER THREE YEARS.

NOTE: INSTALL STAND PIPE ON SEPTIC TANK AND DRY WELL. STAND PIPES MUST BE 8 INCHES IN DIAMETER, CAST IRON, CONCRETE OR TERRA

COTTA ACCEPTED.


*INSTALLER IS RESPONSIBLE FOR OBTAINING FINAL APPROVAL ON THIS PERMIT.

BLDG. PERMIT SIGNED

AND RETURNED 7/29/81

Seal # 13184
H. H. H.

EH-2-1079

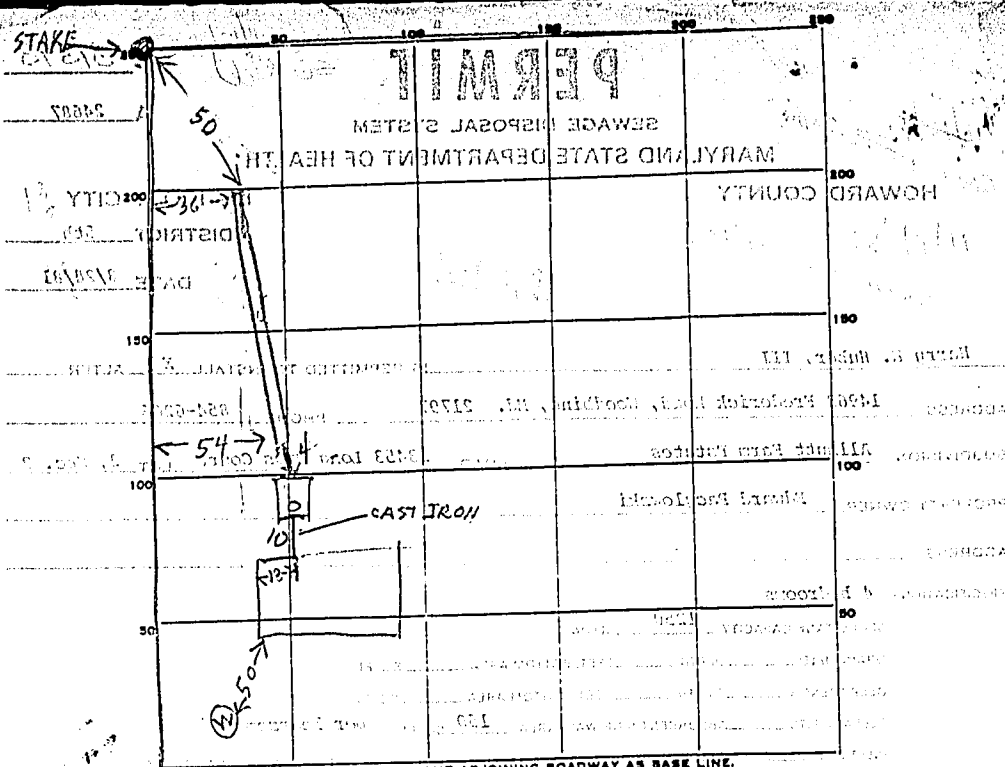

INDICATE NORTH. - NAME ADJOINING ROADWAY AS BASE LINE.

PERMIT CARD

ST

SEPTIC TANK, LEVEL OK 150 CLEANOUTS OK
 DISTRIBUTION BOX, LEVEL OK
 TRENCH, DEPTH 7 FT. TRENCH WIDTH 2 FT.
 TRENCH, DEPTH 7 FT. TRENCH WIDTH 2 FT.

GRAVEL DEPTH 7 IN. TOTAL LENGTH 89 FT.

NUMBER OF TRENCHES 1 TOTAL BOTTOM AREA 623 SQ. FT.

SEEPAGE PITS, INSIDE DIAMETER 4 FT. DEPTH BELOW INLET 4 FT.

ABSORBENT AREA 50 SQ. FT.

REMARKS 11/16/81 - ADD STONE PIPE TO DETCH. H. H. HUBERS WANTS TO

USE PLASTIC SCHEDULE 40 PVC ASTM 2665 NSF MUST CHECK WITH FS.

OK TO COVER TANK RH 11/16/81 11/16/81 Cover all work 11/16/81

DATE SYSTEM APPROVED 11/17/81

INSPECTOR Stephen G. Hill

APPLICATION

SEWAGE DISPOSAL TESTING

STATE OF MARYLAND - DEPARTMENT OF HEALTH AND MENTAL HYGIENE

HOWARD COUNTY HEALTH DEPARTMENT
ENVIRONMENTAL HEALTH SERVICES
P. O. BOX 476, ELLICOTT CITY, MARYLAND 21043
TELEPHONE: 465-5000, EXT. 356

DISTRICT Fifth

DATE 9/9/76

TO: THE COUNTY HEALTH OFFICER
ELLICOTT CITY, MARYLAND

I, HEREBY, APPLY FOR THE NECESSARY TEST IN ORDER TO CONSTRUCT (OR RECONSTRUCT) A SEWAGE DISPOSAL SYSTEM.

PROPERTY OWNER Mr. and Mrs. Smith W. Allnutt, Jr.

ADDRESS 13288 Highland Road PHONE 988-9303
Highland, MD 20777

PROPERTY LOCATION:

SUBDIVISION Hi - Land Farm Estates LOT NO. 11

ROAD AND DESCRIPTION Court "C"

SIZE OF LOT 1.02 Ac. TYPE BLDG. 3 or 4 bedroom
NUMBER OF BEDROOMS

IF NOT SINGLE RESIDENCE DESCRIBE

THE SYSTEM INSTALLED UNDER THIS APPLICATION IS ACCEPTABLE ONLY UNTIL PUBLIC FACILITIES BECOME AVAILABLE.

SIGNATURE OF APPLICANT /s/ Margaret G. Allnutt

APPROVED BY _____ FOR _____ DATE _____
(KIND OF SYSTEM)

REJECTED BY _____ FOR _____ DATE _____
(KIND OF SYSTEM)

HOLD PENDING FURTHER TESTS _____ DATE _____

REASONS FOR REJECTION OR HOLDING _____

THIS IS NOT A PERMIT

[illegible]

DATE	TEST NO.	DEPTH	PRE-WET		TEST - 1" DROP		TIME
			START	STOP	START	STOP	
9/25	25	4'	146	145	145	153	5
	0	13'	146	—	—	152	2+
	151	4 1/4'	149	150	150	153	2
		15' 0"	149	152	153	205	14
	35	3	204	204	204	1209	5
	d	12'	201	204	204	1205	4
	4	13' 0"	504	04	3-181		
	66751	4	251	252	252	254	4
		13'	251	255	255	254	3

TYPE OF SOIL

TESTED BY

ALSO PRESENT:


U. H. H. B/w 17

NO SCALE

LOT 2 SEC 2 ALLMUTT FARMS ESTATES

I CERTIFY THE ABOVE MEASUREMENTS AND
ELEVATIONS ARE ACTUAL + CORRECT FOR THIS
PROPERTY


SIGNED: Sharon Parford

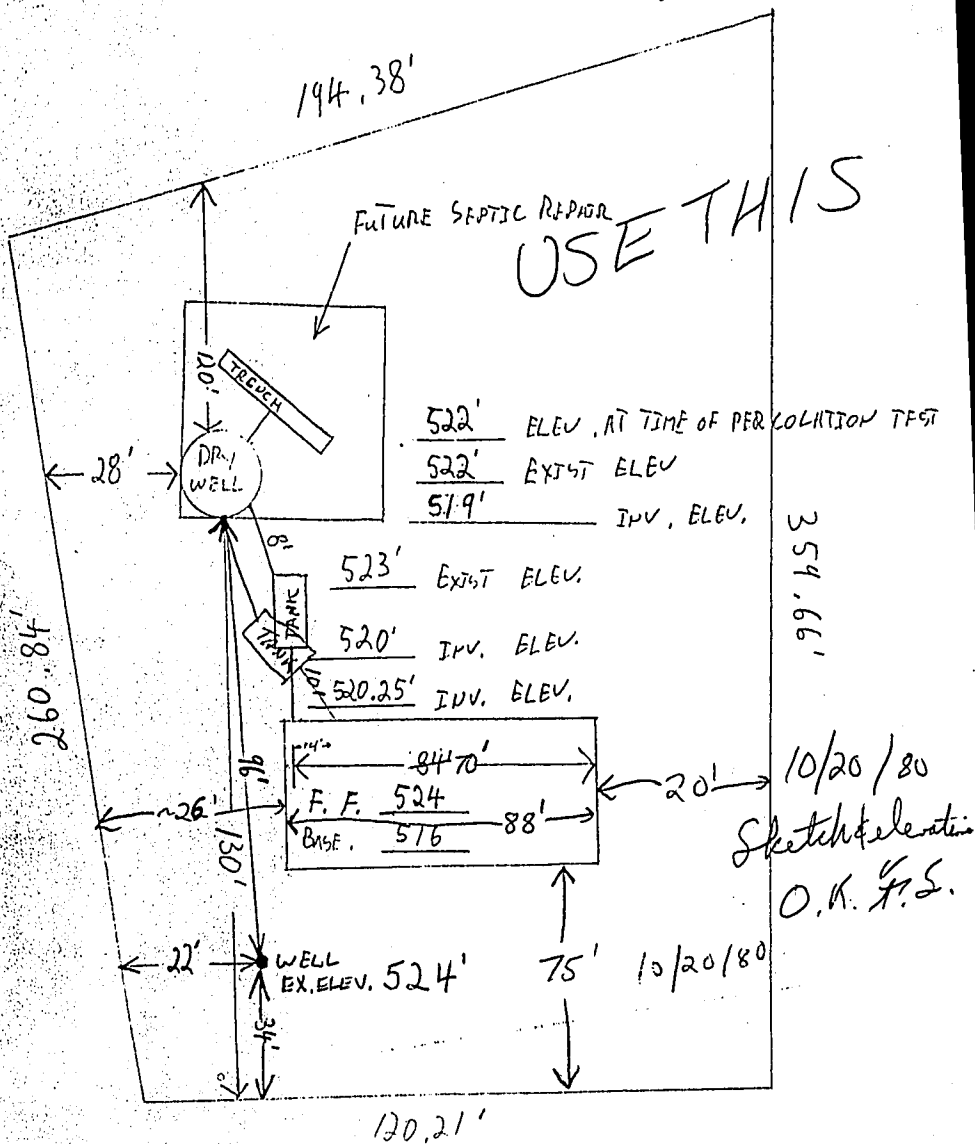

ROAD LONG DAYS COURT

LONG DAYS COURT

$R = 725.00'$ $A = 120.21'$

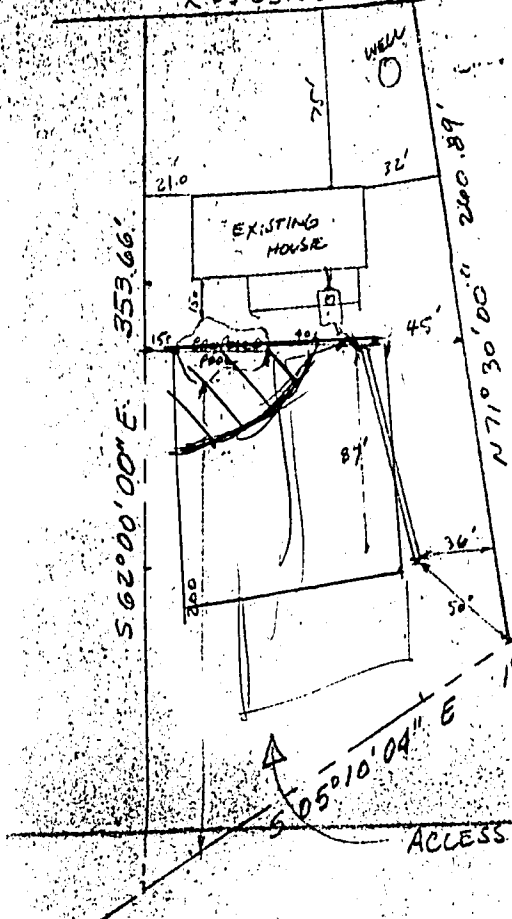

THIS ADJUSTED
POOL PROPOSAL
OK IF RE-SUBMITTED
AS REVISION TO
BP 13194

7/29/87
Cullhan


WALL
BOAR
BOAR
LADI
SLID
ROPL
FILT
MOT
HEA
POOL
CHLO
SKIM
MAIN
RETU
BAC
POOL
CLOC
BLOW
ELEC
ELEC
SPA S
MAIN
HYDR
GRAD
TREES
FENCE
CONCR
NOTE
AC

RECEIVED
HOWARD COUNTY
HEALTH DEPT.

JUL 15 9 01 AM

DIVISION
ENVIRONMENTAL
HEALTH

LONG DAYS COURT

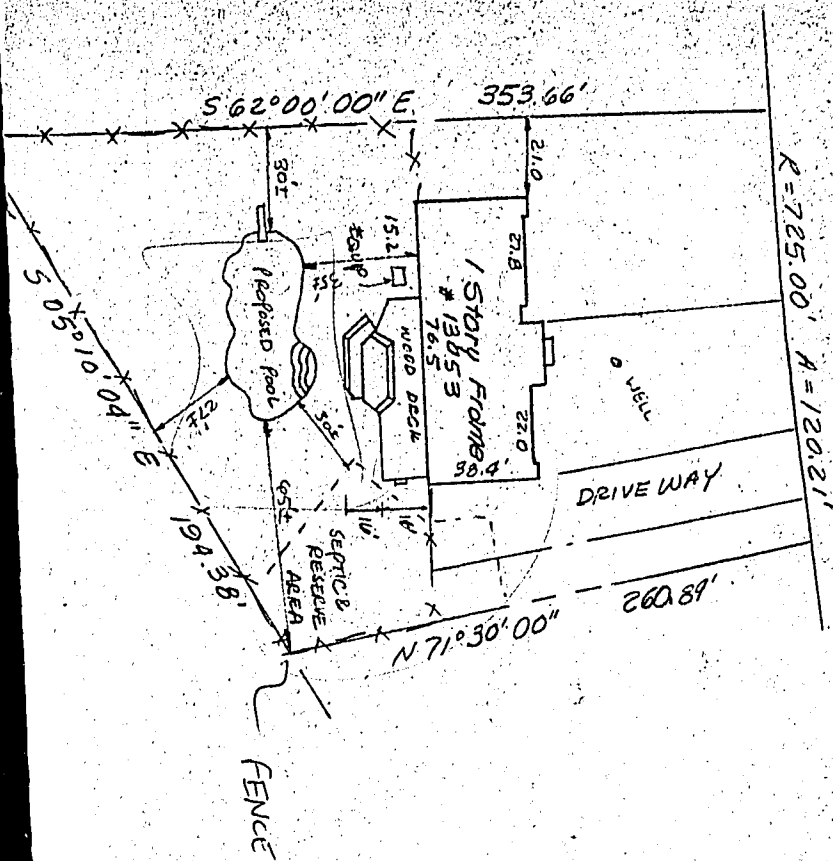

COPING	BULLNOSE BRICK RED
TILE	FLOOR BLUE
WALK-IN STEPS (3)	W/ LOVESEAT (4) INCL.
BOARD SIZE	6" COLOR WHITE
BOARD SUPPORT	INCL.
LADDER	Ø
SLIDE	Ø COLOR Ø
ROPE ANCHORS	W/ W/ROPE & FLOATS INCL.
FILTER	30 SEFT D.E.
MOTOR H.P.	1
HEATER	Ø BTU Ø
POOL CLEANER	POLARIS
CHLORINATOR	AUTOMATIC INCL.
SKIMMER LINE	
MAIN DRAIN	
RETURN LINE	
BACKWASH TO	MANUAL
POOL LIGHT	500 W SPALIGHT Ø
CLOCK	
BLOWER	Ø
ELECTRIC BY	OWNER
ELECTRICAL BONDING BY	
SPA SIZE	Ø x Ø AREA
MAIN DRAIN	Ø
HYDROJETS #	Ø
GRADING	1 W/ DIRTWALK Ø

DNR-214 (7-77)

C 1 8854- (SEQUENCE NO. (WRA USE ONLY))

1 2 3 (SEQ. NO.)
(THIS NUMBER IS TO BE PUNCHED
IN COLS. 3-5 ON ALL CARDS)

STATE OF MARYLAND WATER RESOURCES ADMINISTRATION TAWES STATE OFFICE BLDG., ANNAPOLIS, MD. 21401 WELL COMPLETION REPORT

THIS REPORT MUST BE SUBMITTED-WI
IN 30 DAYS AFTER WELL COMPLETION

FILL IN THIS FORM COMPLETELY

COUNTY
NUMBER 6/24/68DATE RECEIVED
(WRA USE ONLY)June 29, 1977
DATE WELL COMPLETED

DEPTH OF WELL

165
22 (TO NEAREST FOOT) 26

PERMIT NO. FROM "PERMIT TO DRILL WELL"

47-1-4234-4
28 29 30 31 32 33 34 35 36 37
223

DRILLERS IDENTIFICATION NO.

OWNER
HEALTH
HOMES
INC.

DESHI

SHAIKESH

LAST NAME

KEENA CH

POST OFFICE

FIRST NAME
WILLIAM HILL

STREET OR RFD

WELL DESCRIPTION

WELL LOG
STATE THE KIND OF FORMATIONS PENETRATED, THEIR
COLOR, DEPTH, THICKNESS AND IF WATER BEARING

DESCRIPTION (USE ADDITIONAL SHEETS
IF NECESSARY)

FEET
FROM TO

CHECK IF
WATER
BEARING

Top Soil 0 2
Sandy 2 45
Small Stone 45 60
Mica 60 145
Small Stone 145 196
Mica 196 165

GROUTING RECORD

WELL HAS BEEN GROUTED (CIRCLE APPROPRIATE BOX) YES (Y) NO (N)
44 44
TYPE OF GROUTING MATERIAL (CIRCLE BOX)
CEMENT (CM) BENTONITE CLAY (BC)
45 46 45 46
NO. OF BAGS 33 NO. OF POUNDS 2,200
GALLONS OF WATER 178

DEPTH OF GROUT SEAL (TO NEAREST FOOT)
FROM 0 FT. TO 50 FT.
(ENTER 0 IF FROM SURFACE)

CASING RECORD

CASING TYPES
(INSERT APPROPRIATE CODE BELOW)
STEEL (ST) CONCRETE (CO)
PLASTIC (PL) OTHER (OT)
MAIN CASING TYPE
(S) (T) (L) (U)
60 61 63 64 65 67

OTHER CASING (IF USED)
DIAMETER (INCH) DEPTH (FEET)
FROM TO

SCREEN RECORD

SCREEN TYPE
(INSERT APPROPRIATE CODE BELOW)
STEEL (ST) BRASS (BR) OPEN HOLE (HO)
OR BRONZE (OR)
PLASTIC (PL) OTHER (OT)

C 2

DEPTH (NEAREST WHOLE FOOT)
FROM 0 TO 165
1 2 3 4 5 6 7 8 9 10 11 12 13 14 15 16 17 18 19 20 21 22 23 24 25 26 27 28 29 30 31 32 33 34 35 36 37 38 39 40 41 42 43 44 45 46 47 48 49 50 51
SLOTSIZE 1, 2, 3

DIAMETER OF SCREEN 56 (NEAREST INCH)
FROM 56 TO 60

GRAVEL PACK
IF WELL DRILLED WAS A
FLOWING WELL CIRCLE BOX 68 F

WRA USE ONLY (NOT TO BE FILLED IN BY DRILLER)
(E.R.O.S.) W 0
70 71 72 73 74 75 76
TELESCOPE LOG OTHER DATA
CASING INDICATOR AVAILABLE

CIRCLE APPROPRIATE BOXES

A WELL WAS ABANDONED AND SEALED WHEN THIS
WELL WAS COMPLETED
E ELECTRIC LOG OBTAINED
P TEST WELL CONVERTED TO PRODUCTION WELL

I HEREBY CERTIFY THAT I HAVE COMPLIED WITH ALL
CONDITIONS STATED ON THE ABOVE-CAPTIONED "PERMIT
TO DRILL WELL", AND THAT INFORMATION CONTAINED
IN THIS REPORT IS TRUE, ACCURATE, AND COMPLETE
TO THE BEST OF MY KNOWLEDGE, INFORMATION AND
BELIEF.

DRILLERS NAME

PLEASE
PRINT
SIGNATURE

C 3

1 2 3 (SEQ. NO.)

PUMPING TEST

HOURS PUMPED (TO NEAREST HOUR) 8
PUMPING RATE
GALLONS PER MINUTE TO NEAREST GALLON 20
METHOD USED TO
MEASURE PUMPING RATE bucket
WATER LEVEL (DISTANCE FROM LAND SURFACE)
BEFORE PUMPING 70 (NEAREST
FOOT)
WHEN PUMPING 165 (NEAREST
FOOT)
TYPE OF PUMPED USED (CIRCLE APPROPRIATE BOX)
(FOR PUMPING TEST)
A AIR P PISTON T TURBINE
27 27 27
C CENTRIFUGAL R ROTARY O OTHER (DESCRIBE
27 27 27
J JET S SUBMERSIBLE
27 27

PUMP INSTALLED

TYPE OF PUMP (WRITE APPROPRIATE LETTER IN
BOX - SEE ABOVE: A, C, J, P, R, S, T, O)
YES NO
DRILLER WILL INSTALL PUMP (CIRCLE APPROPRIATE BOX) Y N
CAPACITY:
GALLONS PER MINUTE (TO NEAREST GALLON) 31 35
PUMP HORSE POWER 37 41
PUMP COLUMN LENGTH (NEAREST FOOT) 43 47

CASING HEIGHT (CIRCLE APPROPRIATE BOX AND ENTER CASING HEIGHT)

+ ABOVE
- BELOW
LAND SURFACE (NEAREST
FOOT) 2 51

LOCATION OF WELL ON LOT

SHOW PERMANENT STRUCTURE SUCH AS BUILDINGS,
SEPTIC TANKS, AND/OR OTHER LAND MARKS AND
INDICATE NOT LESS THAN TWO DISTANCES
(MEASUREMENTS TO WELL).

HEALTH