

05-384486

6-27-88
1 PM

P 41851

A 24717

DISTRICT 5th

DATE 6-1-88

DATE SYSTEM APPROVED 6/27/88

INSPECTOR

IS PERMITTED TO INSTALL X ALTER _____

SUBDIVISION Allnutt Farms ROAD 13275 Styer Court LOT 6, Sec. 3

PROPERTY OWNER NV Homes

ADDRESS 10230 New Hampshire Avenue, Silver Spring, MD 20903 Phone: 445-3200

GARBAGE GRINDER? YES X NO

SEPTIC TANK CAPACITY 2000 GALLONS NUMBER OF BEDROOMS 4

TRENCHES - 228 sq. ft. sidewall area per bedroom. Trench to be 3 feet wide.

Inlet 3 feet below original grade. Bottom maximum depth 5½ feet

below original grade. Effective area begins at 3 feet below original grade. $2\frac{1}{2}$

feet of stone below distribution box. Start first trench 25 ft. from the left

lot line and at least 125 ft. from the front lot line as seen when facing the

property from Styer Court. Run trench(es) along level ground toward rear of lot.

NOTE: SEPTIC TANK AND TRENCHES TO BE AT LEAST 100 FEET FROM THE WELL. OK/CW

PLANS APPROVED BY Craig Williams DATE 5/6/85

NEITHER THE HOWARD COUNTY COUNCIL NOR THE HEALTH DEPARTMENT IS RESPONSIBLE FOR THE SUCCESSFUL OPERATION OF ANY SYSTEM.

NOTE: CLEANOUT REQUIRED EVERY 70 FEET OF SEWER LINE AND/OR AT 90° SWEEPS IN LINES FROM HOUSE TO DRAIN FIELDS.

NOTE: ALL PARTS OF SEPTIC SYSTEMS (I.E., TANK, DISTRIBUTION BOX, TRENCHES) TO BE 100 FEET FROM WELL. (UNLESS OTHERWISE SPECIFICALLY AUTHORIZED)

NOTE: IF DEEP TRENCH(ES) ARE USED CALL FOR INSPECTION BEFORE AND AFTER PLACING GRAVEL IN TRENCH(ES).

NOTE: NO DRY WELL SHALL EXCEED 15 FOOT IN DIAMETER. NO ABSORPTION TRENCH TO EXCEED 100 FEET IN LENGTH.

NOTE: ALL PIPE FROM HOUSE TO SEPTIC TANK MUST BE CAST IRON OR SCHEDULE 40 PVC OR ABS

PERMIT VOID AFTER TWO YEARS.

NOTE: INSTALL STAND PIPE ON SEPTIC TANK AND DRY WELL. STAND PIPES MUST BE 6 INCHES IN DIAMETER. CAST IRON, CONCRETE OR TERRA COTTA OR PVC OR ABS ACCEPTED. IF TOP OF SEPTIC TANK IS DEEPER THAN 3 FEET, MANHOLE TO GRADE REQUIRED.


NOTE: DISTRIBUTION BOXES MUST HAVE BAFFLES.

***INSTALLER IS RESPONSIBLE FOR OBTAINING FINAL APROVAL ON THIS PERMIT**

***CALL 461-9933 FOR INSPECTION OF SEPTIC SYSTEMS.**

EH - 2-1186

A 24717

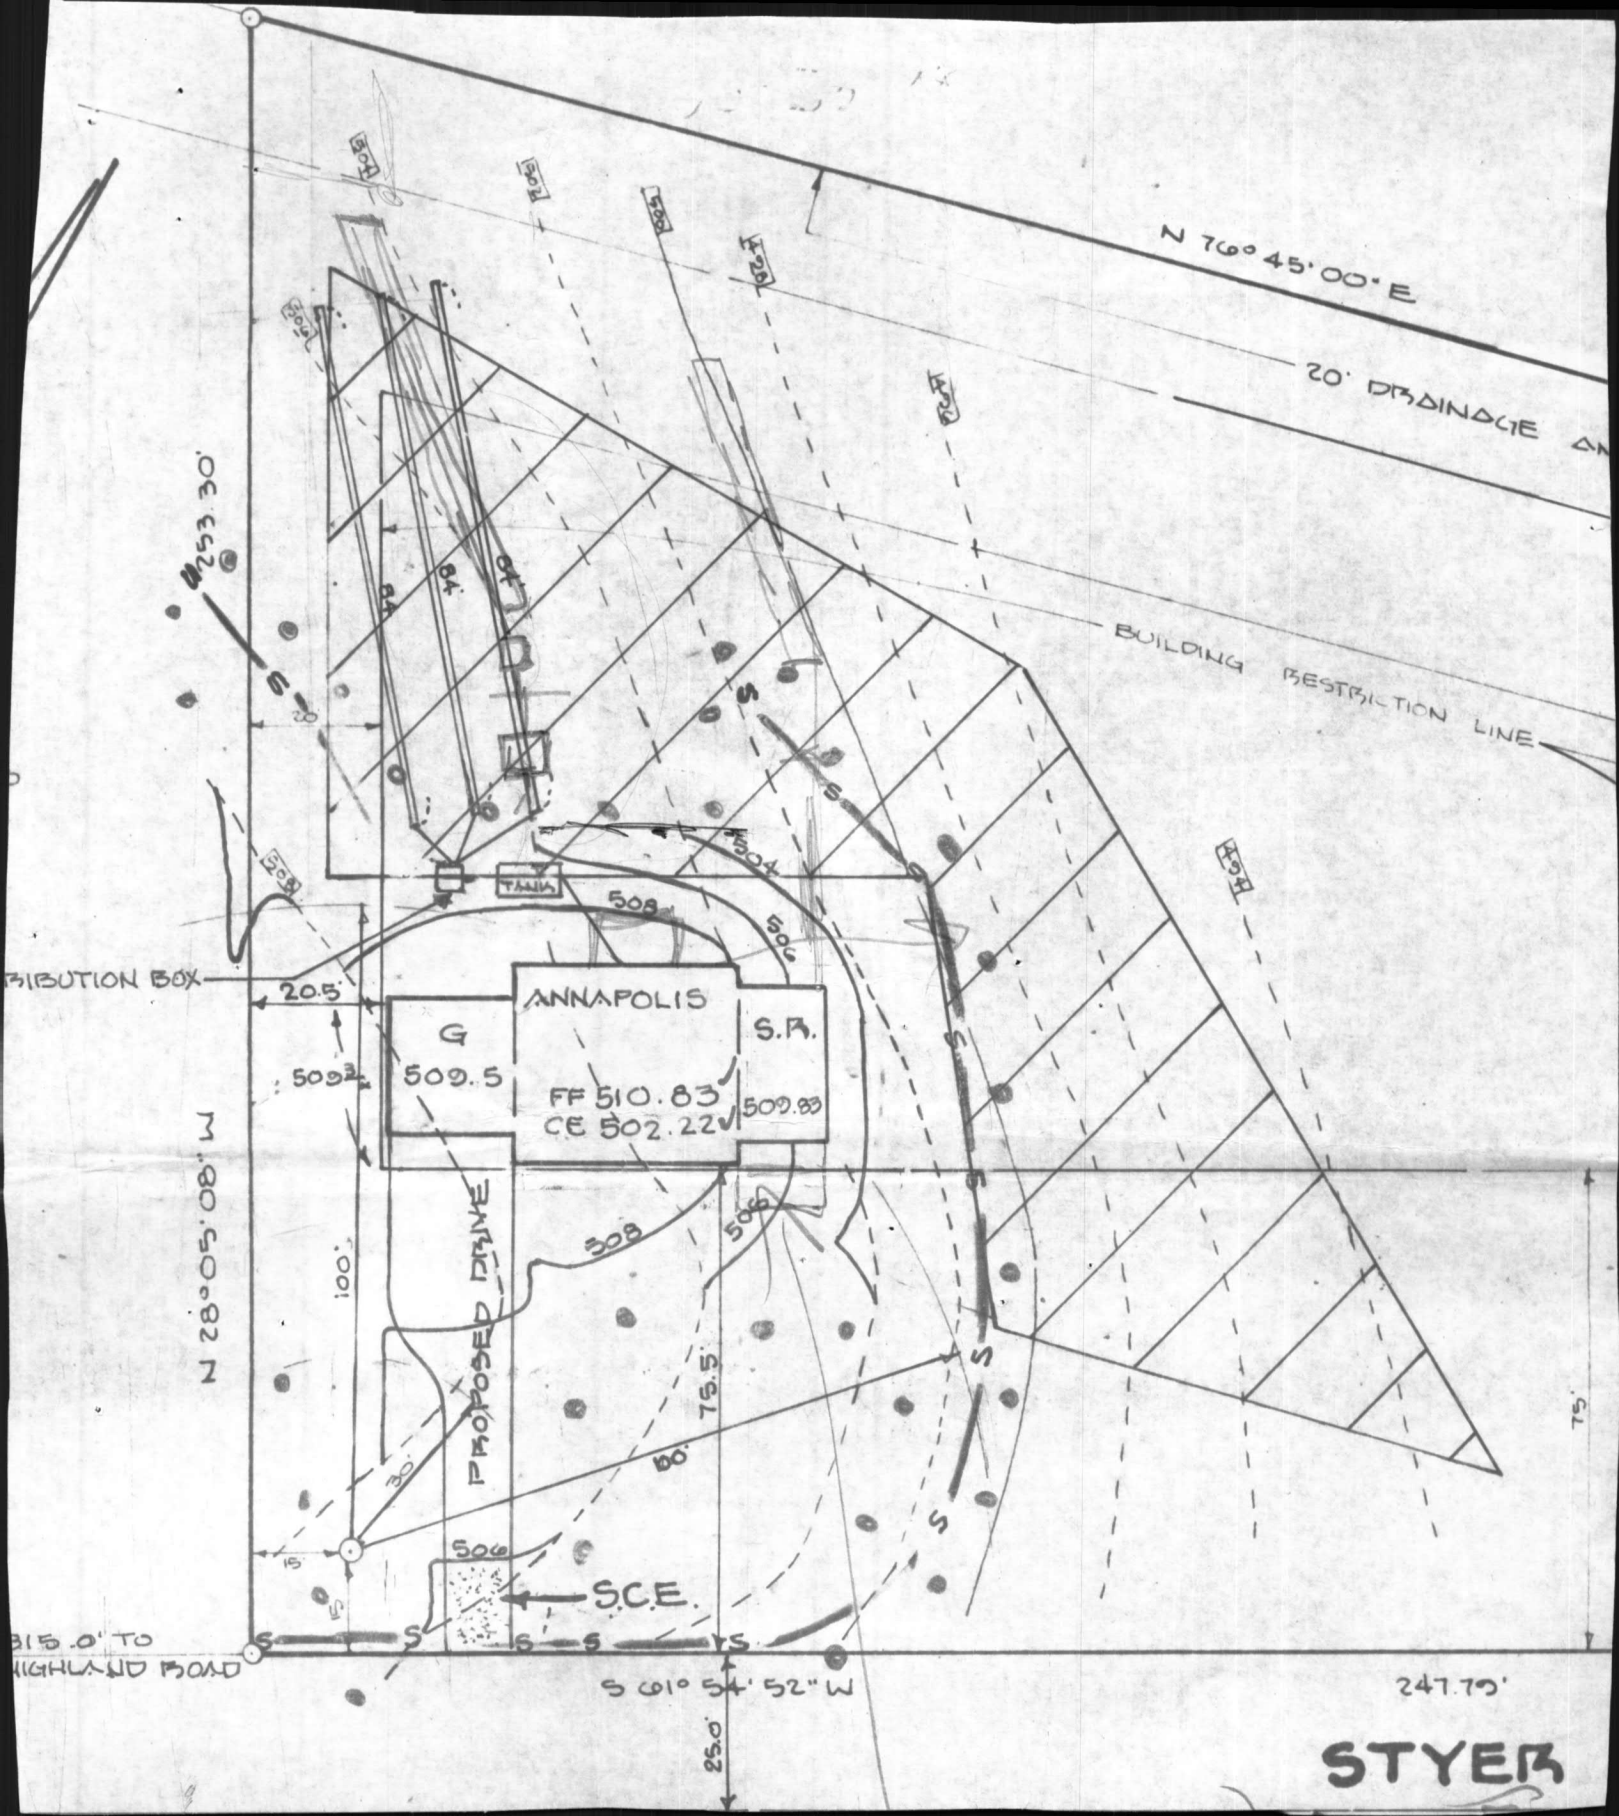


501*8 DENOTES FIELD LOCATED PERC HOLES

THIS AREA DESIGNATES A PRIVATE SEWERAGE EASEMENT OF 10,000 SQUARE FEET AS REQUIRED BY THE MARYLAND STATE DEPT. OF HEALTH & MENTAL HYGIENE FOR INDIVIDUAL SEWAGE DISPOSAL. IMPROVEMENTS OF ANY NATURE IN THIS AREA ARE RESTRICTED UNTIL PUBLIC SEWER IS AVAILABLE. THIS EASEMENT SHALL BECOME NULL & VOID UPON CONNECTION TO A PUBLIC SEWAGE SYSTEM. THE COUNTY HEALTH OFFICER SHALL HAVE THE AUTHORITY TO GRANT VARIANCES FOR ENCROACHMENTS INTO THE PRIVATE SEWERAGE EASEMENT. RECORDATION OF A MODIFIED SEWERAGE EASEMENT SHALL NOT BE NECESSARY.

APPROVED: FOR PRIVATE WATER & PRIVATE
SEWERAGE SYSTEMS.
HOWARD COUNTY HEALTH DEPARTMENT

1-22-81-
COUNTY HEALTH OFFICER F.S. DATE

DATE:

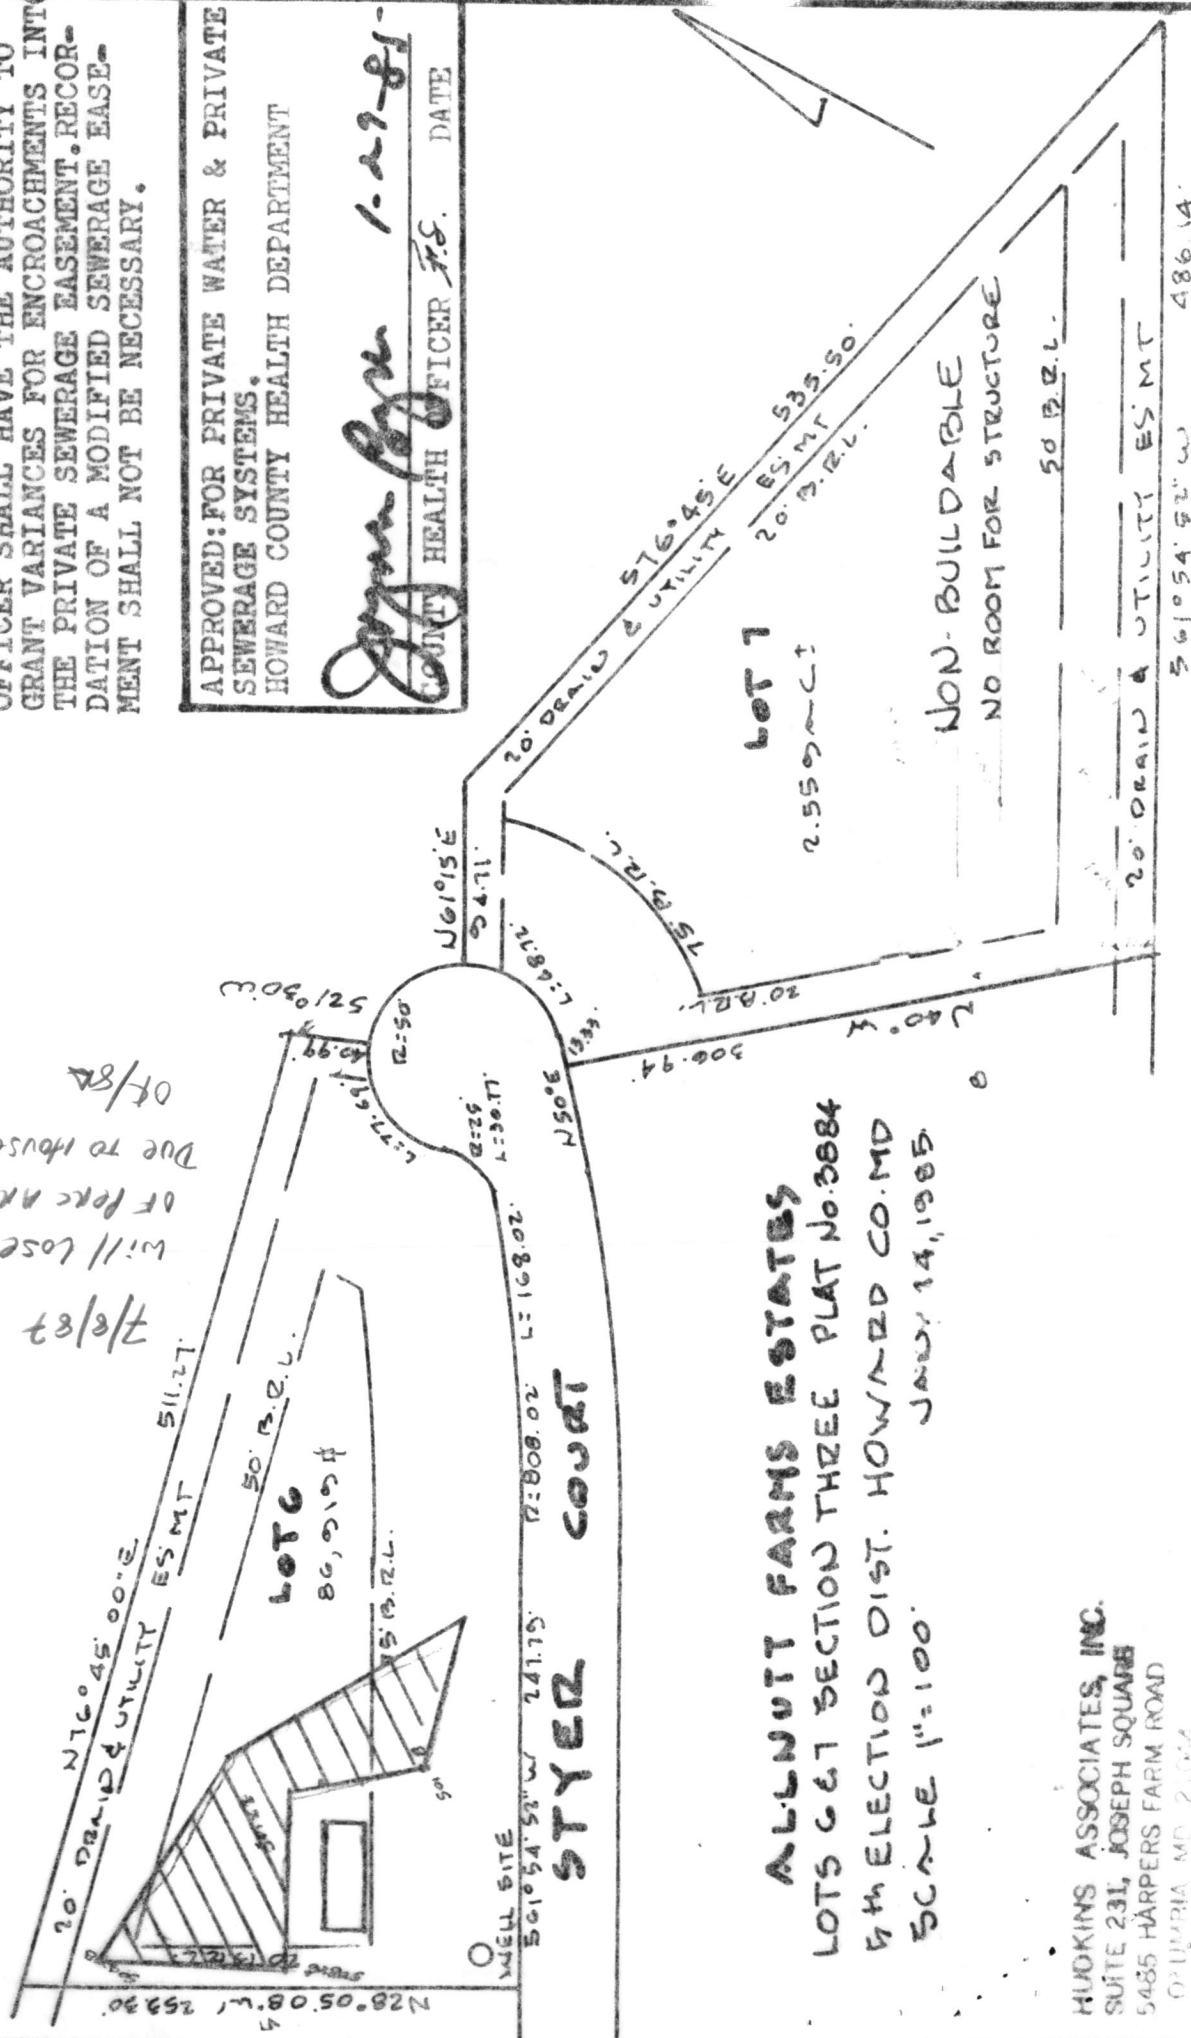

ALLNUTT FARMS ESTATES
LOTS 6 & 7 SECTION THREEE PLAT No. 3884
5th ELECTION DIST. HOWARD CO. MD
SCALE 1"=100' JANU. 14, 1985.

HUDKINS ASSOCIATES, INC.
SUITE 231, JOSEPH SQUARE
5485 HÄRPERS FARM ROAD
COLUMBIA, MD. 21046

C1 6077 SEQUENCE NO. (OEP USE ONLY)

(THIS NUMBER IS TO BE PUNCHED IN COLS. 3-6 ON ALL CARDS)

STATE OF MARYLAND
WELL COMPLETION REPORT
FILL IN THIS FORM COMPLETELY
PLEASE PRINT OR TYPETHIS REPORT MUST BE SUBMITTED WITHIN
45 DAYS AFTER WELL IS COMPLETED.COUNTY
NUMBER

A-24717

DATE Received

DATE WELL COMPLETED

Depth of Well

PERMIT NO.
FROM "PERMIT TO DRILL WELL"

8						13
---	--	--	--	--	--	----

15						20
----	--	--	--	--	--	----

22						26
----	--	--	--	--	--	----

(TO NEAREST FOOT)

28						37
----	--	--	--	--	--	----

OWNER

STREET OR RFD

last name

first name

TOWN

SUBDIVISION

SECTION

LOT

WELL LOG

Not required for driven wells

STATE THE KIND OF FORMATIONS
PENETRATED, THEIR COLOR, DEPTH,
THICKNESS AND IF WATER BEARINGDESCRIPTION (Use
additional sheets if needed)

FEET

FROM

TO

Check
if water
bearing

GROUTING RECORD

WELL HAS BEEN GROUTED

(Circle Appropriate Box)

TYPE OF GROUTING MATERIAL

CEMENT

BENTONITE CLAY

NO. OF BAGS

NO. OF POUNDS

GALLONS OF WATER

DEPTH OF GROUT SEAL (to nearest foot)

48						52
----	--	--	--	--	--	----

(enter 0 if from surface)casing
types
insert
appropriate
code
below

CASING RECORD

STEEL

CONCRETE

PLASTIC

OTHER

MAIN
CASING
TYPENominal diameter
top (main) casing
(nearest inch)Total depth
of main casing
(nearest foot)

60						64
----	--	--	--	--	--	----

66						70
----	--	--	--	--	--	----

EACH
CASING

OTHER CASING (if used)

diameter
inchdepth (feet)
from toscreen type
or open hole
insert
appropriate
code
below

SCREEN RECORD

STEEL

BRASS

OPEN
HOLE

PLASTIC

OTHER

C2

EACH
SCREEN

8						12
---	--	--	--	--	--	----

14						18
----	--	--	--	--	--	----

24						28
----	--	--	--	--	--	----

34						38
----	--	--	--	--	--	----

44						48
----	--	--	--	--	--	----

54						58
----	--	--	--	--	--	----

SLOT SIZE

2 3

DIAMETER
OF SCREEN(NEAREST
INCH)

from to

GRAVEL PACK

IF WELL DRILLED WAS
FLOWING WELL INSERT
F IN BOX 68OEP USE ONLY
(NOT TO BE FILLED IN BY DRILLER)

T

(E.R.O.S.)

WQ

TELESCOPE
CASINGLOG
INDICATOR

OTHER DATA

C3

1 2

PUMPING TEST

HOURS PUMPED (nearest hour)

PUMPING RATE (gal. per min.
to nearest gal.)METHOD USED TO
MEASURE PUMPING RATE

WATER LEVEL (distance from land surface)

BEFORE PUMPING

WHEN PUMPING

TYPE OF PUMP USED (for test)

A air

P piston

T turbine

C centrifugal

R rotary

O other
(describe
below)

J jet

S submersible

PUMP INSTALLED

DRILLER WILL INSTALL PUMP YES NO

IF DRILLER INSTALLS PUMP, THIS SECTION
MUST BE COMPLETED FOR ALL WELLS
EXCEPT HOME USE

TYPE OF PUMP INSTALLED

PLACE (A,C,J,P,R,S,T,O)

IN BOX - SEE ABOVE:

CAPACITY:
GALLONS PER MINUTE
(to nearest gallon)

PUMP HORSE POWER

PUMP COLUMN and enter casing height)

above

below

LAND SURFACE

(nearest
foot)

LOCATION OF WELL ON LOT

SHOW PERMANENT STRUCTURE SUCH AS
BUILDING, SEPTIC TANKS, AND/OR
LANDMARKS AND INDICATE NOT LESS
THAN TWO DISTANCES
(MEASUREMENTS TO WELL)CIRCLE APPROPRIATE LETTER
A A WELL WAS ABANDONED AND SEALED
WHEN THIS WELL WAS COMPLETED

E ELECTRIC LOG OBTAINED

P TEST WELL CONVERTED TO PRODUCTION
WELLI HEREBY CERTIFY THAT THIS WELL HAS BEEN CONSTRUCTED IN
ACCORDANCE WITH COMAR 10.17.13 "WELL CONSTRUCTION"
AND IN CONFORMANCE WITH ALL CONDITIONS STATED IN THE
ABOVE CAPTIONED PERMIT, AND THAT THE INFORMATION
PRESENTED HEREIN IS ACCURATE AND COMPLETE TO THE BEST
OF MY KNOWLEDGE.

DRILLERS IDENT. NO.

DRILLERS SIGNATURE
(MUST MATCH SIGNATURE ON APPLICATION)SITE SUPERVISOR (sign. of driller or journeyman
responsible for sitework if different from permittee)

HEALTH

RECEIVED
HOWARD COUNTY
HEALTH DEPT

OCT 19 4 12 PM '87

DIVISION OF
ENVIRONMENTAL
HEALTH

RECEIVED
HOWARD COUNTY
HEALTH DEPT
ELLICOTT CITY, MD

OCT 19 9 24 AM '87

APPLICATION

SEWAGE DISPOSAL TESTING

STATE OF MARYLAND - DEPARTMENT OF HEALTH AND MENTAL HYGIENE

A 24717

P _____

HOWARD COUNTY HEALTH DEPARTMENT
ENVIRONMENTAL HEALTH SERVICES

P. O. BOX 476 ELLICOTT CITY, MARYLAND 21043
TELEPHONE: 992-2330

DISTRICT _____

DATE _____

TO: THE COUNTY HEALTH OFFICER
ELLICOTT CITY, MARYLAND

I, HEREBY, APPLY FOR THE NECESSARY TEST IN ORDER TO CONSTRUCT (OR RECONSTRUCT) A SEWAGE DISPOSAL SYSTEM.

PROPERTY OWNER MR & MRS SMITH W. ALLNUTT JR NU HOMES

ADDRESS 13288 HIGHLAND RD PHONE _____

PROPERTY LOCATION:

SUBDIVISION ALLNUTT FARMS SECTION III LOT NO. LOT 6

ROAD AND DESCRIPTION 13275 STYLER CT.

SIZE OF LOT _____ TYPE BLDG. _____
(NUMBER OF BEDROOMS)

THE SYSTEM INSTALLED UNDER THIS APPLICATION IS ACCEPTABLE ONLY UNTIL PUBLIC FACILITIES BECOME AVAILABLE. I FULLY UNDERSTAND THE
FEE CONNECTED WITH THE FILING OF THIS PERC TEST APPLICATION IS NON-REFUNDABLE UNDER ANY CIRCUMSTANCES. I ALSO AGREE TO COMPLY
WITH ALL M.O.S.H.A. REQUIREMENTS IN TESTING THIS LOT.

(SIGNATURE OF APPLICANT)

APPROVED BY Frank Skinner FOR trenches DATE 1/29/85

REJECTED BY _____ FOR _____ DATE _____



HOLD PENDING FURTHER TESTS _____ DATE _____

REASONS FOR REJECTION OR HOLDING CERTIFIED PLAT REQUIRED 5/3/84 CW

BLDG. PERMIT SIGNED
AND RETURNED 1-8-88

BP 16256
SK

THIS IS NOT A PERMIT

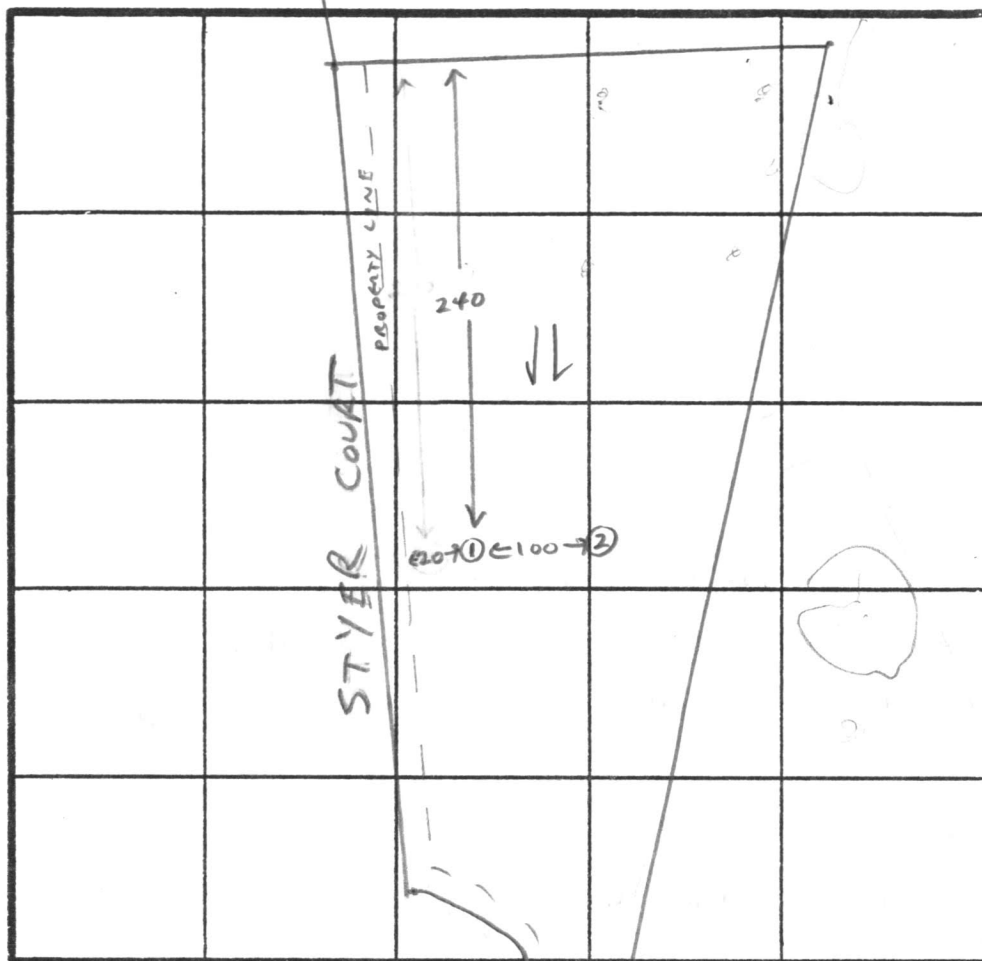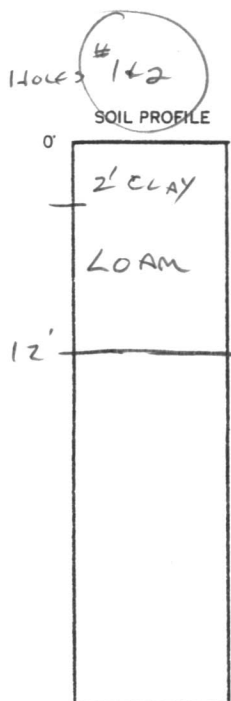

INDICATE NORTH - NAME ADJOINING ROADWAY AS BASE LINE.

DATE	TEST NO.	DEPTH	PRE-WET		TEST - 1" DROP		TIME
			START	STOP	START	STOP	
5-3-84	1	3	11:47	11:50	11:50	11:55	5
		8	11:47	11:49	11:49	11:52	3 MIN
		12	LOAM	2'-12'	DAY		
5-3-84	2	3	11:50	11:52	11:52	11:54	2
		8	11:50	11:52	11:52	11:54	2 MIN
		12	LOAM	2'-12'	DAY		

REMARKS _____

TYPE OF SOIL MICA-SAND LOAM

TESTED BY C. Willard

ALSO PRESENT WHITWORTH & ALLNOTT'S

APPLICATION

A 24717

SEWAGE DISPOSAL TESTING

P _____

STATE OF MARYLAND - DEPARTMENT OF HEALTH AND MENTAL HYGIENE

HOWARD COUNTY HEALTH DEPARTMENT
ENVIRONMENTAL HEALTH SERVICES

DISTRICT Fif th

P. O. BOX 176, ELLICOTT CITY, MARYLAND 21043
TELEPHONE: 465-5000, EXT. 356

DATE 9/9/76

TO: THE COUNTY HEALTH OFFICER
ELLICOTT CITY, MARYLAND

I, HEREBY, APPLY FOR THE NECESSARY TEST IN ORDER TO CONSTRUCT (OR RECONSTRUCT) A SEWAGE DISPOSAL SYSTEM.

PROPERTY OWNER Mr. and Mrs. Smith W. Allnutt, Jr

13288 Highland Road

ADDRESS Highland, MD 20777 PHONE 988-9303

PROPERTY LOCATION:

Allnutt Farms

SUBDIVISION Hi - Land Farm Estates LOT NO. 105, Sec 3

ROAD AND DESCRIPTION Road "D"

SIZE OF LOT 1.71 Ac TYPE BLDG. 3 or 4 bedroom

NUMBER OF BEDROOMS

IF NOT SINGLE RESIDENCE DESCRIBE _____

THE SYSTEM INSTALLED UNDER THIS APPLICATION IS ACCEPTABLE ONLY UNTIL PUBLIC FACILITIES BECOME AVAILABLE.

SIGNATURE OF APPLICANT /s/ Margaret G. Allnutt

APPROVED BY _____ FOR _____ DATE _____

(KIND OF SYSTEM)

REJECTED BY _____ FOR _____ DATE _____

(KIND OF SYSTEM)

HOLD PENDING FURTHER TESTS N/A DATE 4/26/77

REASONS FOR REJECTION OR HOLDING 10/19/76 Hold for wet season testing F. Skinner

4/26/77 - Soil water level marginal (8') hold for development ✓ water level before lot is approved

THIS IS NOT A PERMIT

APPLICATION

A 24717

SEWAGE DISPOSAL TESTING

P _____

STATE OF MARYLAND - DEPARTMENT OF HEALTH AND MENTAL HYGIENE

HOWARD COUNTY HEALTH DEPARTMENT
ENVIRONMENTAL HEALTH SERVICES

DISTRICT Fifth

P. O. BOX 476, ELLICOTT CITY, MARYLAND 21043
TELEPHONE: 465-5000, EXT. 356

DATE 9/9/76

TO: THE COUNTY HEALTH OFFICER
ELLICOTT CITY, MARYLAND

I, HEREBY, APPLY FOR THE NECESSARY TEST IN ORDER TO CONSTRUCT (OR RECONSTRUCT) A SEWAGE DISPOSAL SYSTEM.

PROPERTY OWNER Mr. and Mrs. Smith W. Allnutt, Jr.

ADDRESS 13288 Highland Road
Highland, MD 20777 PHONE 988-9303

PROPERTY LOCATION: Allnutt Farms

SUBDIVISION III - Land Farm Estates Sec. 3 LOT NO. 105 6

ROAD AND DESCRIPTION Road "D"

SIZE OF LOT 1.71 Ac TYPE BLDG. 3 or 4 bedroom

NUMBER OF BEDROOMS

IF NOT SINGLE RESIDENCE DESCRIBE _____

THE SYSTEM INSTALLED UNDER THIS APPLICATION IS ACCEPTABLE ONLY UNTIL PUBLIC FACILITIES BECOME AVAILABLE.

SIGNATURE OF APPLICANT /s/ Margaret G. Allnutt

APPROVED BY _____ FOR _____ DATE _____

(KIND OF SYSTEM)


REJECTED BY _____ FOR _____ DATE _____

(KIND OF SYSTEM)

HOLD PENDING FURTHER TESTS _____ DATE _____

REASONS FOR REJECTION OR HOLDING _____

THIS IS NOT A PERMIT

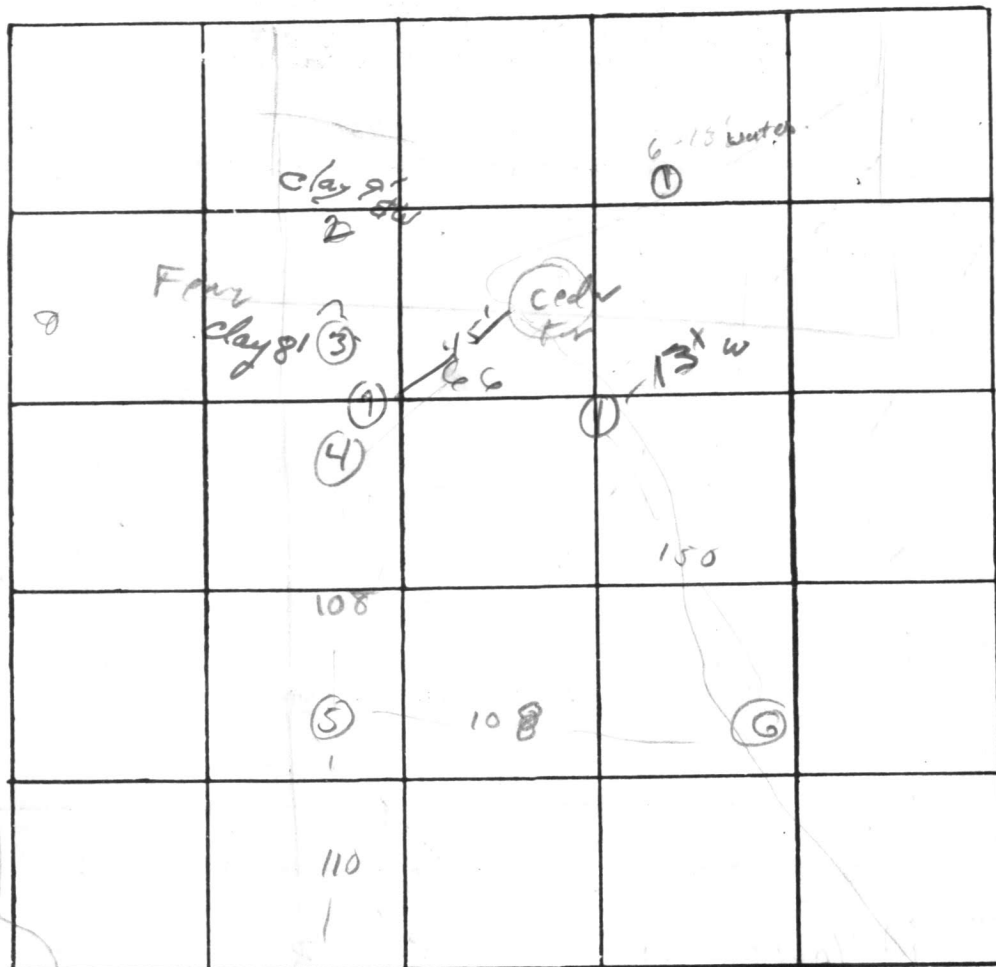

INDICATE NORTH. - NAME ADJOINING ROADWAY AS BASE LINE

Date 7/10/76
Back in 1976
Oct

DATE	TEST NO.	DEPTH	PRE-WET		TEST - 1" DROP		TIME
			START	STOP	START	STOP	
10/2/40	1 5						
	2	clay + water 9'					
	3	clay 8'					
	4 s	6'	223	226	226	237	11
	d	13' w					
	5 s	6'	236	240	240	204	24
	d	14'	236	239	239	340	3
	6 s	3'	255	300	300	309	9
	d	13'	258			300	1 min
9/22/40	7	13'	clay				

FS

FS

9x
5'

REMARKS _____

TYPE OF SOIL _____

TESTED BY DJO Neil ALSO PRESENT: _____