

SYSTEM INSTALLED FIRST

PERMIT

SEWAGE DISPOSAL SYSTEM

MARYLAND STATE DEPARTMENT OF HEALTH*

HOWARD COUNTY

ELLCOTT CITY

DISTRICT 5th.

DATE 8/7/79

05-381983

INDEXED

approved 8/20/79

J. Stayer

P 30077

A 24865

8/17/79
8/20/79

Robert T. Orndorff

IS PERMITTED TO INSTALL X ALTER

ADDRESS 13938 Highland Rd., Clarksville, Md. 21029 PHONE 596-9394

SUBDIVISION Wesley Hills ROAD Rowley Court LOT 5

PROPERTY OWNER F. G. Marker Co., Inc.

ADDRESS 11443 Rowley Road, Clarksville, Md. 21029

SPECIFICATIONS 4 Bedrooms

SEPTIC TANK CAPACITY 1250 GALLONS

DRAIN FIELD _____ DEPTH _____ FEET, BOTTOM AREA _____ SQ. FT.

DEEP TRENCH _____ DEPTH _____ FEET, BOTTOM AREA _____ SQ. FT.

Dry Well SEEPAGE PITS X ABSORBENT SIDE-WALL AREA 249 SQ. FT. area per bedroom

INLET PIPE 4 FT. BELOW ORIGINAL GRADE. MAXIMUM DEPTH 13 FT. BELOW ORIGINAL GRADE

EFFECTIVE DEPTH AT _____ FT. BELOW ORIGINAL GRADE.

1st. Dry Well LOCATE DISPOSAL AREA 60 FT. FROM Court LOT LINE AND 40 FT. FROM Left LOT LINE AS SEEN WHEN
FACING LOT FROM Rowley Court.

~~Two Dry Wells may be needed - Keep dry wells 3 times the diameter of the dry well apart.
A dry well and a ditch may be used also. System must be installed before building
permit issued.~~

PLANS APPROVED BY Raymond Hodges DATE 10/17/79

COVER NO WORK UNTIL INSPECTED AND APPROVED.

NEITHER THE HOWARD COUNTY COUNCIL NOR THE HEALTH DEPARTMENT IS RESPONSIBLE FOR THE SUCCESSFUL OPERATION OF ANY SYSTEM.

NOTE: IF TRENCH IS USED CALL FOR INSPECTION BEFORE PLACING GRAVEL IN TRENCH.

NOTE: NO DRY WELL SHALL EXCEED 15 FOOT IN DIAMETER.

NOTE: ALL PIPE FROM HOUSE TO DISPOSAL AREA MUST BE CAST IRON.

PERMIT VOID AFTER THREE YEARS.

NOTE: INSTALL STAND PIPE ON SEPTIC TANK AND DRY WELL. STAND PIPES MUST BE 6 INCHES IN DIAMETER. CAST IRON, CONCRETE OR TERRA
COTTA ACCEPTED.

BLDG. PERMIT SIGNED
AND RETURNED 9/18/80


Serial # 43502
Wick

*INSTALLER IS RESPONSIBLE FOR OBTAINING FINAL APPROVAL ON THIS PERMIT.

A 24865

249
4
996

60

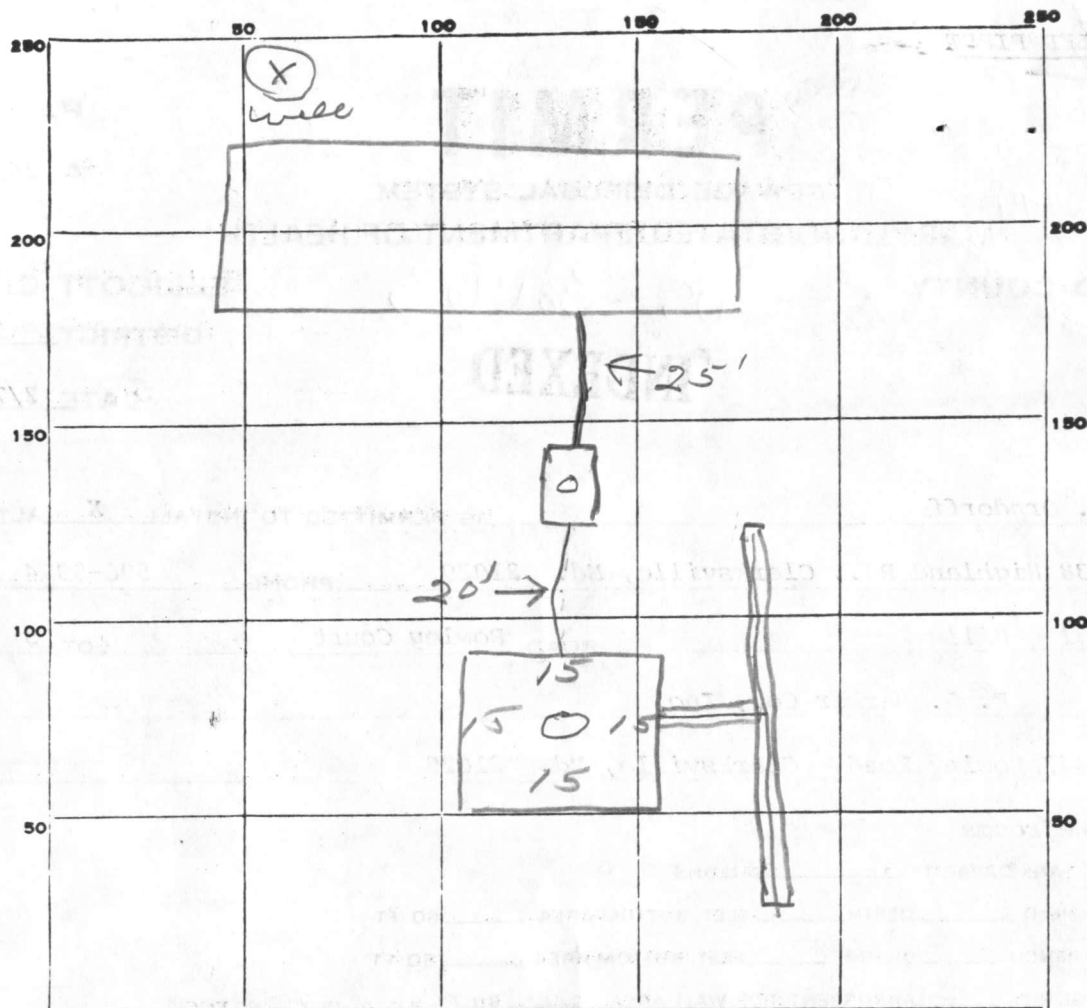

INDICATE NORTH. - NAME ADJOINING ROADWAY AS BASE LINE.

PERMIT CARD

SEPTIC TANK, LEVEL

CLEANOUTS ST/DW

DISTRIBUTION BOX, LEVEL

TILE FIELD, DEPTH 13 FT. TRENCH WIDTH 2 FT.

GRAVEL DEPTH 9 IN. TOTAL LENGTH 56 FT.

NUMBER OF TRENCHES 1 TOTAL BOTTOM AREA 504

SEEPAGE PITS, INSIDE DIAMETER 60 FT. DEPTH BELOW INLET 9 FT.

ABSORBENT AREA 1044 SQ. FT.

REMARKS 8/17/79 - OK to add gravel to trench, add
cleanouts & pipe. Location of trench changed - OK'd by FF
Call. J.S.

8/20/79 OK to cover all work. J.S.

DATE SYSTEM APPROVED 8/20/79

INSPECTOR J. Stays

APPLICATION

A 24865

SEWAGE DISPOSAL TESTING

P _____

STATE OF MARYLAND - DEPARTMENT OF HEALTH AND MENTAL HYGIENE

HOWARD COUNTY HEALTH DEPARTMENT
ENVIRONMENTAL HEALTH SERVICES

P. O. BOX 476, ELLICOTT CITY, MARYLAND 21043
TELEPHONE: 465-5000, EXT. 356

DISTRICT 5th

DATE 12/1/76

*System first
See separate sheet*

TO: THE COUNTY HEALTH OFFICER
ELLICOTT CITY, MARYLAND

I, HEREBY, APPLY FOR THE NECESSARY TEST IN ORDER TO CONSTRUCT (OR RECONSTRUCT) A SEWAGE DISPOSAL SYSTEM.

PROPERTY OWNER Capital District Wesleyan Church

ADDRESS 10929 Pleasant Acres Drive, Hyattsville 20783 PHONE 559-2626

PROPERTY LOCATION:

SUBDIVISION Wesley Hills LOT NO. 5

ROAD AND DESCRIPTION Kraus Road *Rowley Ct*

SIZE OF LOT 40,000 sq. feet TYPE BLDG. 4

NUMBER OF BEDROOMS

IF NOT SINGLE RESIDENCE DESCRIBE _____

THE SYSTEM INSTALLED UNDER THIS APPLICATION IS ACCEPTABLE ONLY UNTIL PUBLIC FACILITIES BECOME AVAILABLE.

SIGNATURE OF APPLICANT /s/ James W. Kraus, President

APPROVED BY Raymond Hodge FOR Dry Wells DATE 10/17/77

(KIND OF SYSTEM)


REJECTED BY _____ FOR _____ DATE _____

(KIND OF SYSTEM)

HOLD PENDING FURTHER TESTS _____ DATE _____

REASONS FOR REJECTION OR HOLDING _____

THIS IS NOT A PERMIT

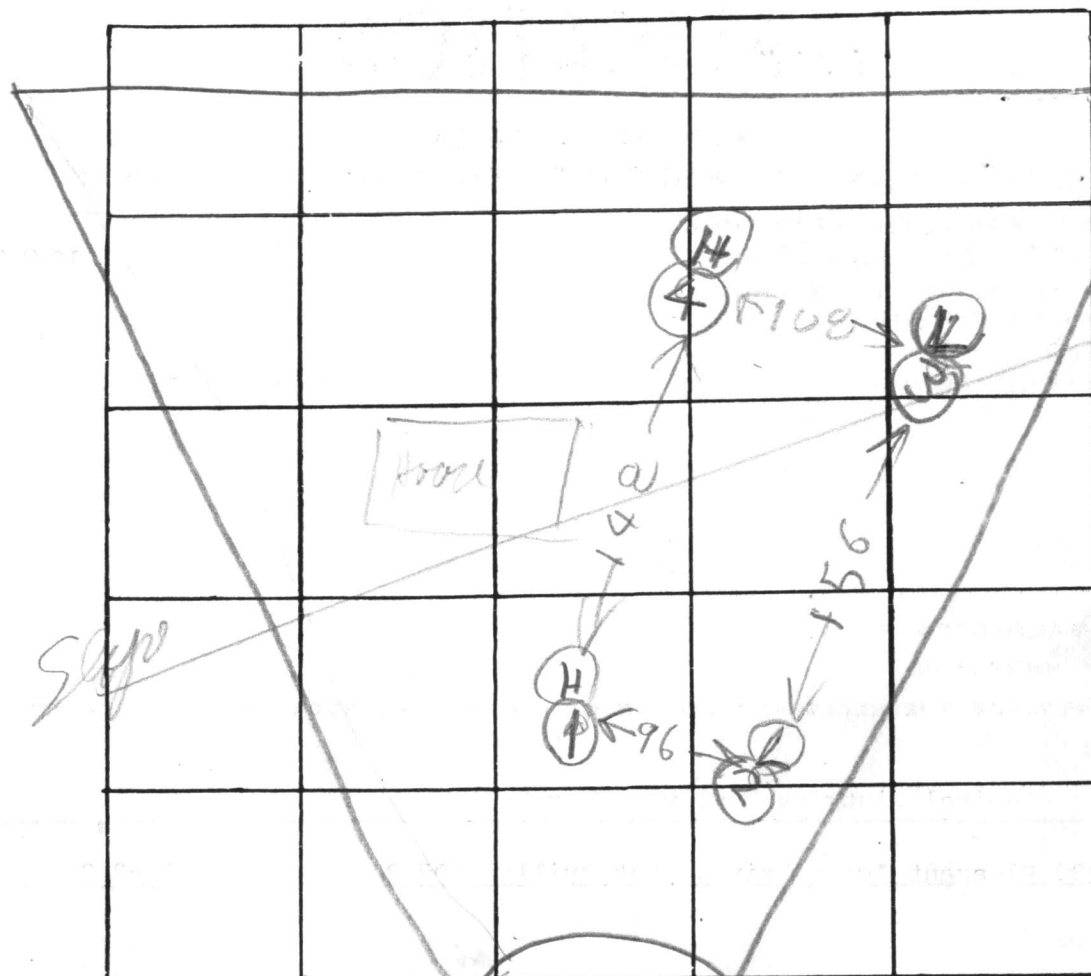

INDICATE NORTH. - NAME ADJOINING ROADWAY AS BASE LINE

DATE	TEST NO.	DEPTH	PRE-WET		TEST - 1" DROP		TIME
			START	STOP	START	STOP	
12/14/76	1S	5	258	310	316	330	20
12/14/76	1D	13	258	304	304	325	21
	2S	4	259	305	305	310	55
	2D	12	259	310	310	322	12
	3S	4	303	308	308	315	7
	3D	14	303	310	310	323	13
12/14/76	4V	11 1/2	76 1/2	315	315	327	PK7

Hole Level

Highest use far W

Low

Lowest

Next High

REMARKS

TYPE OF SOIL

TESTED BY

JRH & RB

ALSO PRESENT:


Fyock

Lot 5

Ar Time 13

Max Depth 4

4.23.79

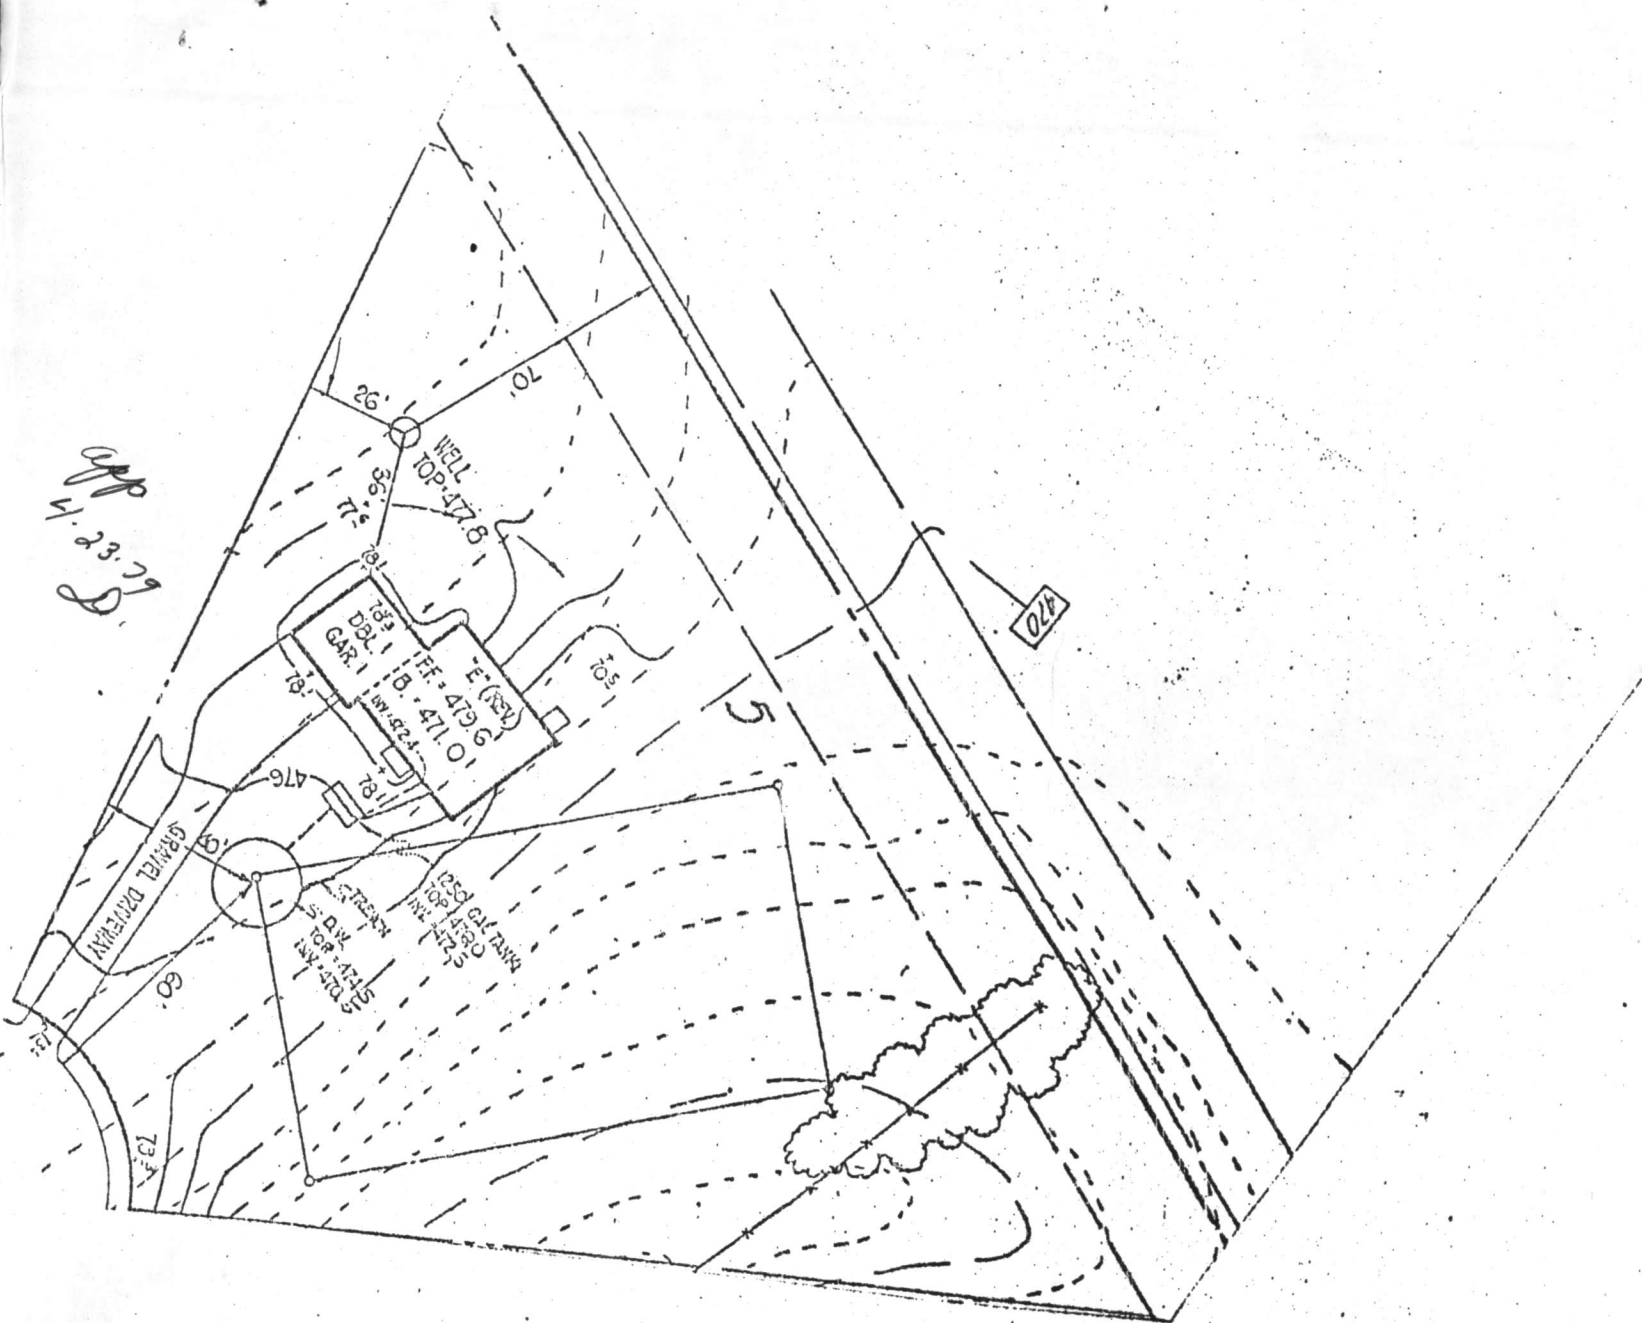

C 1	0381	SEQUENCE NO. (WRA USE ONLY)
1 2 3 (SEQ. NO.) 6	(THIS NUMBER IS TO BE PUNCHED IN COLS. 3-6 ON ALL CARDS)	

STATE OF MARYLAND
WATER RESOURCES ADMINISTRATION
TAWES STATE OFFICE BLDG., ANNAPOLIS, MD. 21401
WELL COMPLETION REPORT

THIS REPORT MUST BE SUBMITTED WI
IN 30 DAYS AFTER WELL COMPLET

FILL IN THIS FORM COMPLETELY

COUNTY
NUMBERDATE RECEIVED
(WRA USE ONLY)

DATE WELL COMPLETED

DEPTH OF WELL

22 (TO NEAREST FOOT) 26

PERMIT NO. FROM "PERMIT TO DRILL WELL"

H0-73-3043
28 29 30 31 32 33 34 35 36 37

DRILLERS IDENTIFICATION NO.

238

OWNER Marble LAST NAME 5900 Primrose Lane FIRST NAME Co-Inc.
 STREET OR RFD 5900 Primrose Lane POST OFFICE Greenbelt MD.

WELL DESCRIPTION

WELL LOG

STATE THE KIND OF FORMATIONS PENETRATED, THEIR
COLOR, DEPTH, THICKNESS AND IF WATER BEARINGDESCRIPTION
(USE ADDITIONAL SHEETS
IF NECESSARY)FEET
FROM TOCHECK IF
WATER
BEARING

Land 0 77
 Gray Mica Rock 77 300

GROUTING RECORD

WELL HAS BEEN GROUTED
(CIRCLE APPROPRIATE BOX)YES NO
Y N
44 44

TYPE OF GROUTING MATERIAL (CIRCLE BOX)

CEMENT C M BENTONITE CLAY B C
45 46 45 46

NO. OF BAGS 20 NO. OF POUNDS 1880

GALLONS OF WATER 120

DEPTH OF GROUT SEAL (TO NEAREST FOOT)

FROM 0 FT. TO 60 FT.
(ENTER 0 IF FROM SURFACE)

CASING RECORD

CASING
TYPES
(INSERT
APPROPRIATE
CODE
BELOW)

S T

STEEL

C O

CONCRETE

P L

PLASTIC

O T

OTHER

MAIN
CASING
TYPENOMINAL DIAMETER
TOP (MAIN) CASING
(NEAREST INCH)TOTAL DEPTH
OF MAIN CASING
(NEAREST FOOT)S + 6 81
60 61 63 64 66 70

OTHER CASING (IF USED)

DIAMETER
(INCH)DEPTH (FEET)
FROM TOE
A
C
H
C
A
S
I
N
GSCREEN TYPE
OR OPEN HOLE

SCREEN RECORD

(INSERT
APPROPRIATE
CODE
BELOW)

S T

STEEL

B R

BRASS
OR BRONZE

H O

OPEN HOLE

P L

PLASTIC

O T

OTHER

C 2 (SEQ. NO.) 6

DEPTH (NEAREST WHOLE FOOT)

FROM TO

E
A
C
H
S
C
R
E
E
N

1 8 9 11 15 17 21

2 23 24 26 30 32 36

3 38 39 41 45 47 51

SLOTSIZE 1, 2, 3,

DIAMETER OF SCREEN 56 (NEAREST INCH)

FROM TO

GRAVEL PACK

IF WELL DRILLED WAS A
FLOWING WELL CIRCLE BOX 68 F

WRA USE ONLY (NOT TO BE FILLED IN BY DRILLER)

T 70

(E.R.O.S.)

72

W Q

TELESCOPE
CASINGLOG
INDICATOR74 75 76
OTHER DATA
AVAILABLE

PUMPING TEST

HOURS PUMPED (TO NEAREST HOUR) 4

PUMPING RATE
(GALLONS PER MINUTE TO NEAREST GALLON) 2METHOD USED TO
MEASURE PUMPING RATE

WATER LEVEL: (DISTANCE FROM LAND SURFACE)

BEFORE PUMPING 45 (NEAREST
FOOT) 17 20WHEN PUMPING 5 (NEAREST
FOOT) 22 25TYPE OF PUMPED USED (CIRCLE APPROPRIATE BOX)
(FOR PUMPING TEST)A AIR
27P PISTON
27T TURBINE
27C CENTRIFUGAL
27R ROTARY
27O OTHER
(DESCRIBE
BELOW)
27J JET
27S SUBMERSIBLE
27

PUMP INSTALLED

TYPE OF PUMP (WRITE APPROPRIATE LETTER IN
BOX - SEE ABOVE: A, C, J, P, R, S, T, O)DRILLER WILL INSTALL PUMP
(CIRCLE APPROPRIATE BOX)YES NO
Y N

CAPACITY:

GALLONS PER MINUTE
(TO NEAREST GALLON) 31 35

PUMP HORSE POWER 37 41

PUMP COLUMN LENGTH
(NEAREST FOOT) 43 47CASING HEIGHT (CIRCLE APPROPRIATE BOX
AND ENTER CASING HEIGHT)


+ ABOVE

LAND SURFACE

- BELOW

50 2 51 (NEAREST
FOOT)

LOCATION OF WELL ON LOT

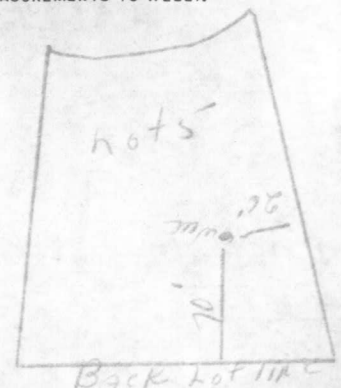N SHOW PERMANENT STRUCTURE SUCH AS BUILDINGS,
SEPTIC TANKS, AND/OR OTHER LAND MARKS AND
INDICATE NOT LESS THAN TWO DISTANCES
(MEASUREMENTS TO WELL).

CIRCLE APPROPRIATE BOXES

A A WELL WAS ABANDONED AND SEALED WHEN THIS
WELL WAS COMPLETED

E ELECTRIC LOG OBTAINED

P TEST WELL CONVERTED TO PRODUCTION WELL

I HEREBY CERTIFY THAT I HAVE COMPLIED WITH ALL
CONDITIONS STATED ON THE ABOVE-CAPTIONED "PERMIT
TO DRILL WELL", AND THAT INFORMATION CONTAINED
IN THIS REPORT IS TRUE, ACCURATE, AND COMPLETE TO
THE BEST OF MY KNOWLEDGE, INFORMATION AND
BELIEF.

DRILLERS NAME

(PLEASE PRINT) Joseph L. Mayne

SIGNATURE Joseph L. Mayne

RECEIVED
APR 5 9 26 AM '70
HOWARD COUNTY
HEALTH DEPT.
ELLICOTT CITY, MD.

