

05-381959

approved 3/27/80
J. Stayer

PERMIT

SEWAGE DISPOSAL SYSTEM

MARYLAND STATE DEPARTMENT OF HEALTH*

HOWARD COUNTY

ELLICOTT CITY

DISTRICT 5th

DATE 3/24/80

INDEXED

Robert L. Orndorff

IS PERMITTED TO INSTALL X ALTER

ADDRESS 13938 Highland Road, Clarksville, Md. 21029 PHONE 596-9394

SUBDIVISION Wesley Hills ROAD 11449 Rowley Road LOT 6

PROPERTY OWNER F. G. Marker Co., Inc.
5900 Princess Garden Parkway, Suite 707, Lanham, Md.

ADDRESS ~~11449 Rowley Road, Clarksville, Md. 21029~~

SPECIFICATIONS 4 bedrooms

SEPTIC TANK CAPACITY 1250 GALLONS

DRAIN FIELD _____ DEPTH _____ FEET, BOTTOM AREA _____ SQ. FT.

DEEP TRENCH _____ DEPTH _____ FEET, BOTTOM AREA _____ SQ. FT.

SEEPAGE PITS X ABSORBENT SIDE-WALL AREA 120 SQ. FT. per bedroom.

INLET PIPE 4 FT. BELOW ORIGINAL GRADE. MAXIMUM DEPTH 12 FT. BELOW ORIGINAL GRADE

EFFECTIVE DEPTH AT _____ FT. BELOW ORIGINAL GRADE.

LOCATE DISPOSAL AREA 88 FT. FROM back LOT LINE AND 62 FT. FROM right LOT LINE AS SEEN WHEN
FACING LOT FROM Rowley Road.

PLANS APPROVED BY Raymond Hodges

DATE 10/17/77

COVER NO WORK UNTIL INSPECTED AND APPROVED.

NEITHER THE HOWARD COUNTY COUNCIL NOR THE HEALTH DEPARTMENT IS RESPONSIBLE FOR THE SUCCESSFUL OPERATION OF ANY SYSTEM.

NOTE: IF TRENCH IS USED CALL FOR INSPECTION BEFORE PLACING GRAVEL IN TRENCH.

NOTE: NO DRY WELL SHALL EXCEED 15 FOOT IN DIAMETER.

NOTE: ALL PIPE FROM HOUSE TO DISPOSAL AREA MUST BE CAST IRON.

PERMIT VOID AFTER THREE YEARS.

NOTE: INSTALL STAND PIPE ON SEPTIC TANK AND DRY WELL. STAND PIPES MUST BE 6 INCHES IN DIAMETER. CAST IRON, CONCRETE OR TERRA
COTTA ACCEPTED.

*INSTALLER IS RESPONSIBLE FOR OBTAINING FINAL APPROVAL ON THIS PERMIT.

BLDG. PERMIT SIGNED


AND RETURNED

10/9/84
Serial # 8257 - Prod.

A 24866

480

62
8
496

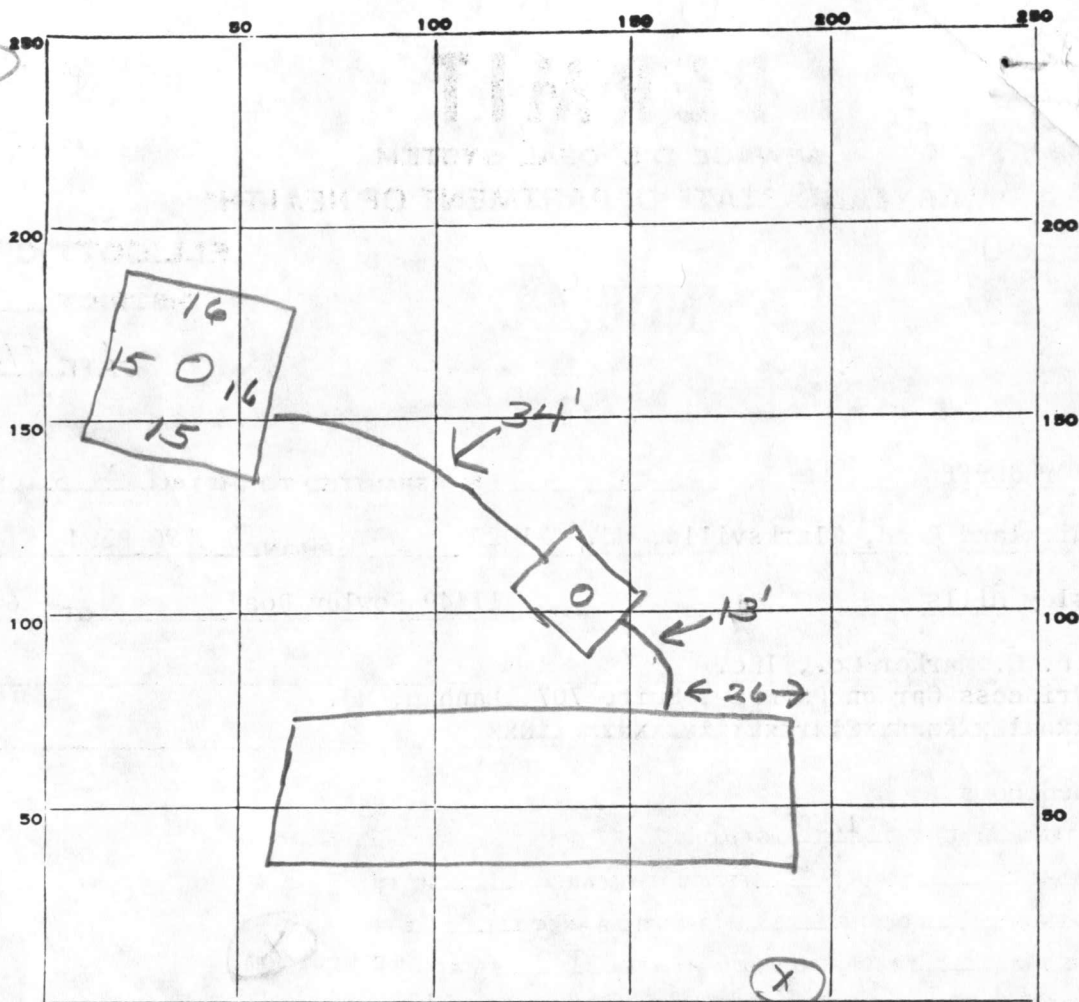

INDICATE NORTH. - NAME ADJOINING ROADWAY AS BASE LINE.

PERMIT CARD ☒

SEPTIC TANK, LEVEL ☒

CLEANOUTS ST/DW

DISTRIBUTION BOX, LEVEL ☒

TILE FIELD, DEPTH _____ FT. TRENCH WIDTH _____ FT.

GRAVEL DEPTH _____ IN. TOTAL LENGTH _____ FT.

NUMBER OF TRENCHES _____ TOTAL BOTTOM AREA _____

SEEPAGE PITS, INSIDE DIAMETER 62 FT. DEPTH BELOW INLET 8 FT.

ABSORBENT AREA 496 SQ. FT.

REMARKS 3/27/80 OK to cover all work. JH+SK

DATE SYSTEM APPROVED 3/27/80 INSPECTOR J. Payer

APPLICATION

A 24866

SEWAGE DISPOSAL TESTING

P _____

STATE OF MARYLAND - DEPARTMENT OF HEALTH AND MENTAL HYGIENE

HOWARD COUNTY HEALTH DEPARTMENT
ENVIRONMENTAL HEALTH SERVICES

DISTRICT 5th

P. O. BOX 476, ELLICOTT CITY, MARYLAND 21043
TELEPHONE: 465-5000, EXT. 356

DATE 12/1/76

system first see attached sheet for spec

BLDG. PERMIT SIGNED
AND RETURNED 4/27/79

Serial # 39214

TO: THE COUNTY HEALTH OFFICER
ELLICOTT CITY, MARYLAND

I, HEREBY, APPLY FOR THE NECESSARY TEST IN ORDER TO CONSTRUCT (OR RECONSTRUCT) A SEWAGE DISPOSAL SYSTEM.

PROPERTY OWNER Capital District Wesleyan Church

ADDRESS 10929 Pleasant Acres Drive, Hyattsville 20783 PHONE 559-2626

PROPERTY LOCATION:

SUBDIVISION Wesley Hills LOT NO. 6

ROAD AND DESCRIPTION Kraus Road ROWLEY RD

SIZE OF LOT 40,000 sq. feet TYPE BLDG. 4

NUMBER OF BEDROOMS

IF NOT SINGLE RESIDENCE DESCRIBE _____

THE SYSTEM INSTALLED UNDER THIS APPLICATION IS ACCEPTABLE ONLY UNTIL PUBLIC FACILITIES BECOME AVAILABLE.

SIGNATURE OF APPLICANT /s/ James W. Kraus, President


APPROVED BY Raymond Hodge FOR DR7WELL DATE 10/17/77
(KIND OF SYSTEM)

REJECTED BY _____ FOR _____ DATE _____
(KIND OF SYSTEM)

HOLD PENDING FURTHER TESTS _____ DATE _____

REASONS FOR REJECTION OR HOLDING _____

THIS IS NOT A PERMIT

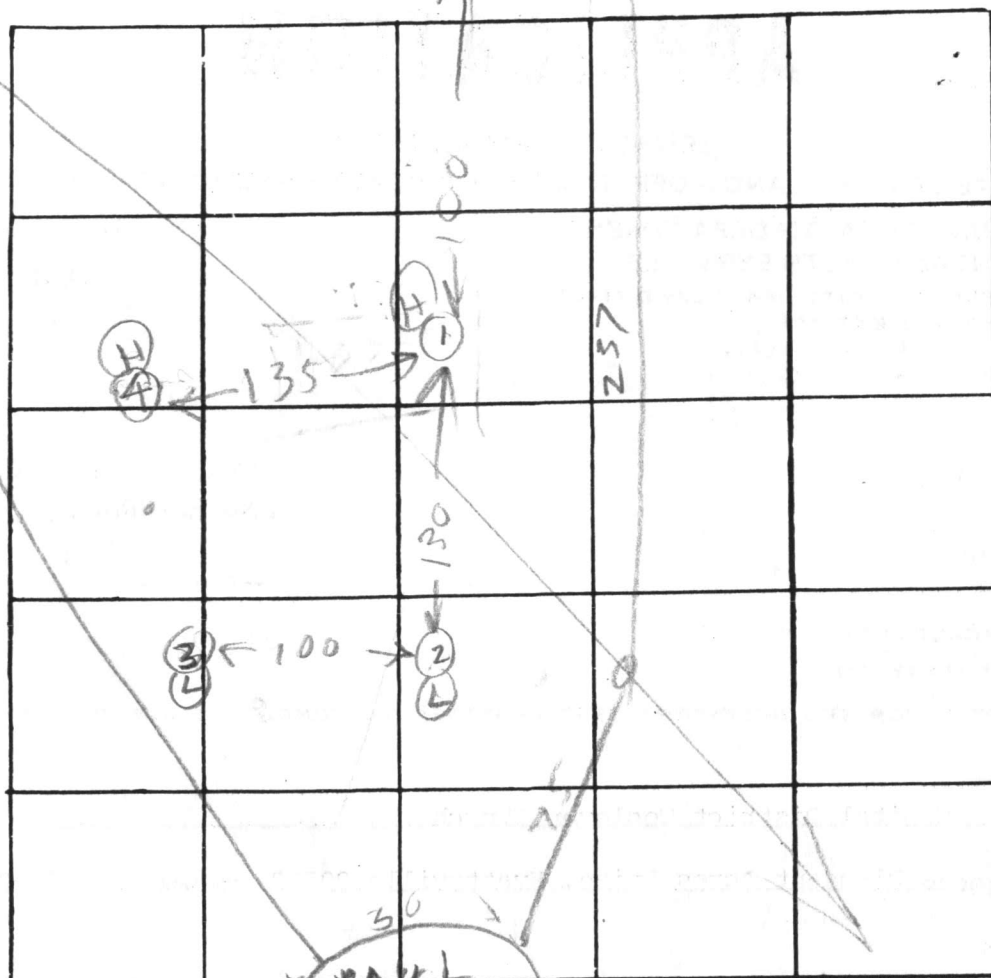


DATE	TEST NO.	DEPTH	PRE-WET		TEST - 1" DROP		TIME
			START	STOP	START	STOP	
2/17/76	1D	1 1/2	1030	1036	1036	1039	3
	1S	5	1030	1036	1036	1037	1
	2S	4	1032	1035	1035	1041	6
	2D	13	1032	1049	1044	1052	11
	3D	14	1043	1047	1047	1051	4
	3S	4	1043	1048	1045	1047	2
1/7/76	4D	13	TOP BOT	3 FT CLAS 10 FT SANIM			7

REMARKS Holes dug at different sites from those
TYPE OF SOIL shown on testing plat Engineer to Certify Holes
TESTED BY BIF ALSO PRESENT: F. York

ALSO PRESENT:

Ar Time 6 MaxDepth 5


Wesley Hills

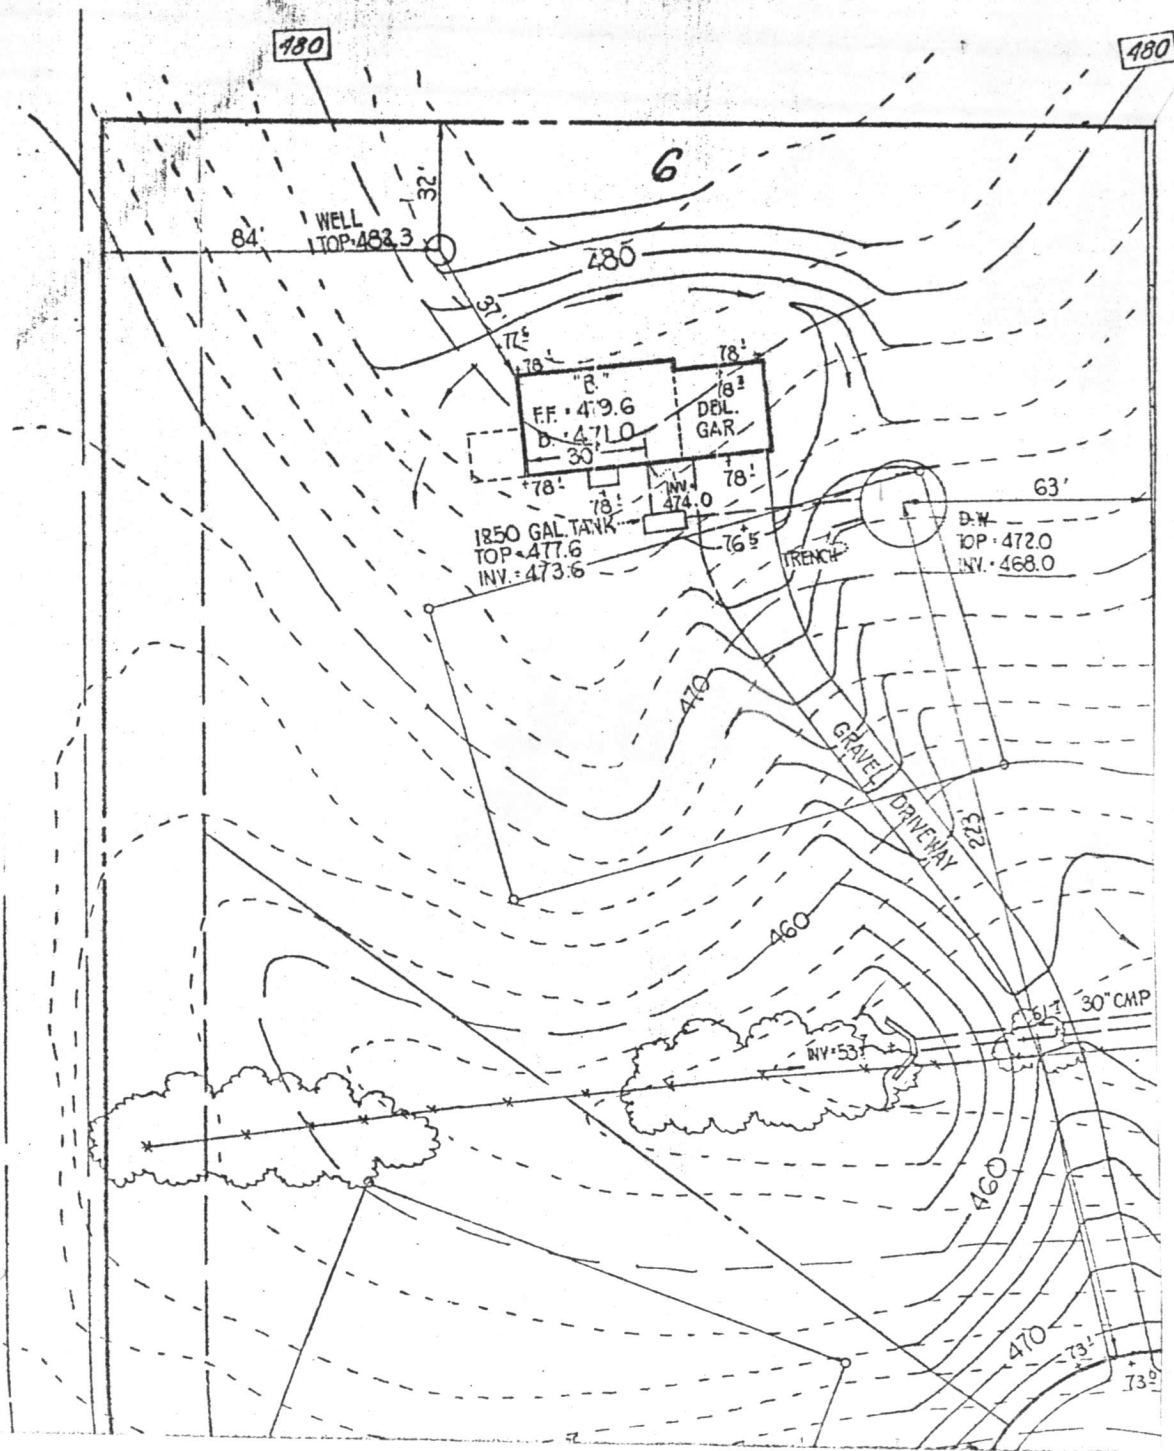

474.0
473.6
4

Note Certification Statement on large plat


4/27/79 Plans O.K.
Well drilled R.H.

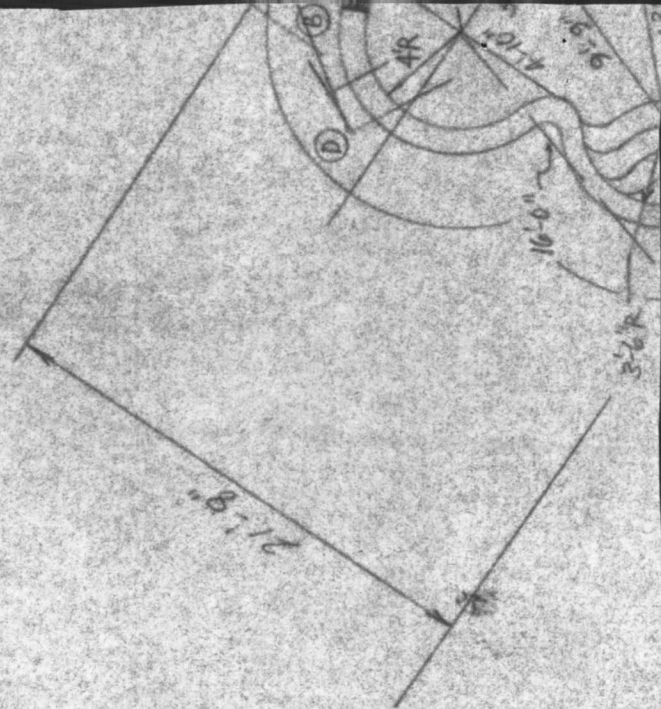

NO IMPACT ON
WELL OR SEPTIC
10/9/86
C. Williams

11449 ROWLEY RD.
LOT 6
WESLEY HILLS
5TH ELECT. DIST.
HOWARD CO., MD.
SCALE: 1" = 50'

C 1		0382		SEQUENCE NO. (WRA USE ONLY)		STATE OF MARYLAND WATER RESOURCES ADMINISTRATION TAWES STATE OFFICE BLDG., ANNAPOLIS, MD. 21401 WELL COMPLETION REPORT		THIS REPORT MUST BE SUBMITTED IN 30 DAYS AFTER WELL COMPLET	
1 2 3 (SEQ. NO.) 6								FILL IN THIS FORM COMPLETELY	
(THIS NUMBER IS TO BE PUNCHED IN COLS. 3-6 ON ALL CARDS)								COUNTY NUMBER	
DATE RECEIVED (WRA USE ONLY)		APR 19 1979		DEPTH OF WELL		265		PERMIT NO. FROM "PERMIT TO DRILL WELL"	
		DATE WELL COMPLETED		22 (TO NEAREST FOOT)		26		140-73-3046	
8-13		15 20						28 29 30 31 32 33 34 35 36 37	
								DRILLERS IDENTIFICATION NO. 238	
OWNER		Markus		F. G.		Co -			
STREET OR RFD		5900		Princess Gardens Parkway		POST OFFICE		Lanham Md.	
WELL LOG		WELL DESCRIPTION		GROUTING RECORD		PUMPING TEST		WATER LEVEL	
STATE THE KIND OF FORMATIONS PENETRATED, THEIR COLOR, DEPTH, THICKNESS AND IF WATER BEARING		DESCRIPTION (USE ADDITIONAL SHEETS IF NECESSARY)		WELL HAS BEEN GROUTED (CIRCLE APPROPRIATE BOX)		YES (Y) NO (N)		HOURS PUMPED (TO NEAREST HOUR)	
FEET		CHECK IF WATER BEARING		TYPE OF GROUTING MATERIAL (CIRCLE BOX)		CEMENT (CM) BENTONITE CLAY (BC)		PUMPING RATE (GALLONS PER MINUTE TO NEAREST GALLON)	
FROM TO				NO. OF BAGS NO. OF POUNDS		GALLONS OF WATER		METHOD USED TO MEASURE PUMPING RATE	
0 70		70 265		20 1880		120		2 8	
Sand & Shell mixed		Gray mica Rock		DEPTH OF GROUT SEAL (TO NEAREST FOOT)		FROM 48 FT. TO 58 FT.		WATER LEVEL: (DISTANCE FROM LAND SURFACE)	
				(ENTER 0 IF FROM SURFACE)		48 52 54 58		BEFORE PUMPING 17 20	
				Casing Record		Casing Types		WHEN PUMPING 22 25	
				INSERT APPROPRIATE CODE BELOW		STEEL (ST) CONCRETE (CO)		TYPE OF PUMP USED (CIRCLE APPROPRIATE BOX)	
				MAIN CASING TYPE		NOMINAL DIAMETER TOP (MAIN) CASING (NEAREST INCH)		TOTAL DEPTH OF MAIN CASING (NEAREST FOOT)	
				5 7		6 75		A AIR P PISTON T TURBINE	
				OTHER CASING (IF USED)		Diameter (inch) Depth (feet) FROM TO		C CENTRIFUGAL R ROTARY O OTHER (DESCRIBE BELOW)	
				Screen Record		INSERT APPROPRIATE CODE BELOW		PUMP INSTALLED	
				STEEL (ST) BRASS OR BRONZE (BR) OPEN HOLE (HO)		PLASTIC (PL) OTHER (OT)		TYPE OF PUMP (WRITE APPROPRIATE LETTER IN BOX - SEE ABOVE: A, C, J, P, R, S, T, O)	
				C 2		1 2 3 (SEQ. NO.) 6		DRILLER WILL INSTALL PUMP (CIRCLE APPROPRIATE BOX)	
				DEPTH (NEAREST WHOLE FOOT)		FROM TO		CAPACITY:	
				1 40 73 265		23 24 26 30 32 36		GALLONS PER MINUTE (TO NEAREST GALLON)	
				28 39 41 45 47 51		31 35		PUMP HORSE POWER	
				SLOT SIZE 1, 2, 3		37 41		PUMP COLUMN LENGTH (NEAREST FOOT)	
				Diameter of Screen (NEAREST INCH)		56 60		Casing Height (CIRCLE APPROPRIATE BOX AND ENTER CASING HEIGHT)	
				Gravel Pack		IF WELL DRILLED WAS A FLOWING WELL CIRCLE BOX		+ ABOVE - BELOW	
				WRA USE ONLY (NOT TO BE FILLED IN BY DRILLER)		T (70) W Q (72)		LAND SURFACE (NEAREST FOOT)	
				Telescope Casing Log Indicator		74 75 76 OTHER DATA AVAILABLE		LOCATION OF WELL ON LOT	
								SHOW PERMANENT STRUCTURE SUCH AS BUILDINGS, SEPTIC TANKS, AND/OR OTHER LAND MARKS AND INDICATE NOT LESS THAN TWO DISTANCES (MEASUREMENTS TO WELL).	
								Sketch of Lot	

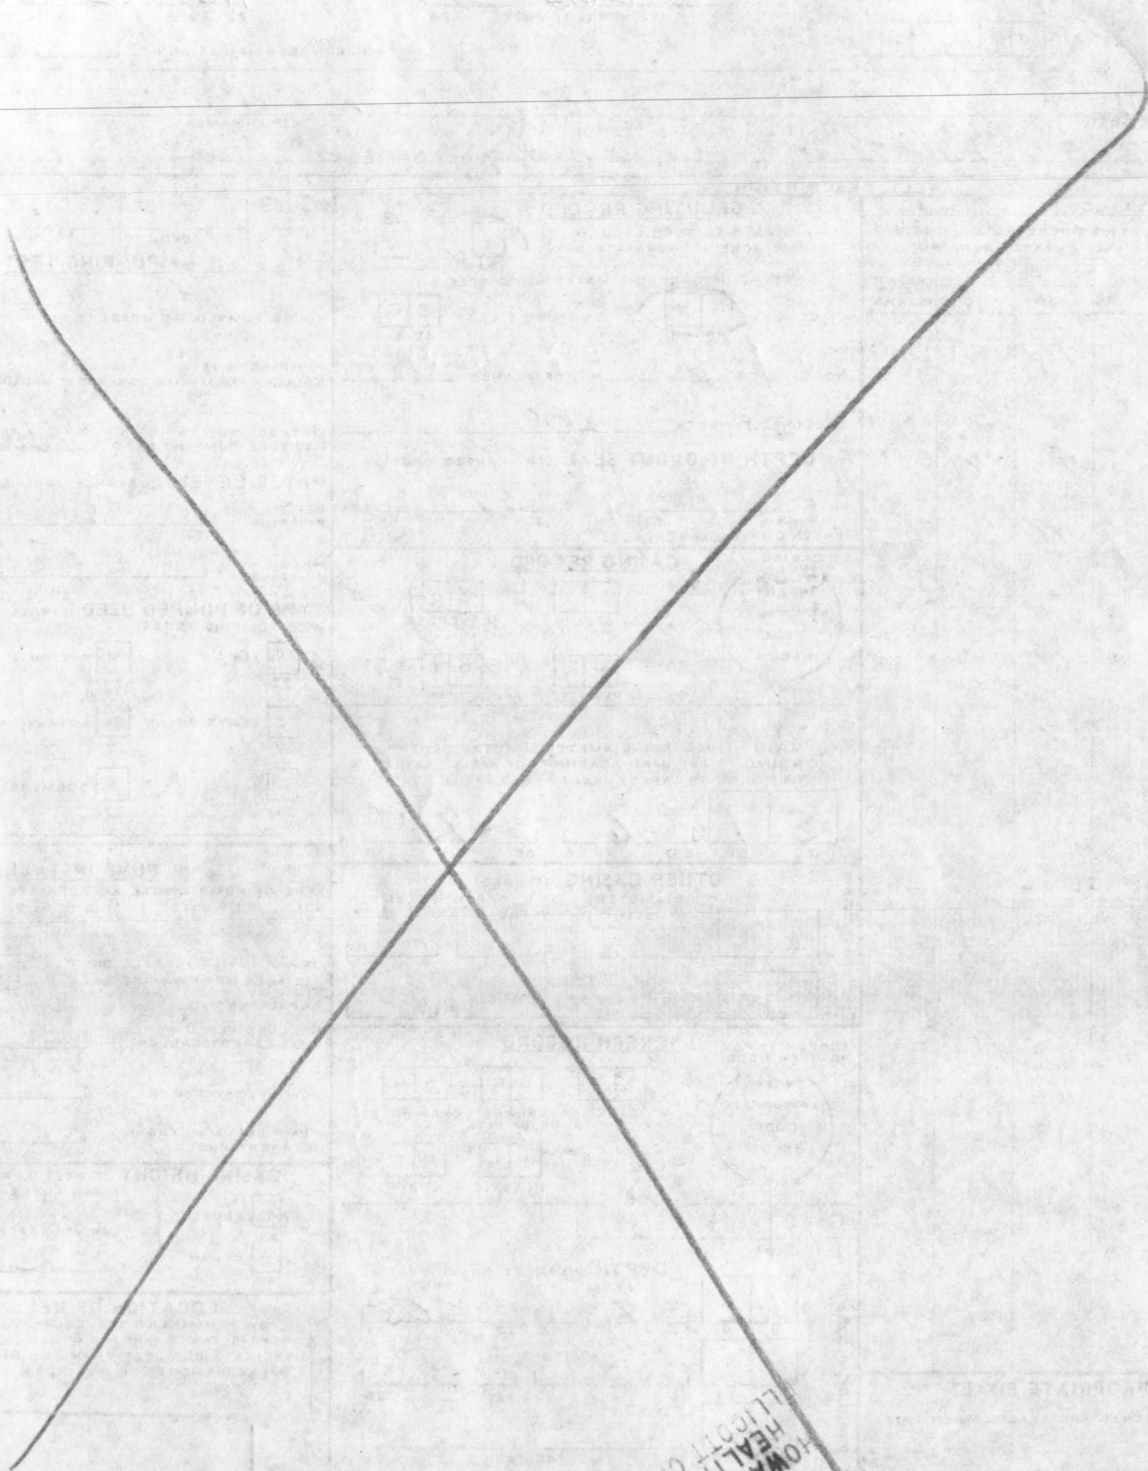

RECEIVED
JUN 30 7 50 AM
HOWARD COUNTY
HEALTH DEPT
ELICOTT CITY, MD