

11/10/76
around 1:00 P.M.

PERMIT

SEWAGE DISPOSAL SYSTEM

MARYLAND STATE DEPARTMENT OF HEALTH

HOWARD COUNTY

ELLICOTT CITY

DISTRICT 3rd

DATE 11/8/76

INDEXED

Jack Fyock

IS PERMITTED TO INSTALL ALTER ☒

ADDRESS 13775 Triadelphia Road, Glenelg, Md.

PHONE 988-9270

A SEWAGE DISPOSAL-SYSTEM LOCATED AT _____

SUBDIVISION _____ ROAD Route 144

LOT _____

PROPERTY OWNER Mrs. Ada Smallwood

ADDRESS Route 144, West Friendship, Maryland

SPECIFICATIONS

DRAIN FIELD _____ DEPTH _____ FEET, BOTTOM AREA _____ SQ. FT.

SEEPAGE PITS _____ ABSORBENT SIDE-WALL AREA _____ SQ. FT.

SEPTIC TANK CAPACITY _____ GALLONS

FOR GARBAGE GRINDER, INCREASE DISPOSAL AREA 22% & TANK CAPACITY 50%.

OTHER REPAIR - Call for inspection when ground is opened up so Sanitarian can
recommend repair system.


PLANS APPROVED BY Palmer F. Wine

DATE 11/8/76

FILL SEPTIC TANK AND DISTRIBUTION BOX WITH WATER BEFORE CALLING FOR AN INSPECTION. COVER NO WORK UNTIL INSPECTED AND APPROVED.

NEITHER THE HOWARD COUNTY COMMISSIONERS NOR THE HEALTH DEPARTMENT IS RESPONSIBLE FOR THE SUCCESSFUL OPERATION OF ANY SYSTEM.

24457

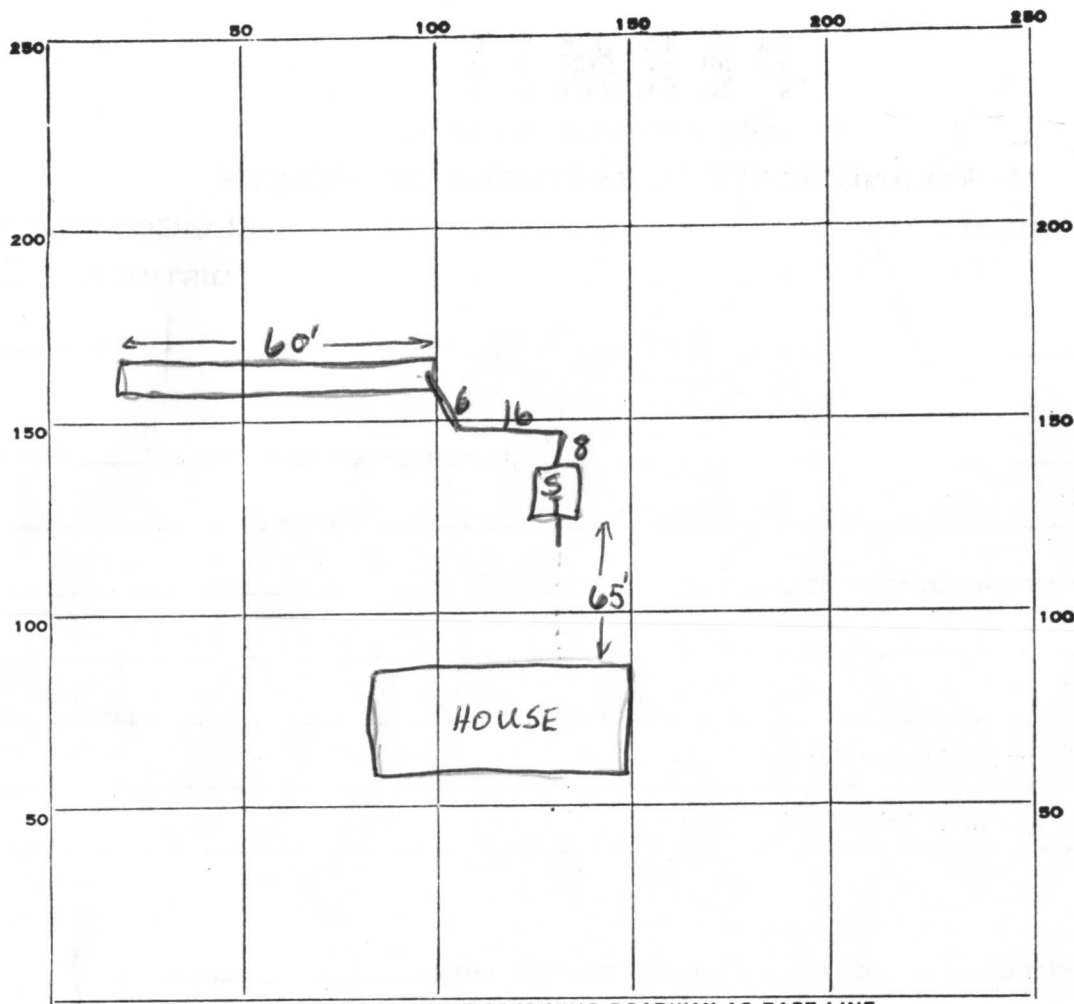

INDICATE NORTH. - NAME ADJOINING ROADWAY AS BASE LINE.

PERMIT CARD none seen

SEPTIC TANK, LEVEL 1000 gal

CLEANOUTS ST
✓

DISTRIBUTION BOX, LEVEL _____

TILE FIELD, DEPTH 10 FT. TRENCH WIDTH 2 FT.

GRAVEL DEPTH 28 FT. TOTAL LENGTH 60 FT.

NUMBER OF TRENCHES 1 TOTAL SIDEWALL 480 ✓
BOTTOM AREA

SEEPAGE PITS, INSIDE DIAMETER _____ FT. DEPTH BELOW INLET _____ FT.

11/10/76 ABSORBENT AREA _____ SQ. FT.

REMARKS I measured the depth of ditch to be ten feet.

Ada Smallwood

Job essentially complete. WZ.

DATE SYSTEM APPROVED

11/10/76.

INSPECTOR

William H. Zepp